
BM = 1764.9 - City Stkl. 44' W. of E. Oliver Ave. & 32' N. of E.A.C. Pmt W. on 25th St. N.
BM = 1837.7 - "X" Cut Top curb W.S. Oliver, 1st curb Jt. N. of S.L. Arlene ext.
BM = 1803.3 - S.W. Corner Conc. Porch No. at 4914 E. 24th St. N.

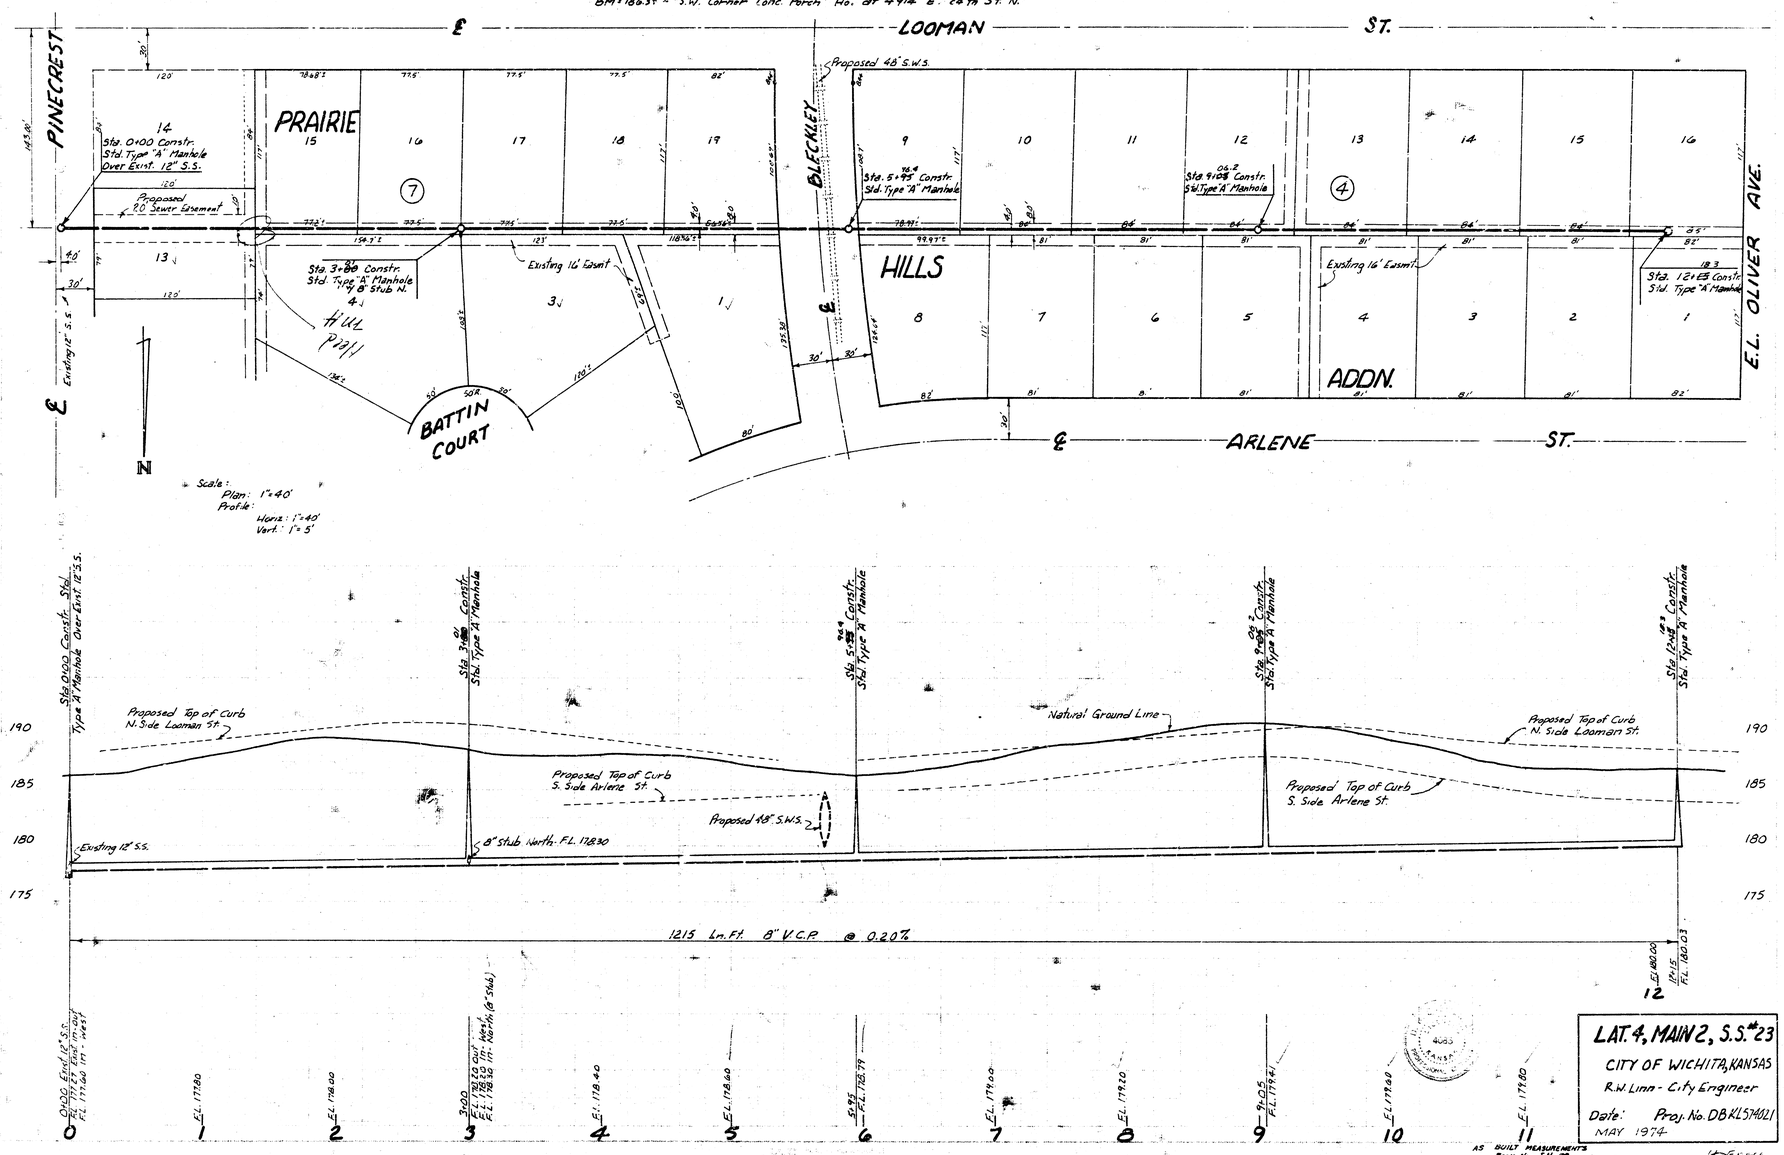

LAT. 4, MAIN 2, S.S. #23
CITY OF WICHITA, KANSAS
R.W. Linn - City Engineer
Date: MAY 1974
Proj. No. DBKLS74021

14 e 4