Note: Contractor to replace all fences. Contractor shall also replace all water lines, gas lines, and septic tank laterals disturbed during construction of the sewer. The work of removing and replacing gas lines, water lines, and septic tank laterals will not be paid for directly, and is to be considered as incidental to the construction of the sewer.

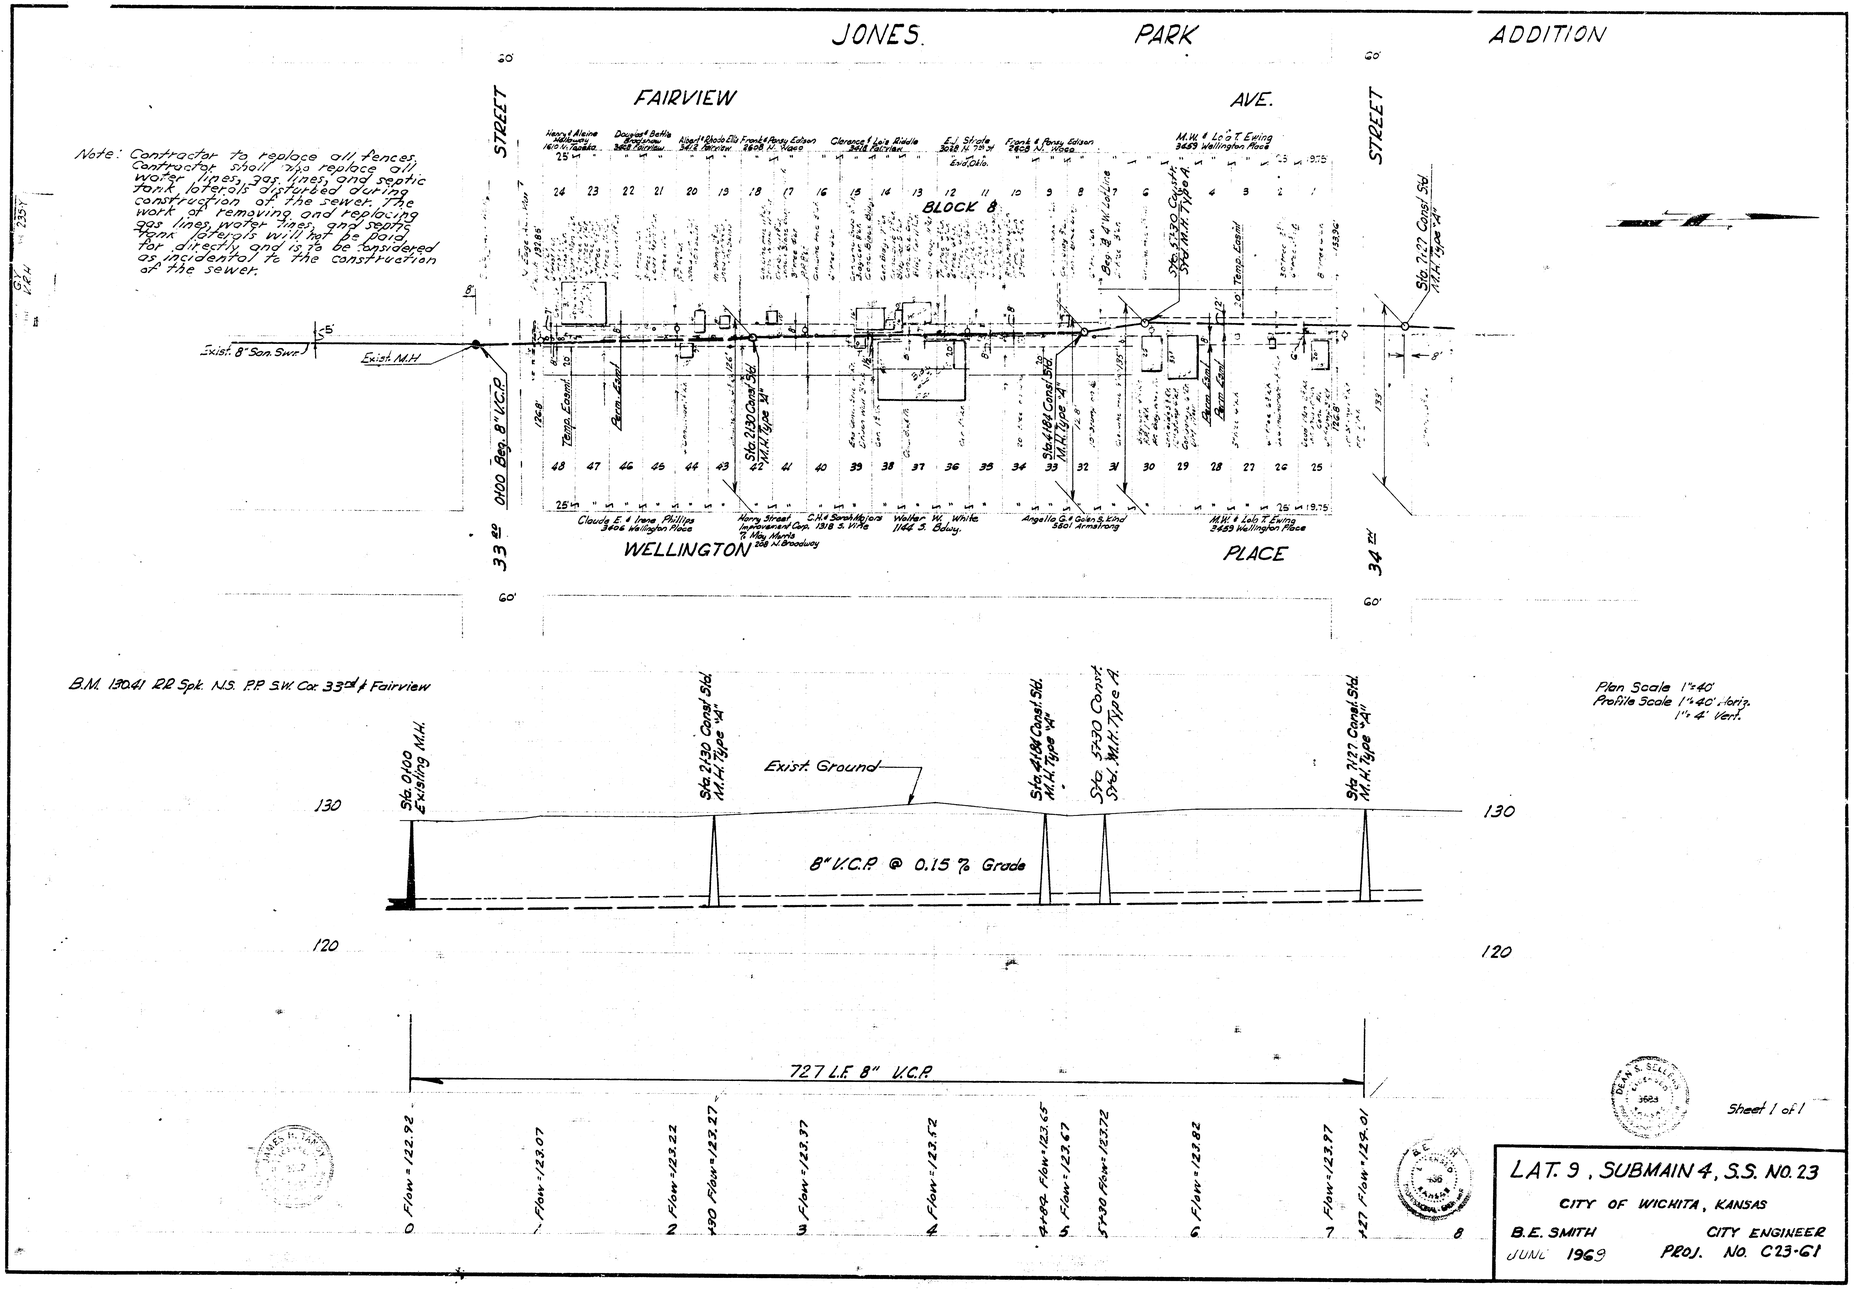

Plan Scale 1"=40'
Profile Scale 1"=40' Horiz.
1"=4' Vert.

Sheet 1 of 1

LAT. 9, SUBMAIN 4, S.S. NO. 23

CITY OF WICHITA, KANSAS

B.E. SMITH — CITY ENGINEER

JUNE 1969 — PROJ. NO. C23-61

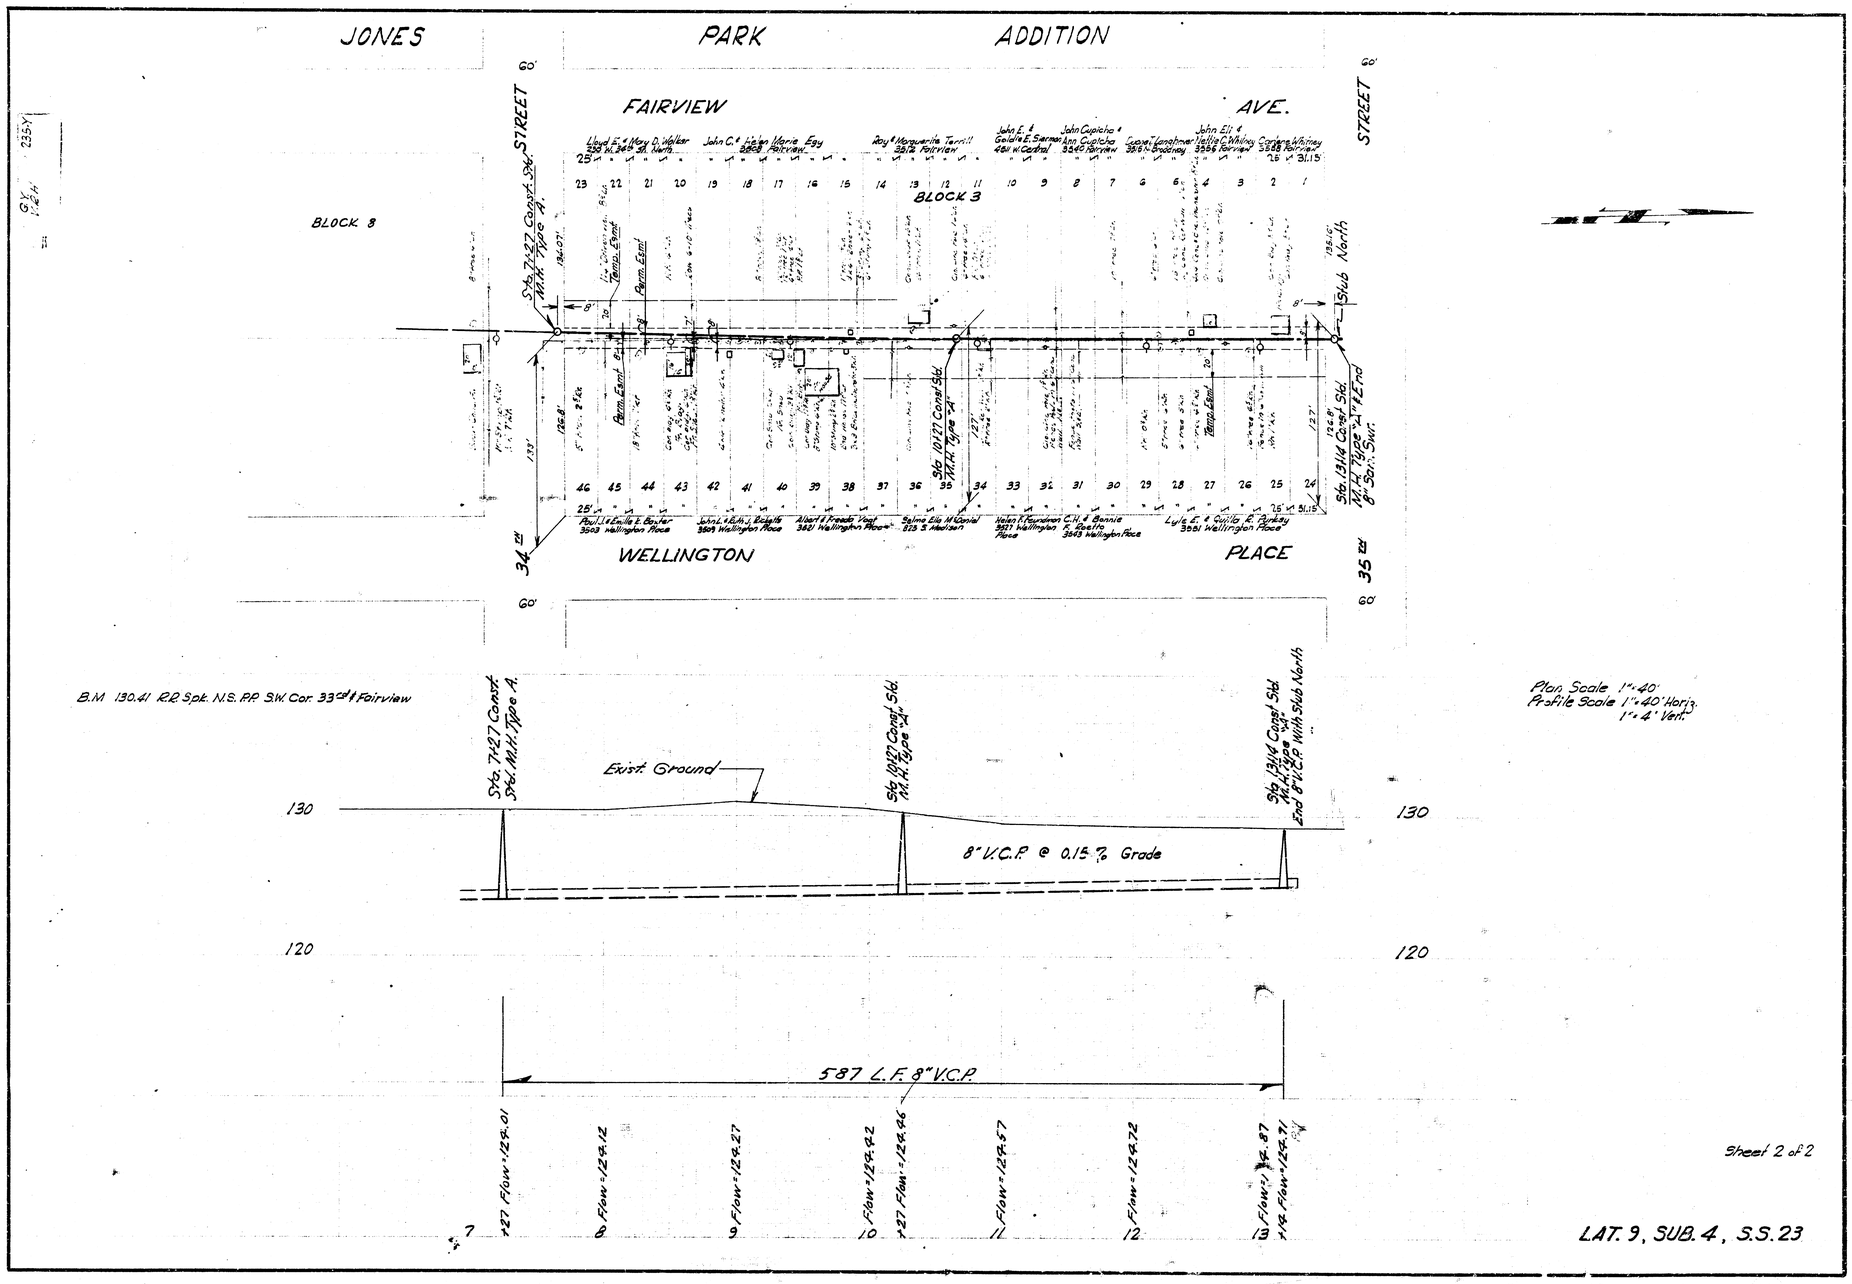
JONES PARK ADDITION
FAIRVIEW AVE.
WELLINGTON PLACE
BLOCK 8
BLOCK 3
STREET
Sta. 7+27 Const. Std. M.H. Type A.
Sta. 10+27 Const. Std. M.H. Type "A"
Sta. 13+14 Const. Std. M.H. Type "A" & End 8" San. Swr.
Stub North
Temp. Esmt.
Perm. Esmt.
34th
35th
60'
B.M. 130.41 R.R. Spk. N.S. P.P. S.W. Cor. 33rd & Fairview
Exist. Ground
8" V.C.P. @ 0.15% Grade
130
120
587 L.F. 8" V.C.P.
Plan Scale 1"=40'
Profile Scale 1"=40' Horiz.
1"=4' Vert.
Sheet 2 of 2
LAT. 9, SUB. 4, S.S. 23