


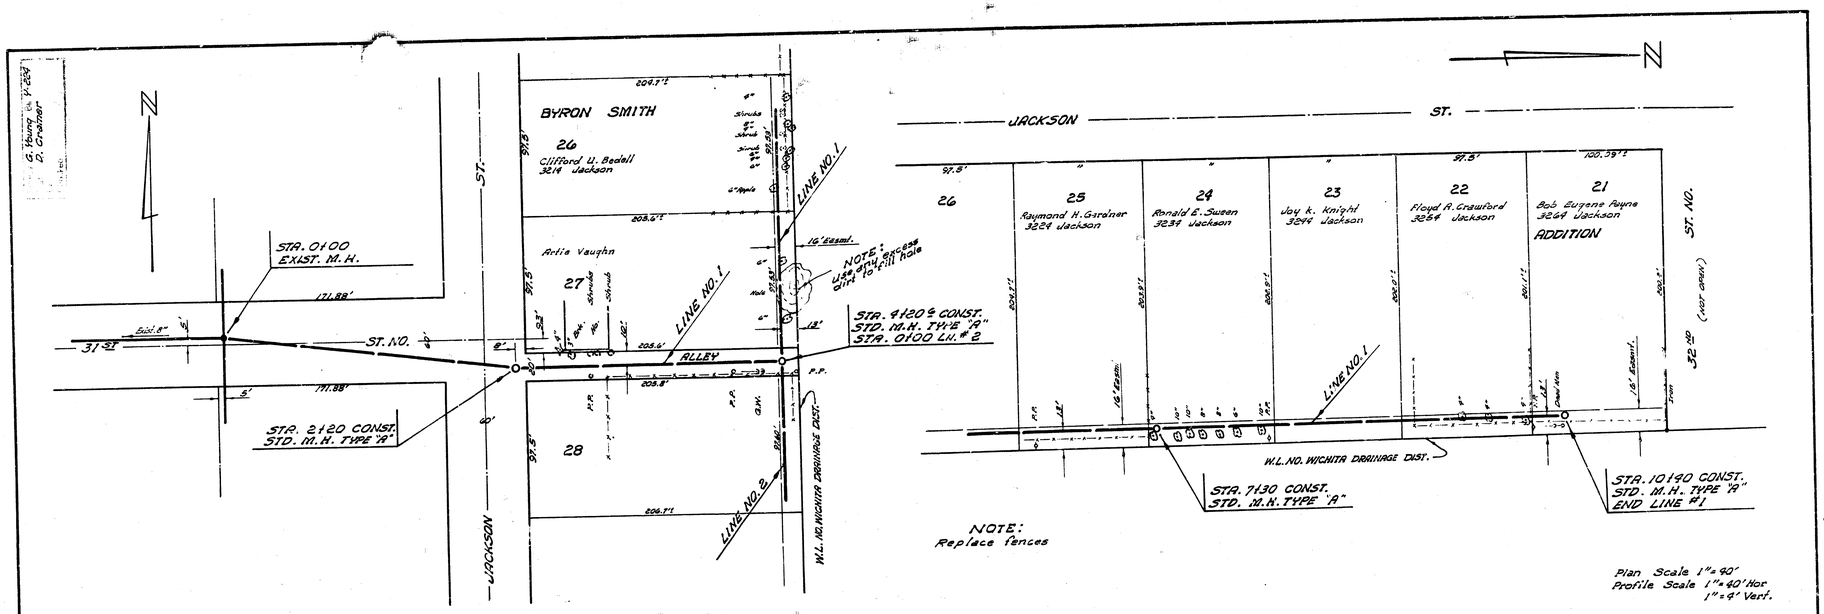


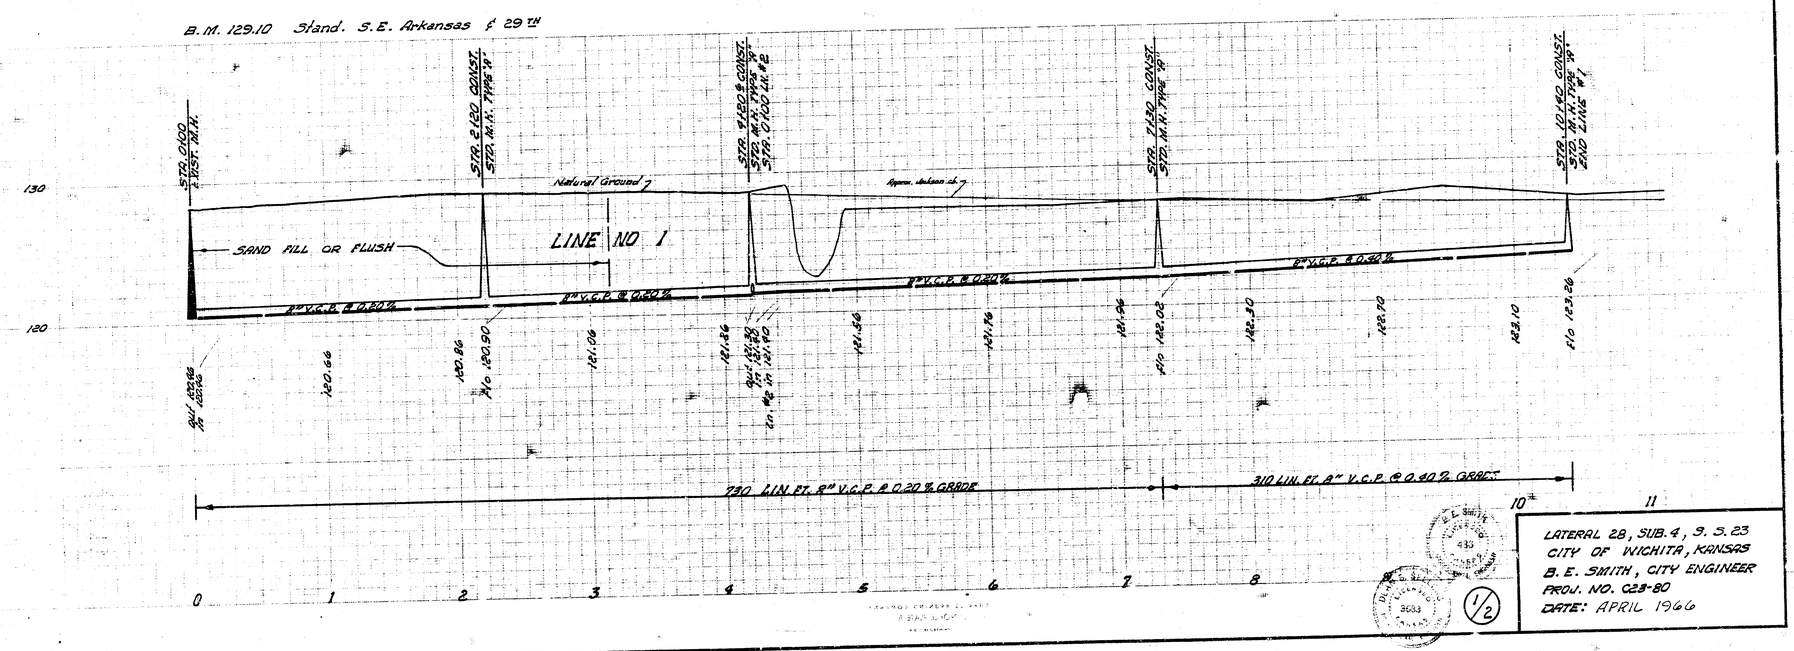

LATERAL 28, SUB. 4, S. S. 23
CITY OF WICHITA, KANSAS
B. E. SMITH, CITY ENGINEER
PROJ. NO. C23-80
DATE: APRIL 1966

1/2

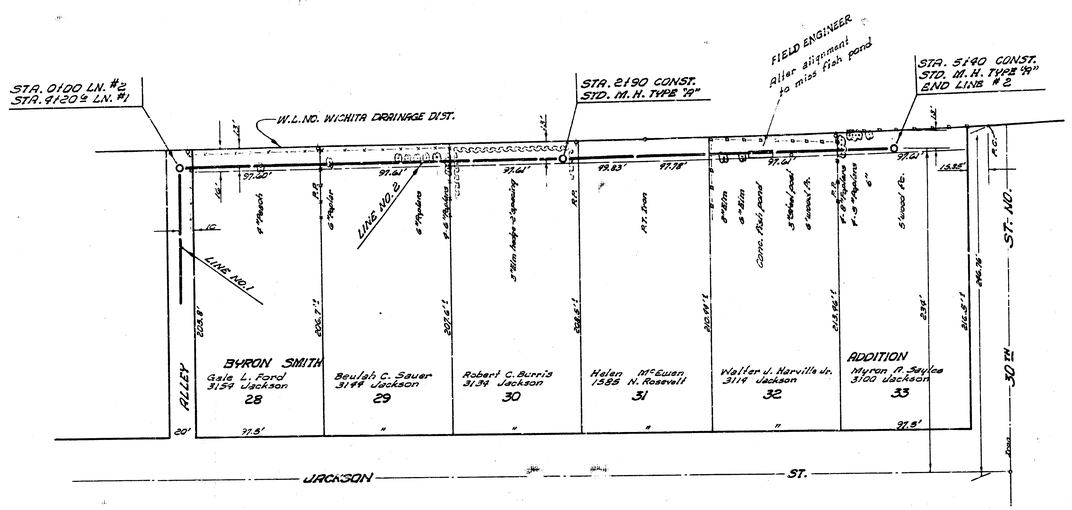

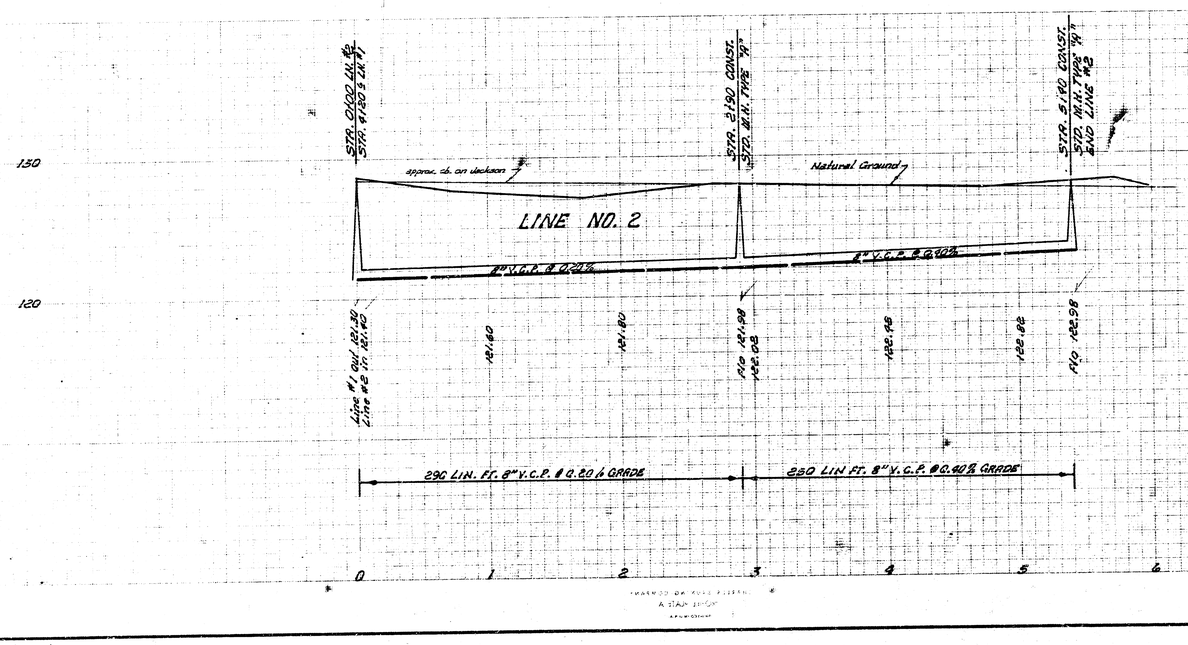

2/2

LAT. 28, SUB. 4, S.S. NO. 23
PROJ. NO. C23-80

a 15 1 (1)