



Scale:  
Plan 1" = 40'  
Profile 1" = 40' Hor.  
1" = 5' Vert.

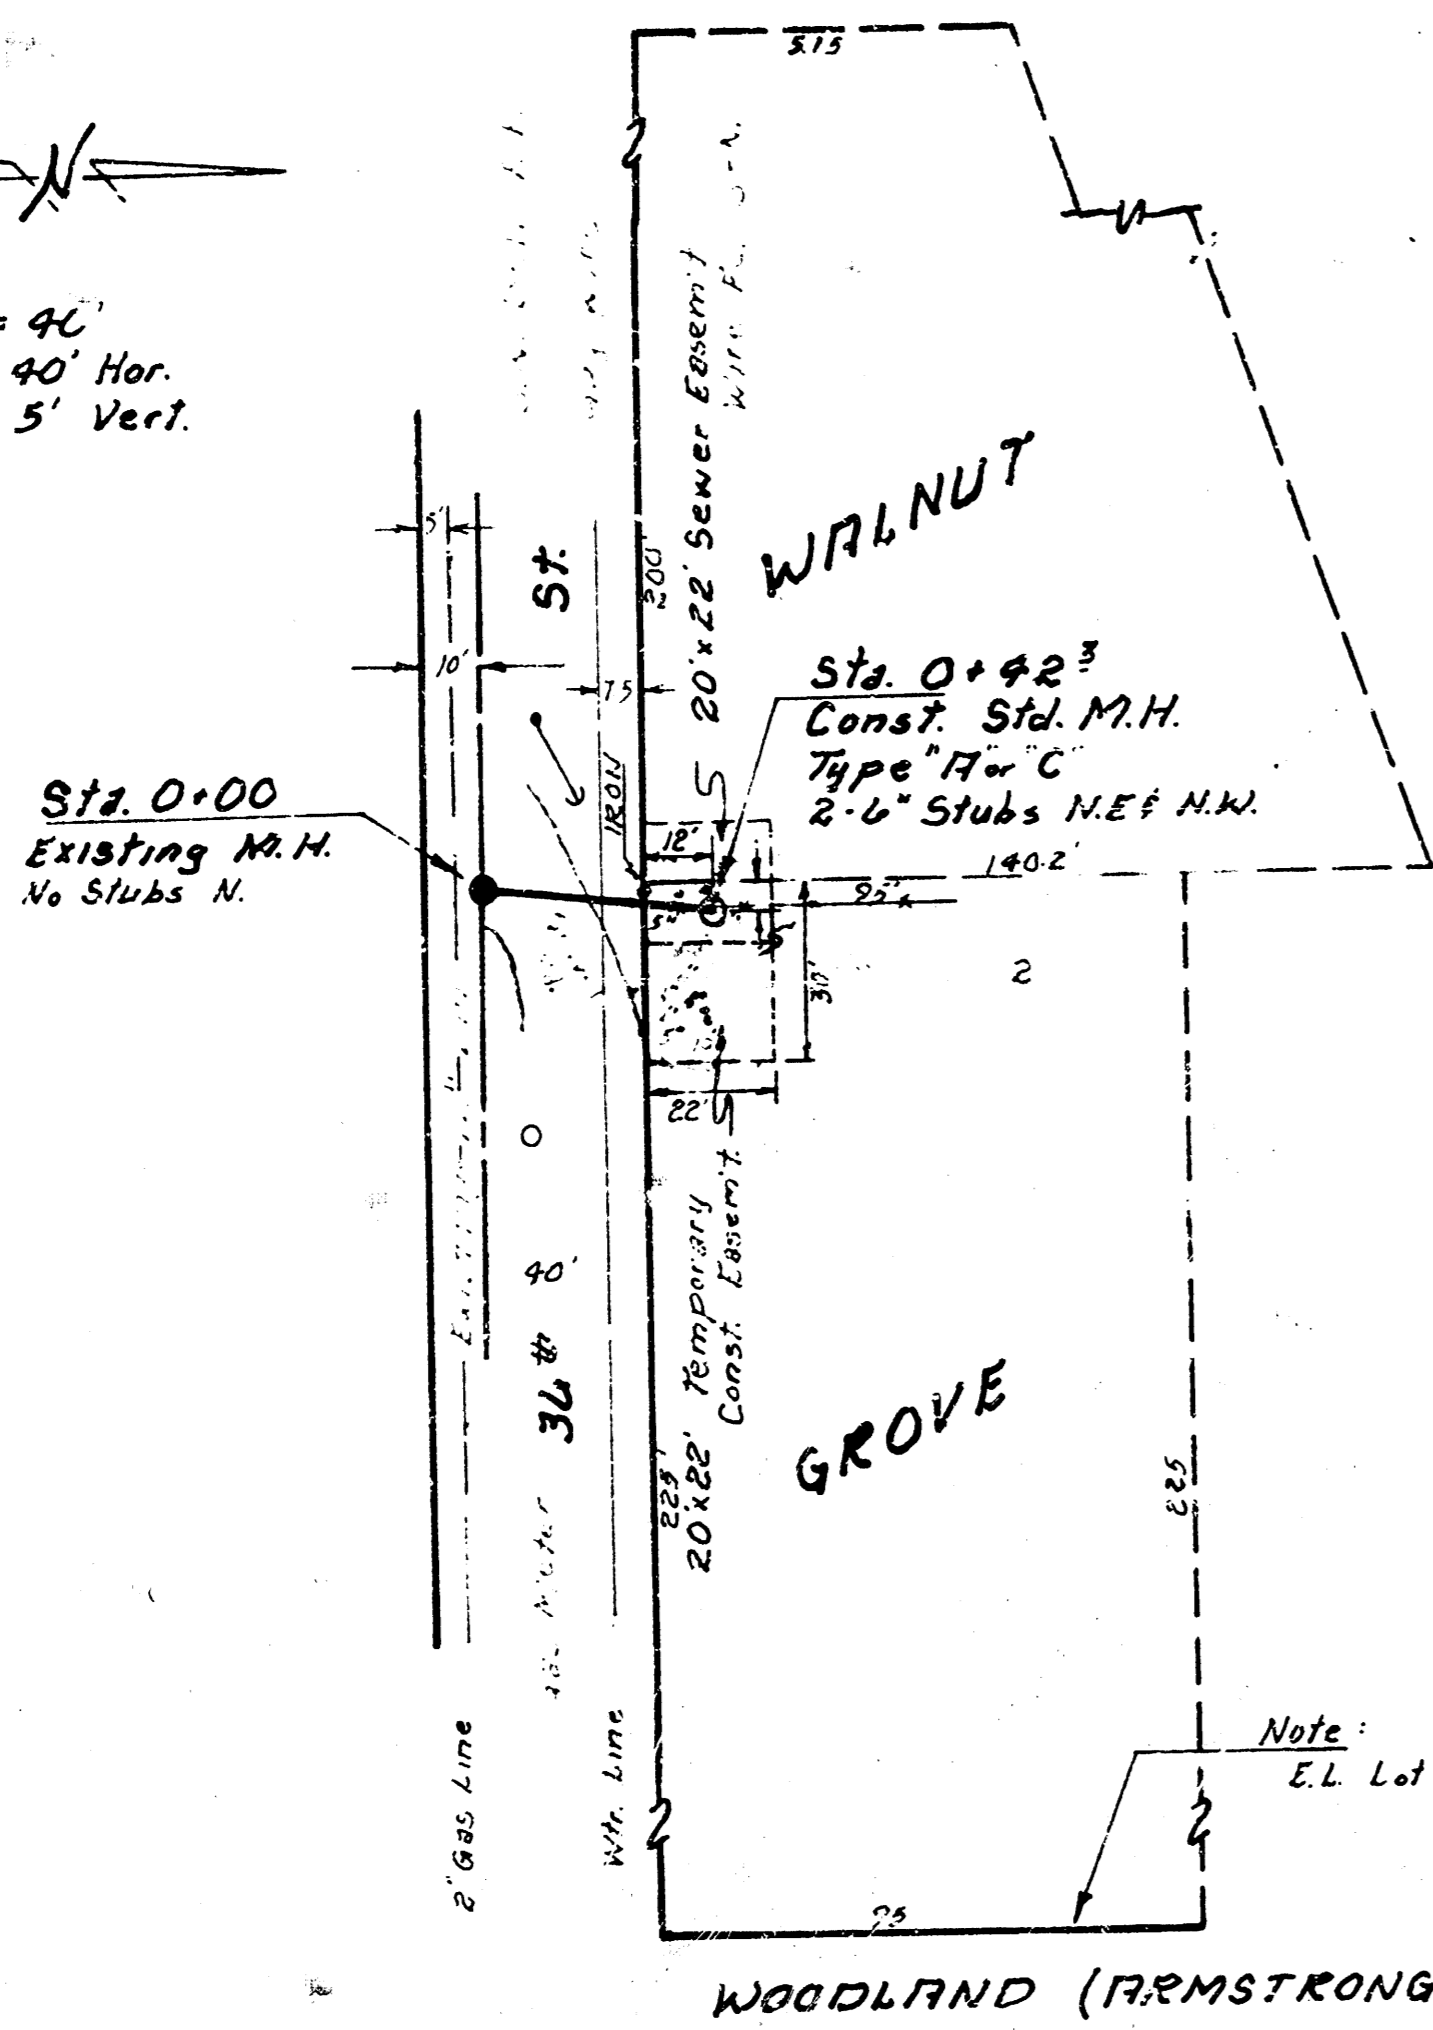

NOTE: FIELD ENGINEER SHALL LOCATE NEW MANHOLES SUCH THAT IT WILL NOT BE UNDER THE FENCE.


PLAN  
NOTE BOOK  
NO. 722-1

PROFILE  
NOTE BOOK  
NO. 722-1

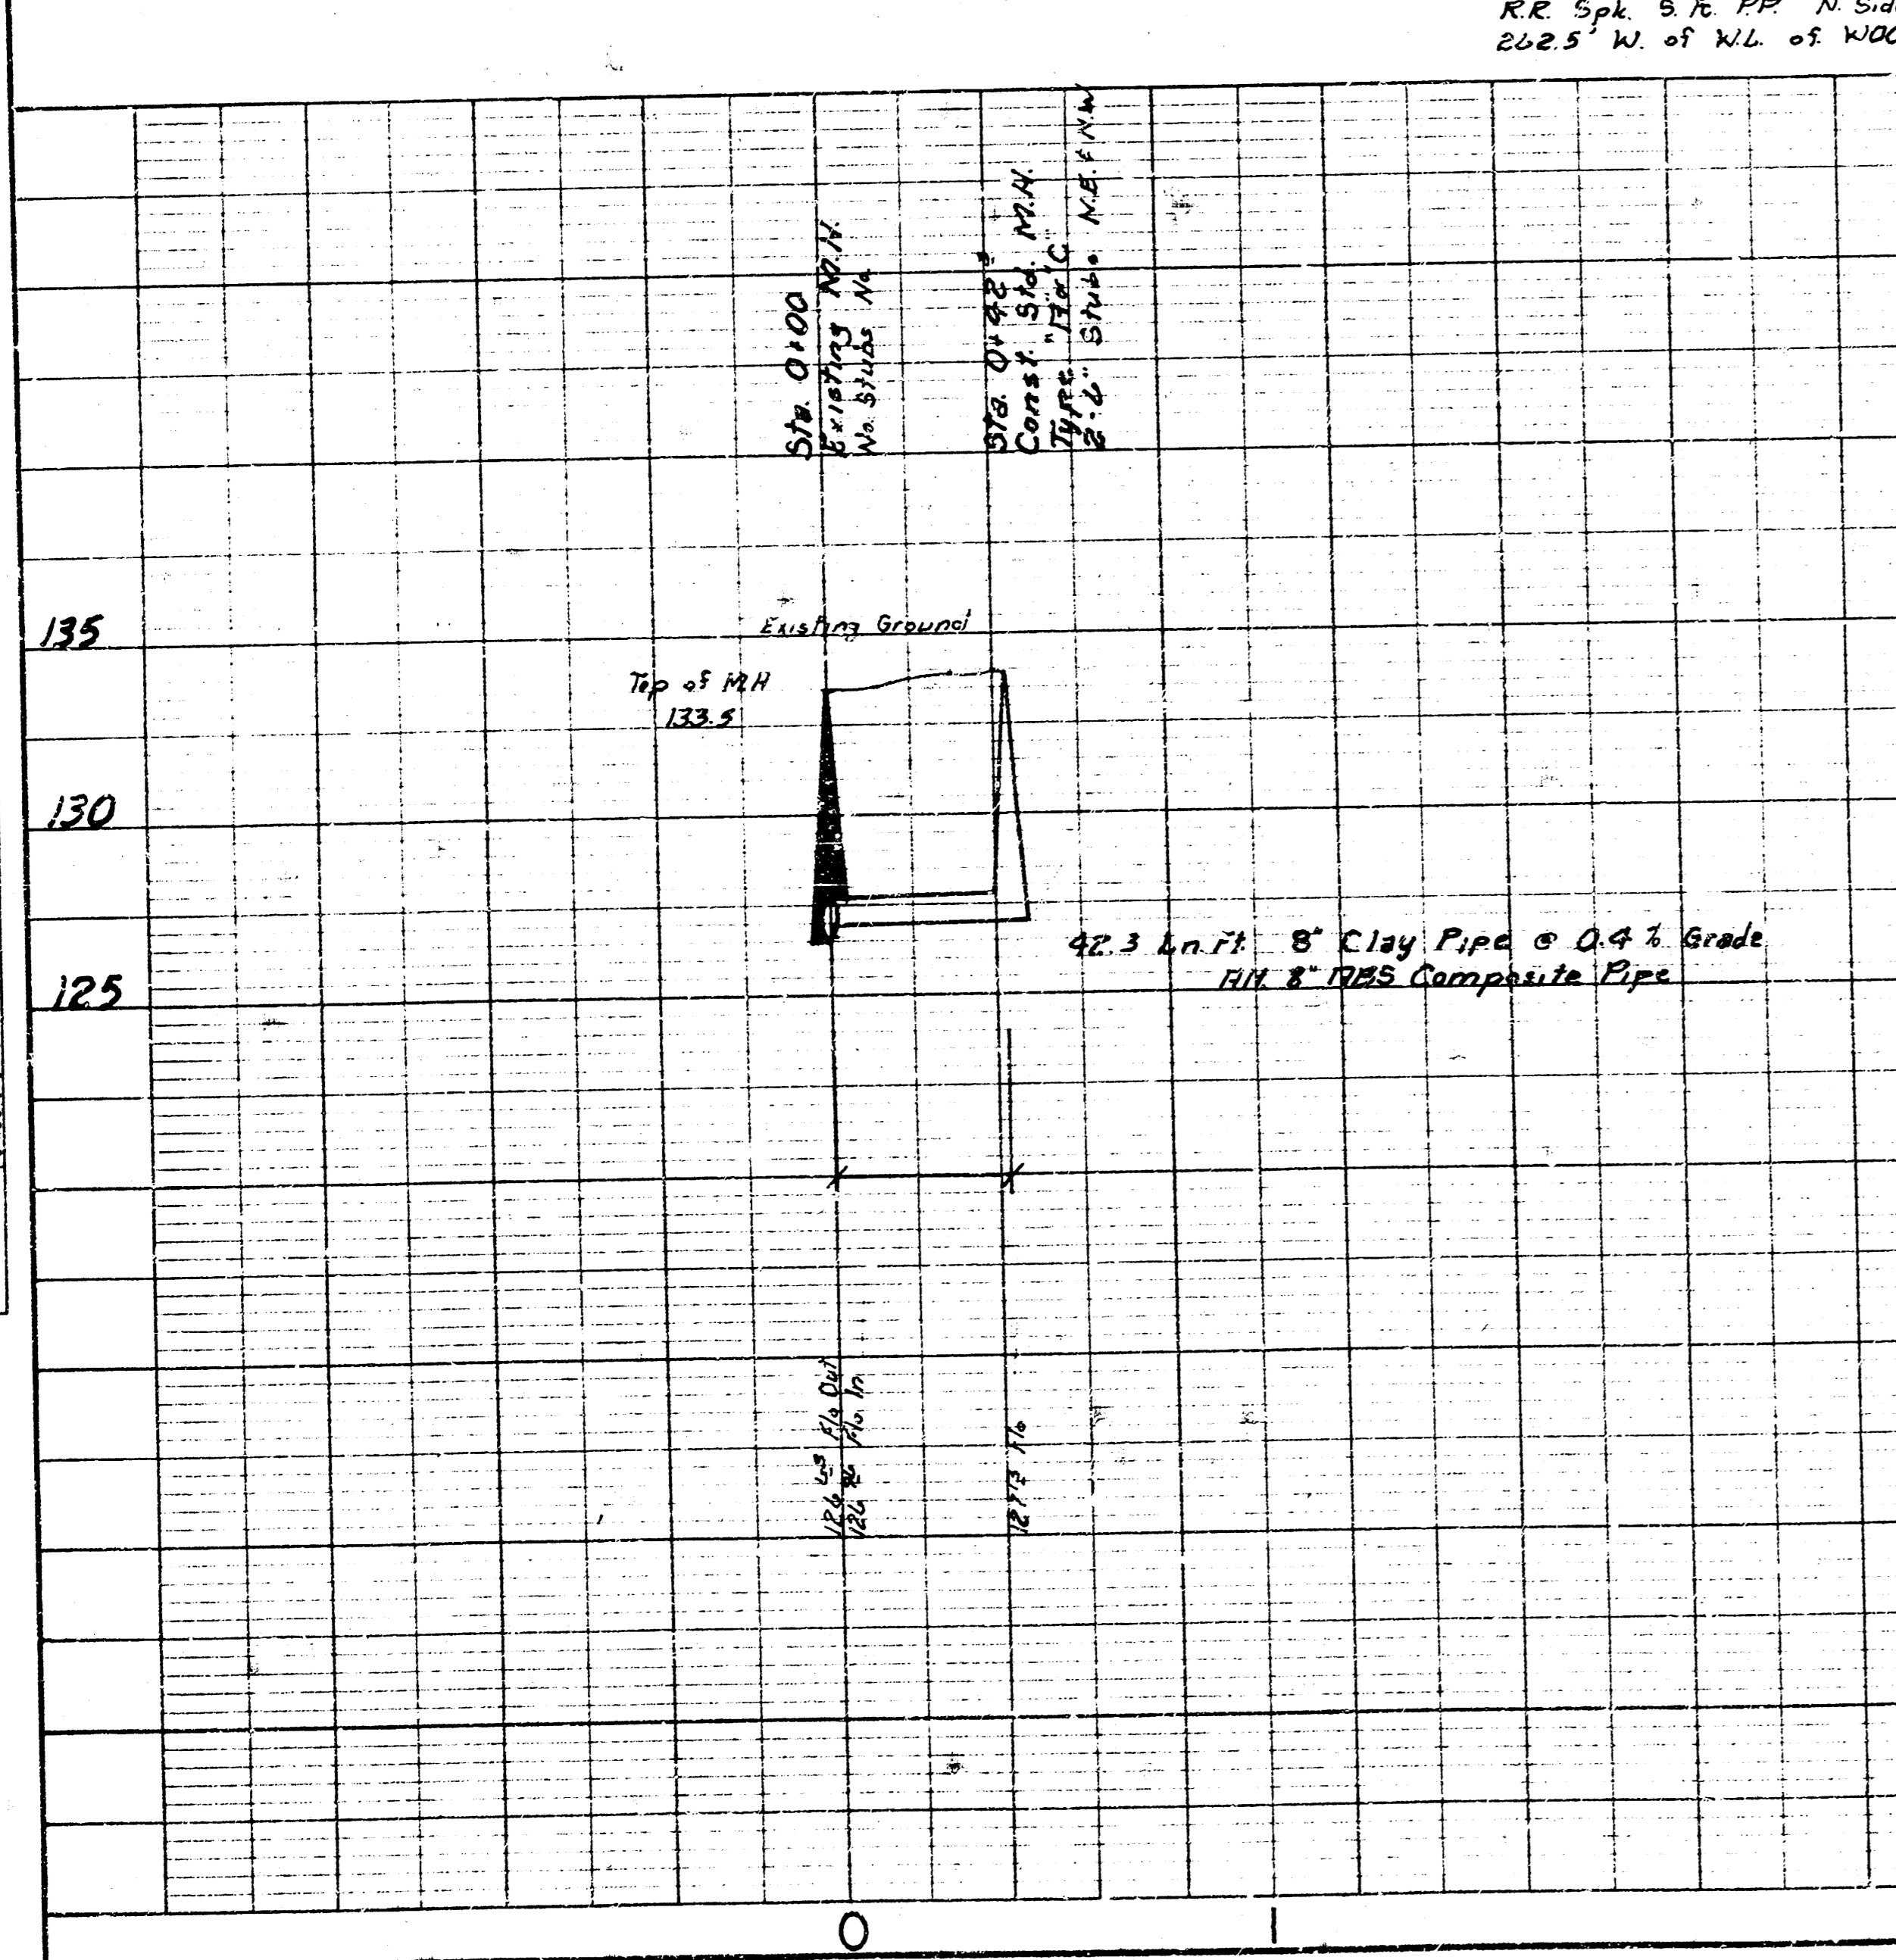


Lat. 96, Main 4, SS. No. 23  
CITY of WICHITA, KANSAS  
R. W. LINN CITY ENGINEER  
PROJ. NO. 468-76-245-80566-000-000-001  
DATE:

7-78  
D. C. CICO  
J. D. AMERLAND  
T.C.D. - 2  
SURVEYED  
PLOTTED  
BOOK NO.

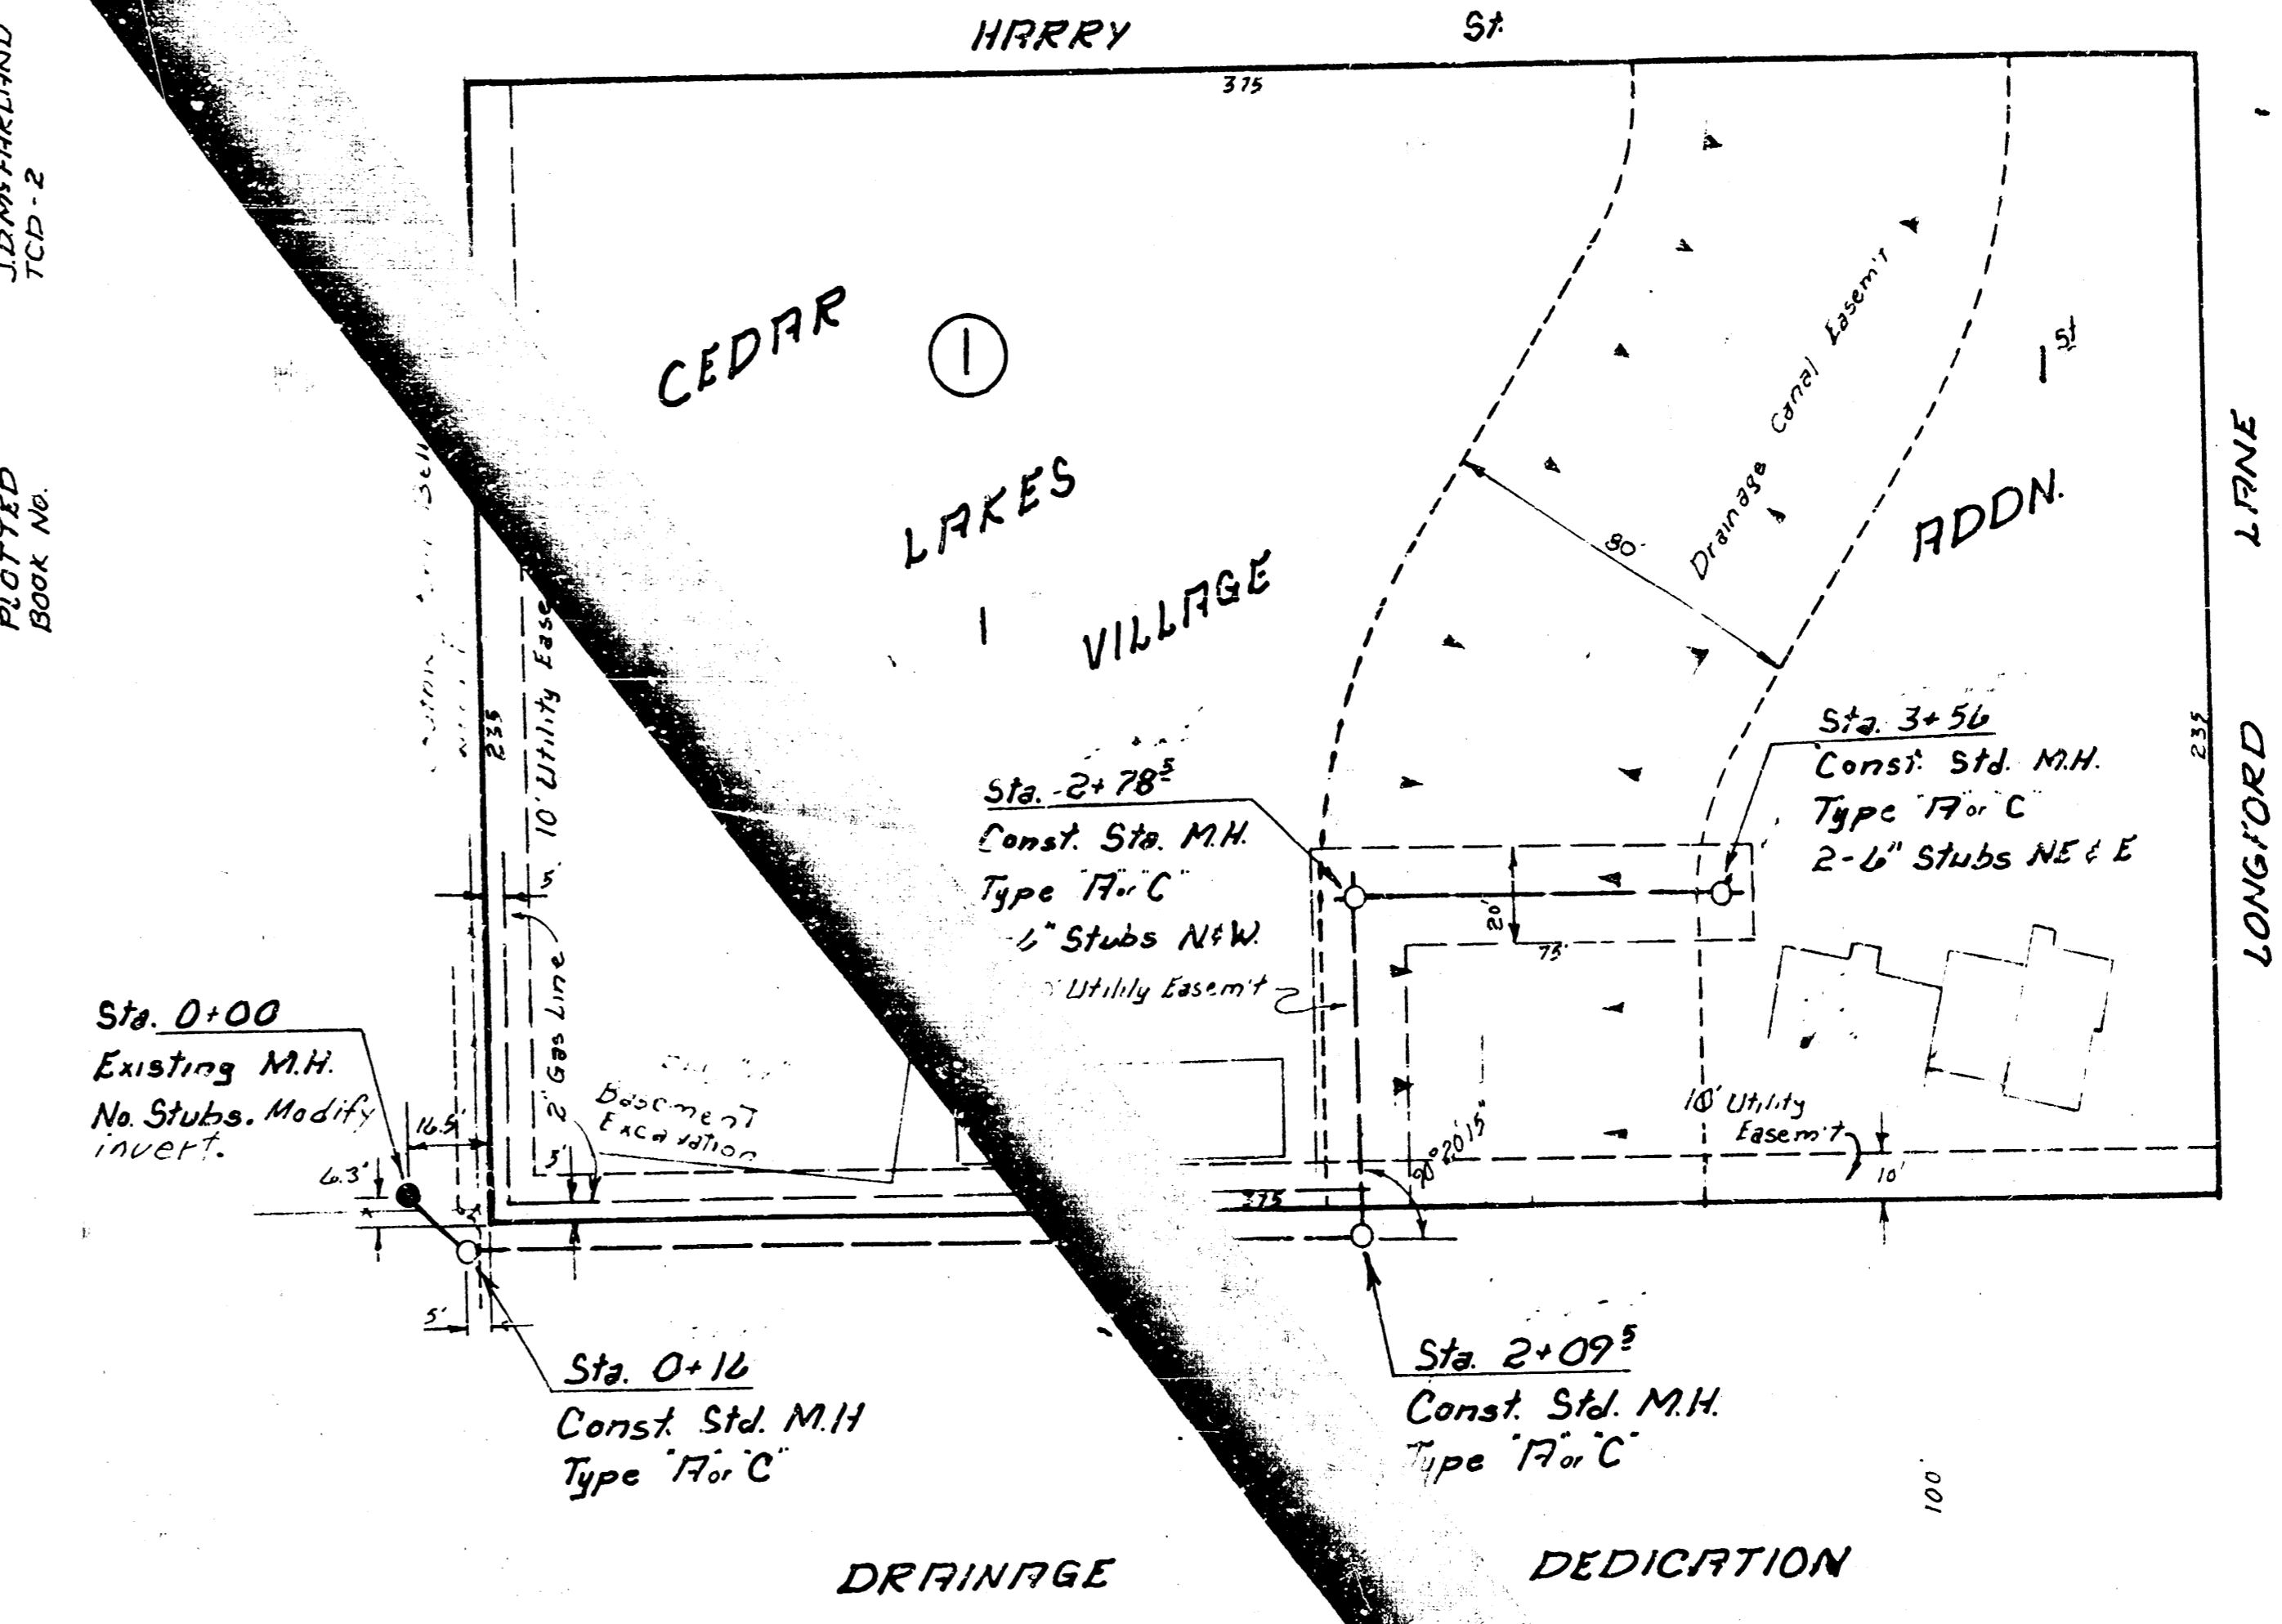

Scale:  
Plan 1" = 40'  
Profile 1" = 40' Hor.  
1" = 5' Ver.

B.M. 15908  
"D" Cut NW Cor N Headwall 85' W  
of W.L. of LONGFORD & HARRY ST

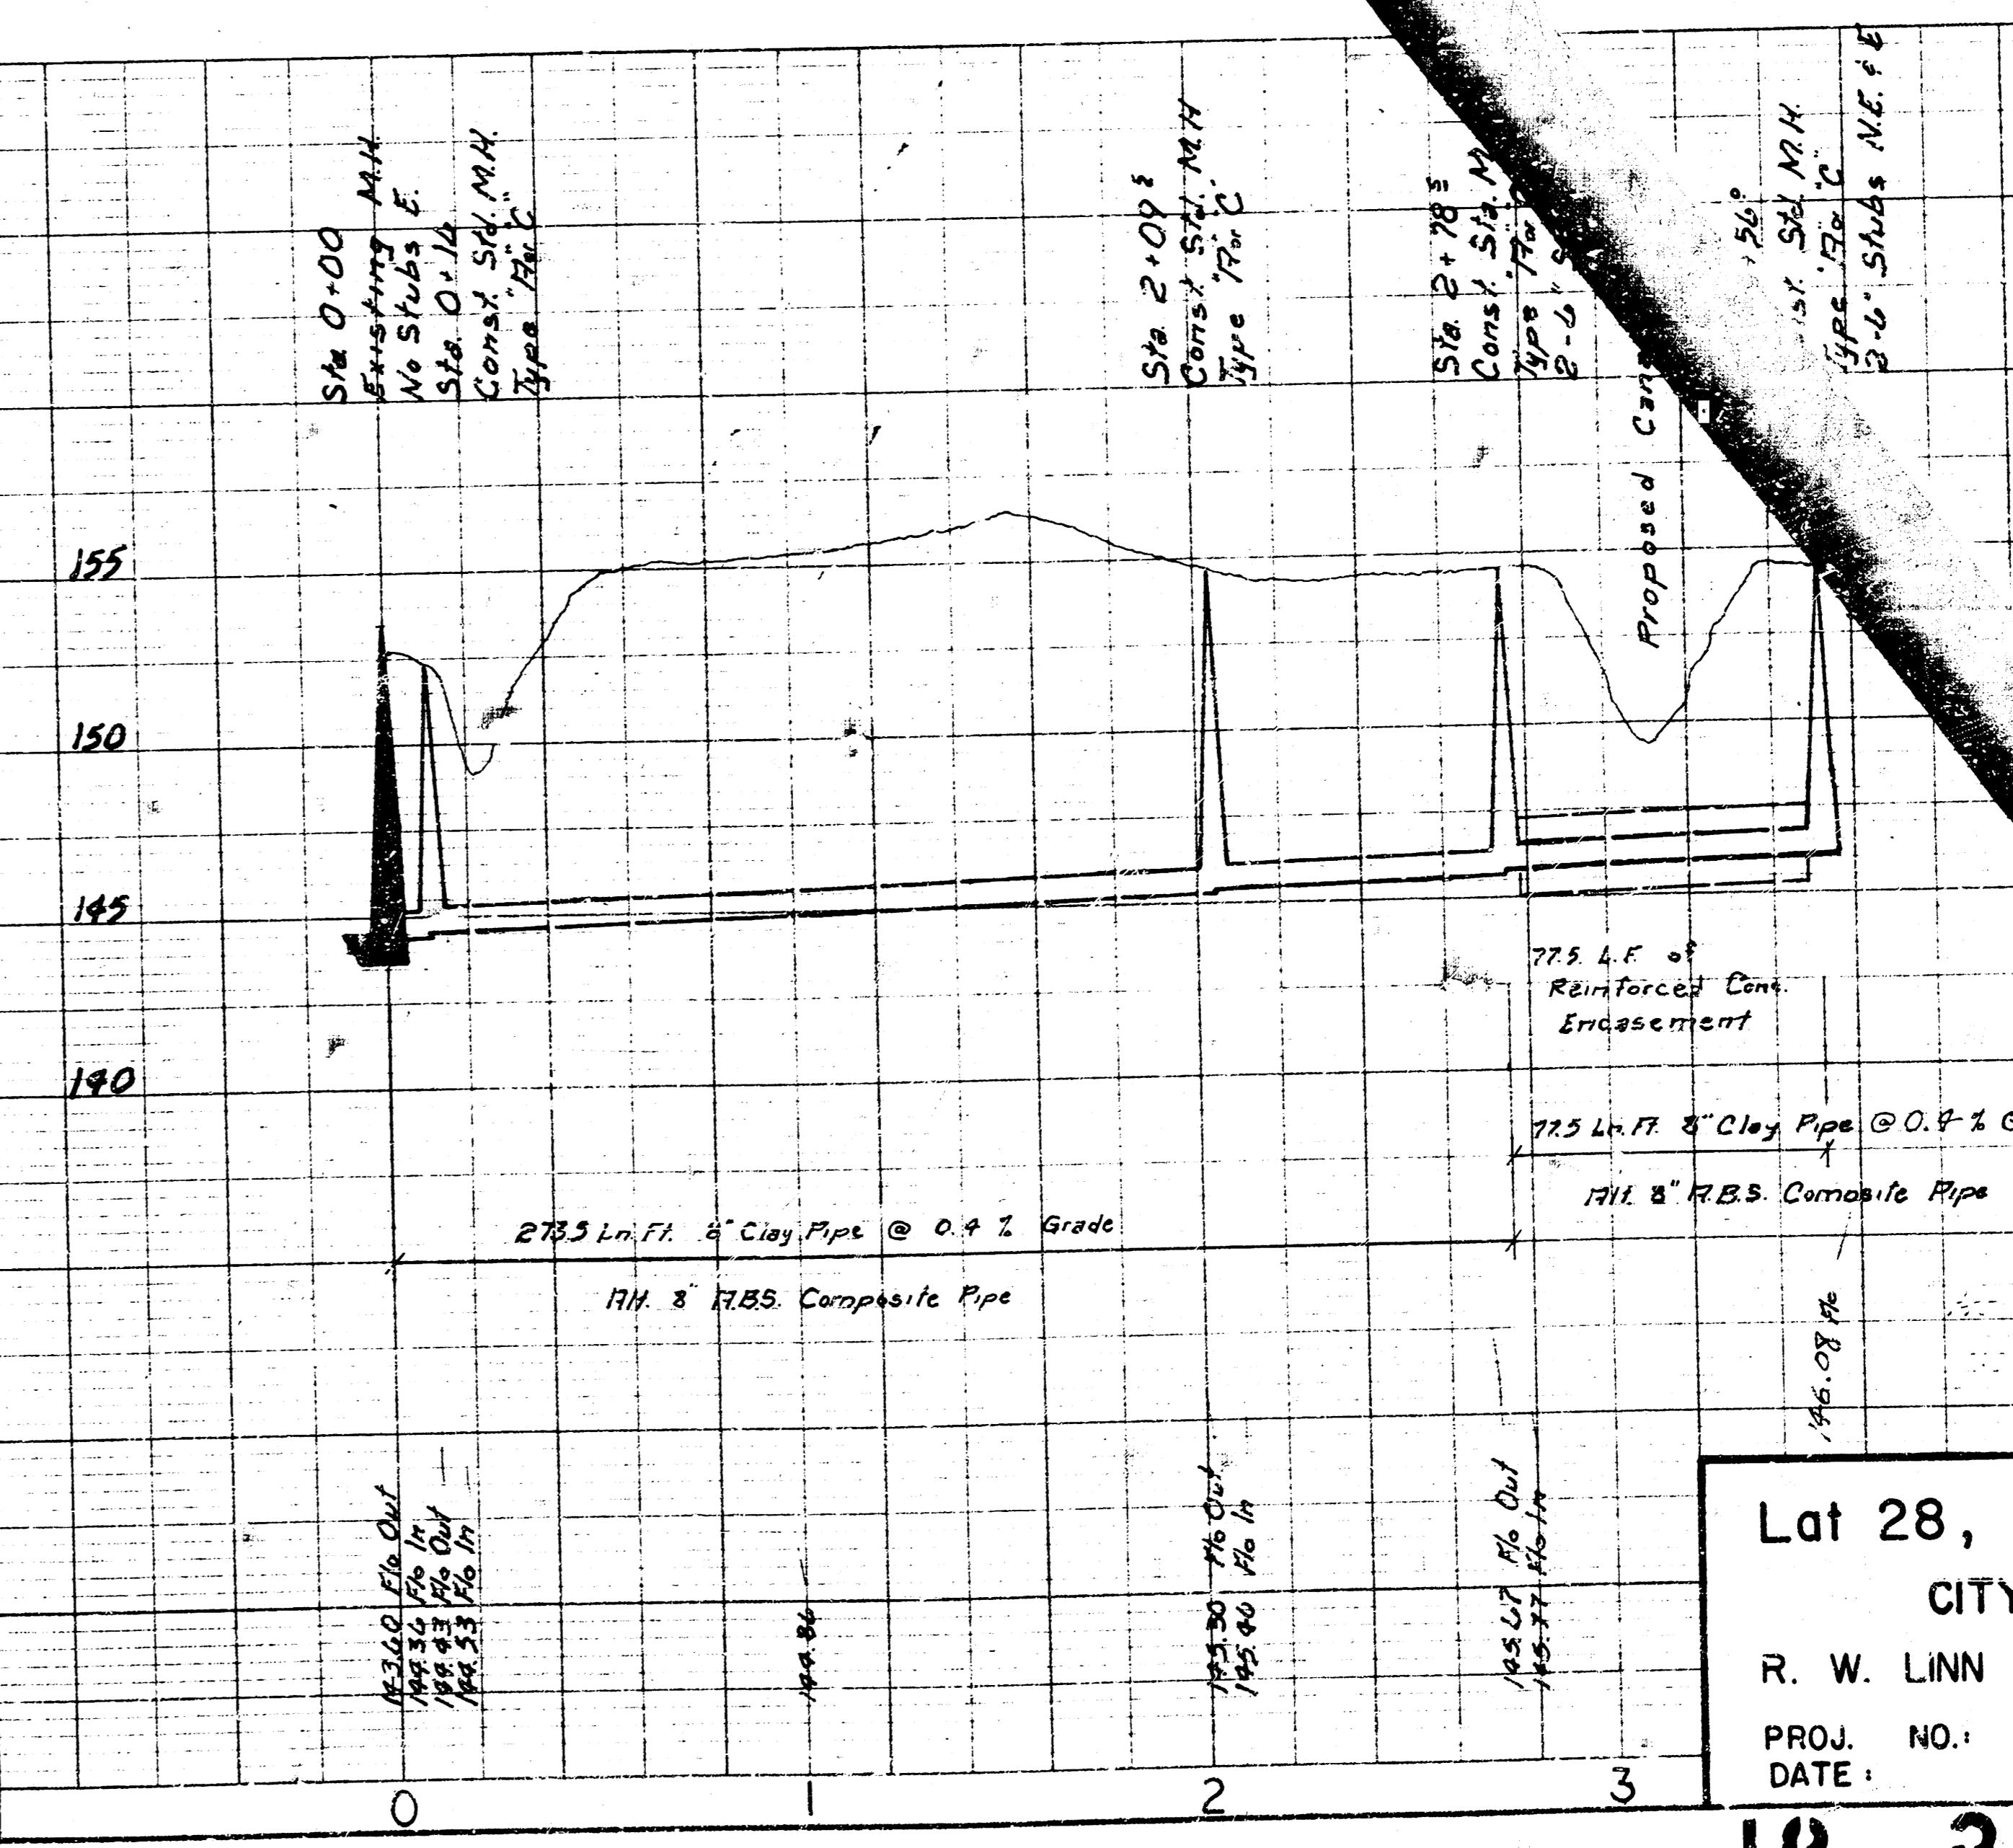

Lat 28, Main 17 WAR INDUSTRIES  
CITY of WICHITA, KANSAS  
R. W. LINN CITY ENGINEER  
PROJ. NO. 468-76-245-80567-000-000-001  
DATE:

10 2 4 3