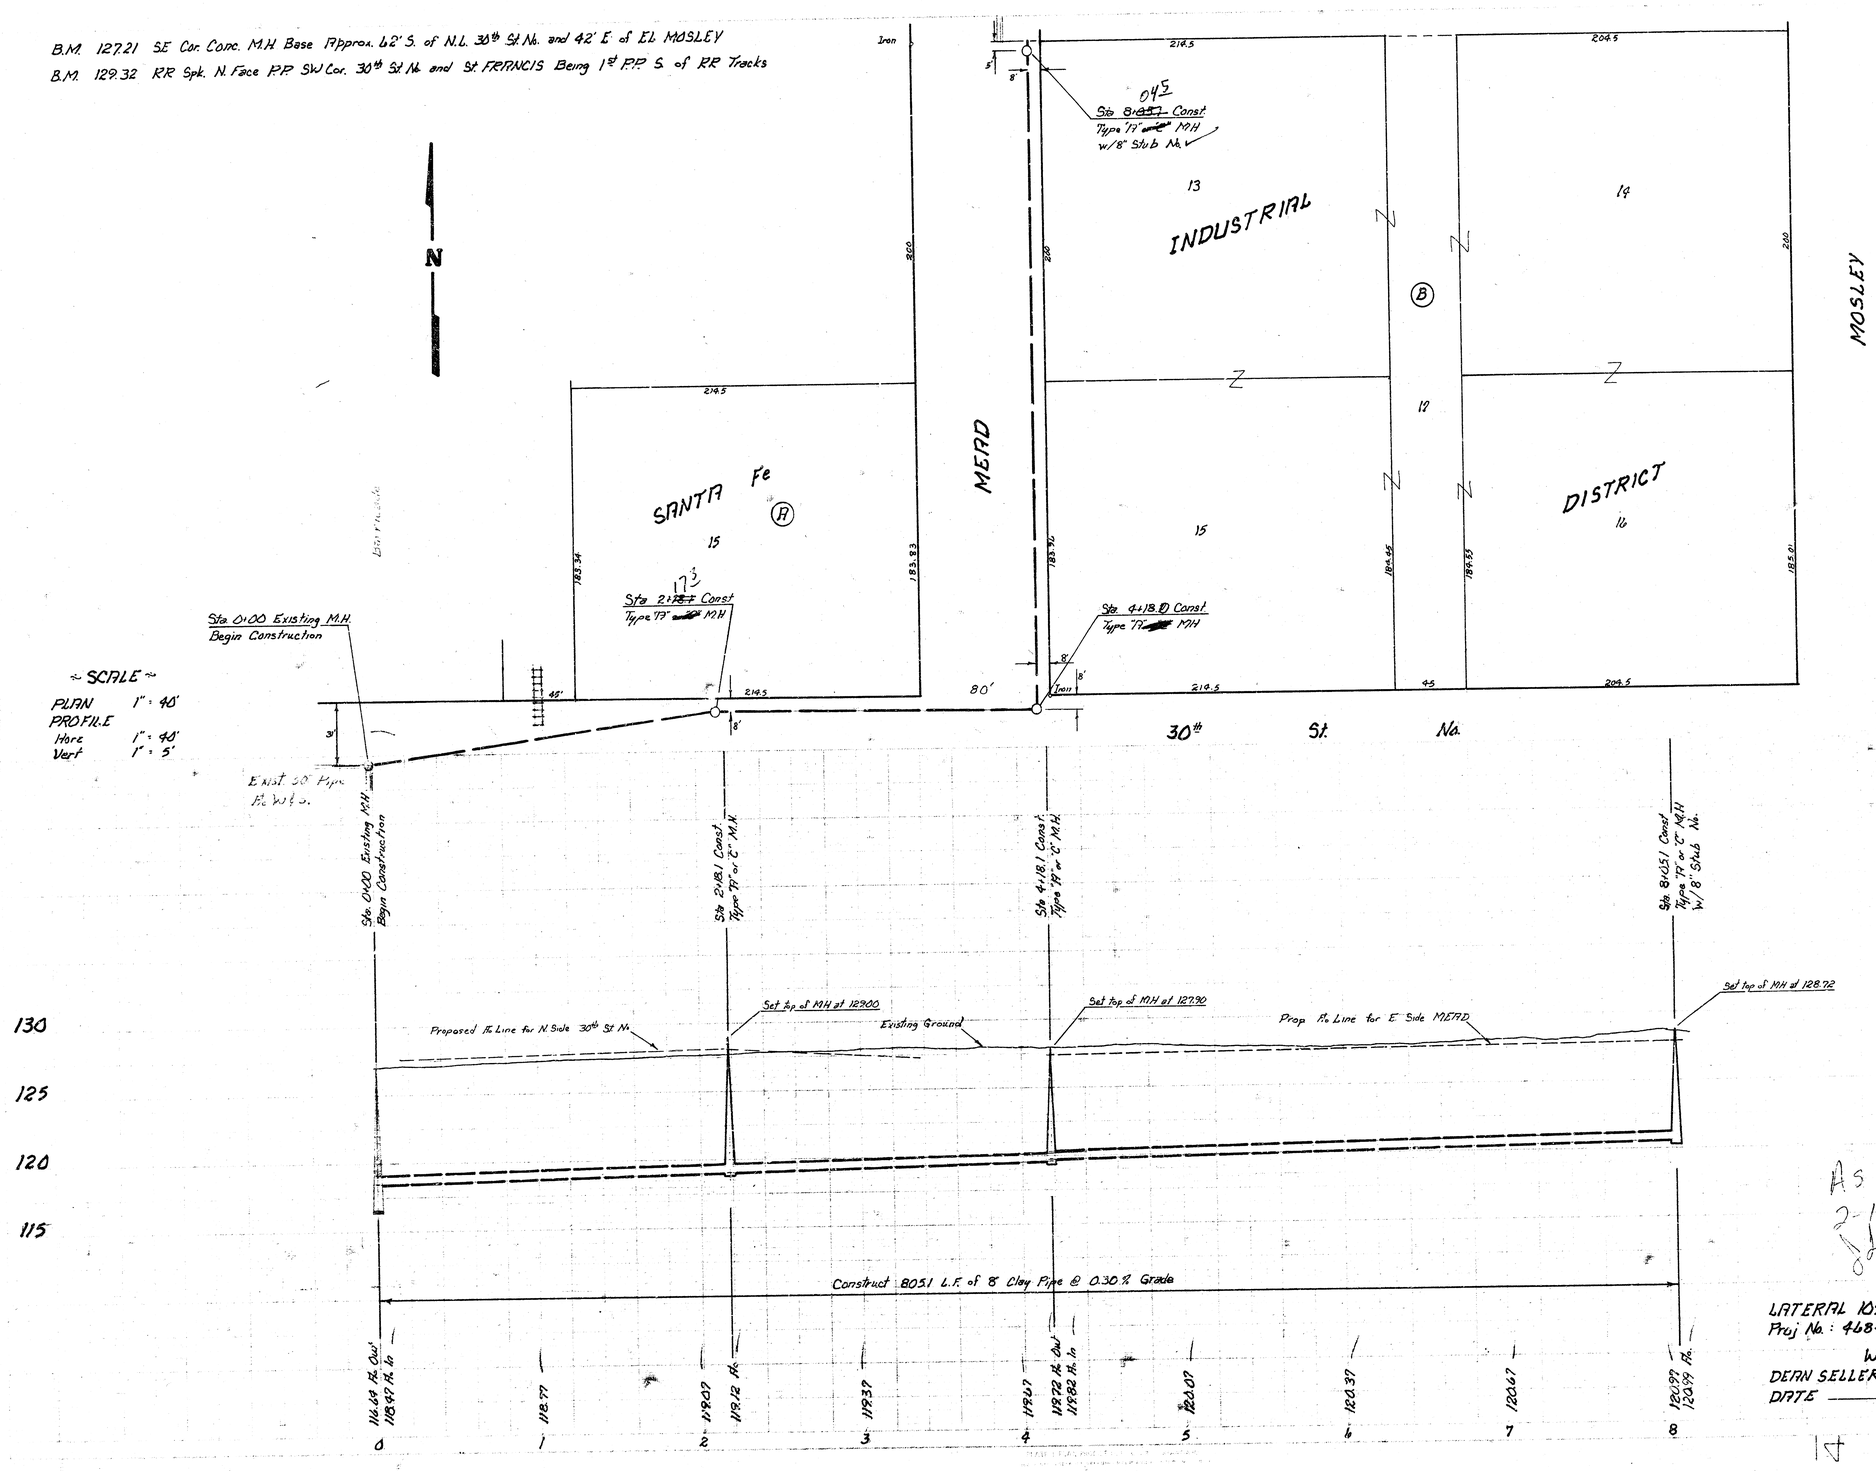

~ SCALE ~
PLAN 1" = 40'
PROFILE
Horz 1" = 40'
Vert 1" = 5'

As Built
2-17-81

LATERAL 105, MAIN 4, SANITARY SEWER 23
Proj No.: 468-76-245-80960-000-000-001
WICHITA, KANSAS
DEAN SELLERS ~ Acting CITY ENGINEER
DATE _____

DONALD E. SCHNEIDER LICENSED 6311 KANSAS PROFESSIONAL ENGINEER