

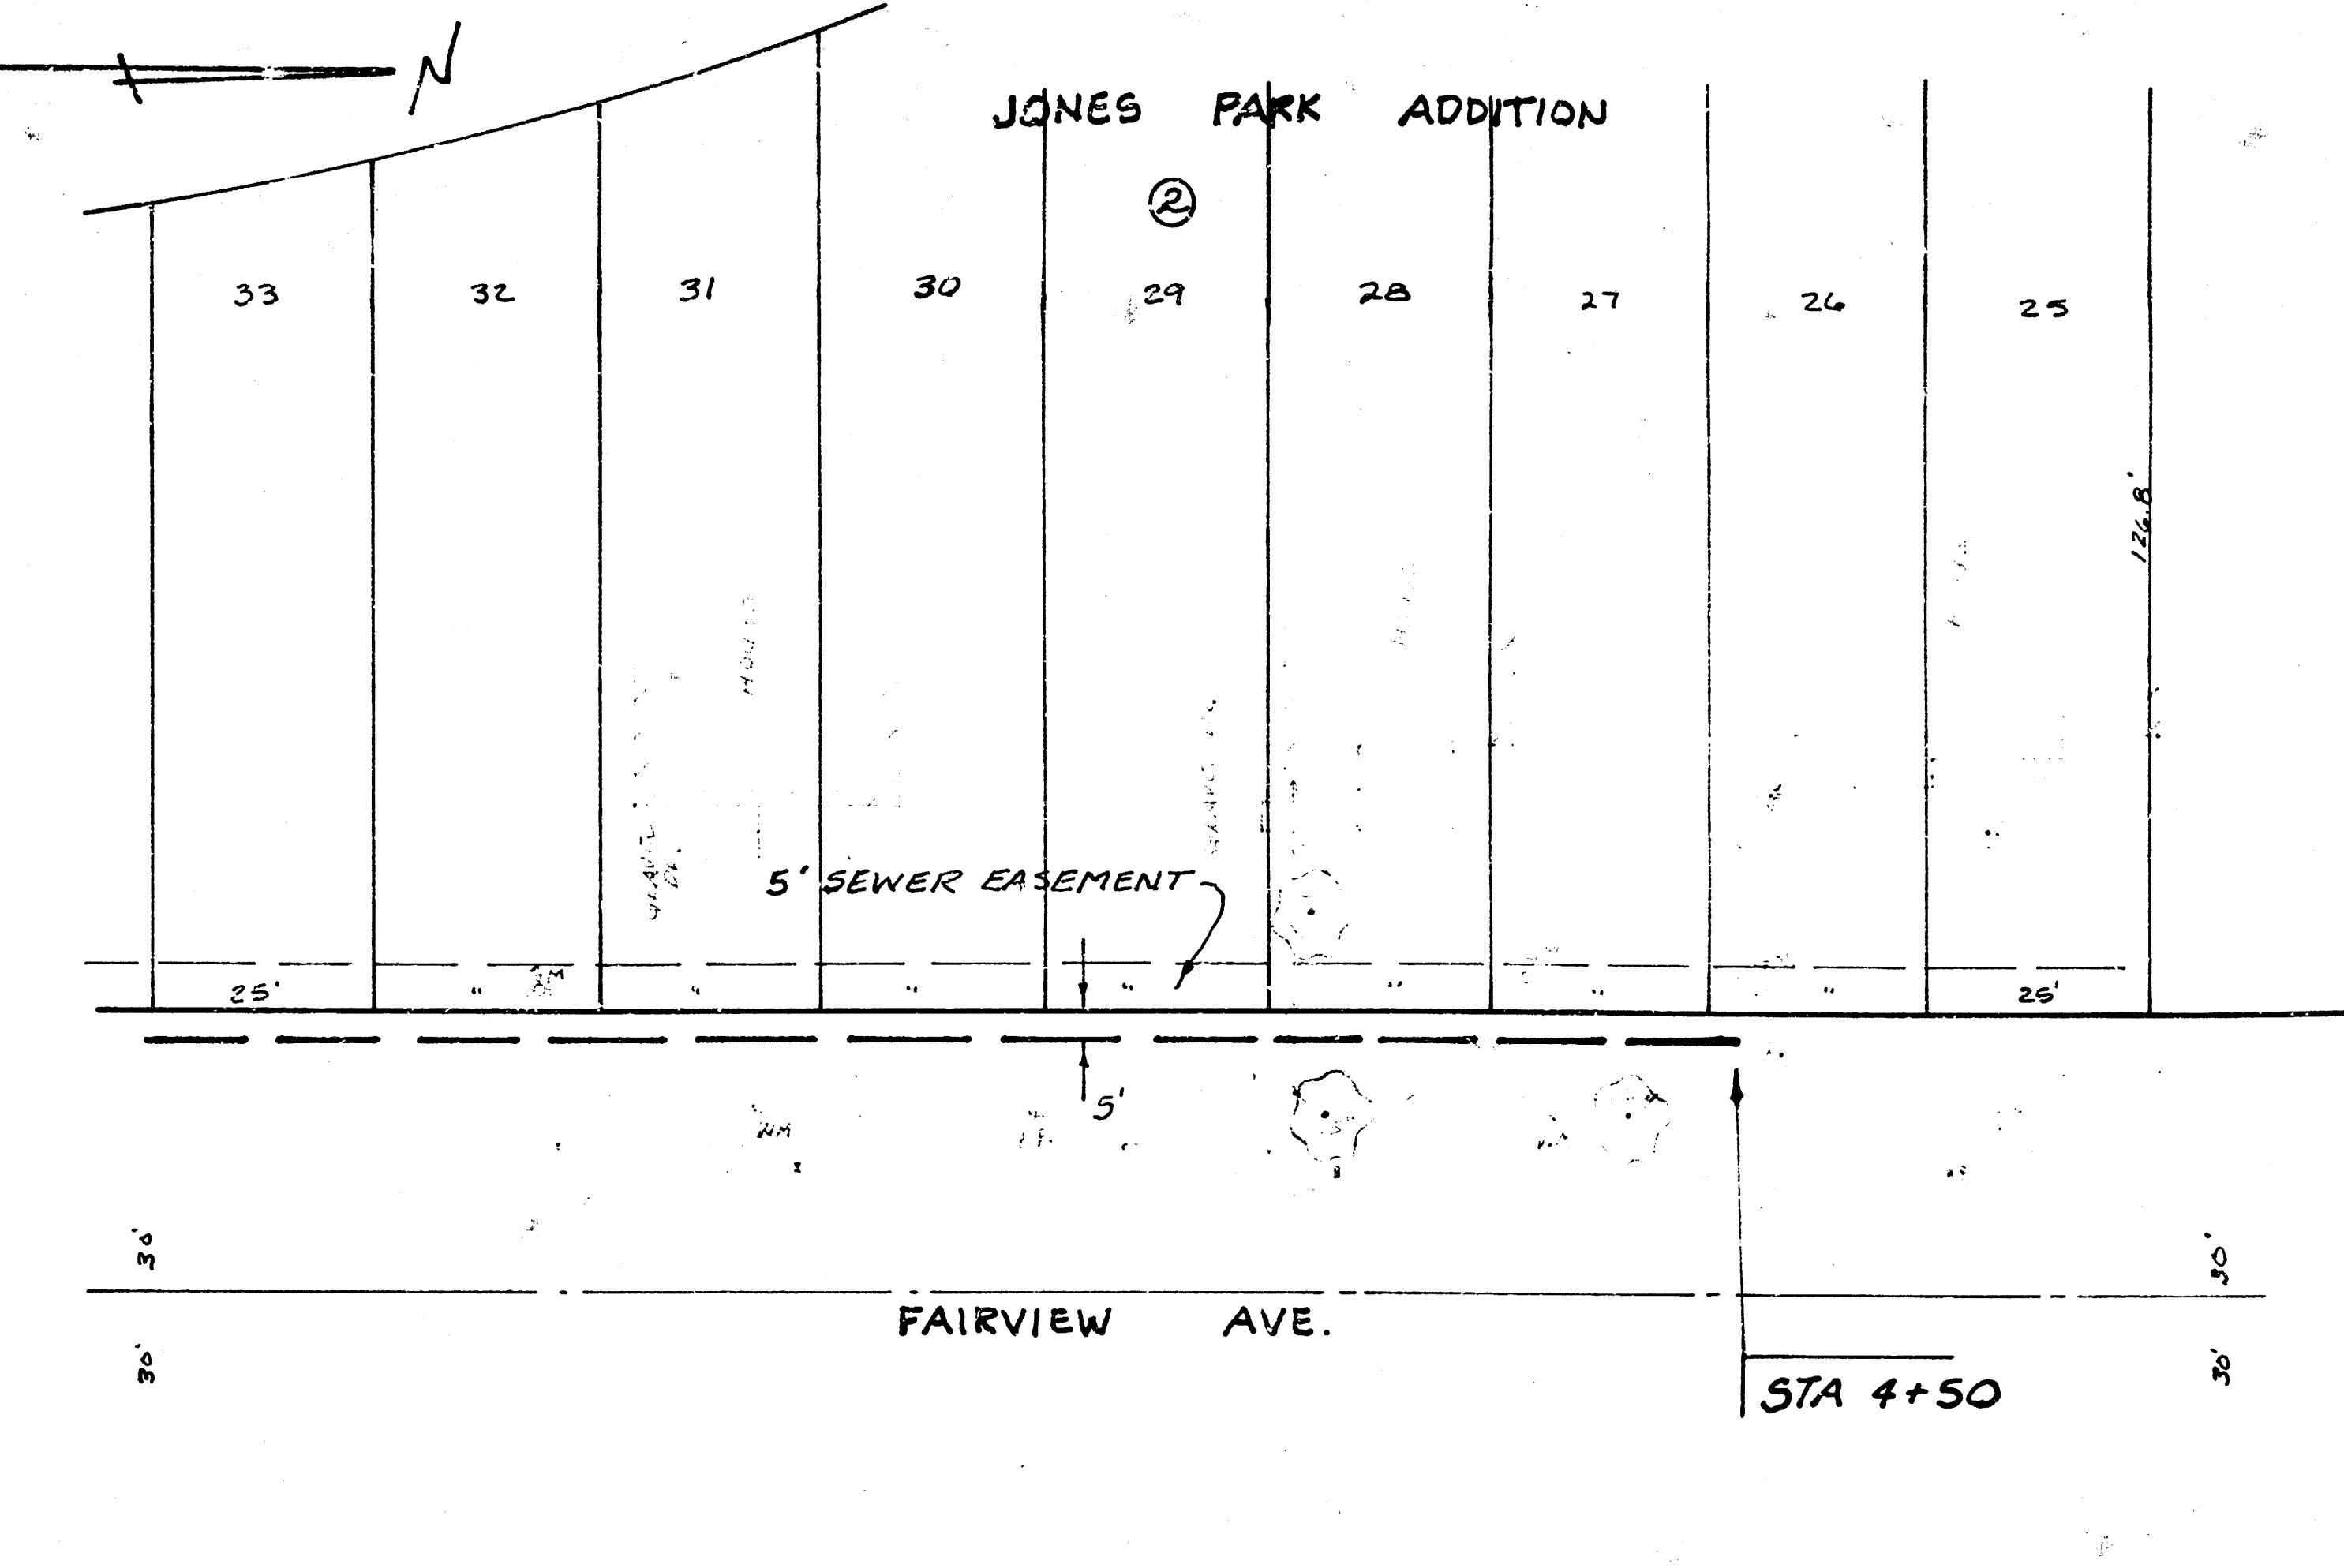
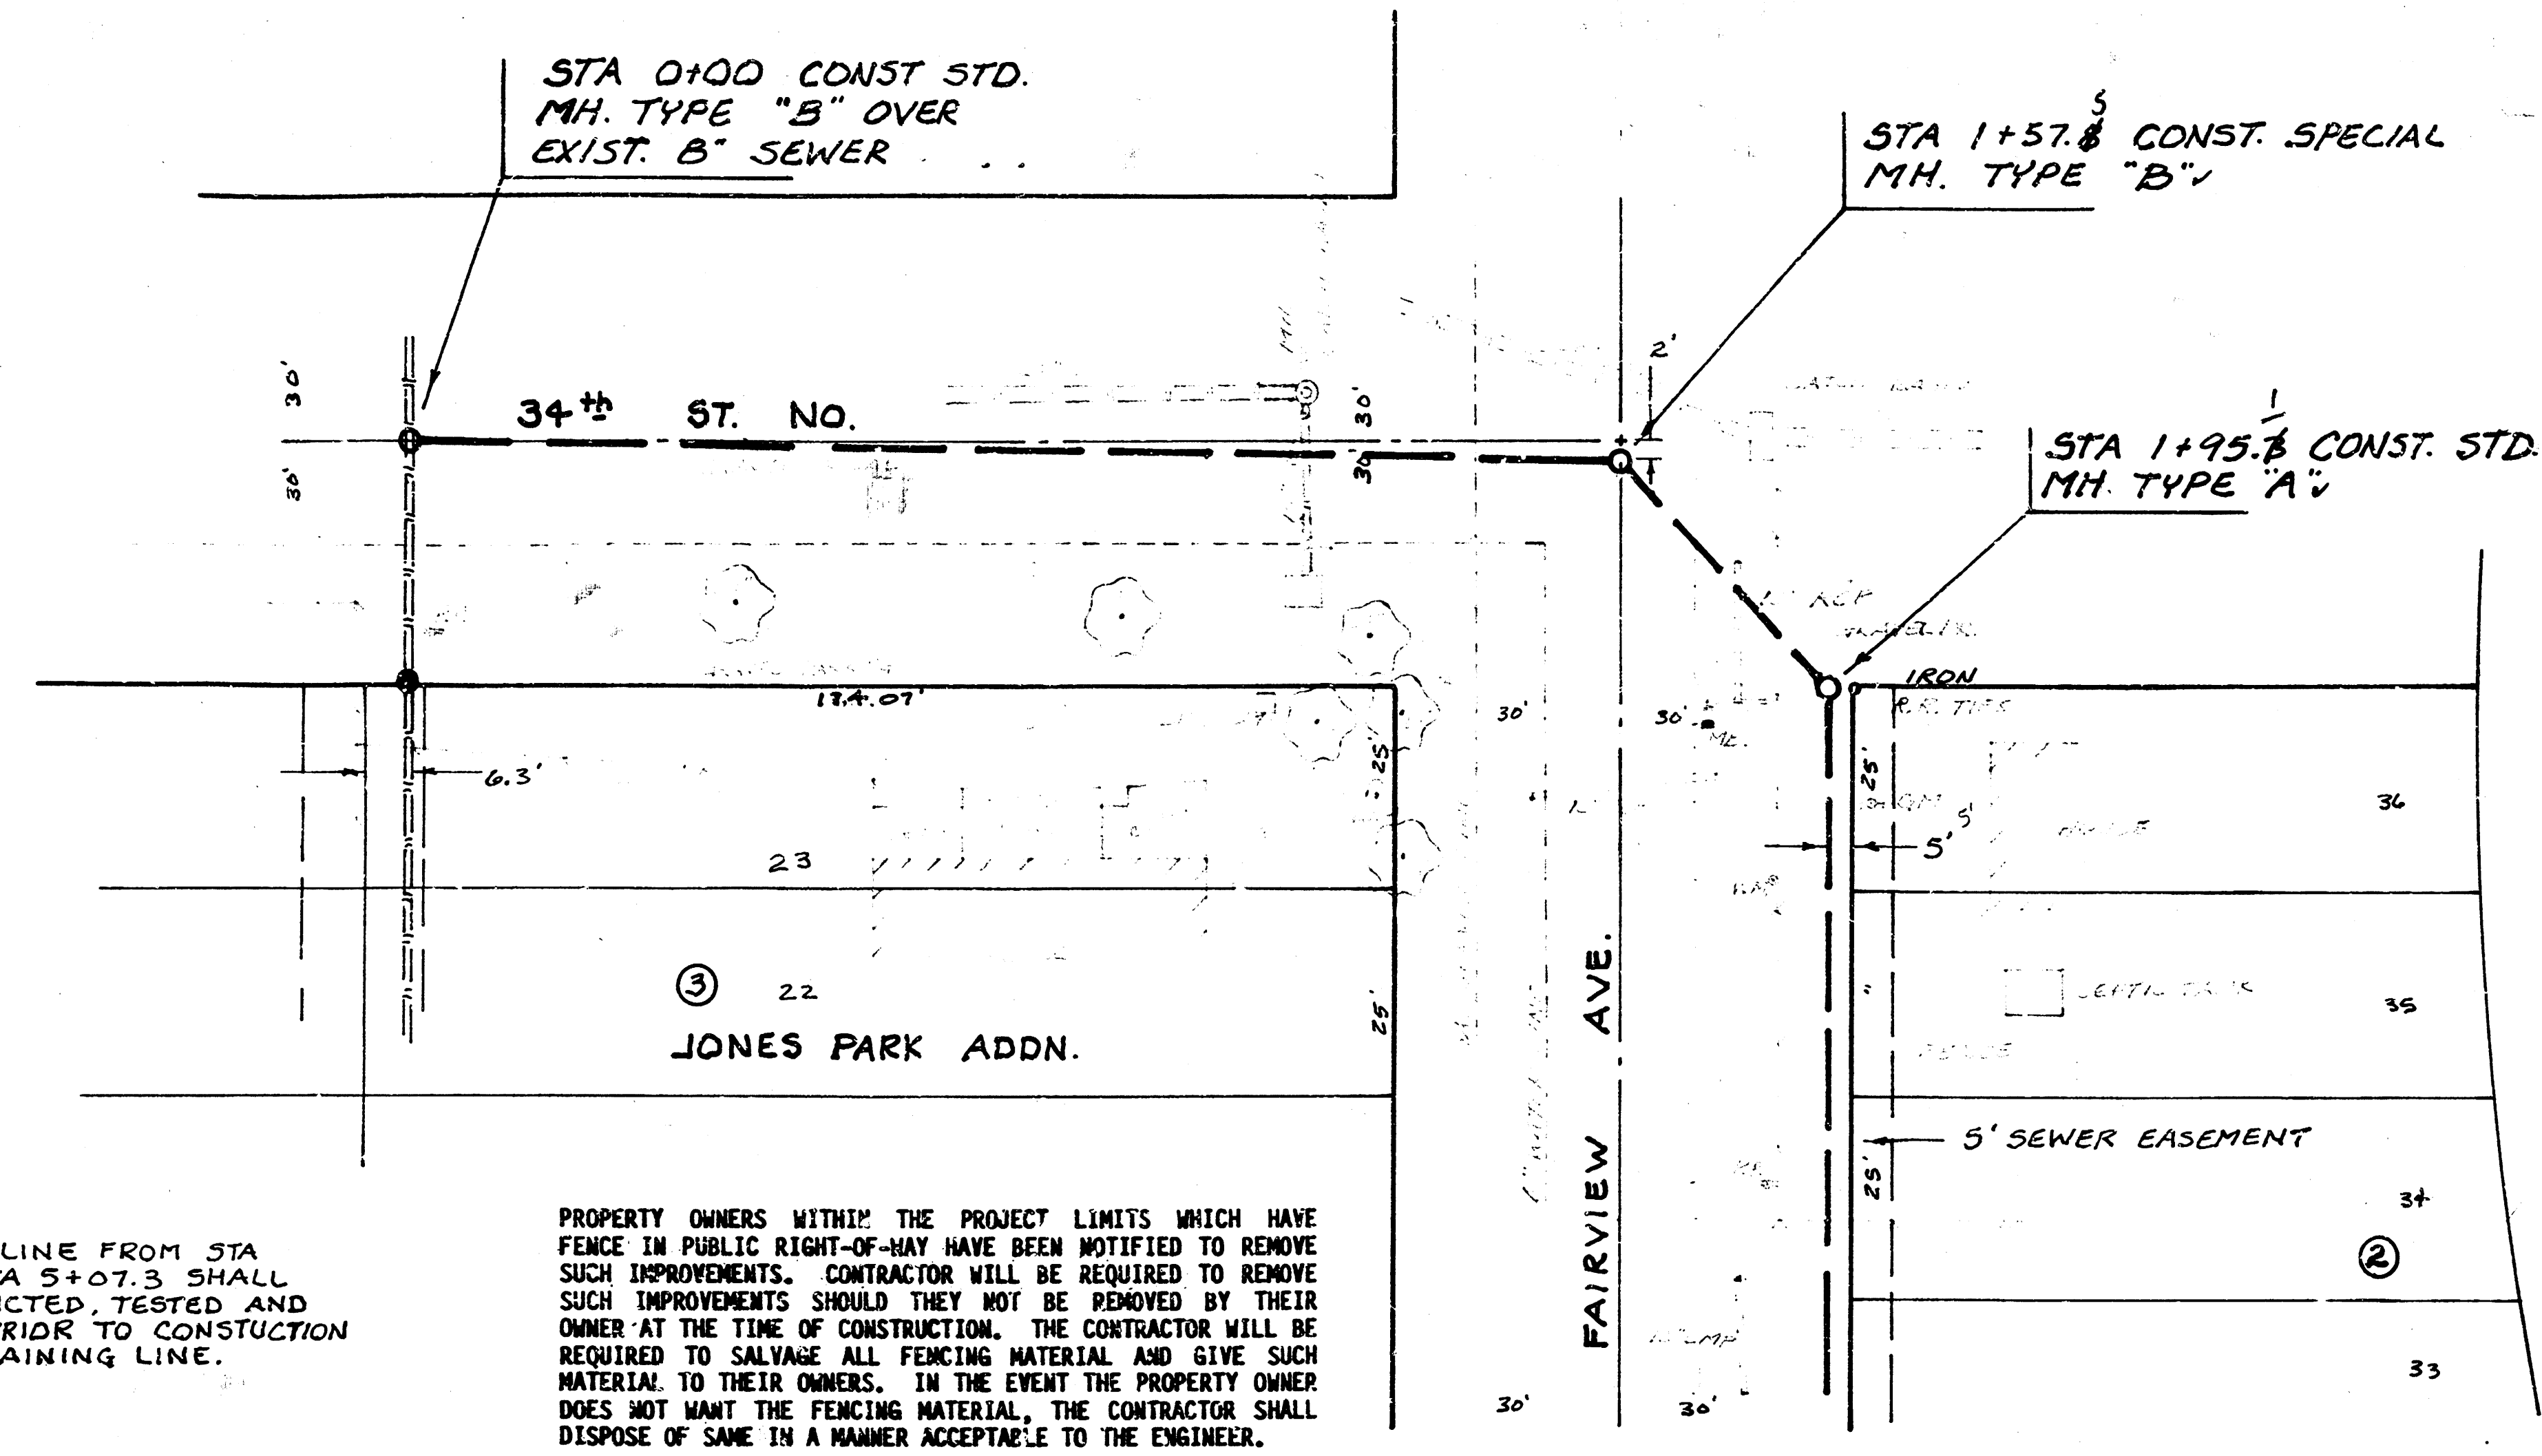


SCALE PLAN 1" = 20' HORIZ. PROFILE 1" = 5' VERT.

NOTE: CONTRACTOR TO NOTIFY ALL PROPERTY OWNERS 48 HRS. PRIOR TO CONSTRUCTION.



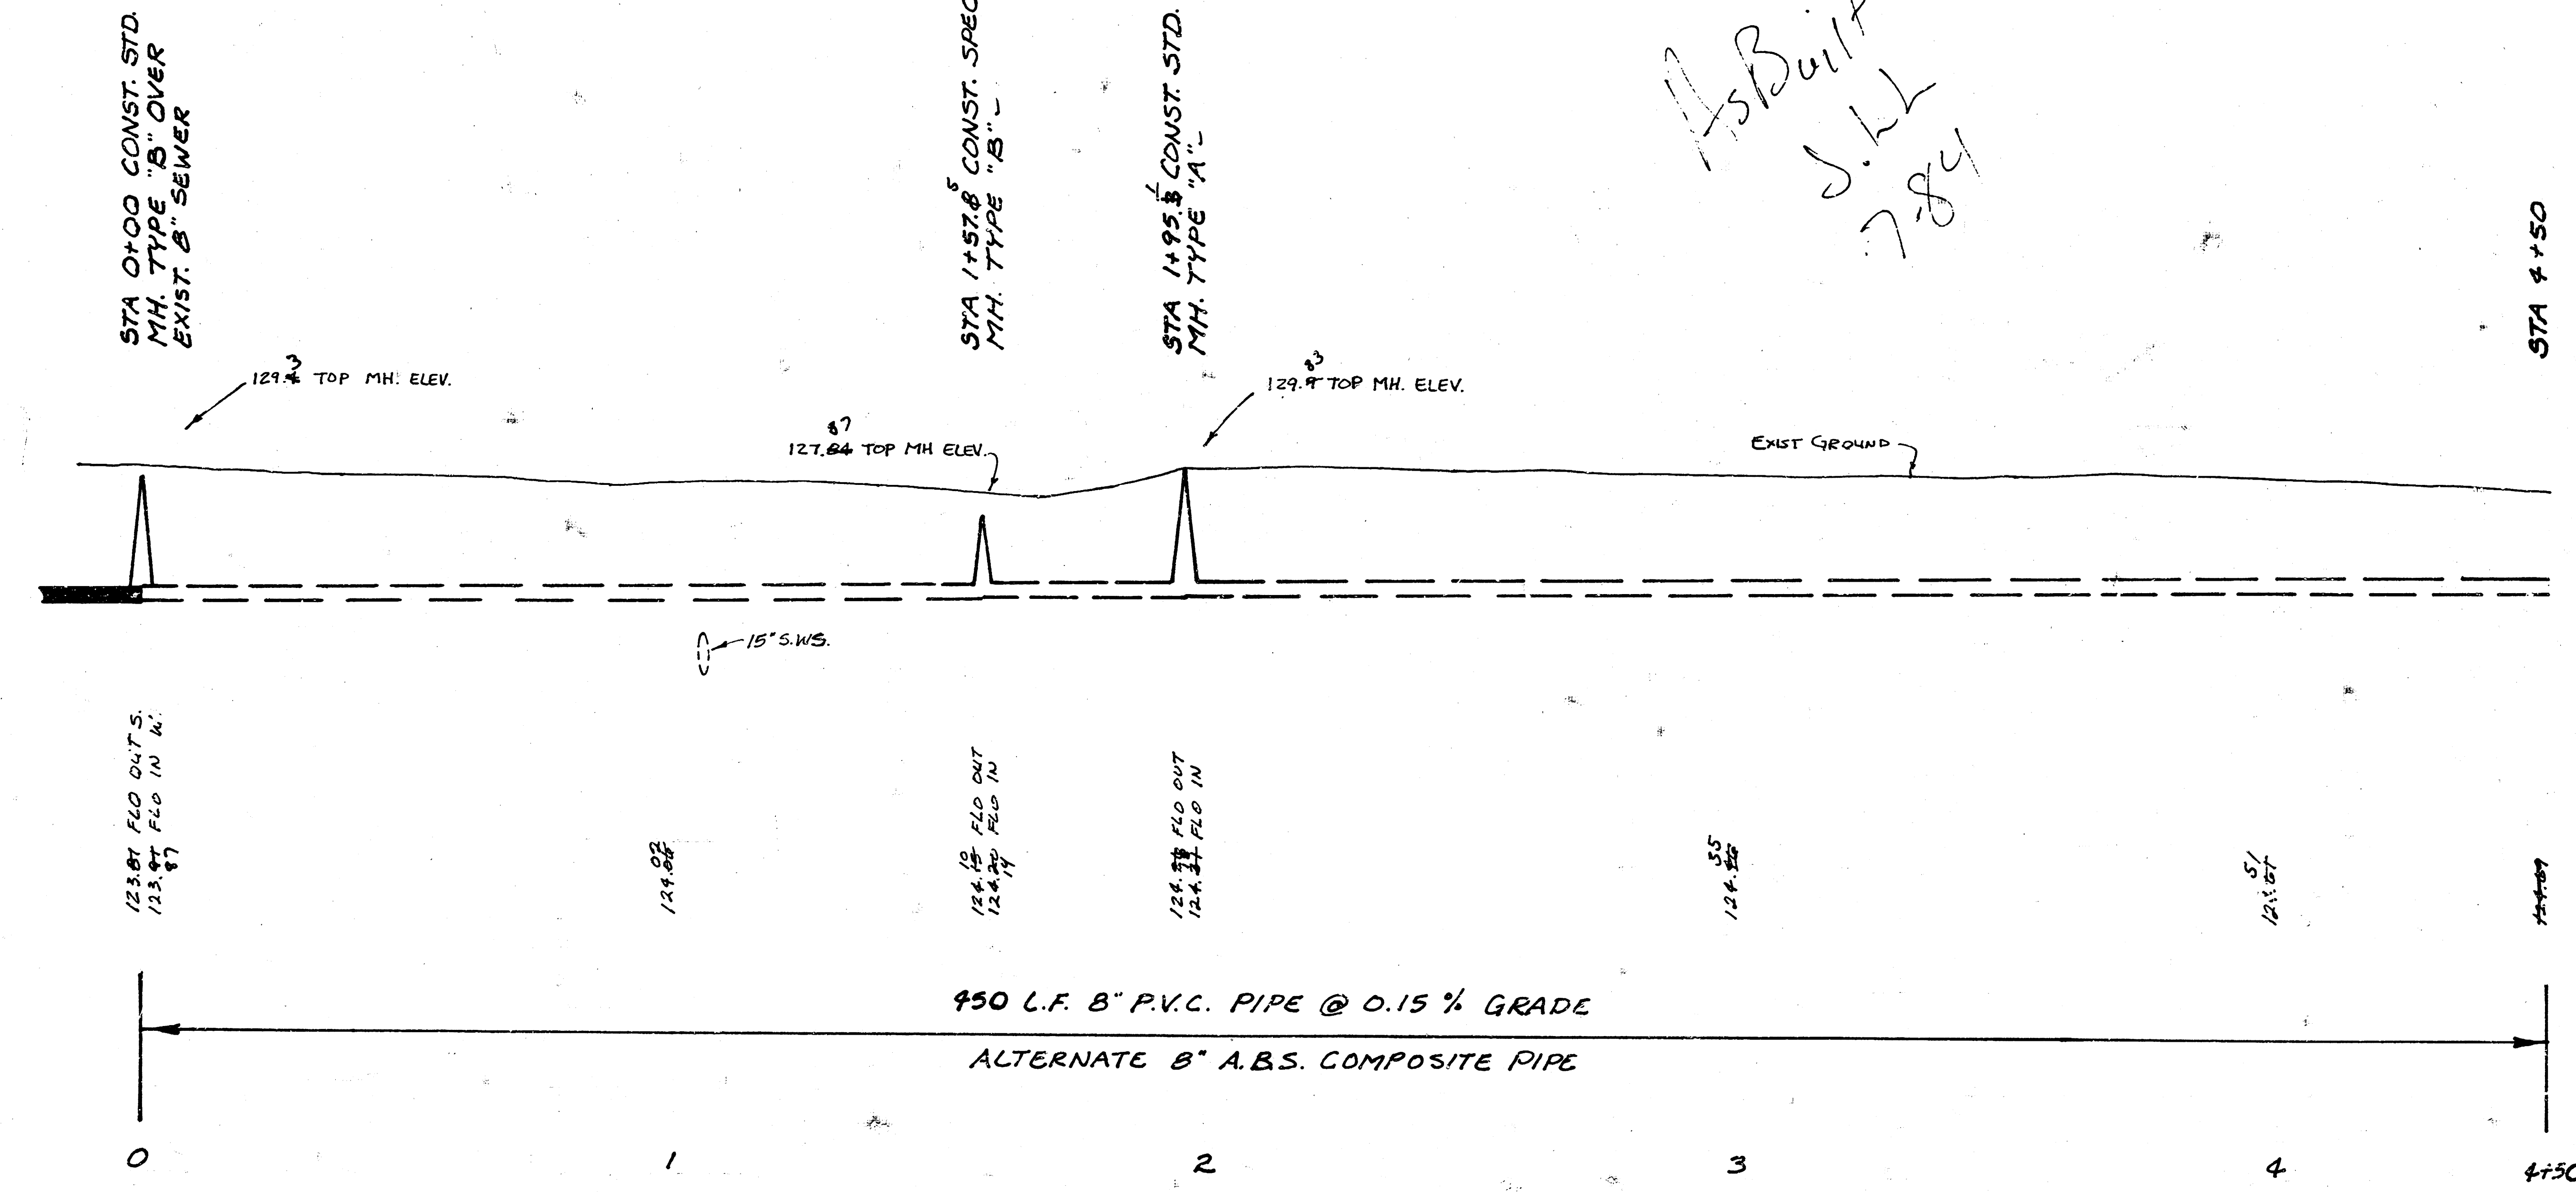


- BM. 130.25 R.R. SPIKE N. FACE P.P. S. SIDE OF 34th ST. NO. 135 FT. E. OF E.L. FAIRVIEW.
- BM. 129.24 R.R. SPIKE W. FACE P.P. WEST SIDE OF FAIRVIEW 2nd P.P. N. OF N.L. 34th ST. NO.
- BM. 129.56 R.R. SPIKE S. FACE P.P. NORTH SIDE 35th ST. NO. 2nd P.P. W. OF FAIRVIEW.

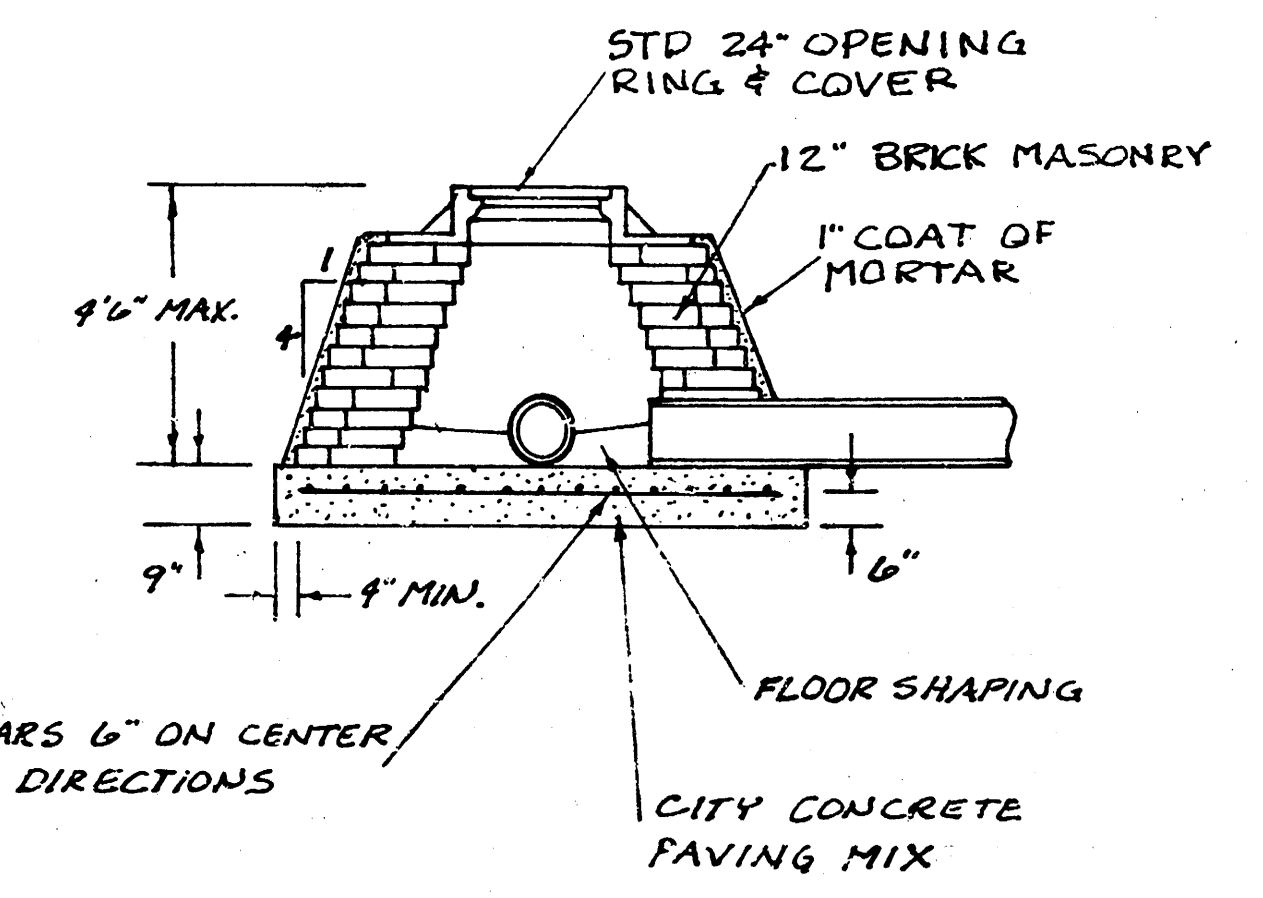

PROJECT DESCRIPTION	
LAT. 110, MAIN 4, S. S. NO. 23	
PROJECT NUMBER	
468-76-245-81258-000-001	
BOOK NO. JLA-35	APPROVED BY
DRAWN BY LDM15	DATE
CITY OF WICHITA	
DEPARTMENT OF ENGINEERING	
M. E. LINDEBAK - CITY ENGINEER	

SCALE PLAN 1" = 20' HORIZ.
 PROFILE 1" = 20' HORIZ.
 1" = 5' VERT.

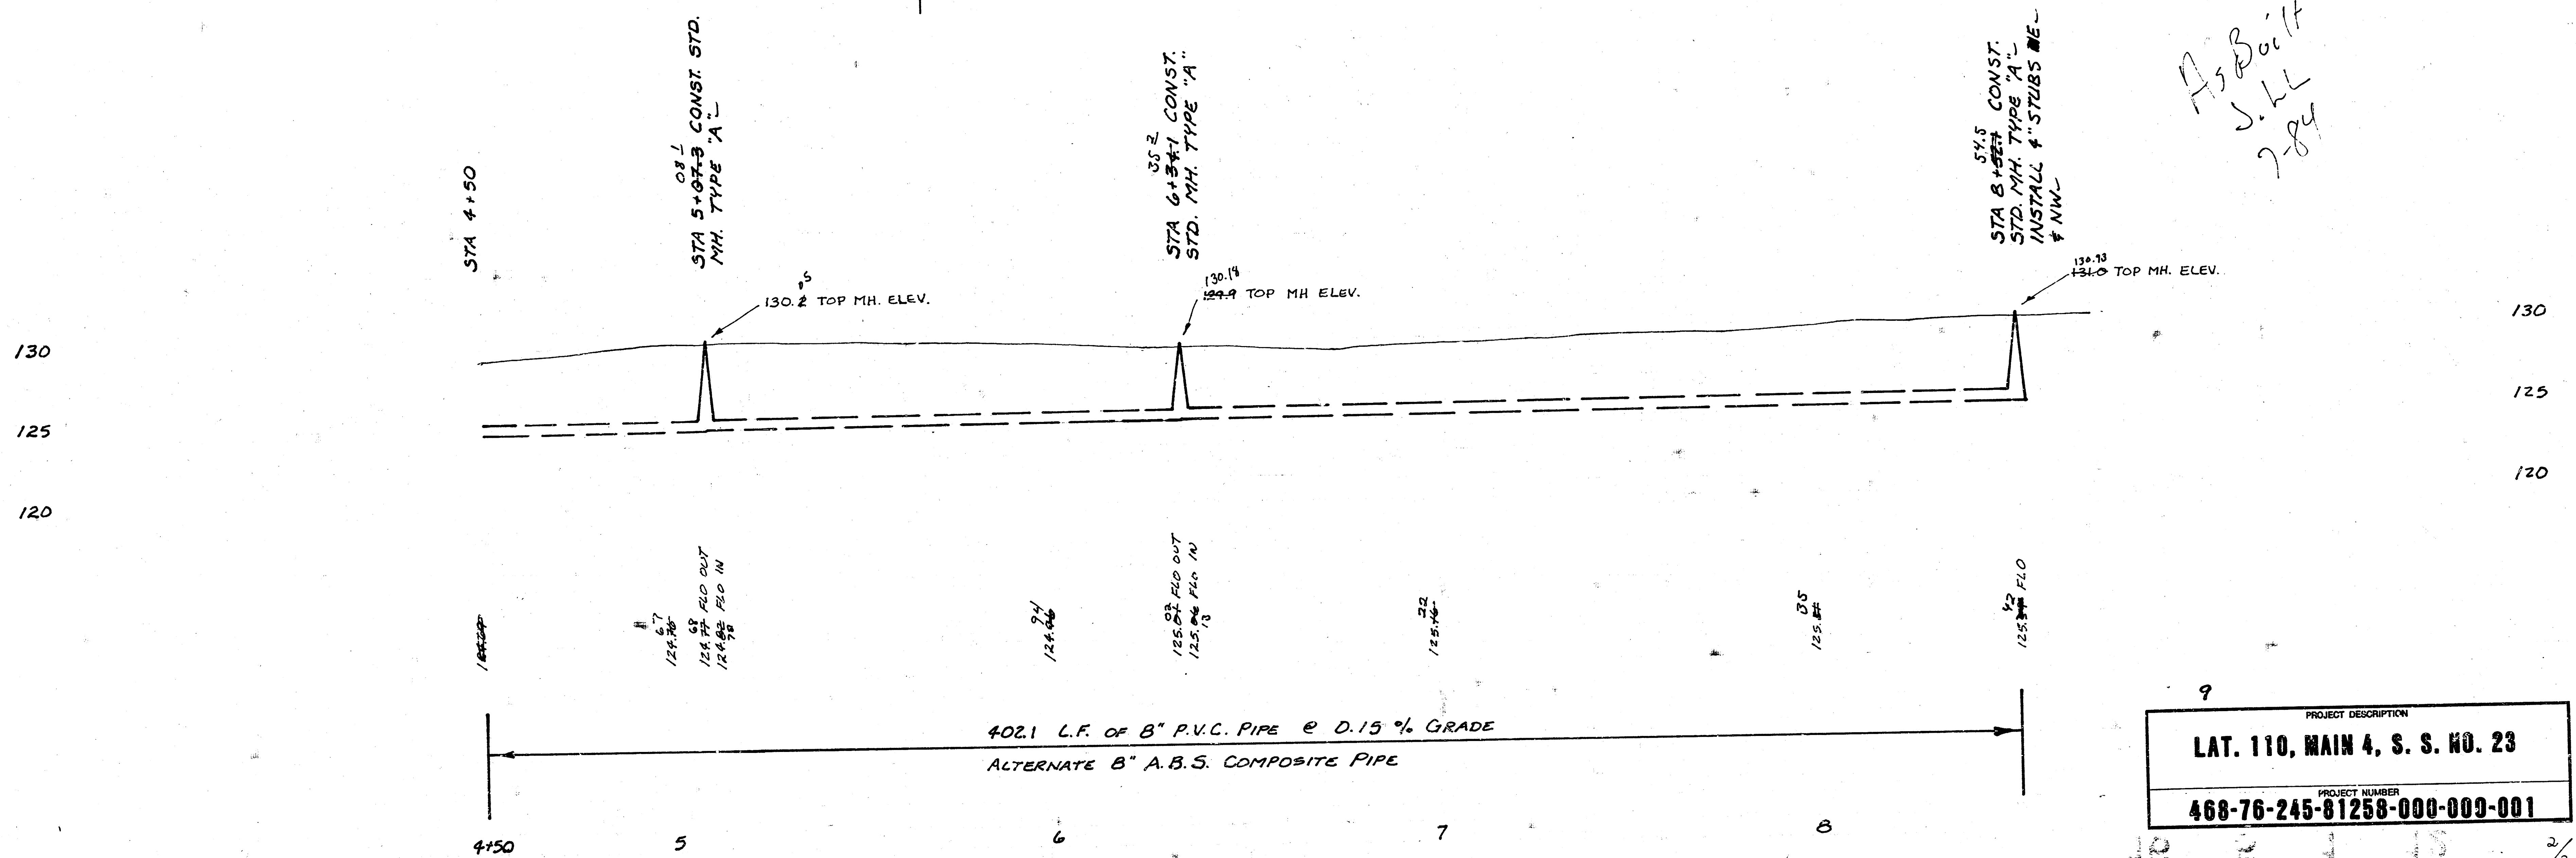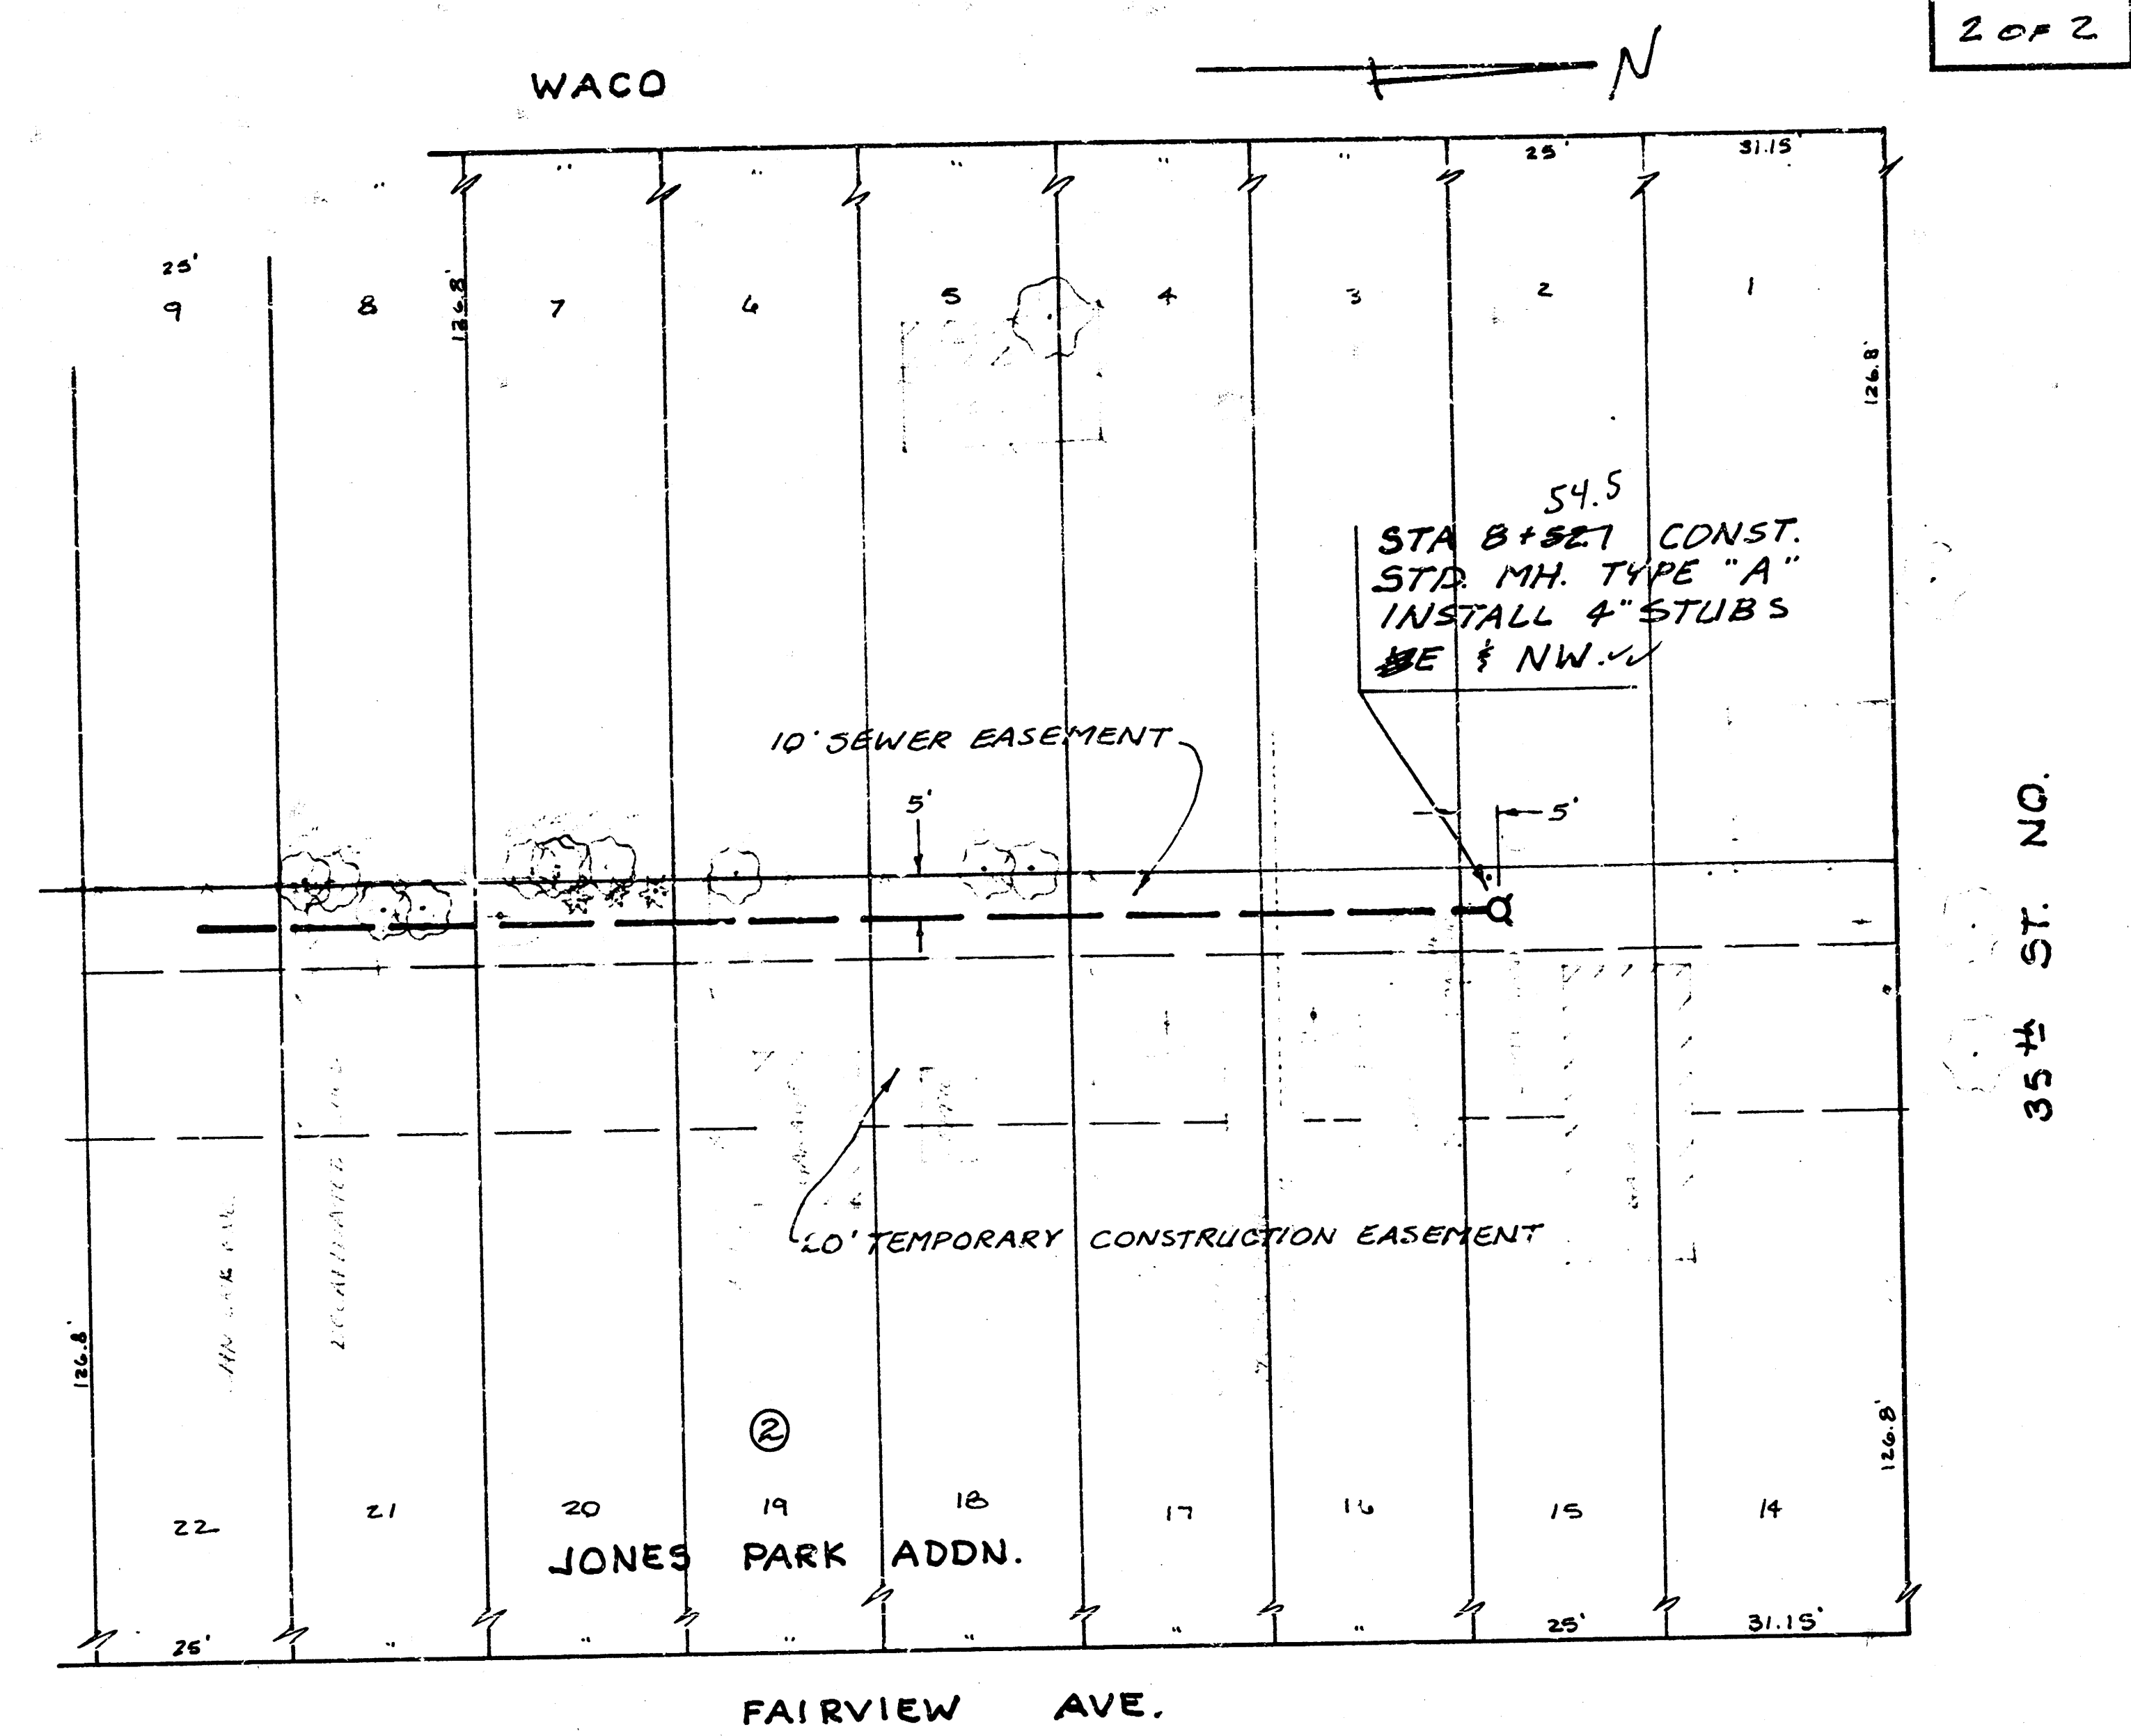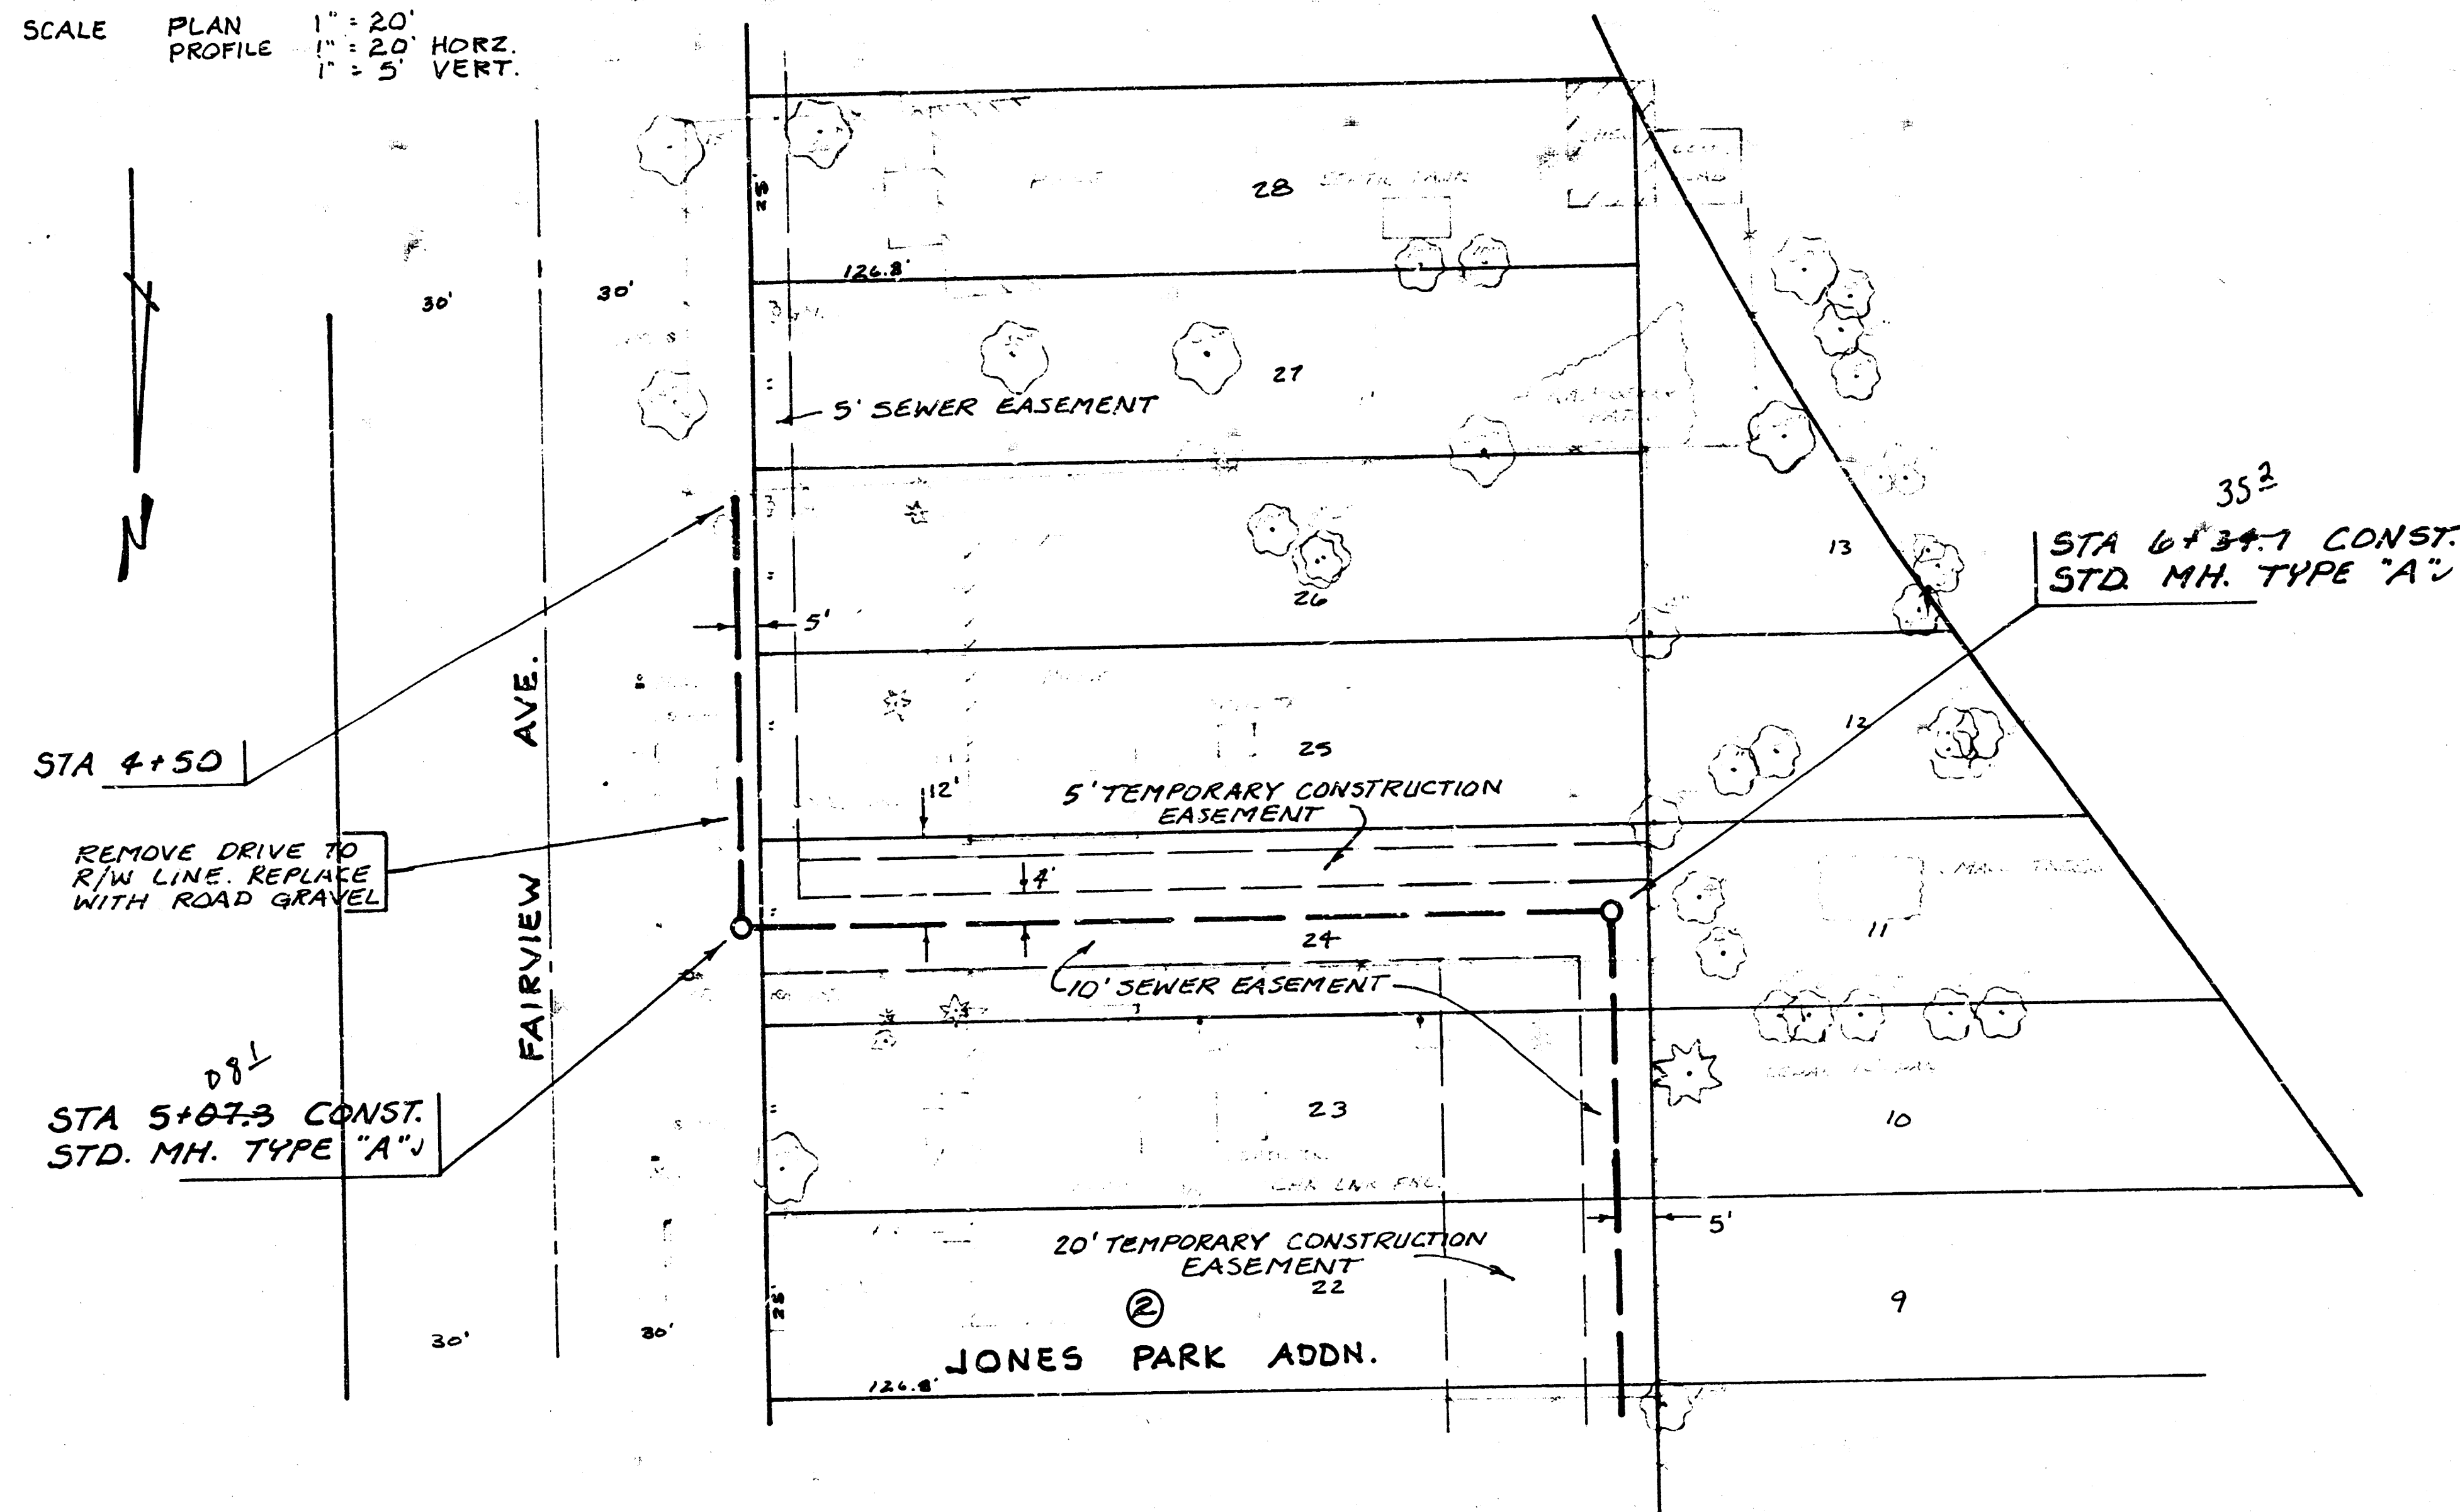

PROJECT DESCRIPTION
 LAT. 110, MAIN 4, S. S. NO. 23
 PROJECT NUMBER
 468-76-245-81258-000-000-001

FILMED FROM THE BEST
 AVAILABLE COPY