

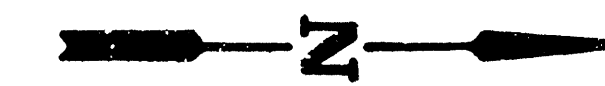


SHEET
1 of 1

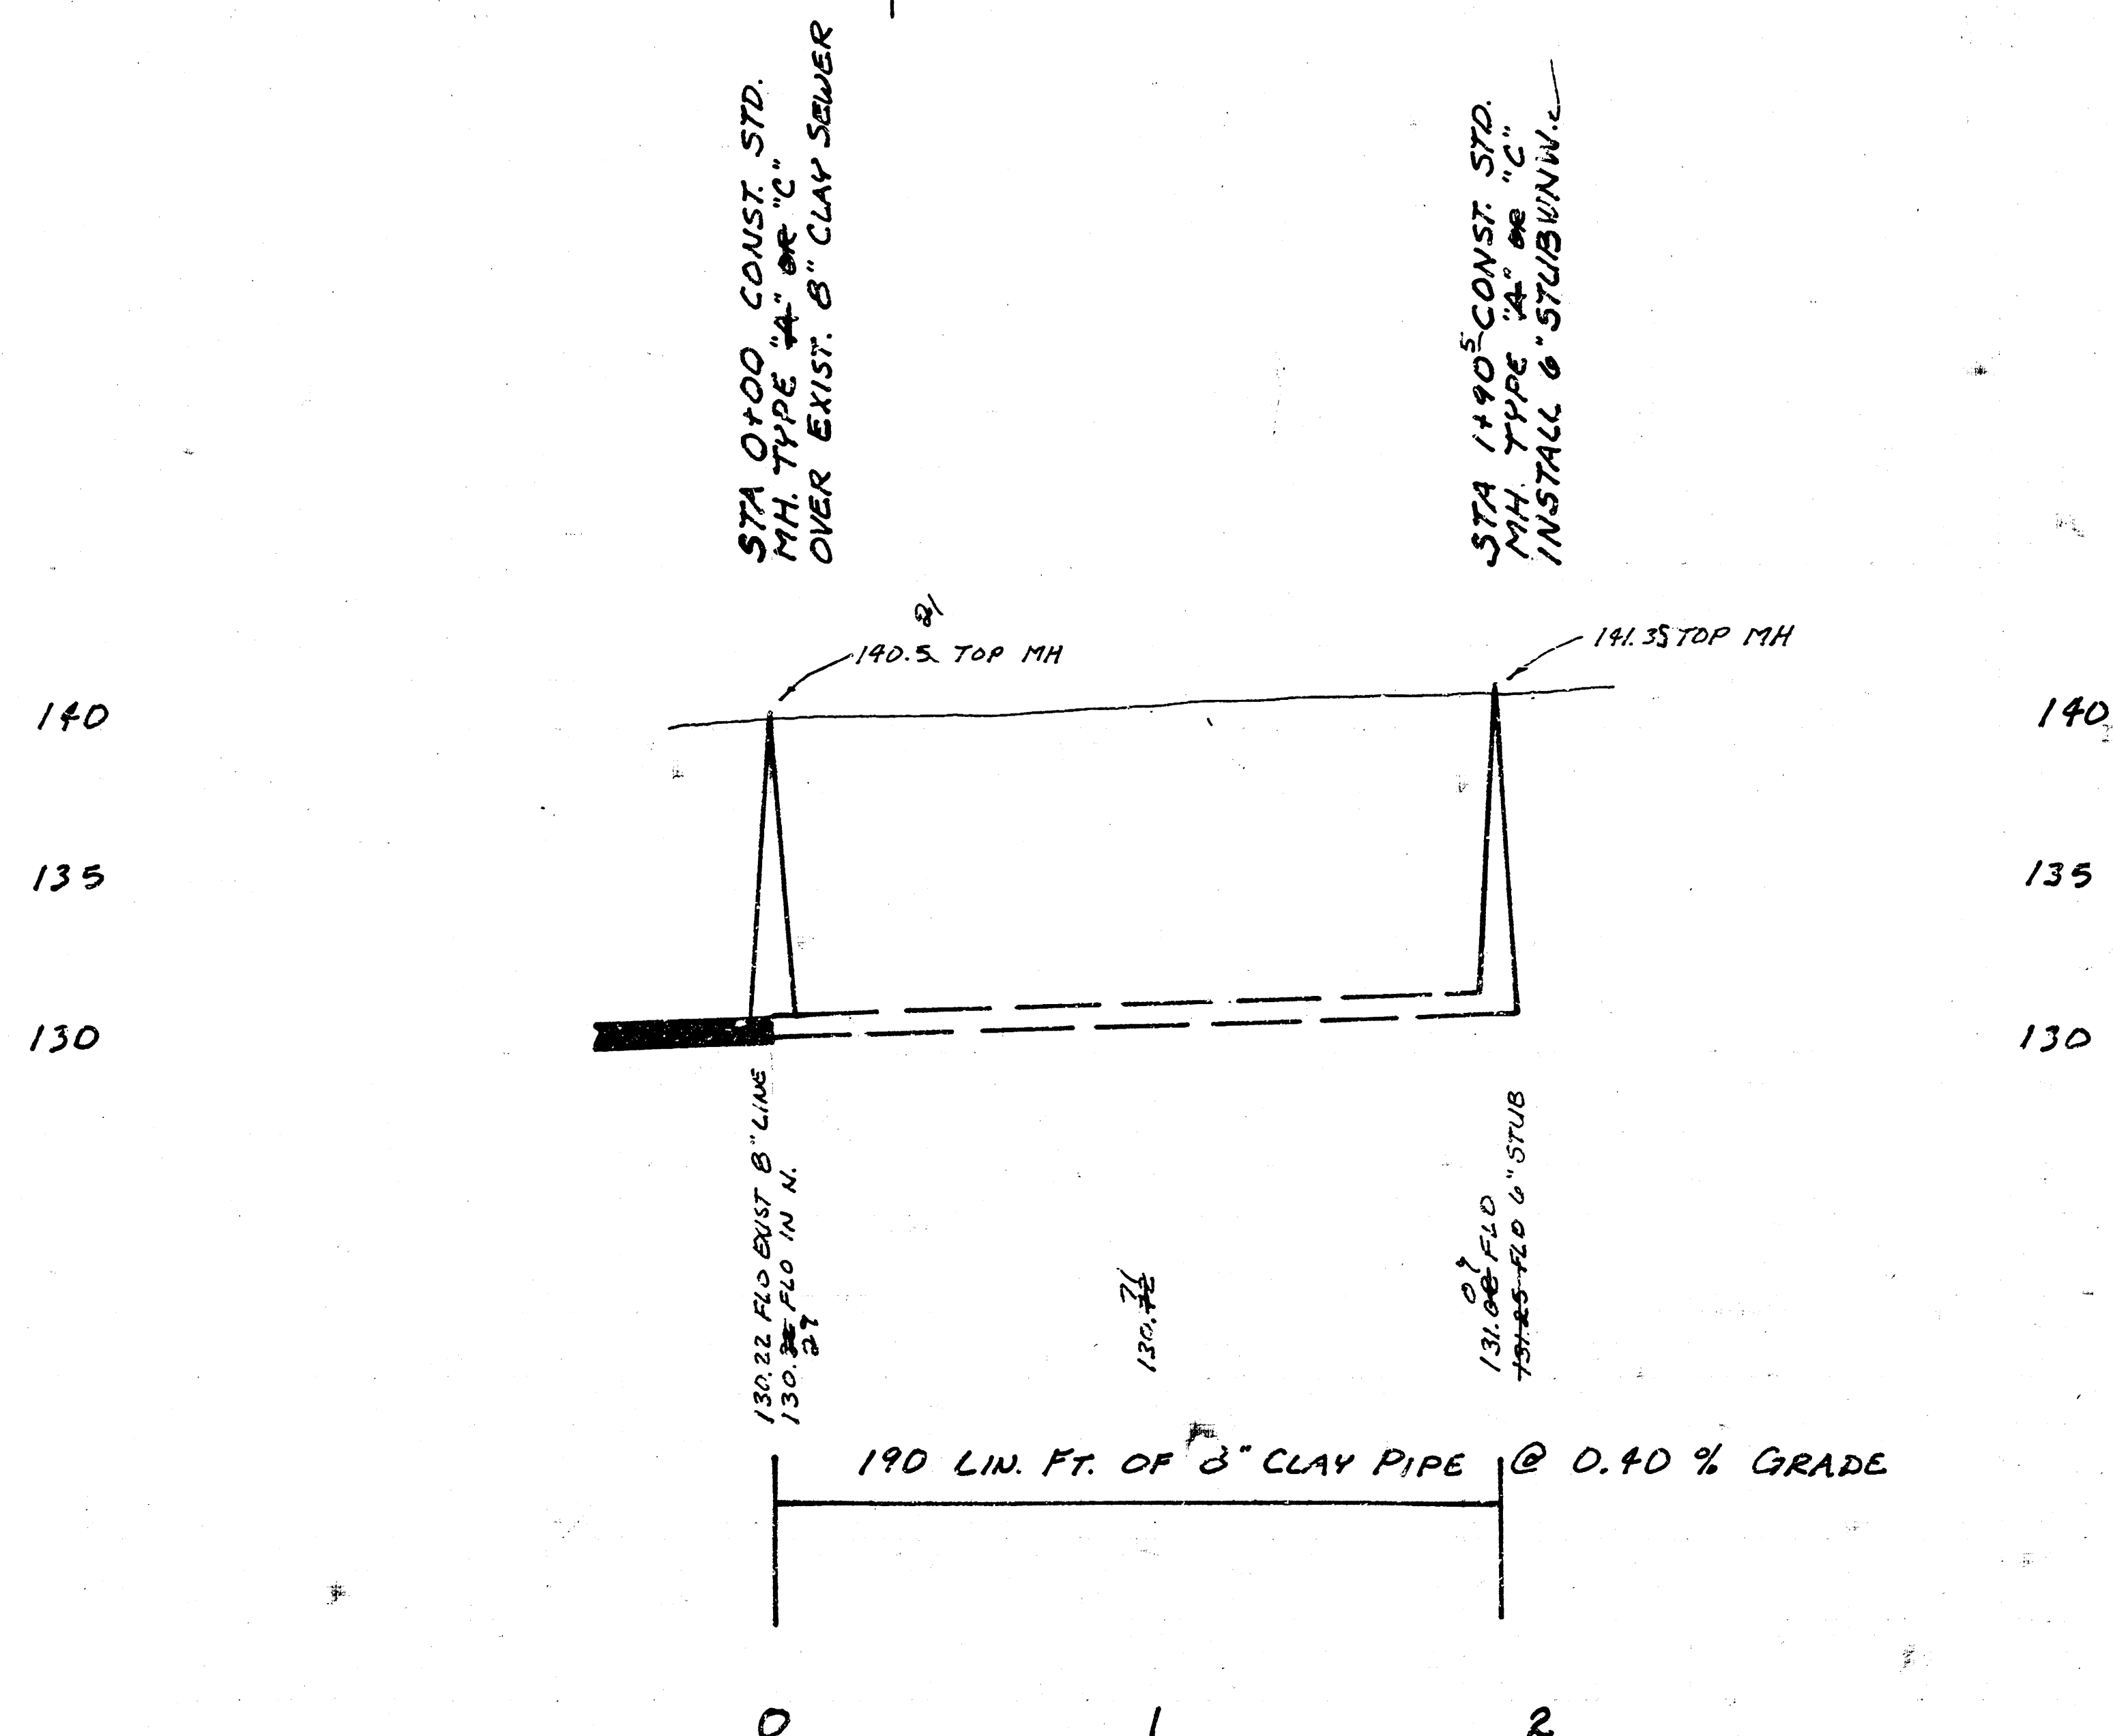

SCALE PLAN 1" = 40'
PROFILE 1" = 40' HORIZ.
1" = 5' VERT.

THE CONTRACTOR SHALL BE RESPONSIBLE FOR PRESERVING PROPERTY IRONS. THE CONTRACTOR SHALL BE REQUIRED TO RE-ESTABLISH ANY PROPERTY IRONS WHICH ARE DAMAGED OR DESTROYED BY HIS CONSTRUCTION OPERATIONS. SUCH IRONS SHALL BE RE-ESTABLISHED BY A LICENSED LAND SURVEYOR OR A LICENSED PROFESSIONAL ENGINEER IN ACCORDANCE WITH STATE LAWS.

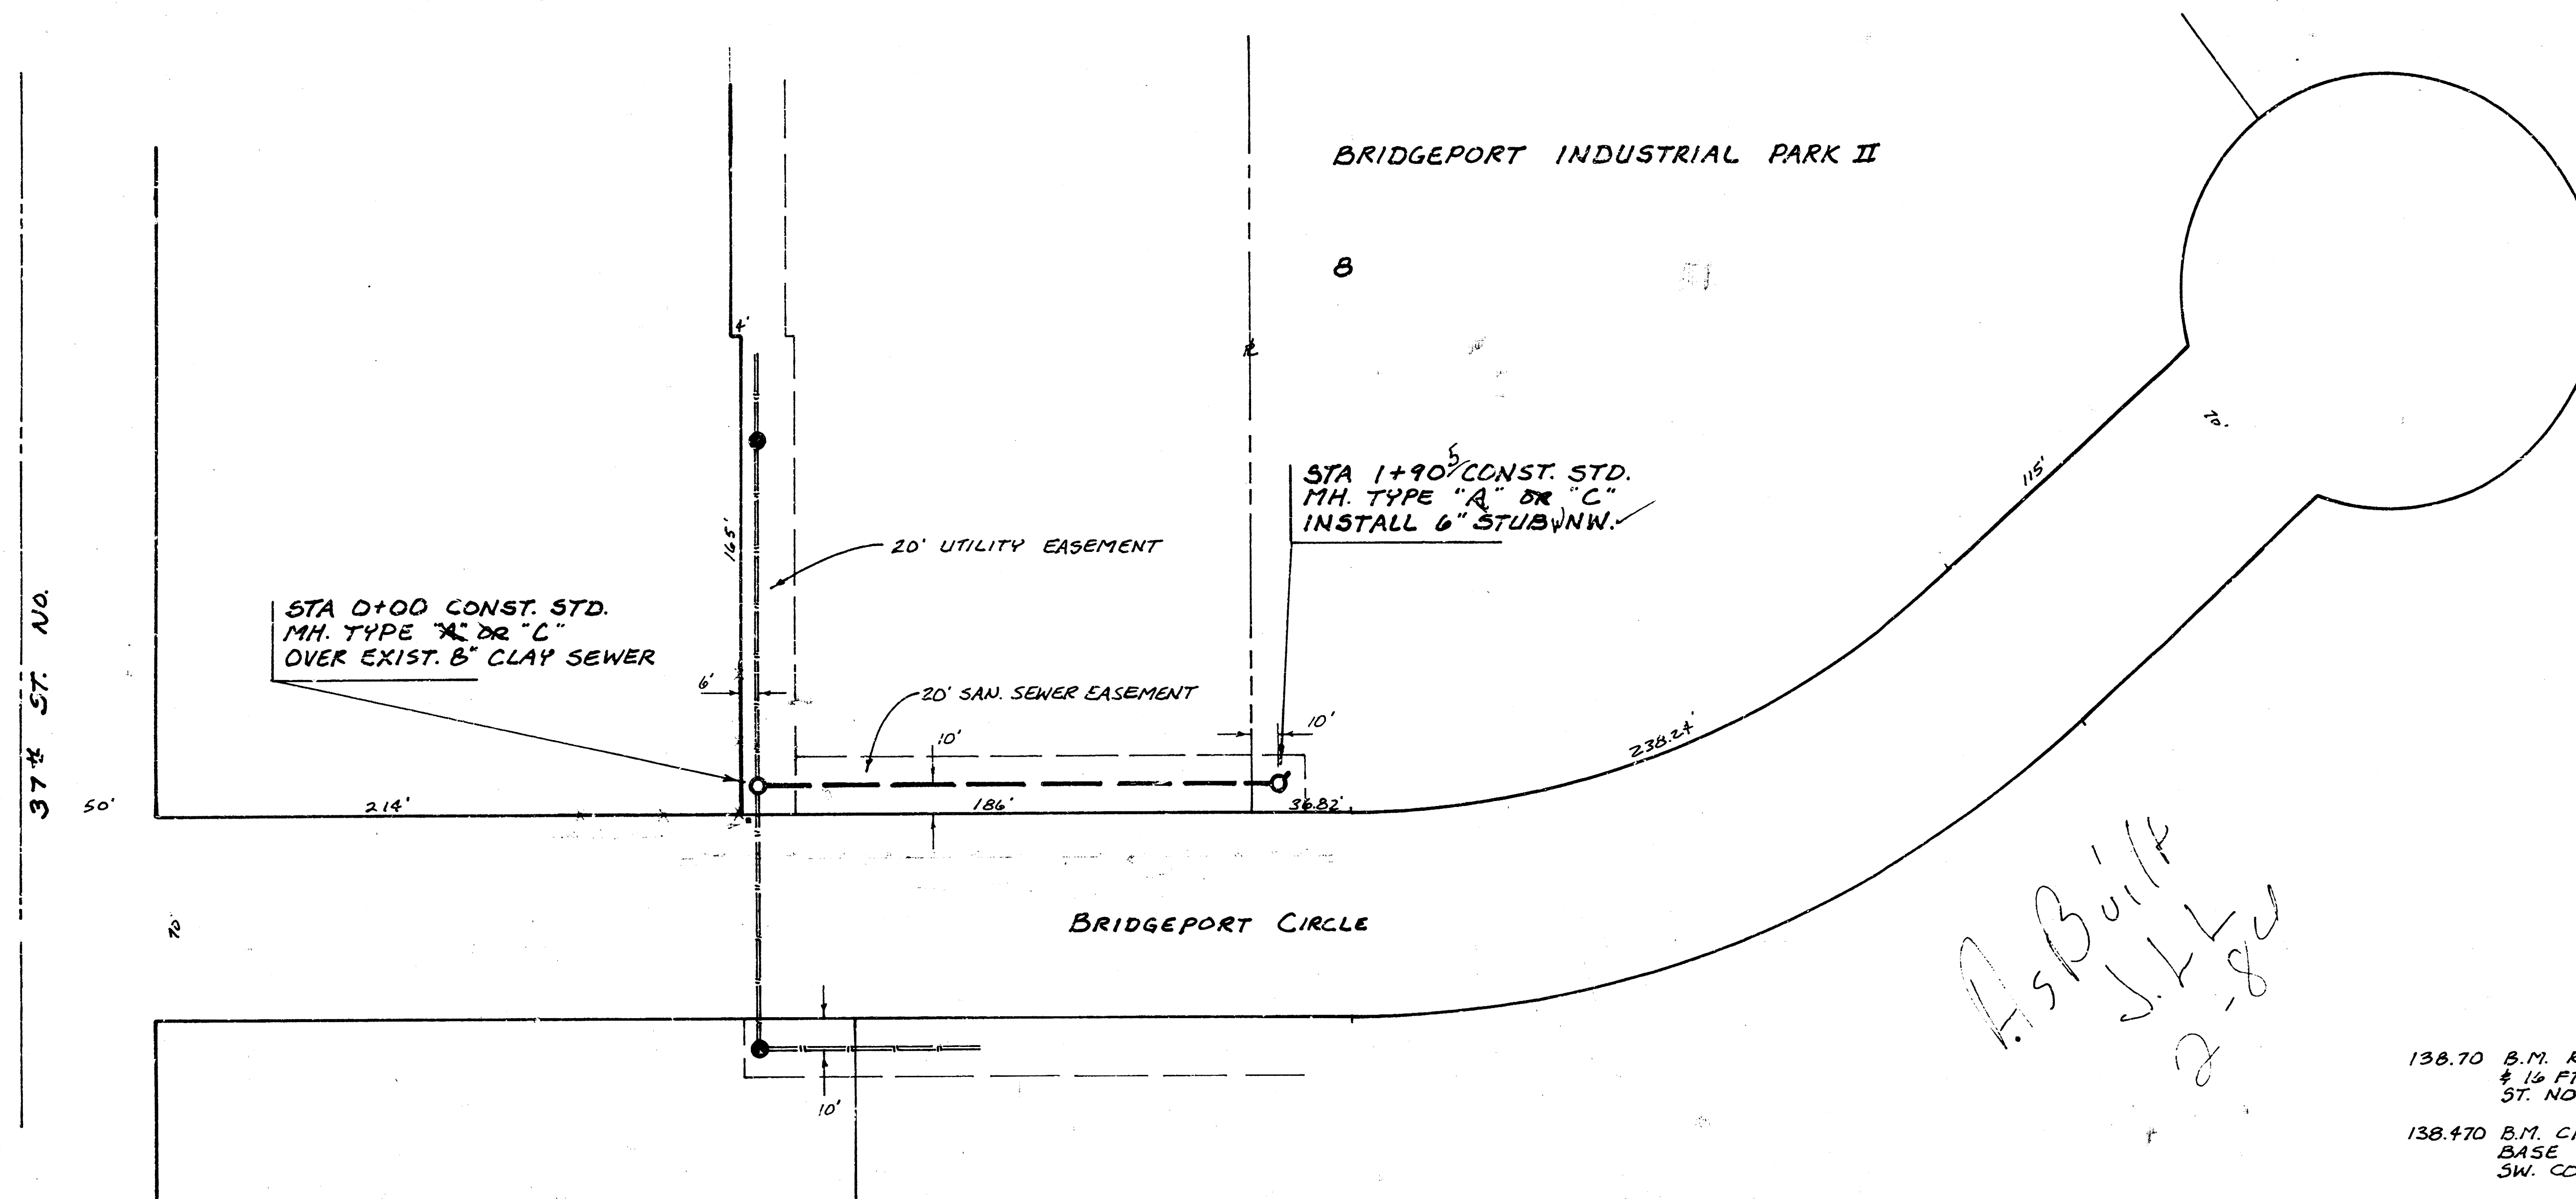

PROJECT DESCRIPTION			
LAT 113, MAIN 4, SANITARY SEWER NO. 23			
PROJECT NUMBER			
879-56-890-50134-295-000-000			
BOOK NO.	APPROVED BY	DATE	REVISED
DRAWN BY LOOMIS			
CITY OF WICHITA			
DEPARTMENT OF ENGINEERING			
CITY ENGINEER	SCALE		
HE LINDEBAK			

FILMED FROM THE BEST