B. M. 204.69 "a" Top N. end W. clvt. Headwall ent. Clvt. N. S. 21st. 200' E. of Edgemoor.

Survey by G.Y. Book No. 237-Y
Plan by J.W.
Checked by

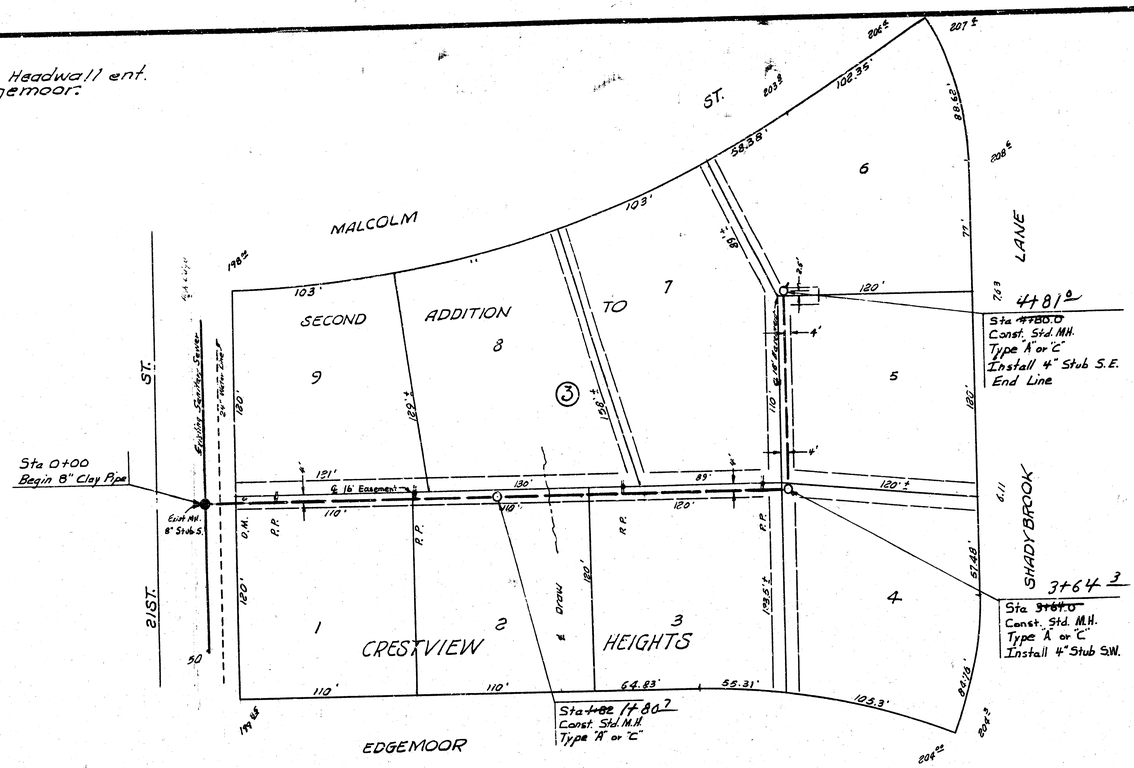

Plan Scale 1" = 40'
Profile Scale 1" = 40' Horz.
1" = 4' Vert.

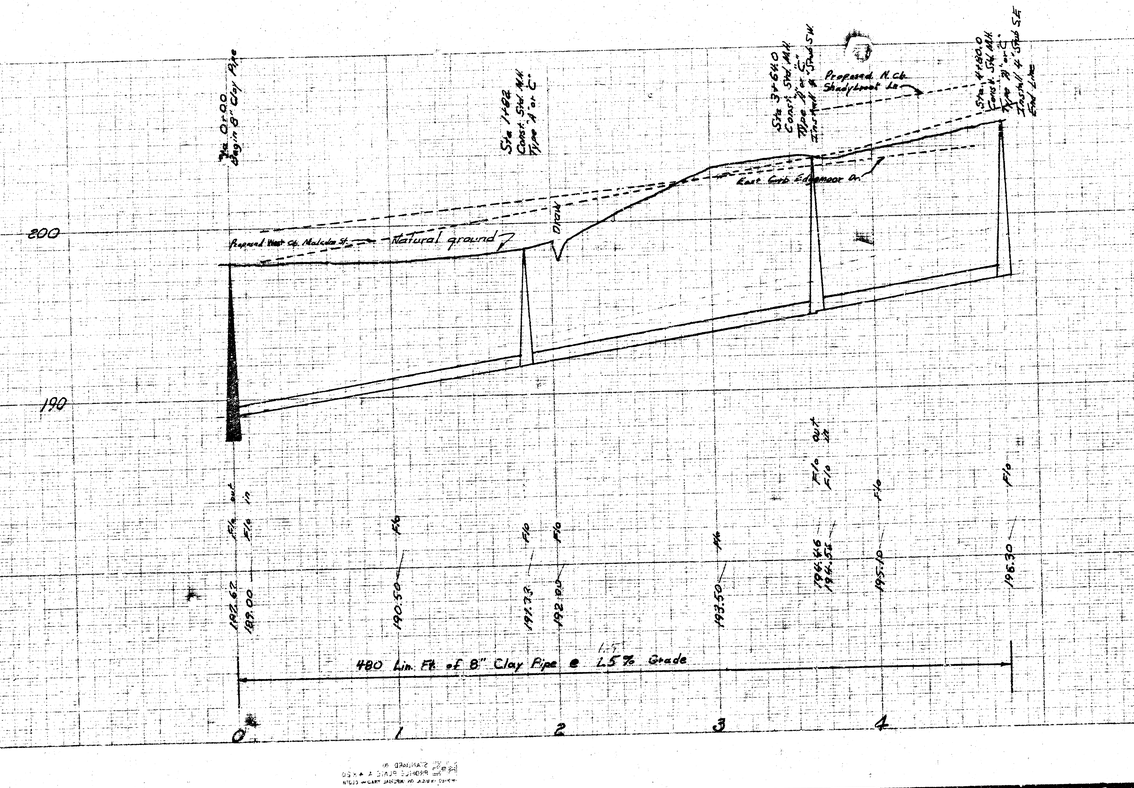

As Built 3-11-76

LAT. II, SUBMAIN 5, S. S. NO. 23
CITY OF WICHITA, KANSAS
R. W. LINN CITY ENGINEER
PROJECT DBKL 566040