P.K. 200.65 City Std. @ N.E. cor. Woodlawn & 21st.
B.M. 188.477 City Std. 1'e north of 21st on Woodlawn
B.M. 175.61 R.R. spike E. face osage-orange hedge, Sta. 9+77.55.
B.M. 170.75 S. flm existing M.H., Sta. 0+00.

NOTE: FIELD ENGINEER TO ESTABLISH SEWER ALIGNMENT USING GIVEN DIMENSIONS AND ANGLES FROM THE S.E. CORNER OF THE N.E. QUARTER OF SEC. 1, T27S, R1E OF 6TH P.M.

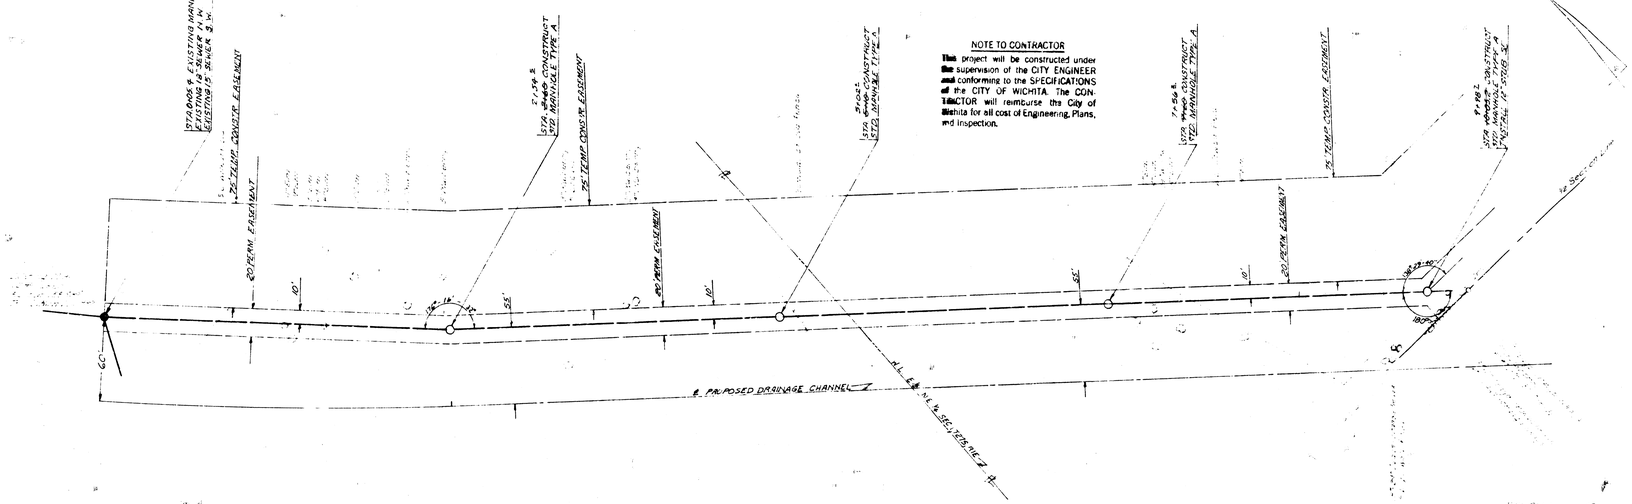


NOTE TO CONTRACTOR

This project will be constructed under the supervision of the CITY ENGINEER and conforming to the SPECIFICATIONS of the CITY OF WICHITA. The CONTRACTOR will reimburse the City of Wichita for all cost of Engineering, Plans, and Inspection.

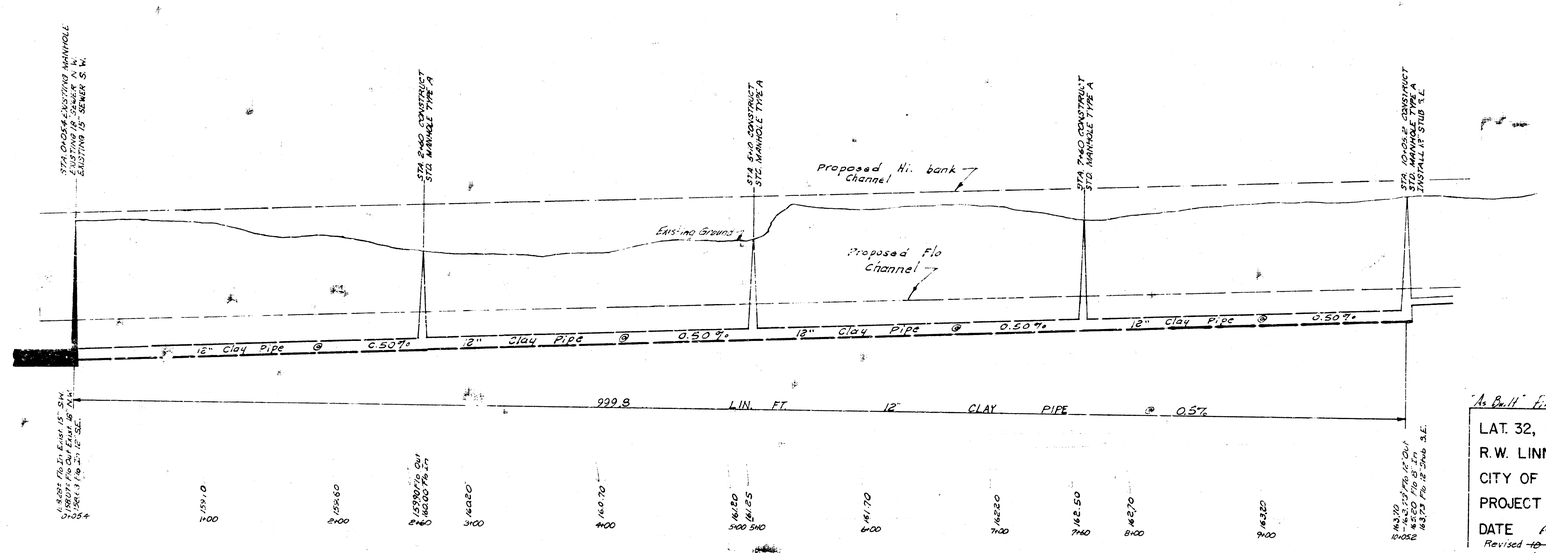


"As Built" final measurements 1-31-80

LAT. 32, MAIN 5, S.S. NO. 23
R.W. LINN CITY ENGINEER
CITY OF WICHITA, KS.
PROJECT NO. AAKB 502027
DATE Aug. 1972
Revised ~~10-20-72~~ 1-31-73

B. M. 200.65 CITY STD. @ N.E. COR. WOODLAWN & 21ST ST.
B. M. 188.48 CITY STD. @ WOODLAWN & 25TH ST. NO. 26'S.& 47'E. OF ¼ SEC. COR.

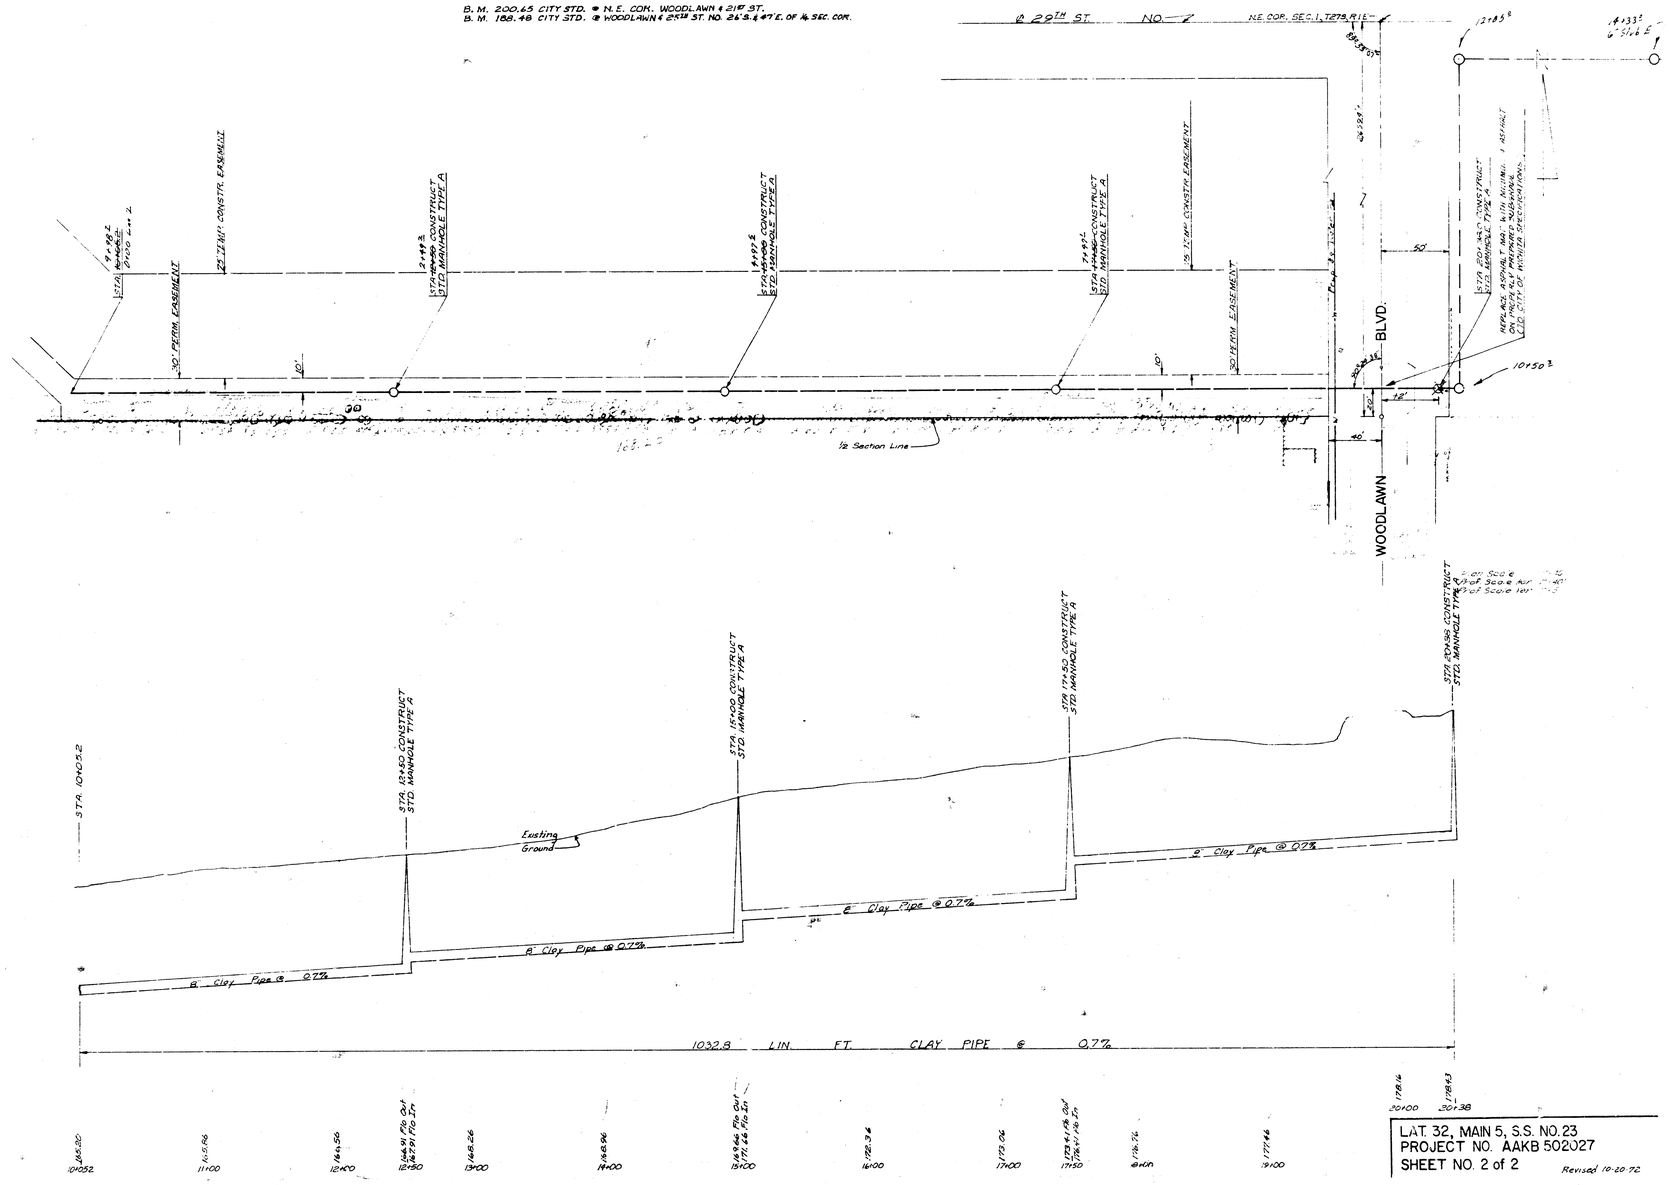


LAT. 32, MAIN 5, S.S. NO. 23
PROJECT NO. AAKB 502027
SHEET NO. 2 of 2

Revised 10-20-72