


LAT 36 MAIN 5 S.S. NO. 23
CITY OF WICHITA, KS.

R. W. LINN ——— CITY ENGINEER

PROJECT NUMBER: DBKL577071
PLANS

SANITARY SEWER EXTENSIONS


WOODLAWN PLACE 3rd ADDITION

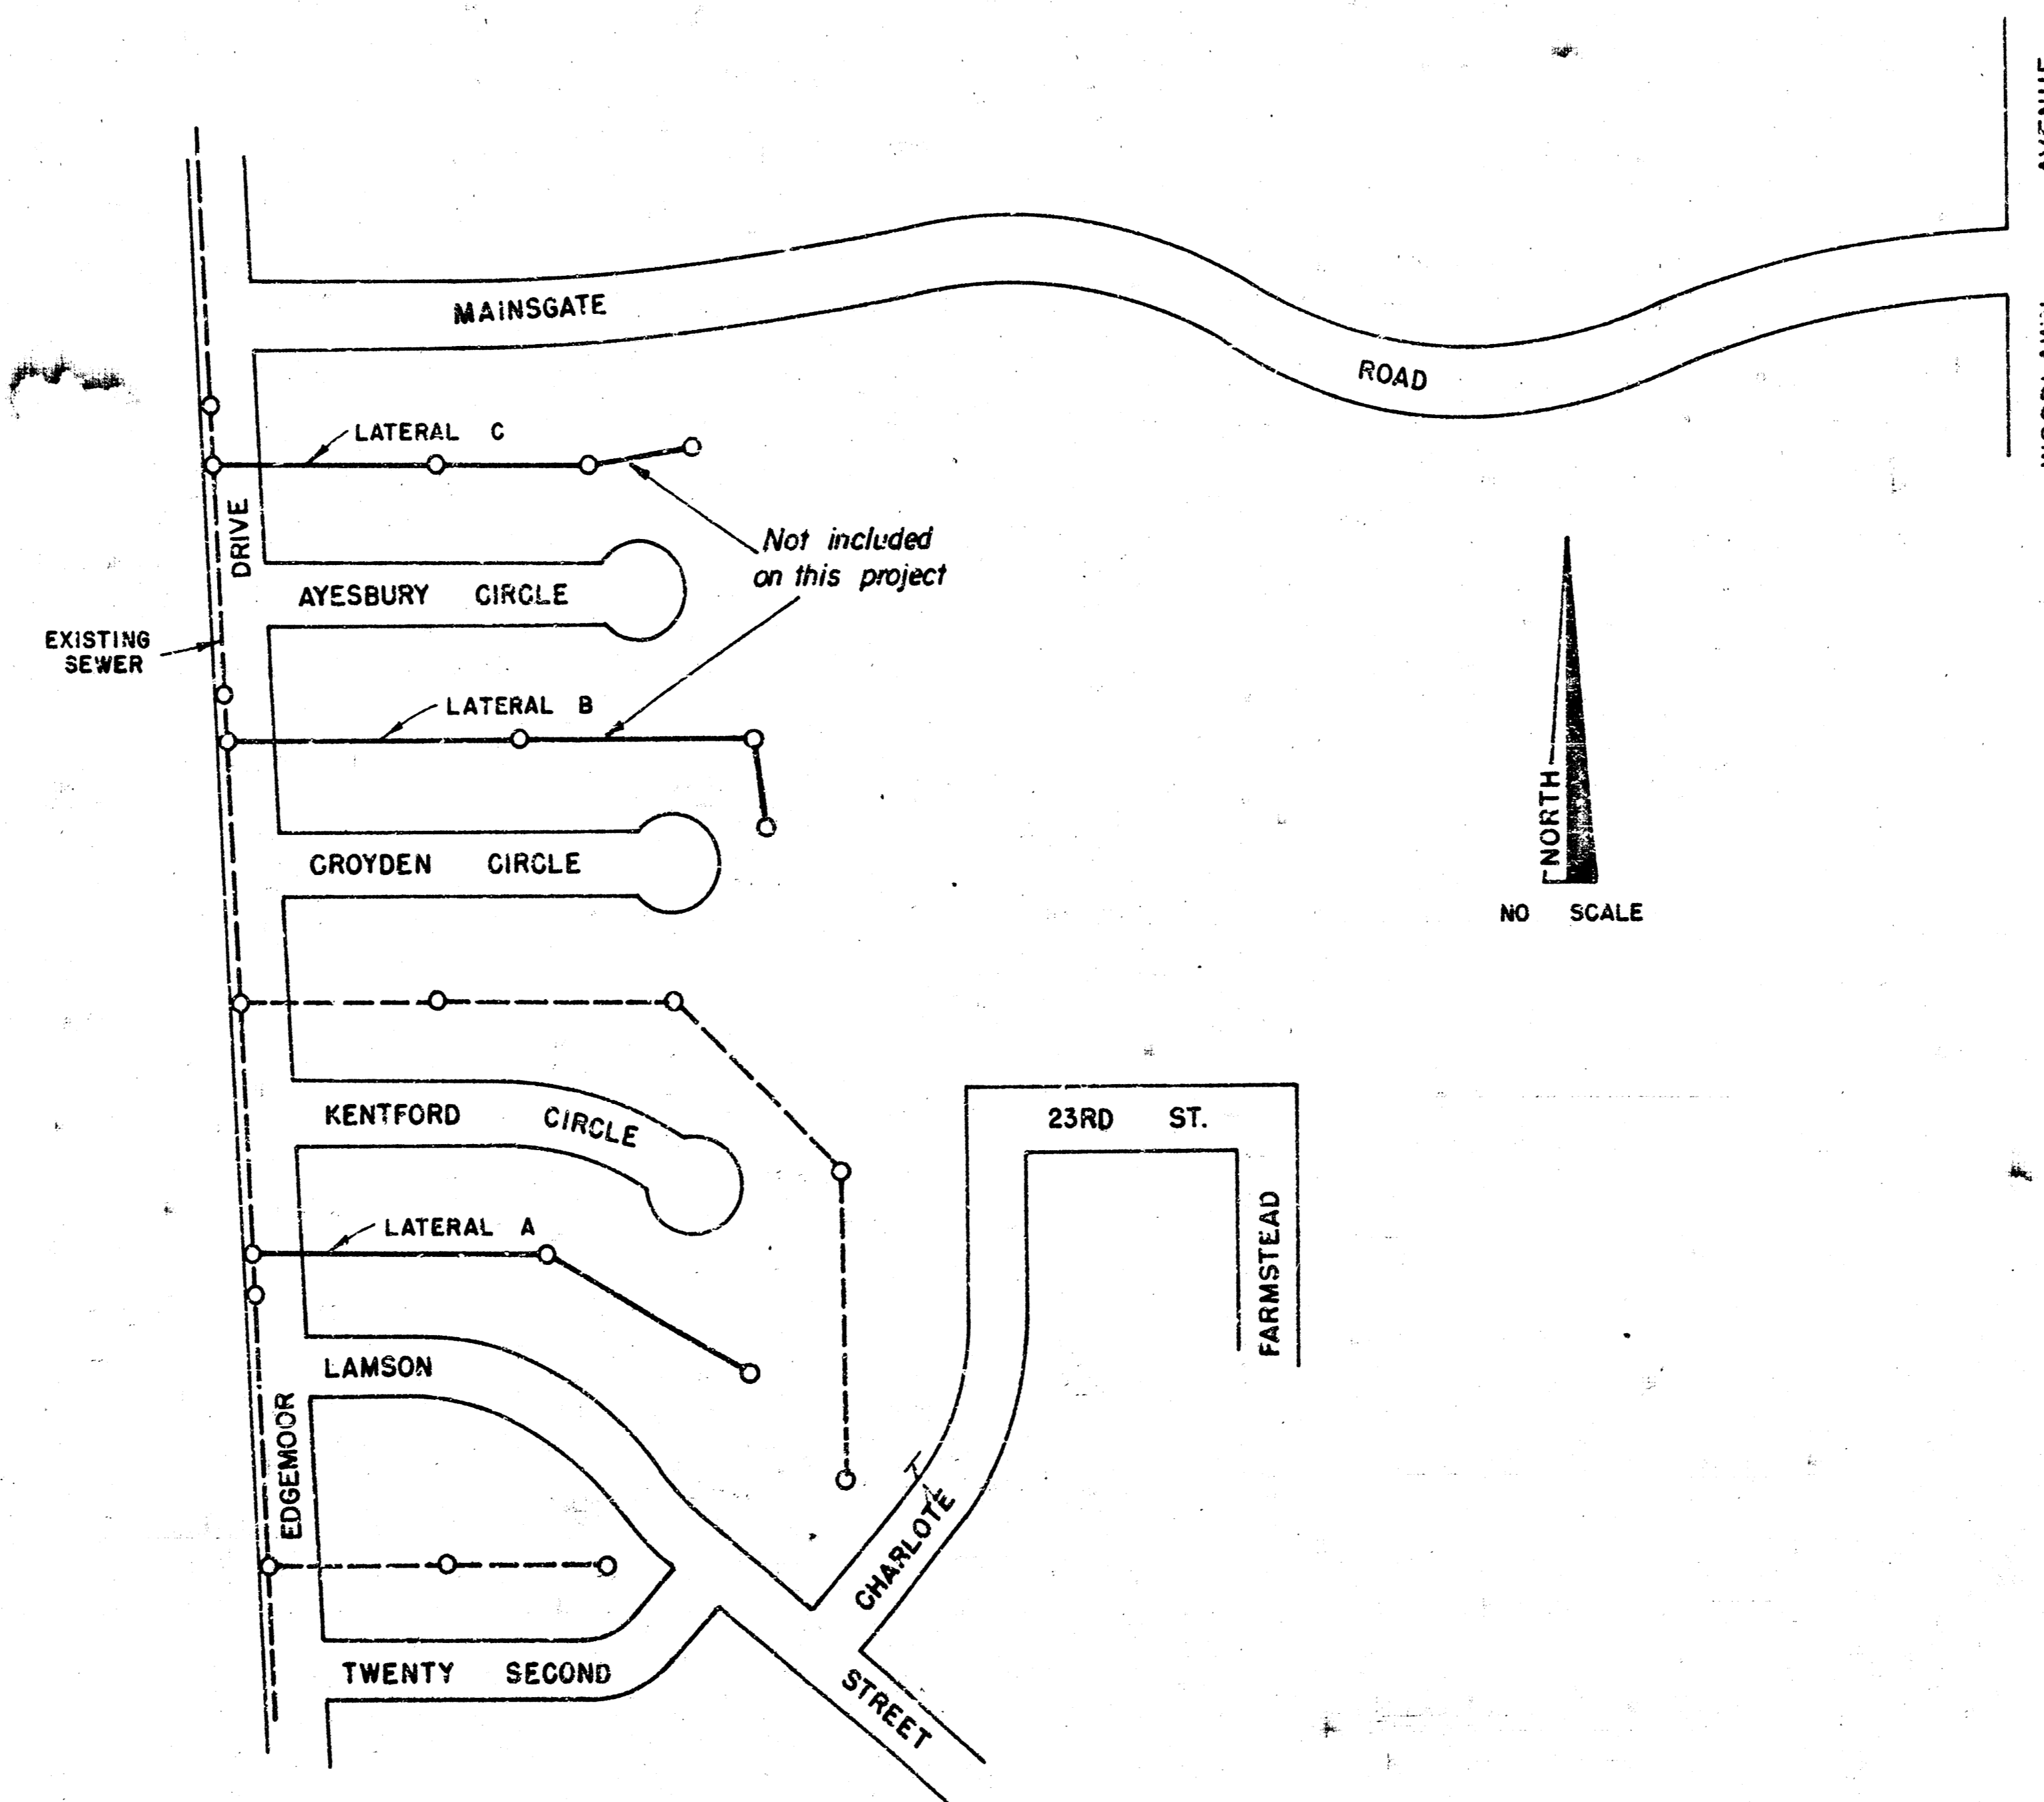



REISS AND GODDNESS ENGINEERS
1822
WICHITA, KANSAS

Note: Laterals B and C are not included on this project

NORTH
Scale 1" = 60'

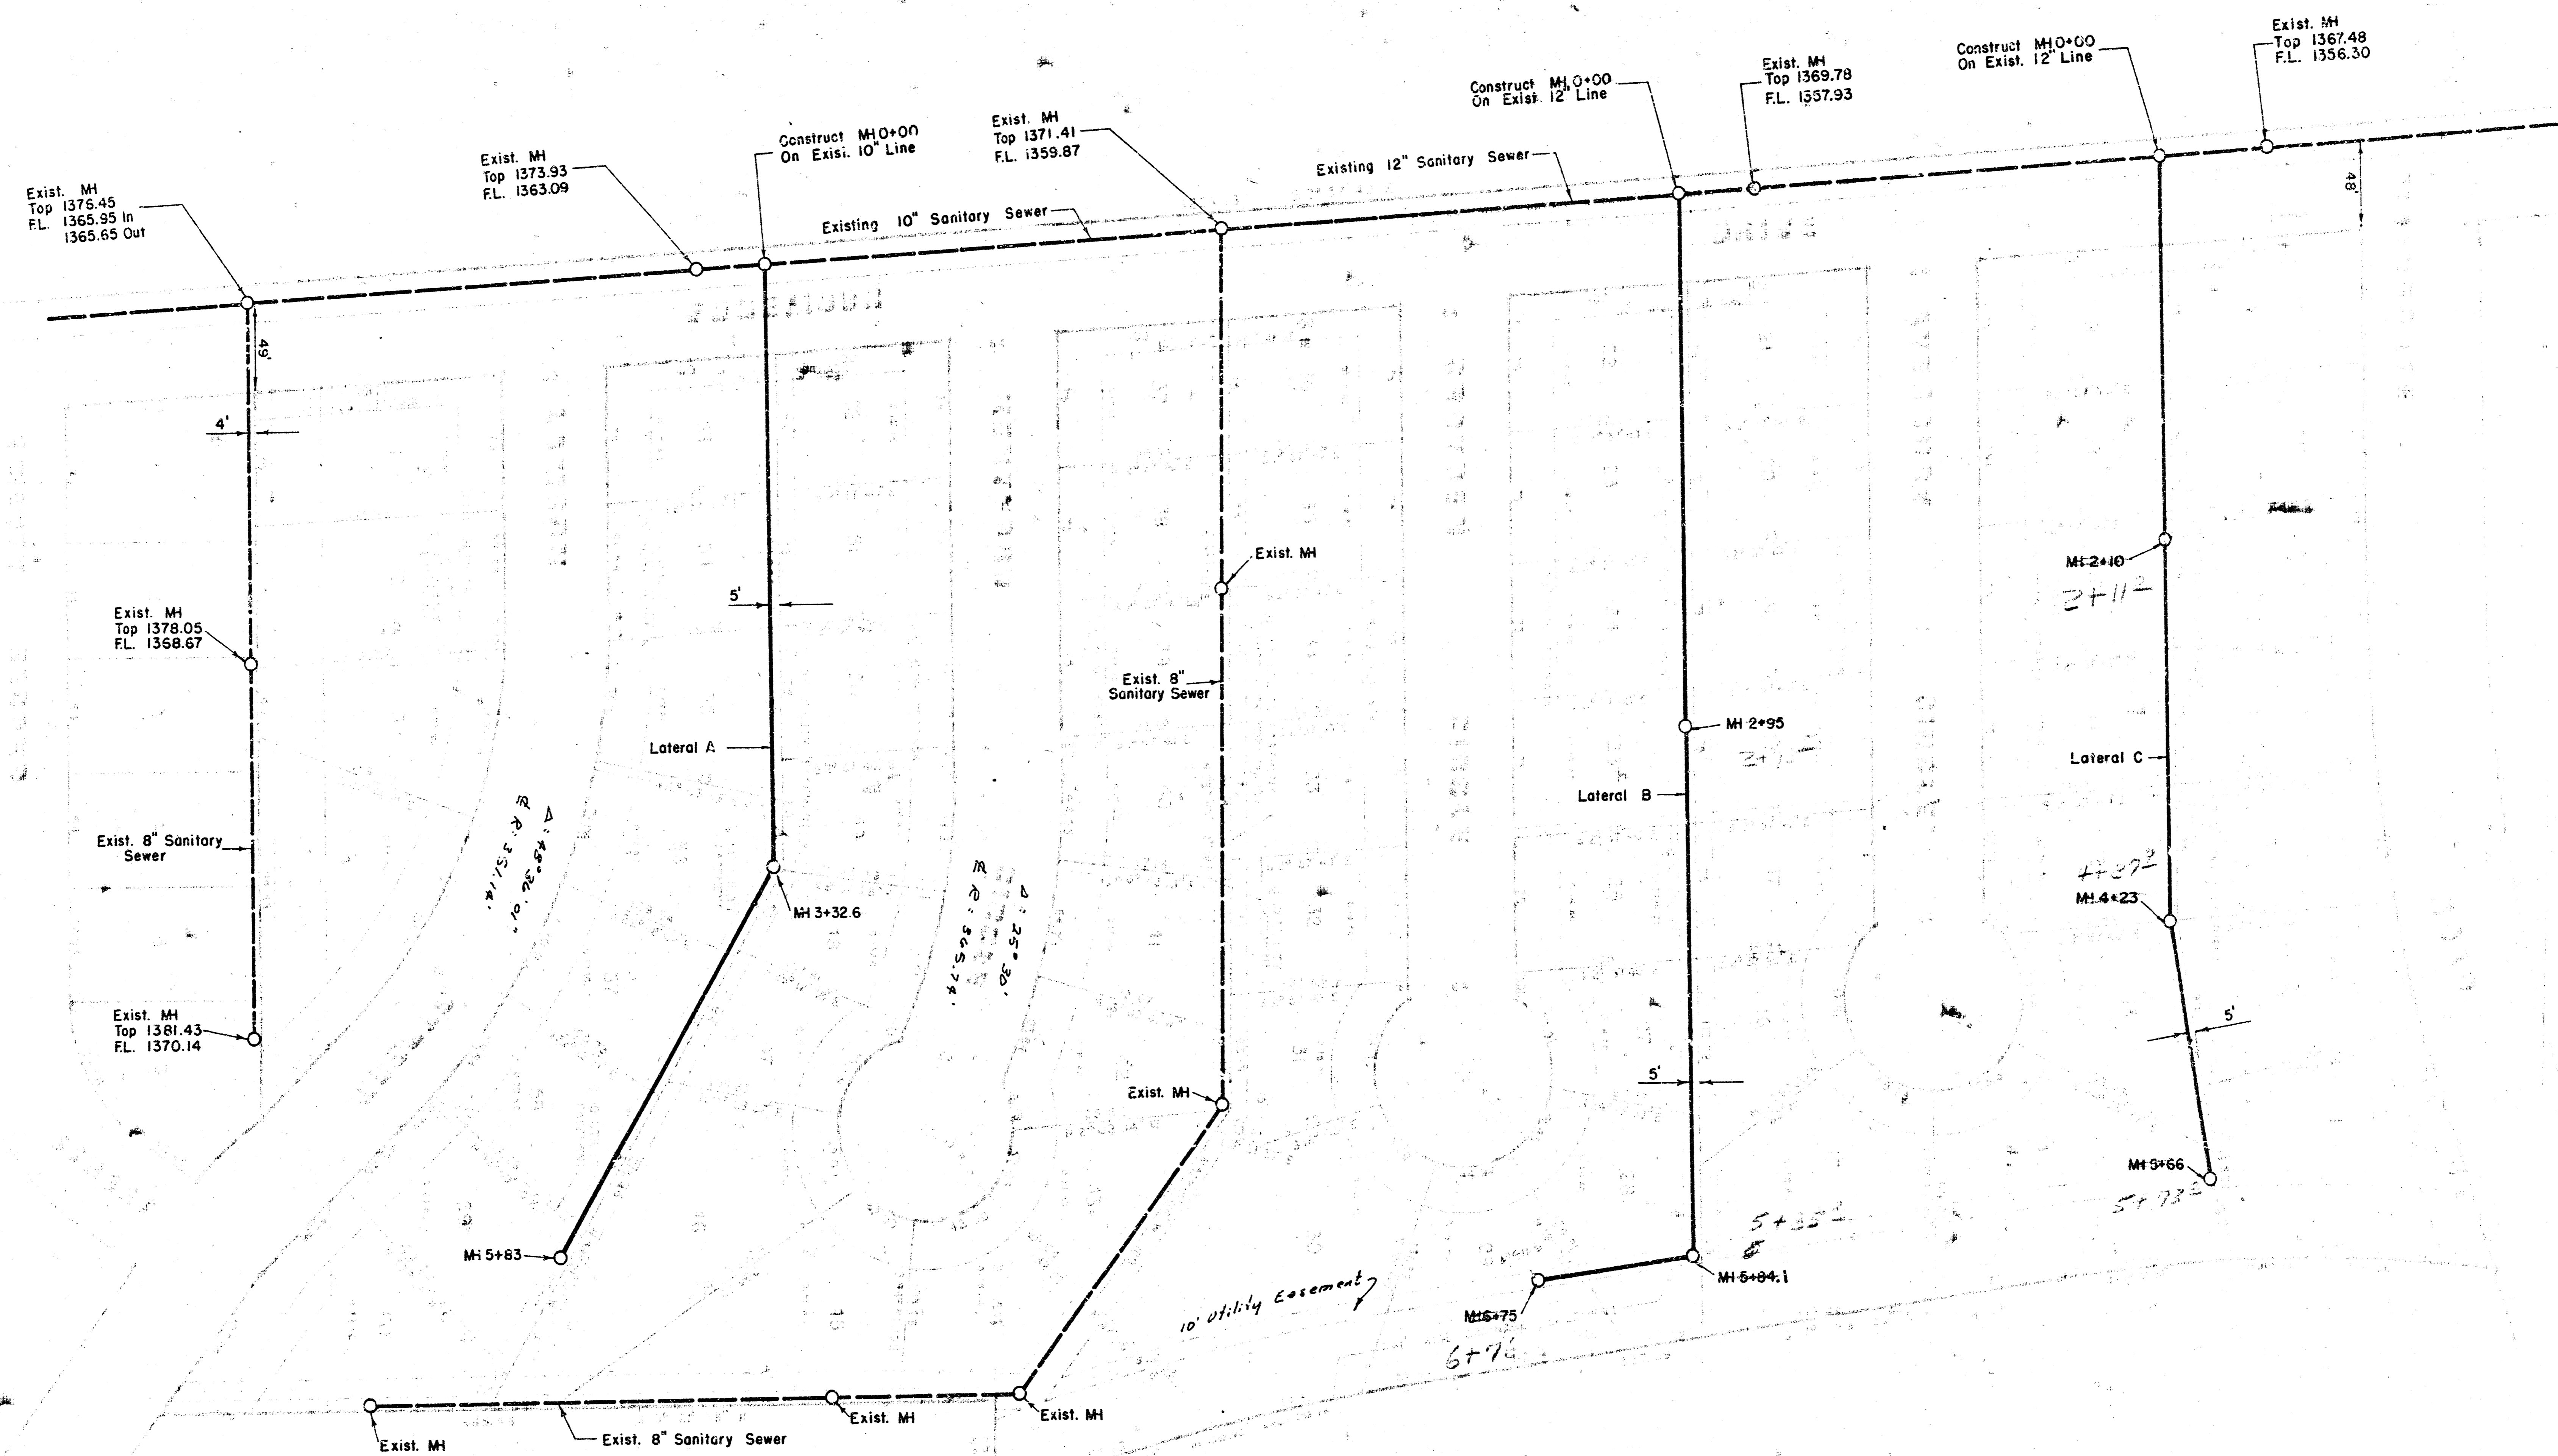

- * B.M. 1 1367.58 "□" Center Conc. Abutment N. Side RCBC Mainsgate & 130' Drainage Easmt
- * B.M. 2 1368.43 Top Of Top Flange Bolt Mueller Fire Hydrant At Mainsgate & Edgemoor

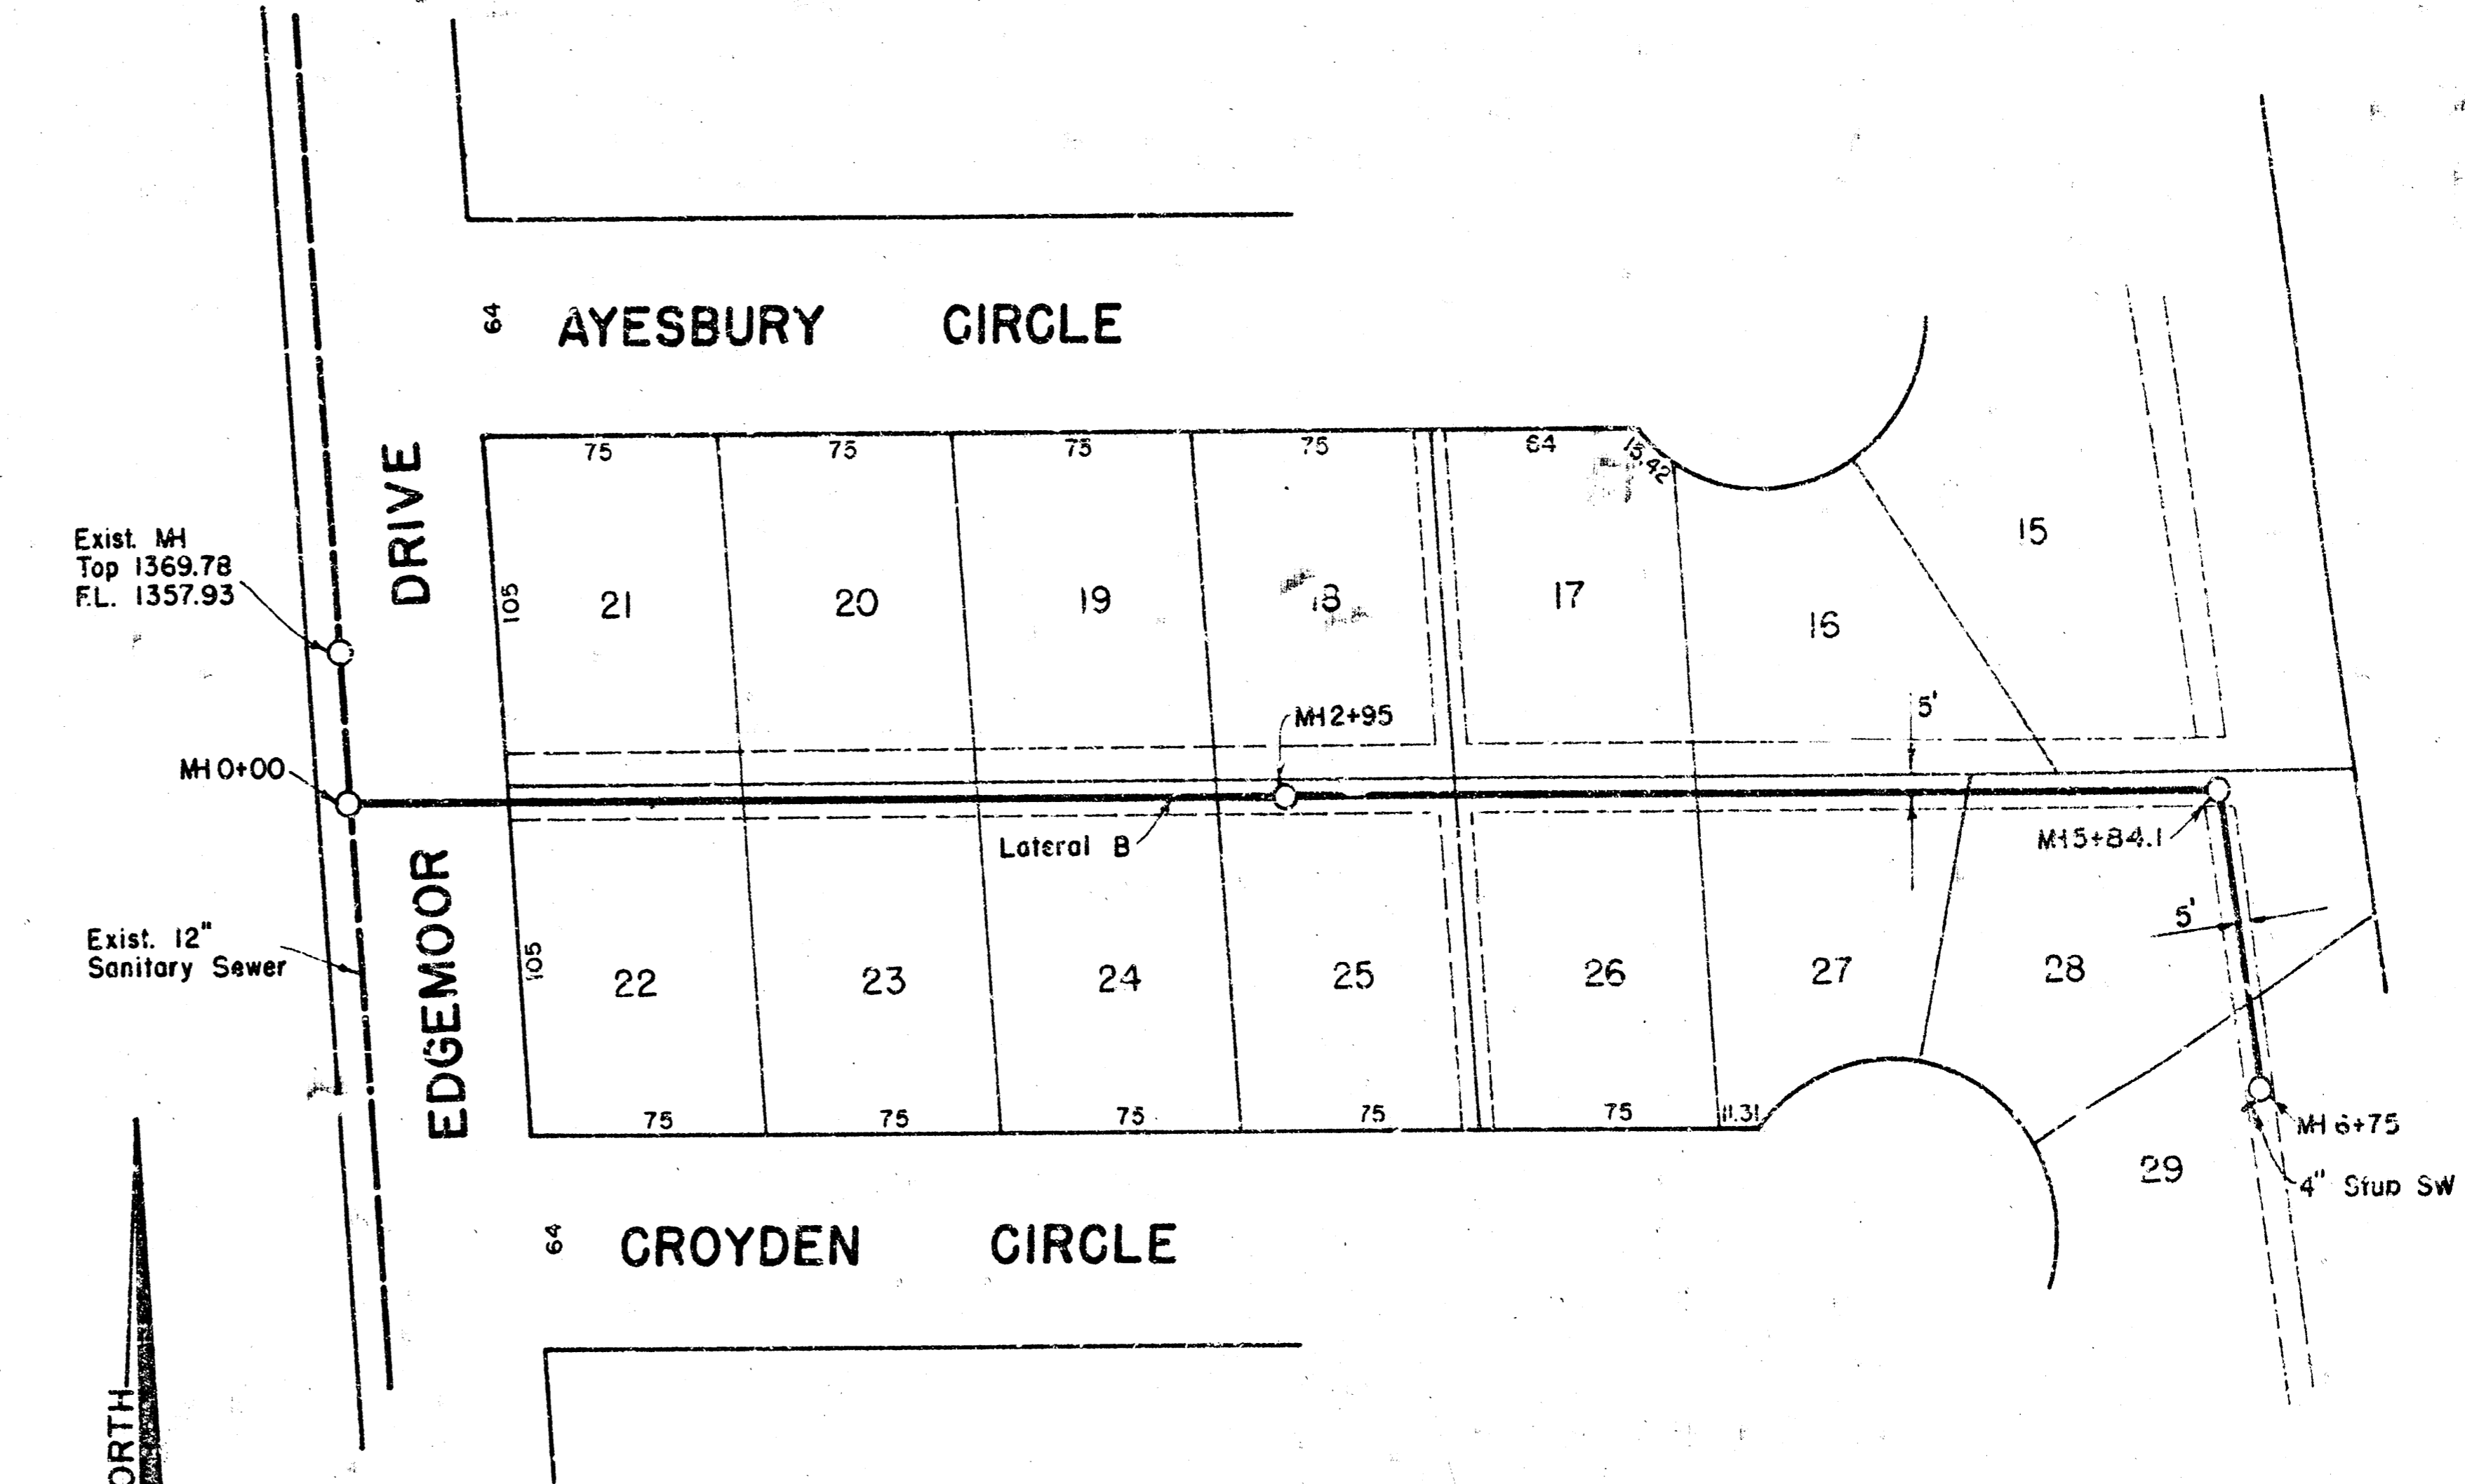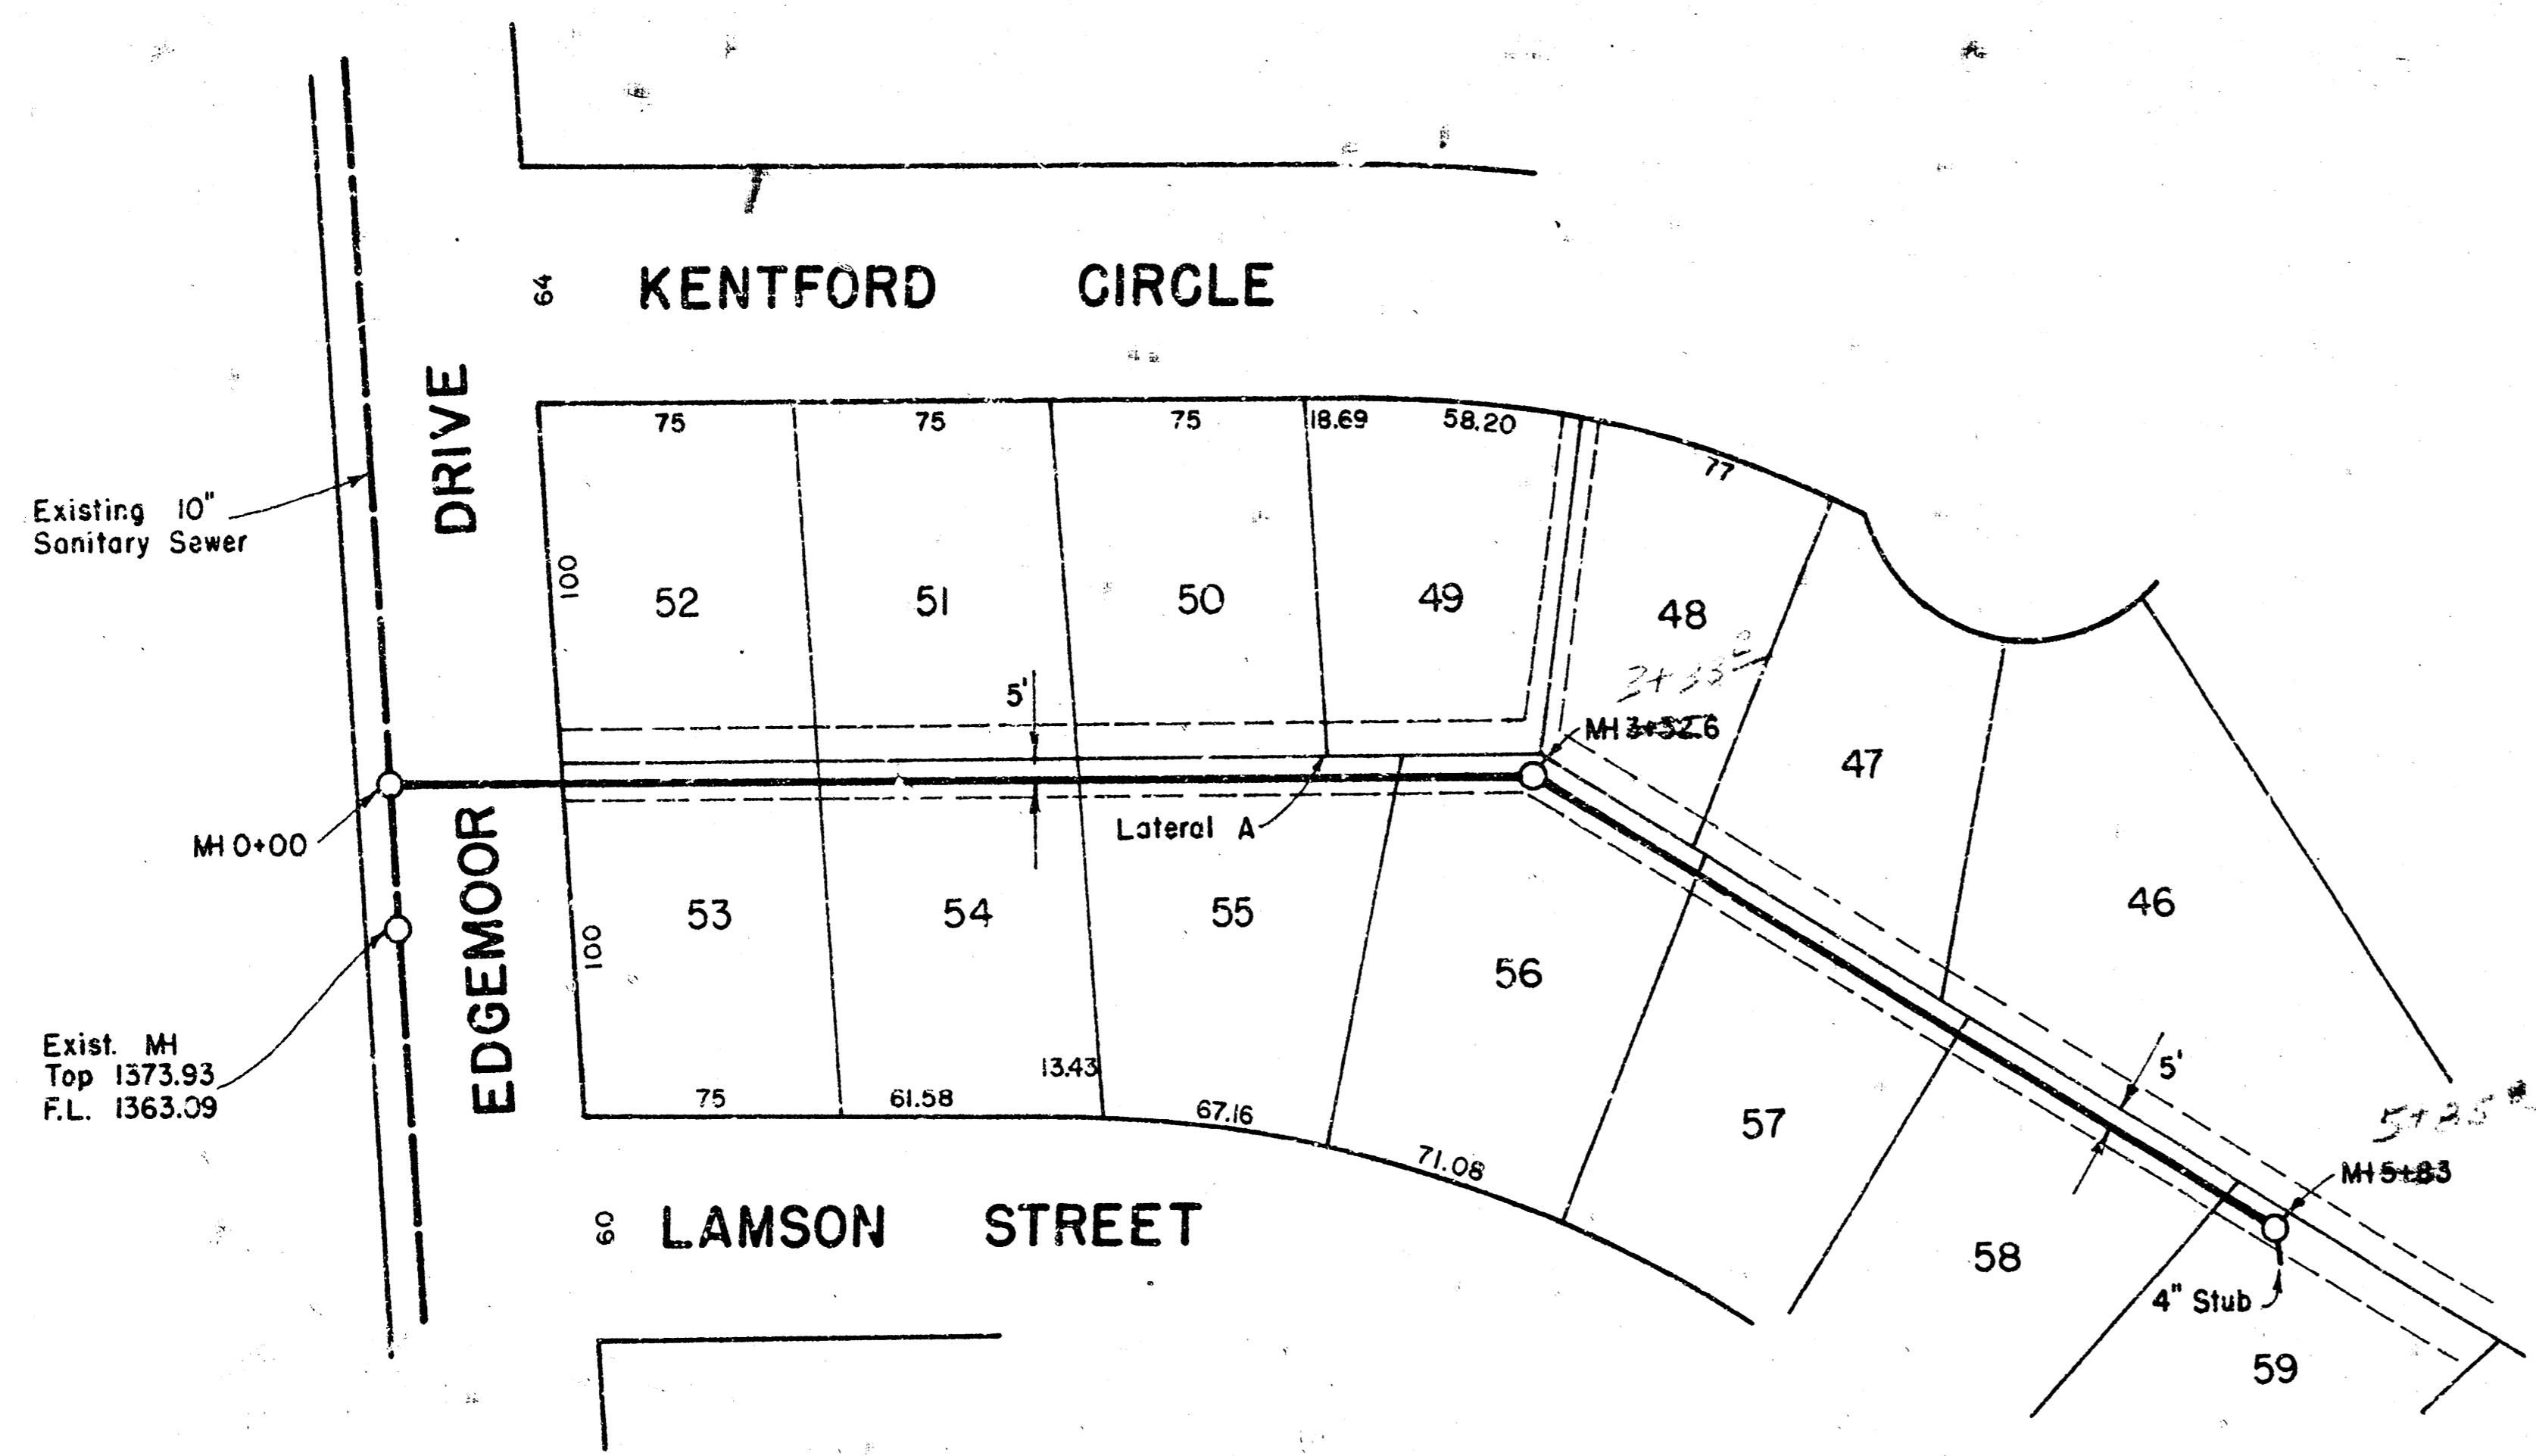

NORTH
Scale 1" = 60'

Lateral A
Scale 1" = 60' Horiz.
1" = 4' Vert.

Lateral B
Scale 1" = 60' Horiz.
1" = 4' Vert.

