LAT 36 MAIN 5 S.S. NO. 23

CITY OF WICHITA, KS.


R. W. LINN ——— CITY ENGINEER

PROJECT NUMBER: DBKL577071

PLANS

SANITARY SEWER EXTENSIONS

WOODLAWN PLACE 3rd ADDITION

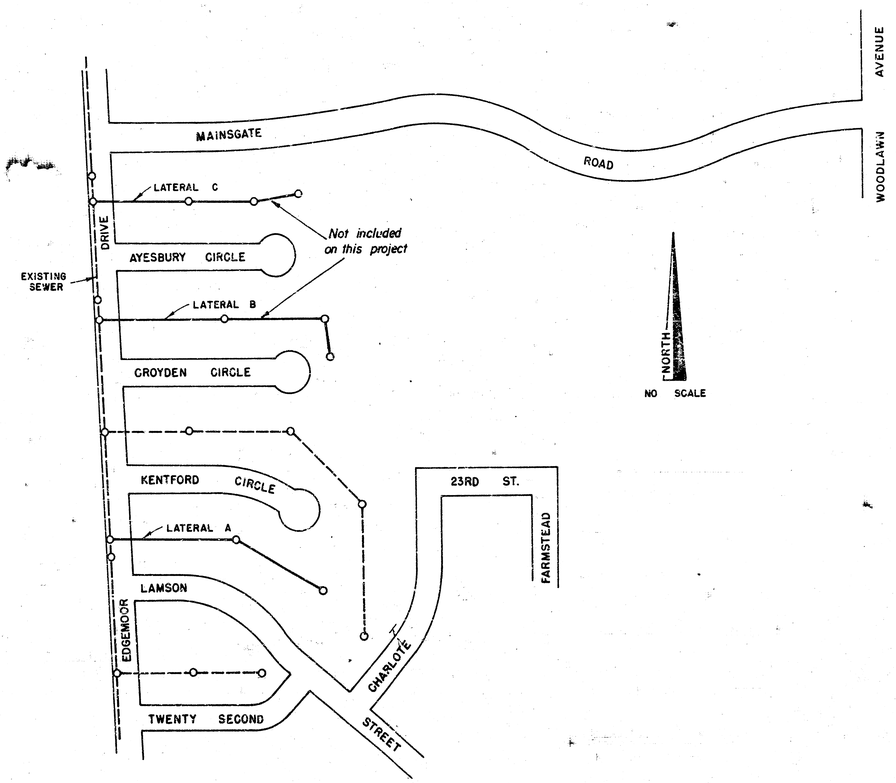

REISS AND GOODNESS ENGINEERS

Note: Laterals B and C are not included on this project

NORTH

Scale 1"=60

Exist. MH
Top 1376.45
F.L. 1365.95 In
1365.65 Out

Exist. MH
Top 1373.93
F.L. 1363.09

Construct MH 0+00
On Exist. 10" Line

Exist. MH
Top 1371.41
F.L. 1359.87

Existing 10" Sanitary Sewer

Existing 12" Sanitary Sewer

Construct MH 0+00
On Exist. 12" Line

Exist. MH
Top 1369.78
F.L. 1357.93

Construct MH 0+00
On Exist. 12" Line

Exist. MH
Top 1367.48
F.L. 1356.30

49'

4'

5'

Exist. MH
Top 1378.05
F.L. 1368.67

Exist. MH

Exist. 8" Sanitary Sewer

Lateral A

MH 3+32.6

Exist. 8" Sanitary Sewer

Exist. MH
Top 1381.43
F.L. 1370.14

Exist. MH

MH 2+10

2+11

MH 2+95

Lateral B

Lateral C

4+27

MH 4+23

5'

5'

MH 5+66

5+72

MH 5+83

5+32

MH 5+84.1

10' Utility Easement

MH 6+75

6+74

Exist. MH


Exist. 8" Sanitary Sewer


Exist. MH

Exist. MH

B.M.* 1 1367.58 "□" Center Conc. Abutment N. Side
RCBC Mainsgate & 130' Drainage Easm't

B.M.* 2 1368.43 Top Of Top Flange Bolt Mue□ller
Fire Hydrant At Mainsgate & Edgemoor

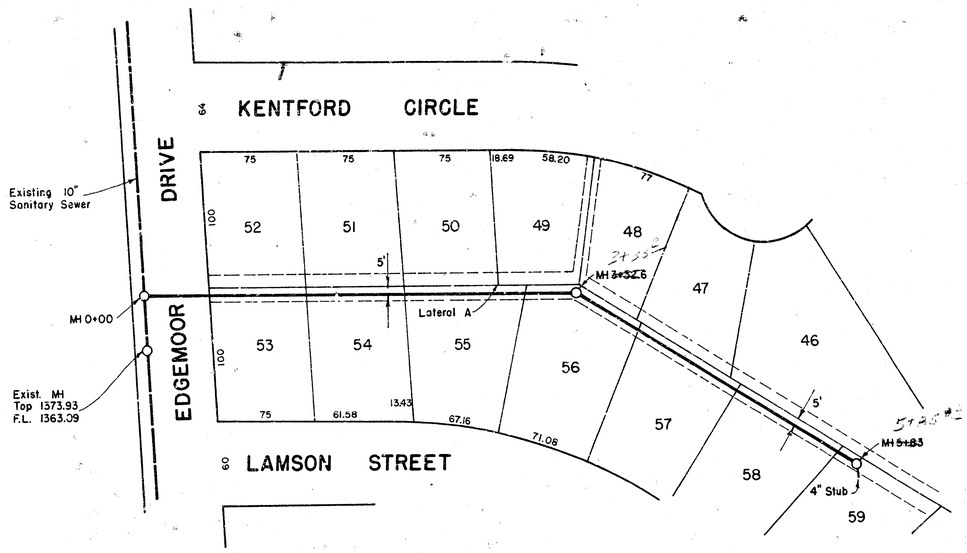

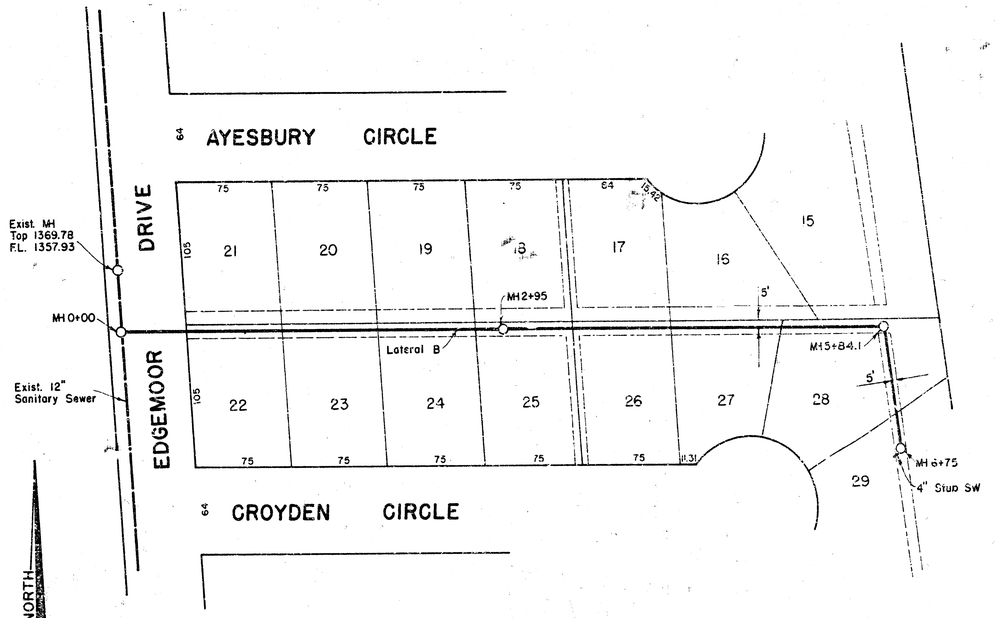


NORTH

Scale 1" = 60'


Lateral A

Scale 1" = 60' Horiz.
1" = 4' Vert.

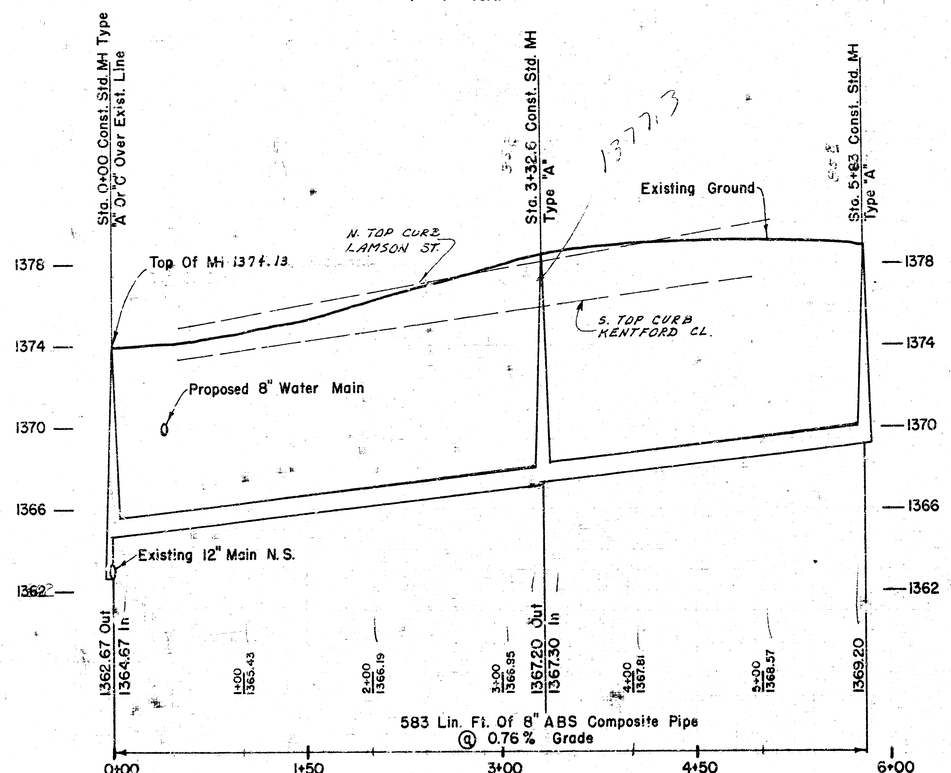

Lateral B

Scale 1" = 60' Horiz.
1" = 4' Vert.

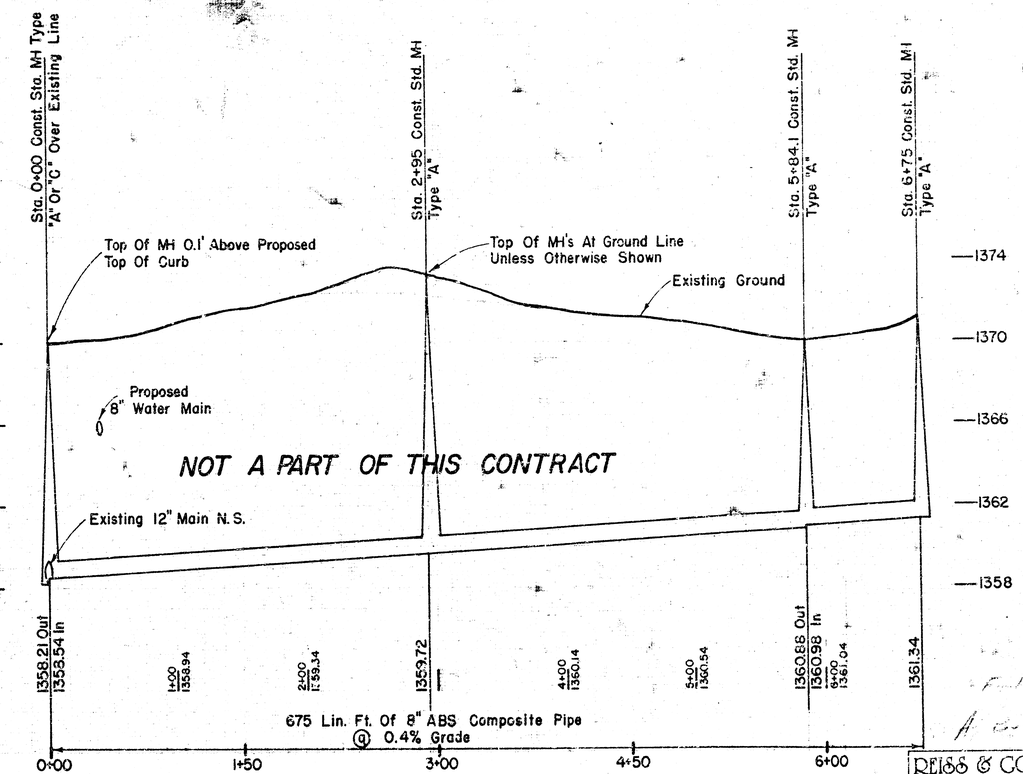

REISS & GOODNESS ENG