LAT 36 MAIN 5 S.S. NO. 23

CITY OF WICHITA, KS.


R. W. LINN ——— CITY ENGINEER

PROJECT NUMBER: DBKL577071

PLANS

SANITARY SEWER EXTENSIONS

WOODLAWN PLACE 3rd ADDITION

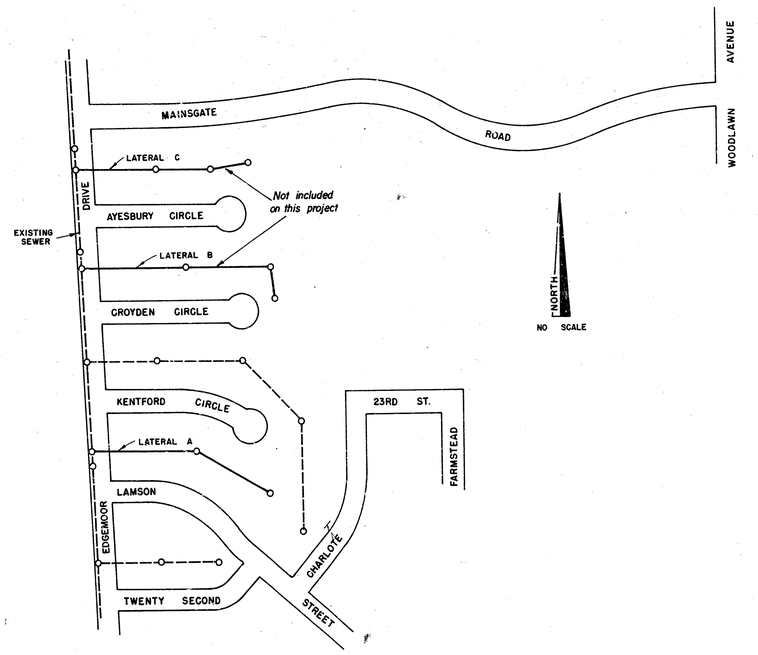

REISS AND GOODNESS ENGINEERS


REISS & GOODNESS ENGINEERS
2160 WEST 21st STREET
WICHITA, KANSAS 67204
(316) 832-0213

REVISION	DRAWN BY	CHECKED BY	DESIGNED BY	PROJECT	CUSTOMER	SCALE	PROJECT NO.
	L. Thompson 4-29-77		K. Hill	SANITARY SEWER EXTENSIONS	FIDELITY DEVELOPMENT INC	NO SCALE	SEV
						DATE 4-29-77	SHEET 1 of 3

Note: Laterals B and C are not included on this project

NORTH

Scale 1" = 60

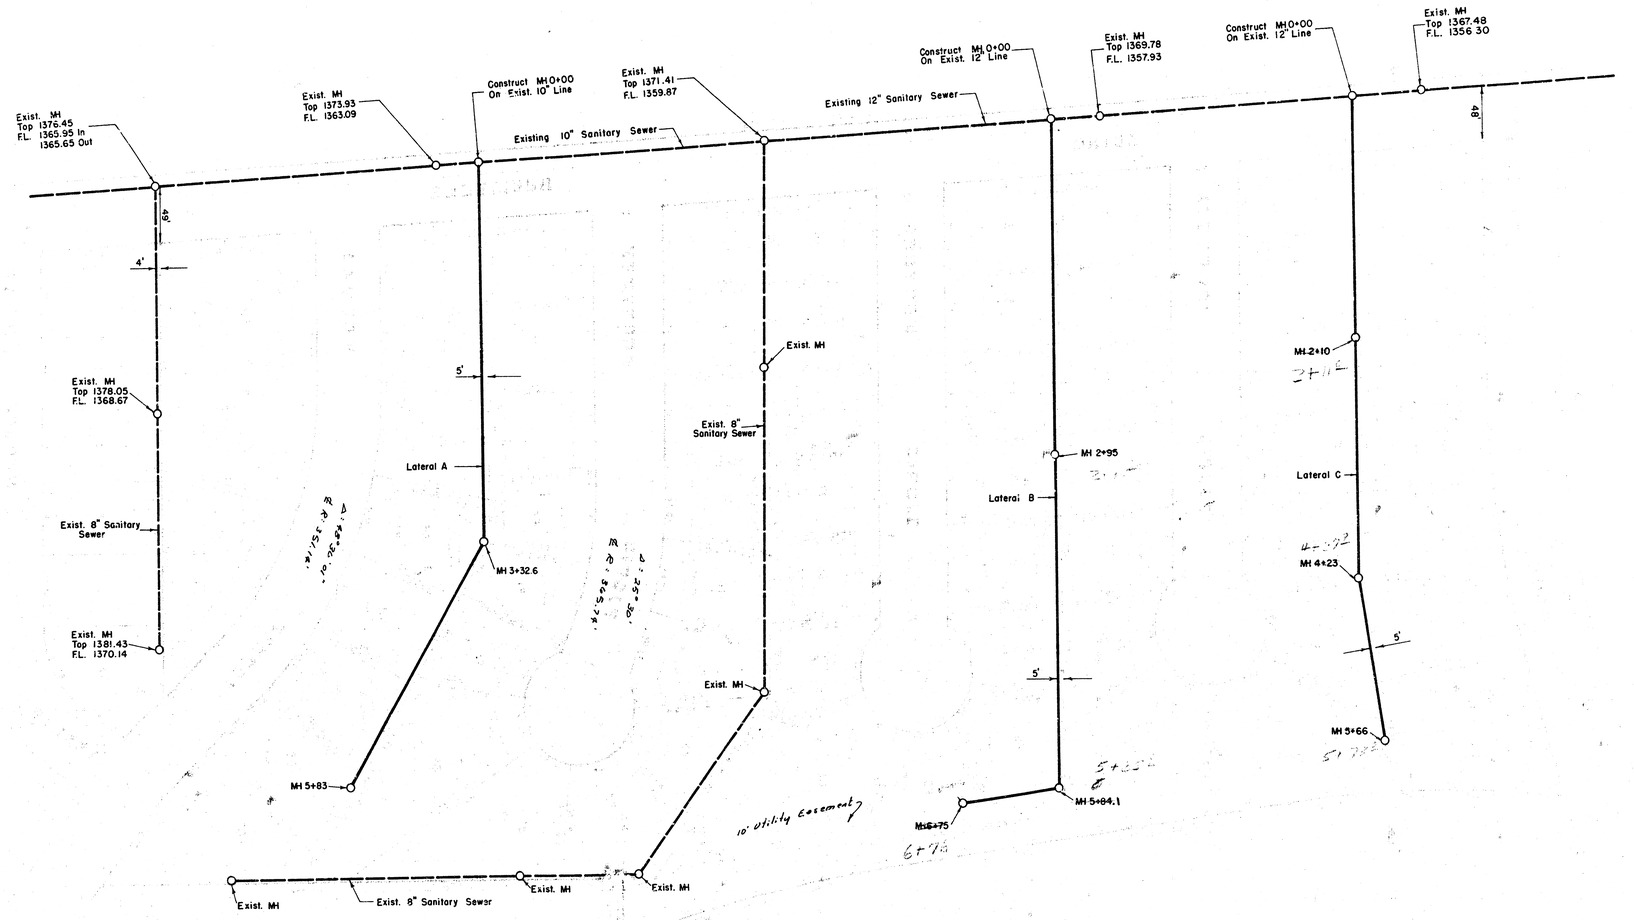

B.M. 1 1367.58 "□" Center Conc. Abuiment N. Side RCBC Mainsgate & 130' Drainage Easm't

B.M. 2 1368.43 Top Of Top Flange Bolt Mueller Fire Hydrant At Mainsgate & Edgemoor

L. Thompson 4-29-77


K. Hill

SANITARY SEWER EXTENSIONS

4-29-77


SEW 1/2

FILMED FROM THE BEST

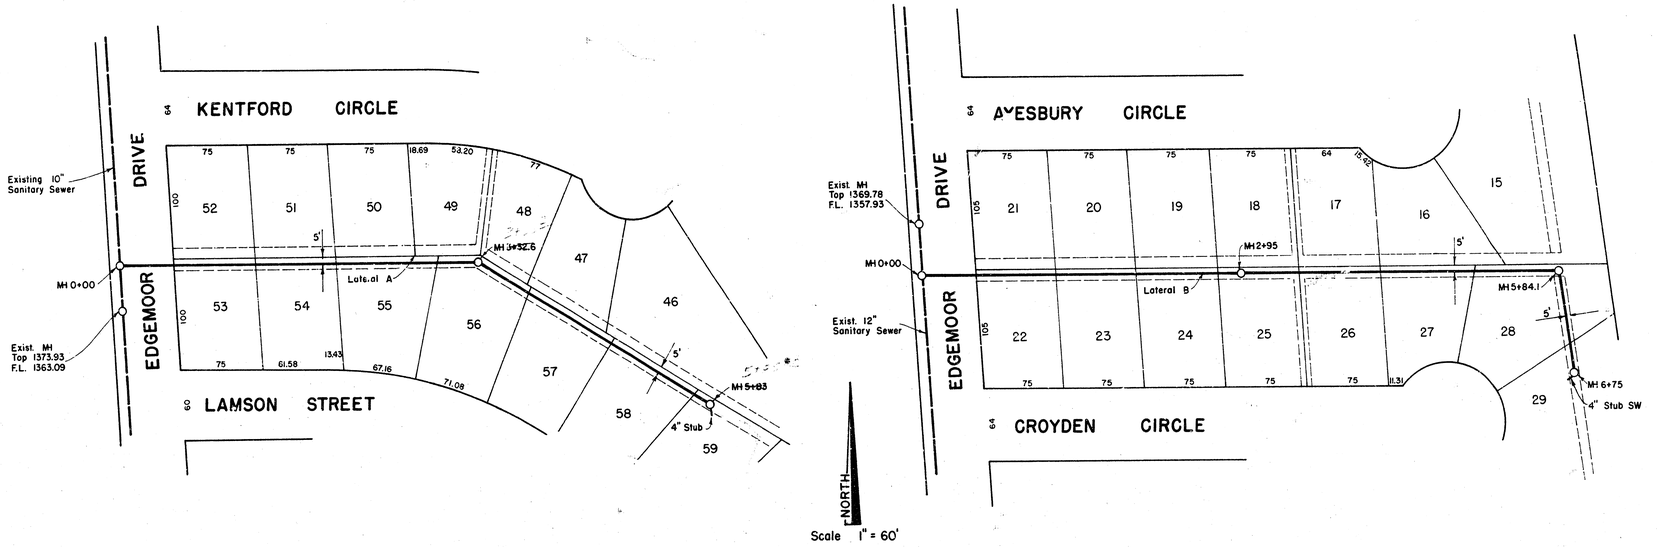


Lateral A

Scale 1" = 60' Horiz.
1" = 4' Vert.

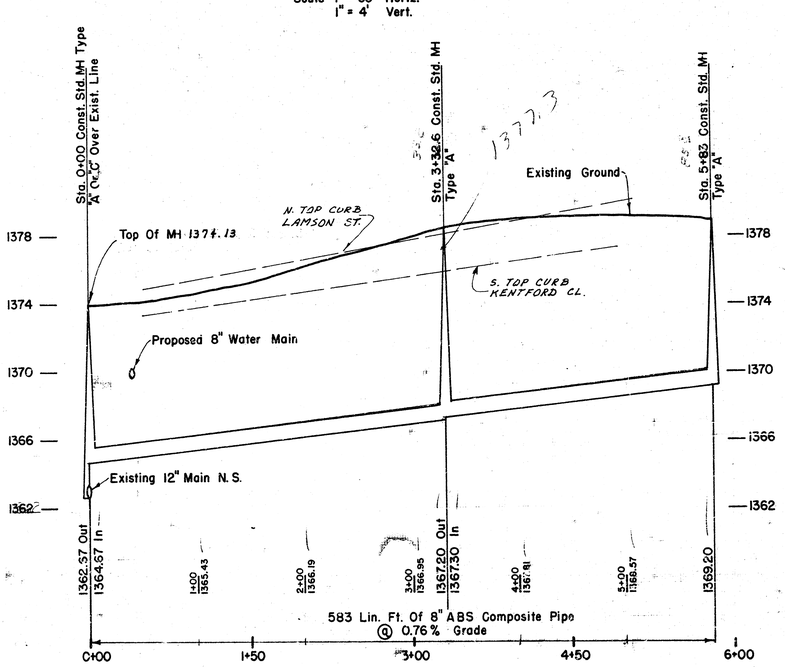

Lateral B

Scale 1" = 60' Horiz.
1" = 4' Vert.

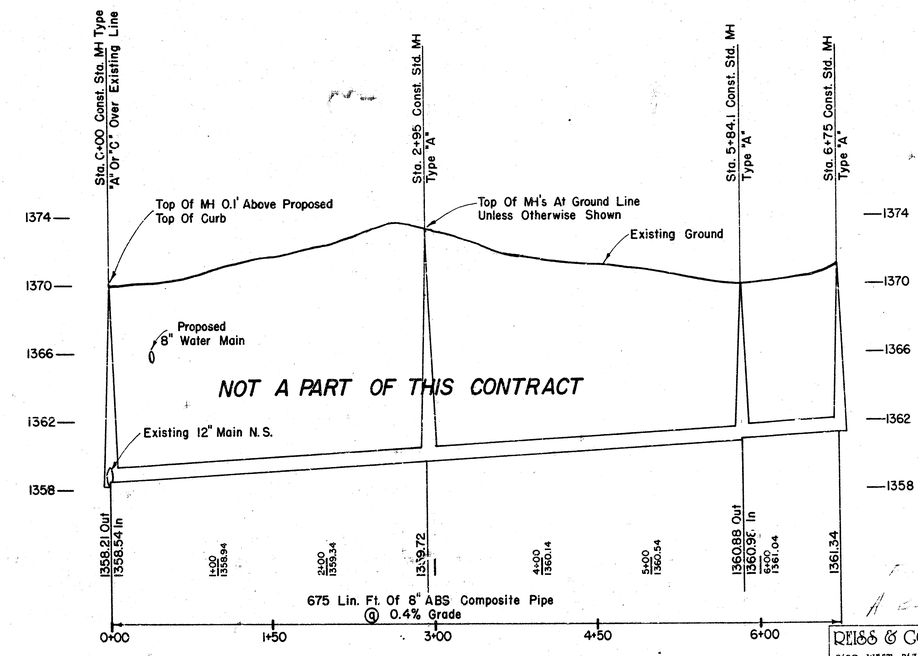

REISS & GOODNESS ENGINEERS
2160 WEST 21ST STREET
WICHITA, KANSAS 67204
(316) 832-02[illegible]

REVISION	DRAWN BY	CHECKED BY	DESIGNED BY	PROJECT	CUSTOMER	SCALE	PROJECT
	L. Thompson 4-29-77		K. Hill	SANITARY SEWER EXTENSIONS	FIDELITY DEVELOPMENT INC.	AS SHOWN	SE-2
						DATE 4-29-77	SHEET 3