

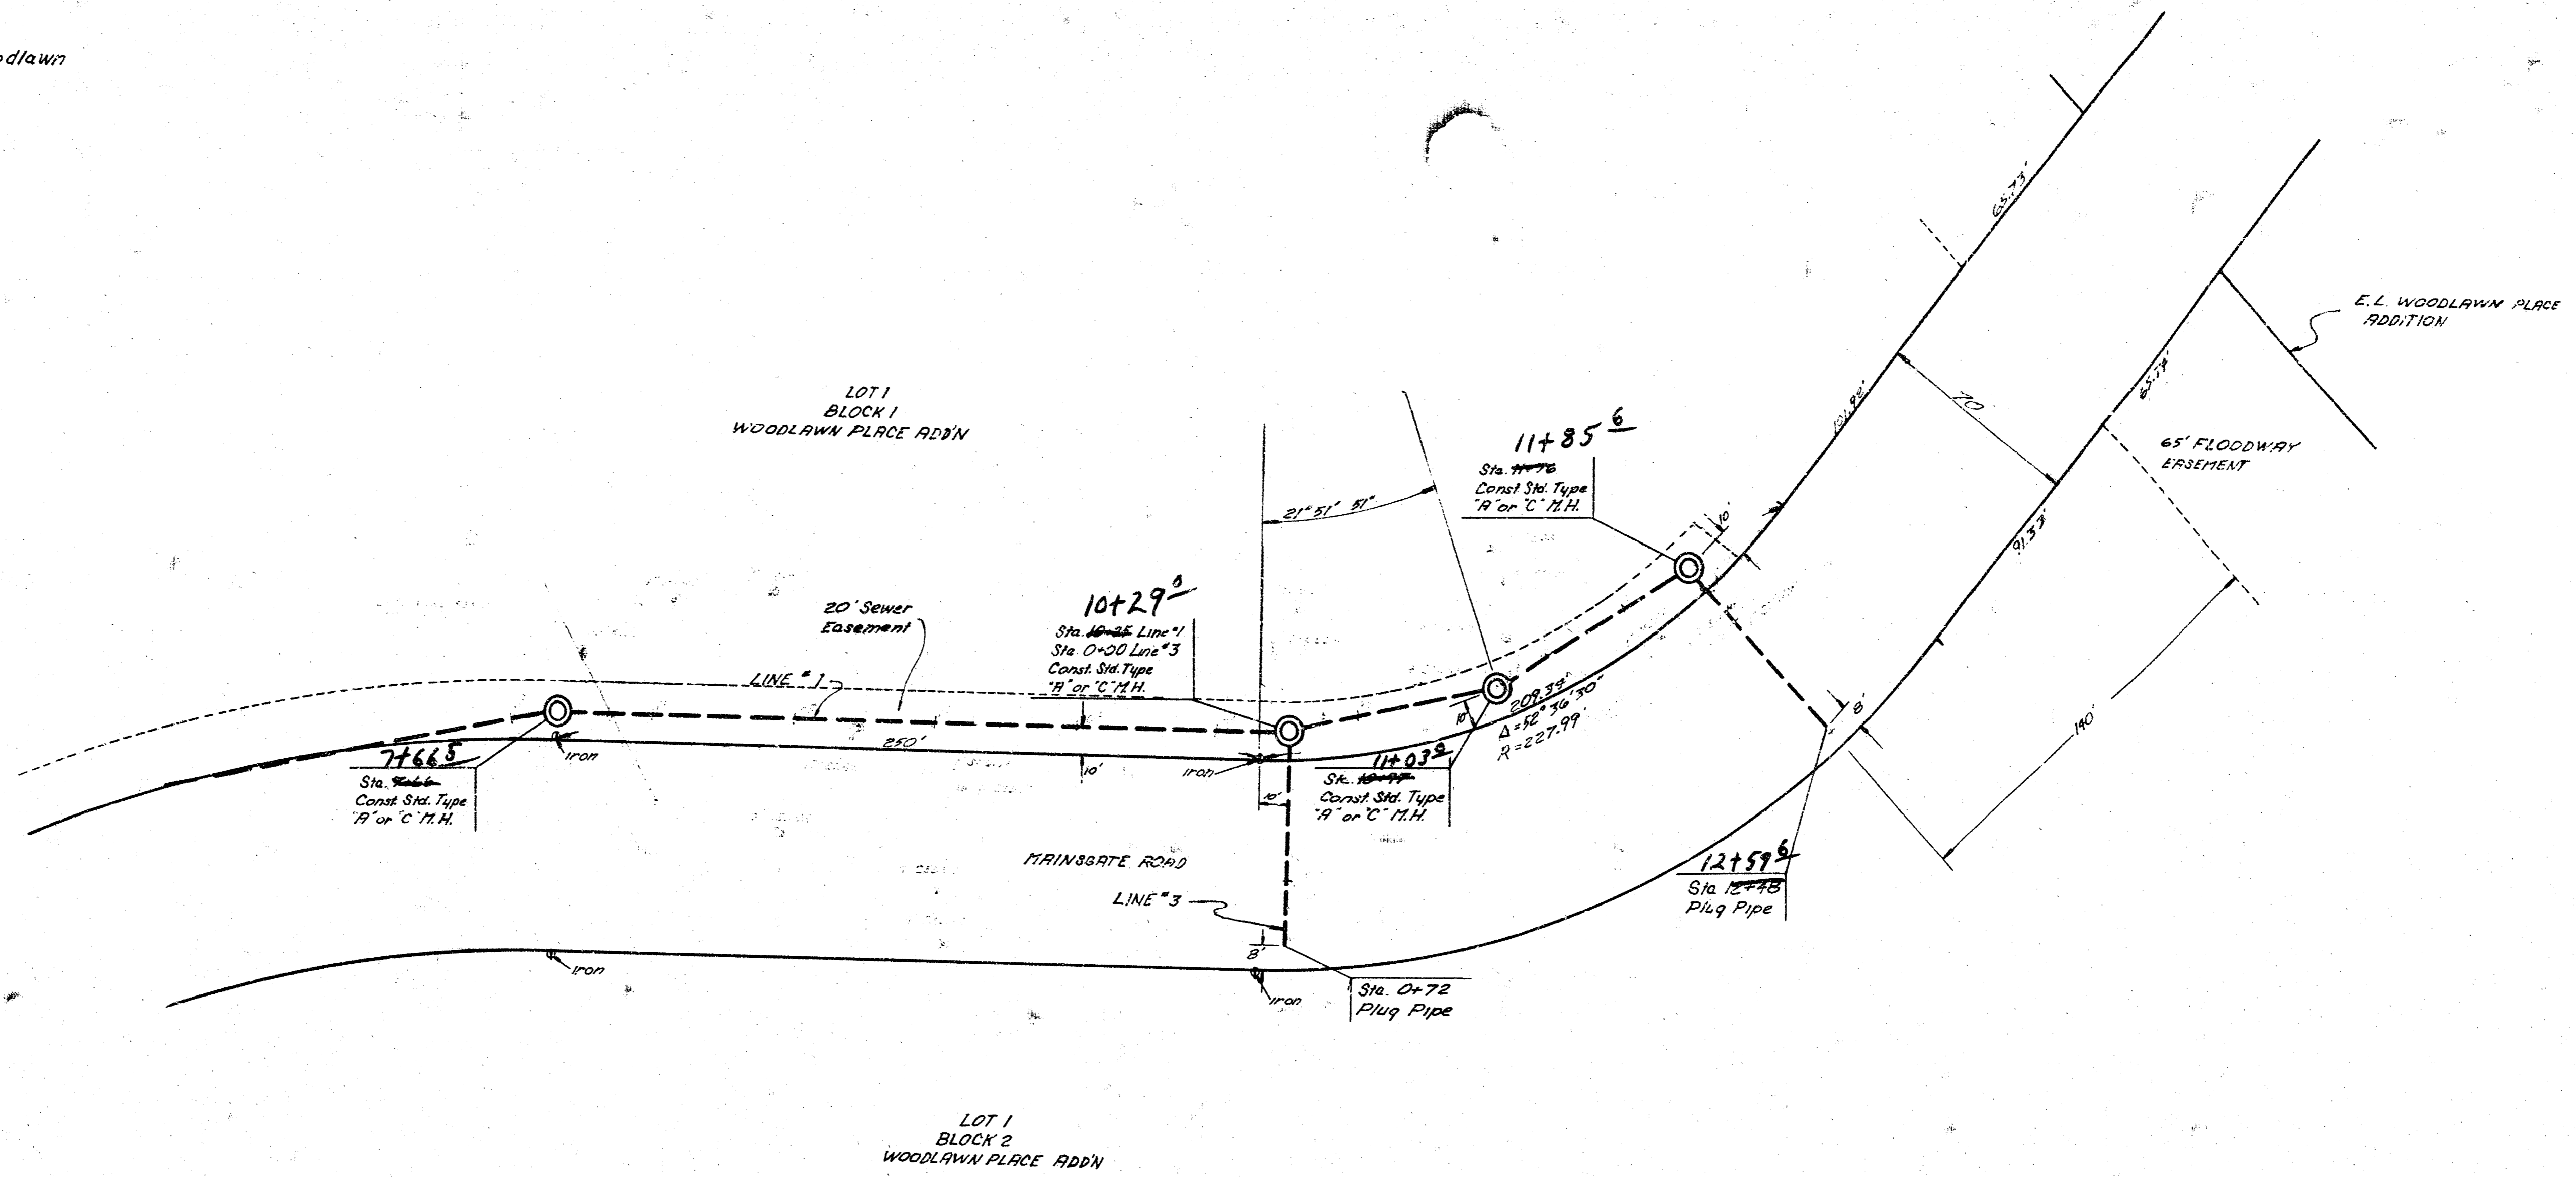


B.M. 188.48 City Sid. 26'S. + 47'E. of 25th + Woodlawn

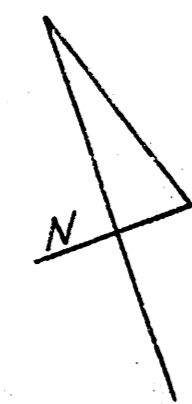


SCALE
 PLAN 1"=40'
 PROFILE VERT. 1"=5'

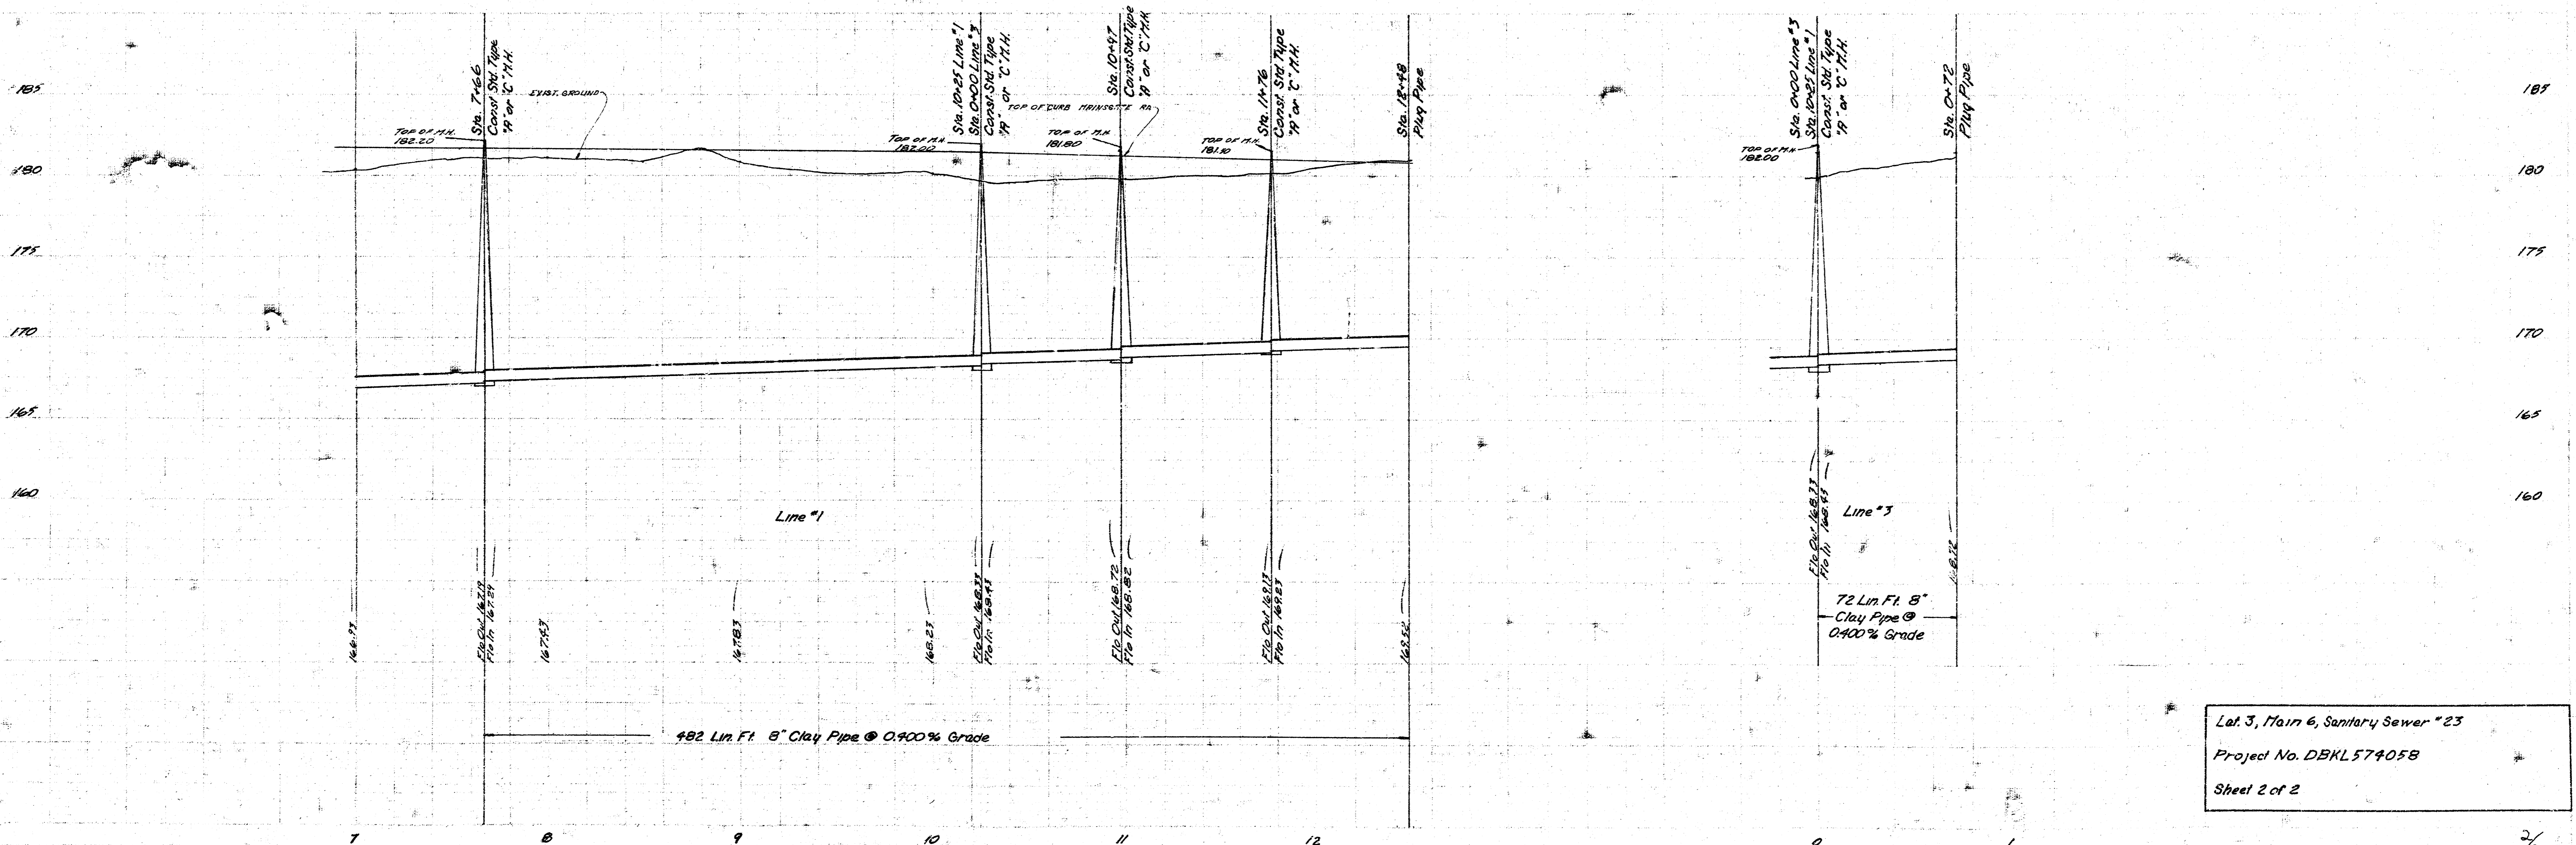

Lot 3, Main 6, Sanitary Sewer #23
 Project No. DBKL57405B
 Sheet 2 of 2


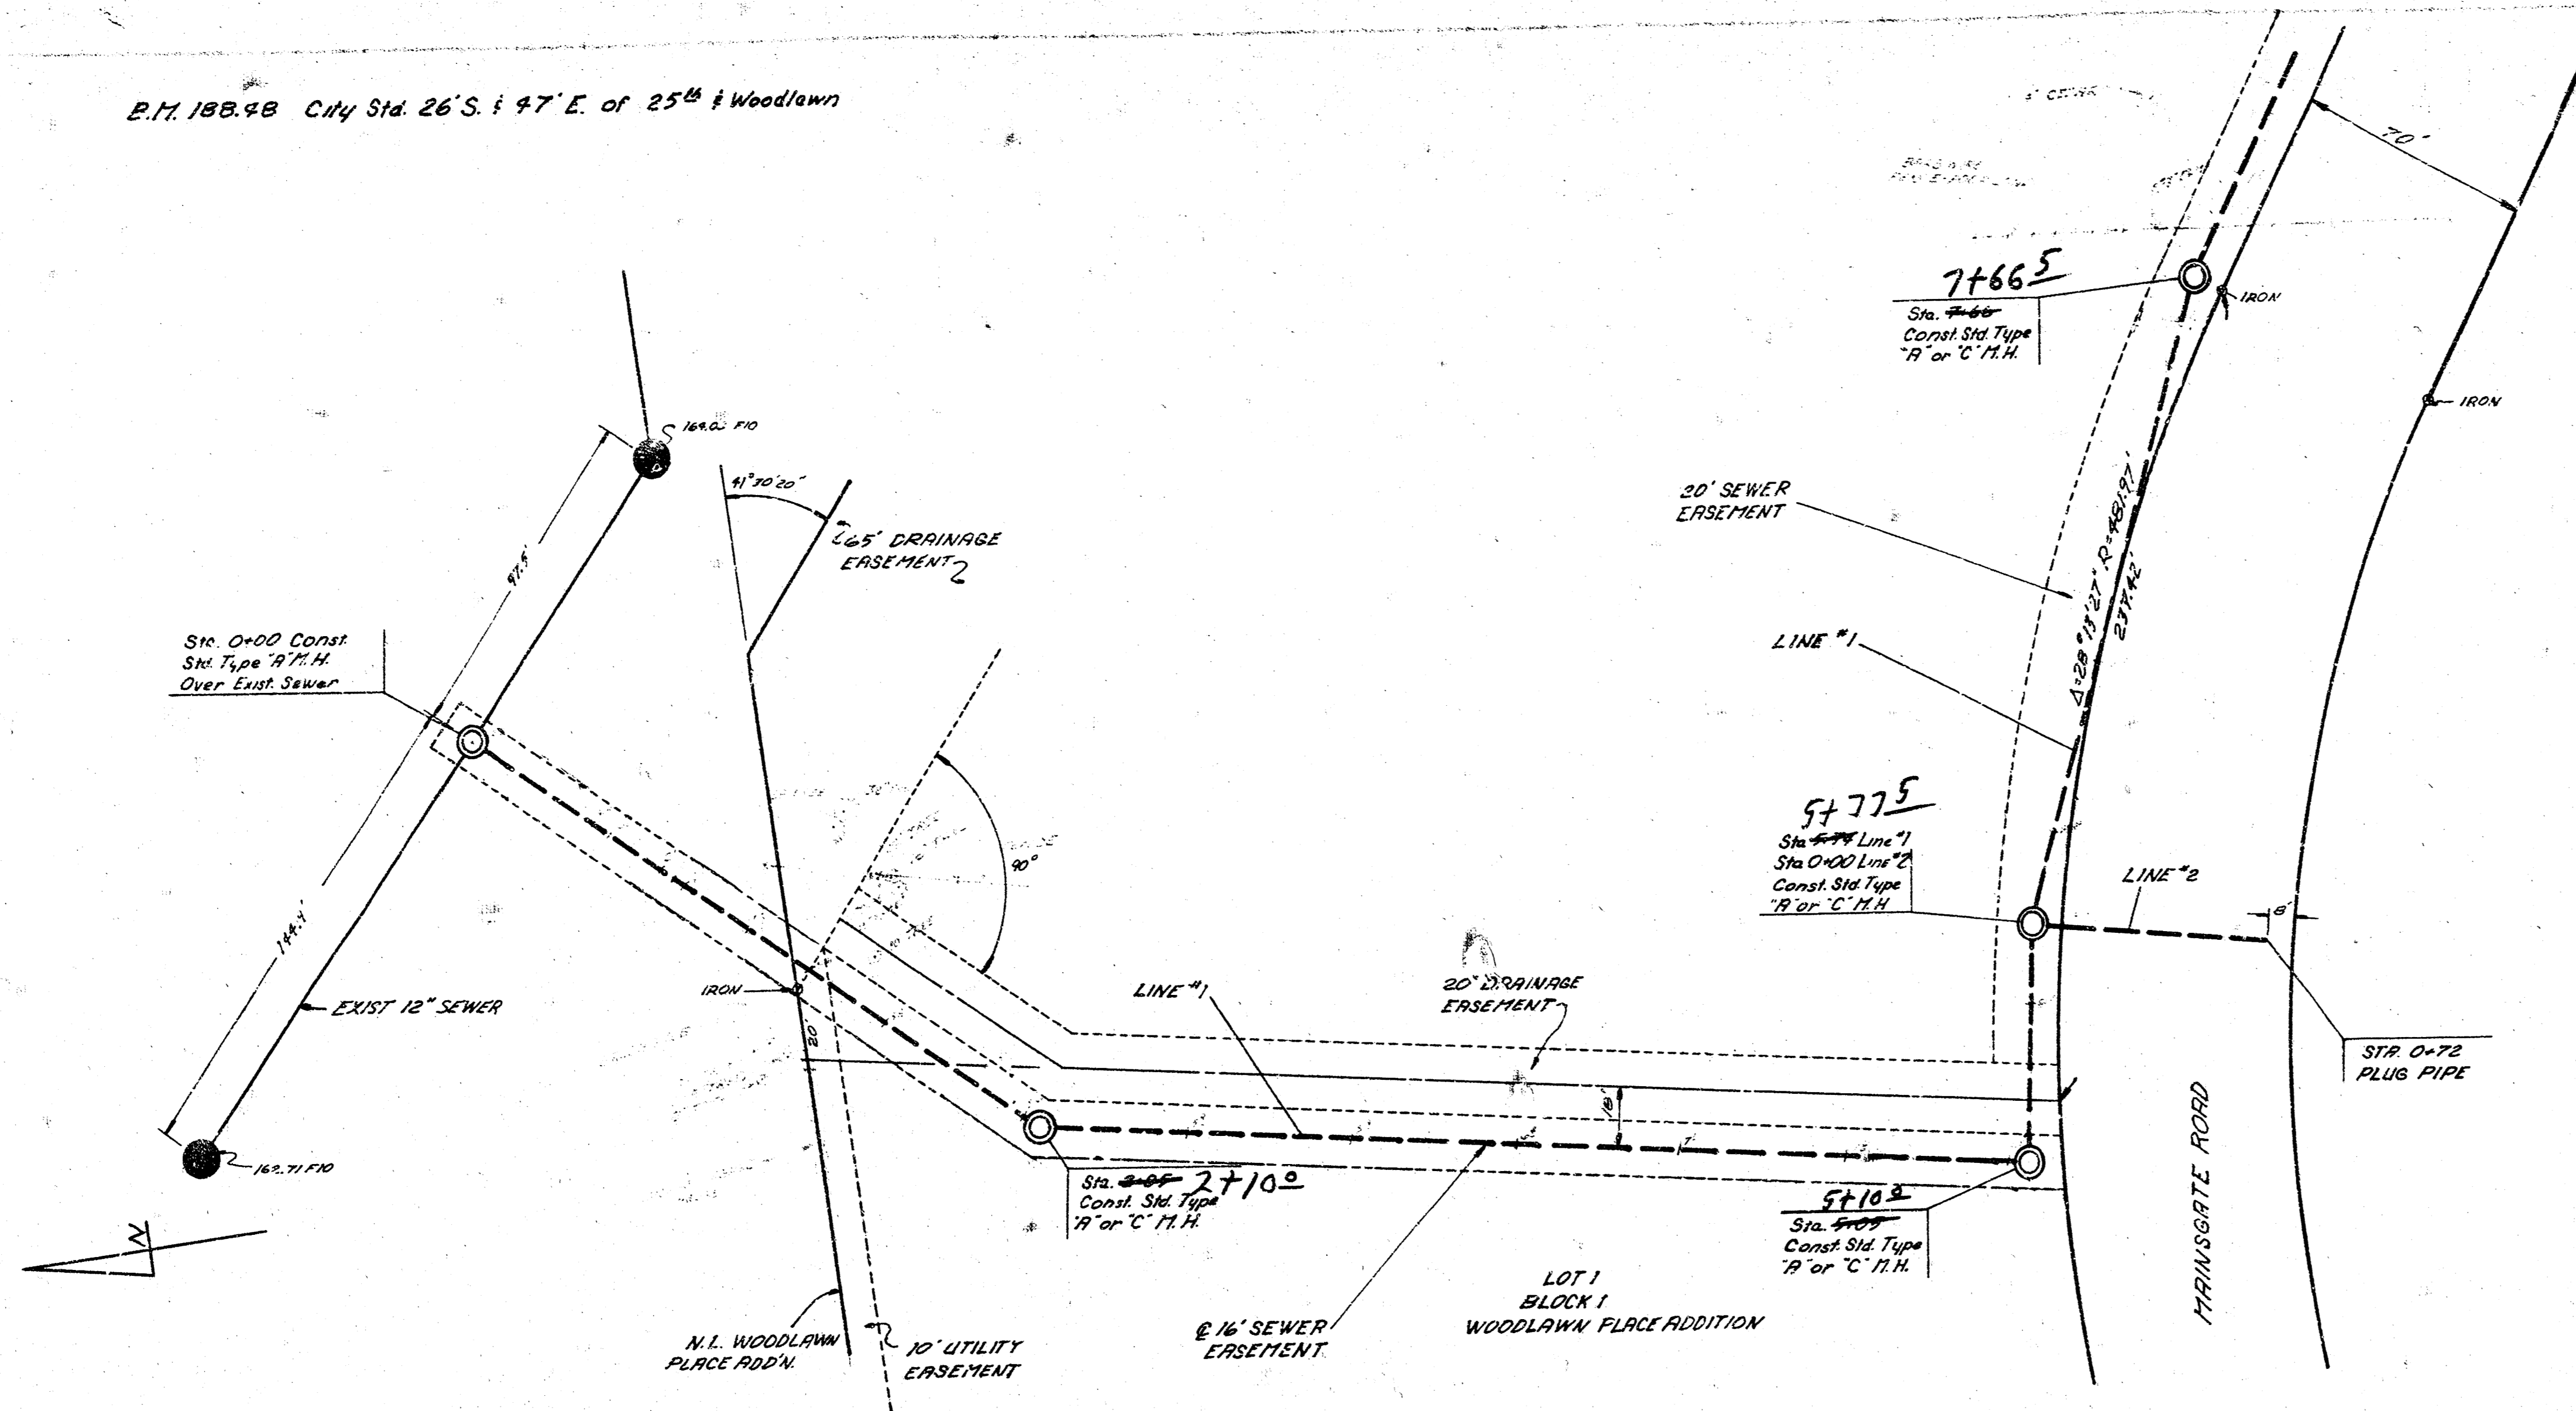


LOT 1
BLOCK 2
WOODLAWN PLACE ADDITION

- General Notes
1. Pipe Plugs Are To Be Temporary. Plugs & Cost is To Incidentals To Project.
 2. Fence To Be Removed & Replaced, as Necessary.
 3. Field Engineer to Determine Tree Removal.

NOTE
Sewer District is Lot 1, excepting the West 25', Blk 2, Woodlawn Place Addition

Scales:
Plan: 1"=40'
Profile: Vert: 1"=5'

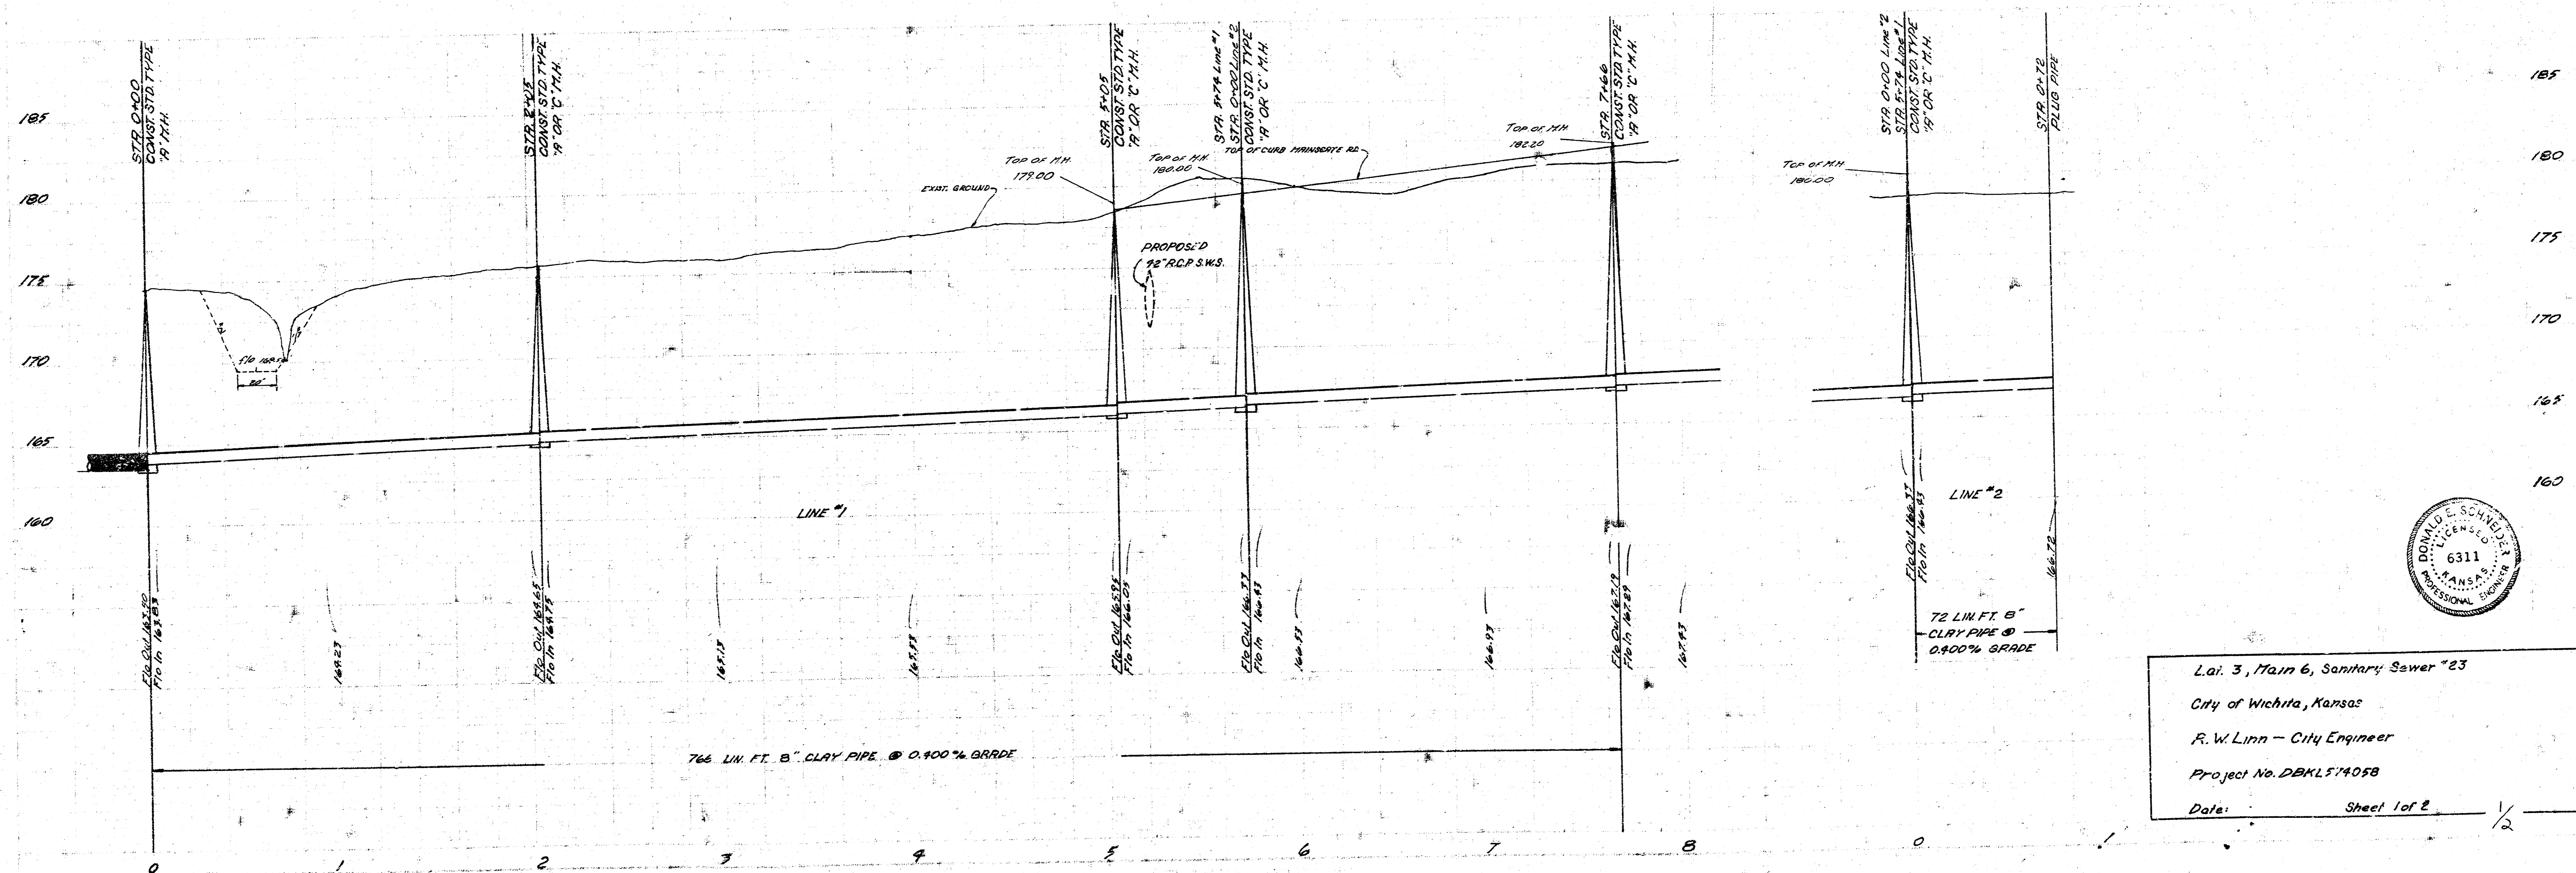

Lat. 3, Main 6, Sanitary Sewer #23
City of Wichita, Kansas
R. W. Linn - City Engineer
Date: _____ Sheet 1 of 2