


B. Dwyer
R. Loomis

DCD-463

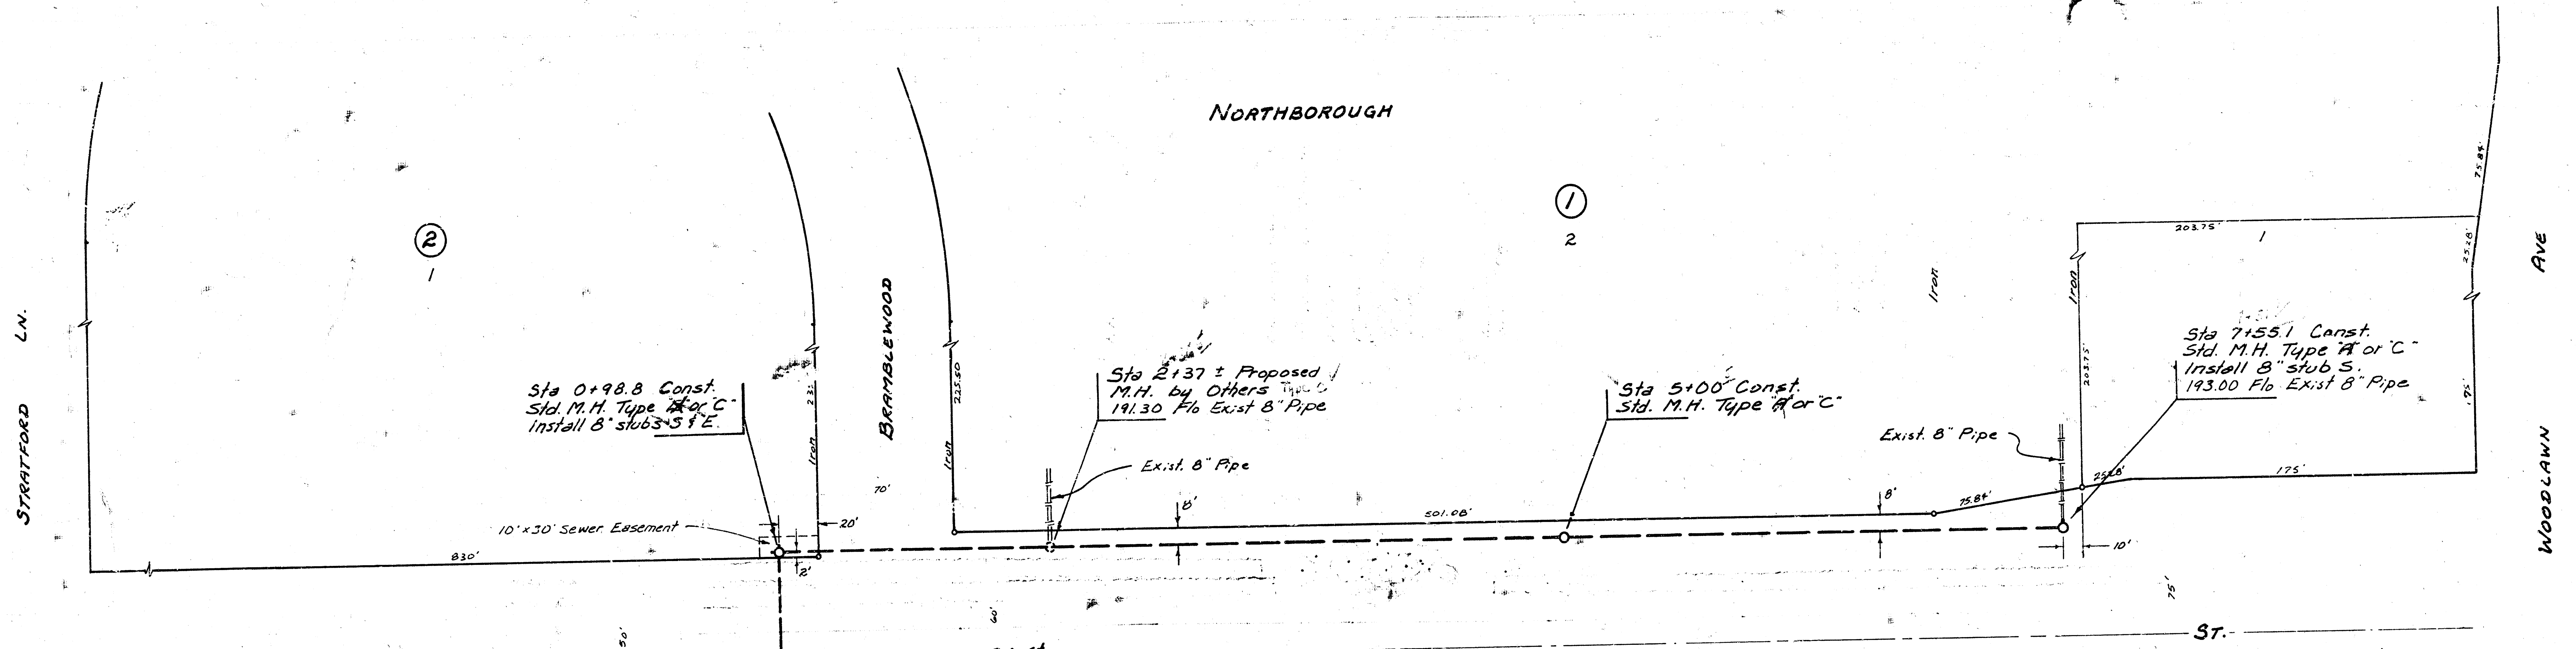

Sta 0+00 Exist. M.H.
Remove Exist. 8" stub S.

Sta 0+98.8 Const.
Std. M.H. Type A or C
Install 8" stub S.E.


Sta 2+37 ± Proposed
M.H. by Others
191.30 Flo Exist. 8" Pipe

Sta 5+00 Const.
Std. M.H. Type A or C

Sta 7+55.1 Const.
Std. M.H. Type A or C
Install 8" stub S.
193.00 Flo Exist. 8" Pipe

B.M. 200.65 City Std. Disc. 45.4' E and 45.4' N.
of E of Woodlawn and 21st St.

Scale Plan 1" = 40'
Profile 1" = 40' Horiz.
1" = 5' Vert.

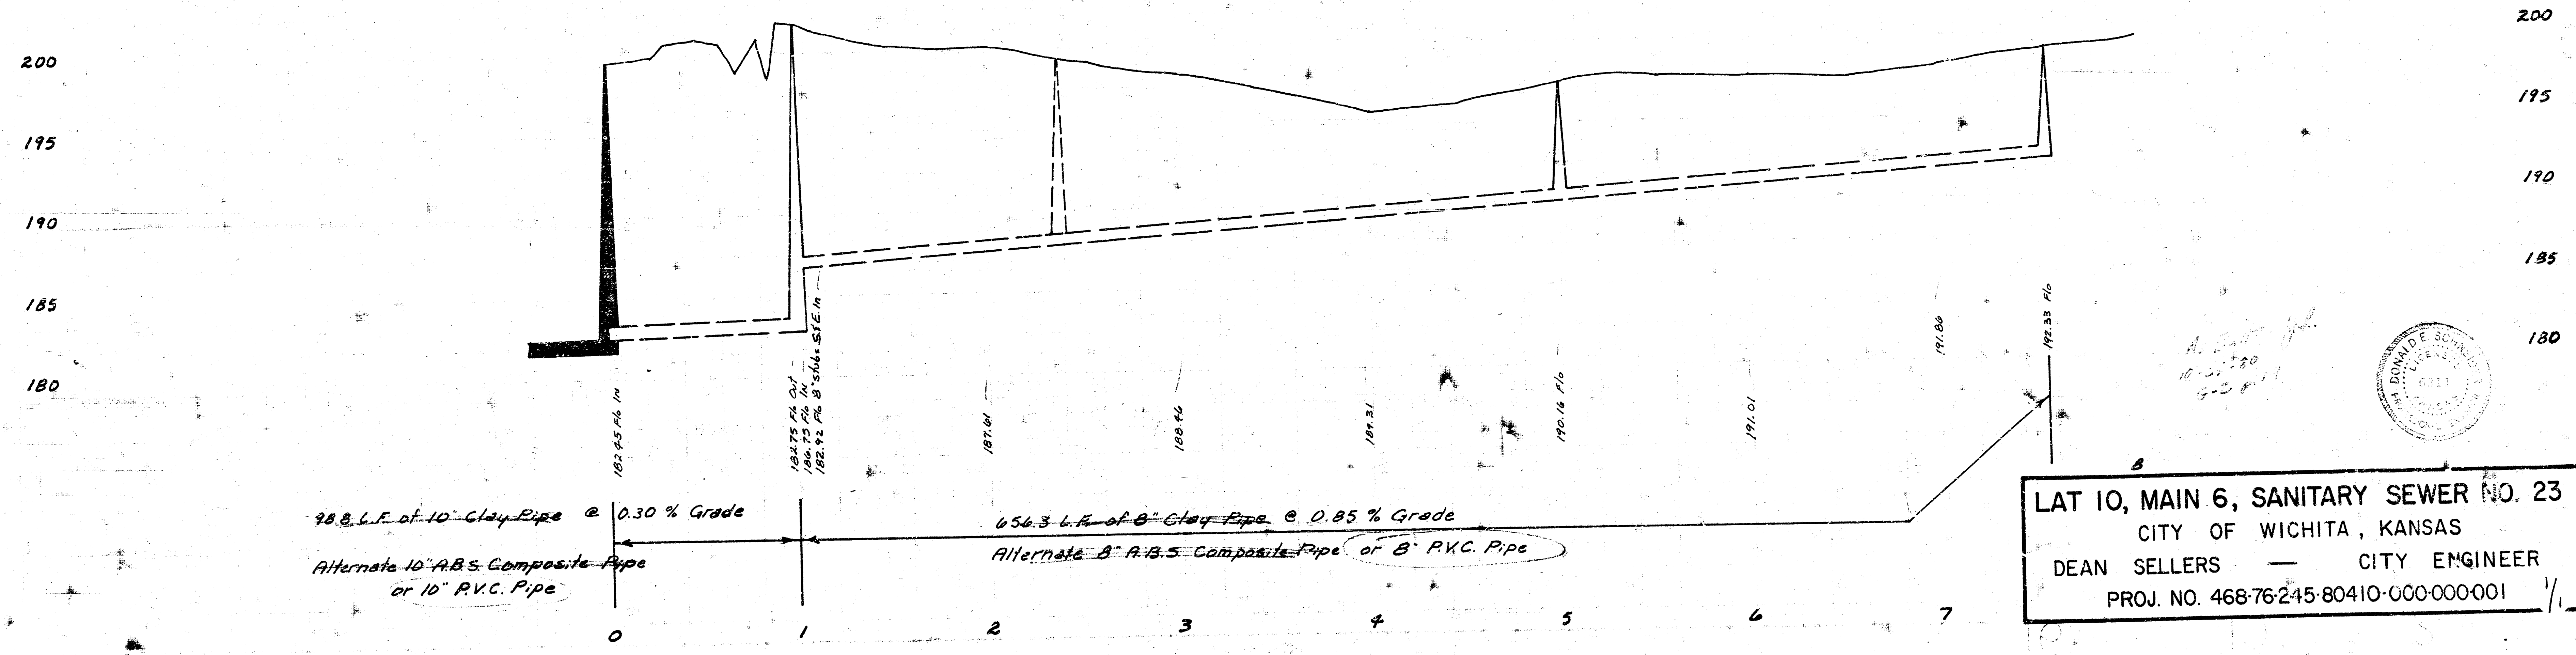

98.8 L.F. of 10" Clay Pipe @ 0.30 % Grade
Alternate 10" ABS Composite Pipe
or 10" PVC Pipe

656.3 L.F. of 8" Clay Pipe @ 0.85 % Grade
Alternate 8" ABS Composite Pipe or 8" PVC Pipe

LAT 10, MAIN 6, SANITARY SEWER NO. 23
CITY OF WICHITA, KANSAS
DEAN SELLERS — CITY ENGINEER
PROJ. NO. 468-76-245-80410-000-000001

