

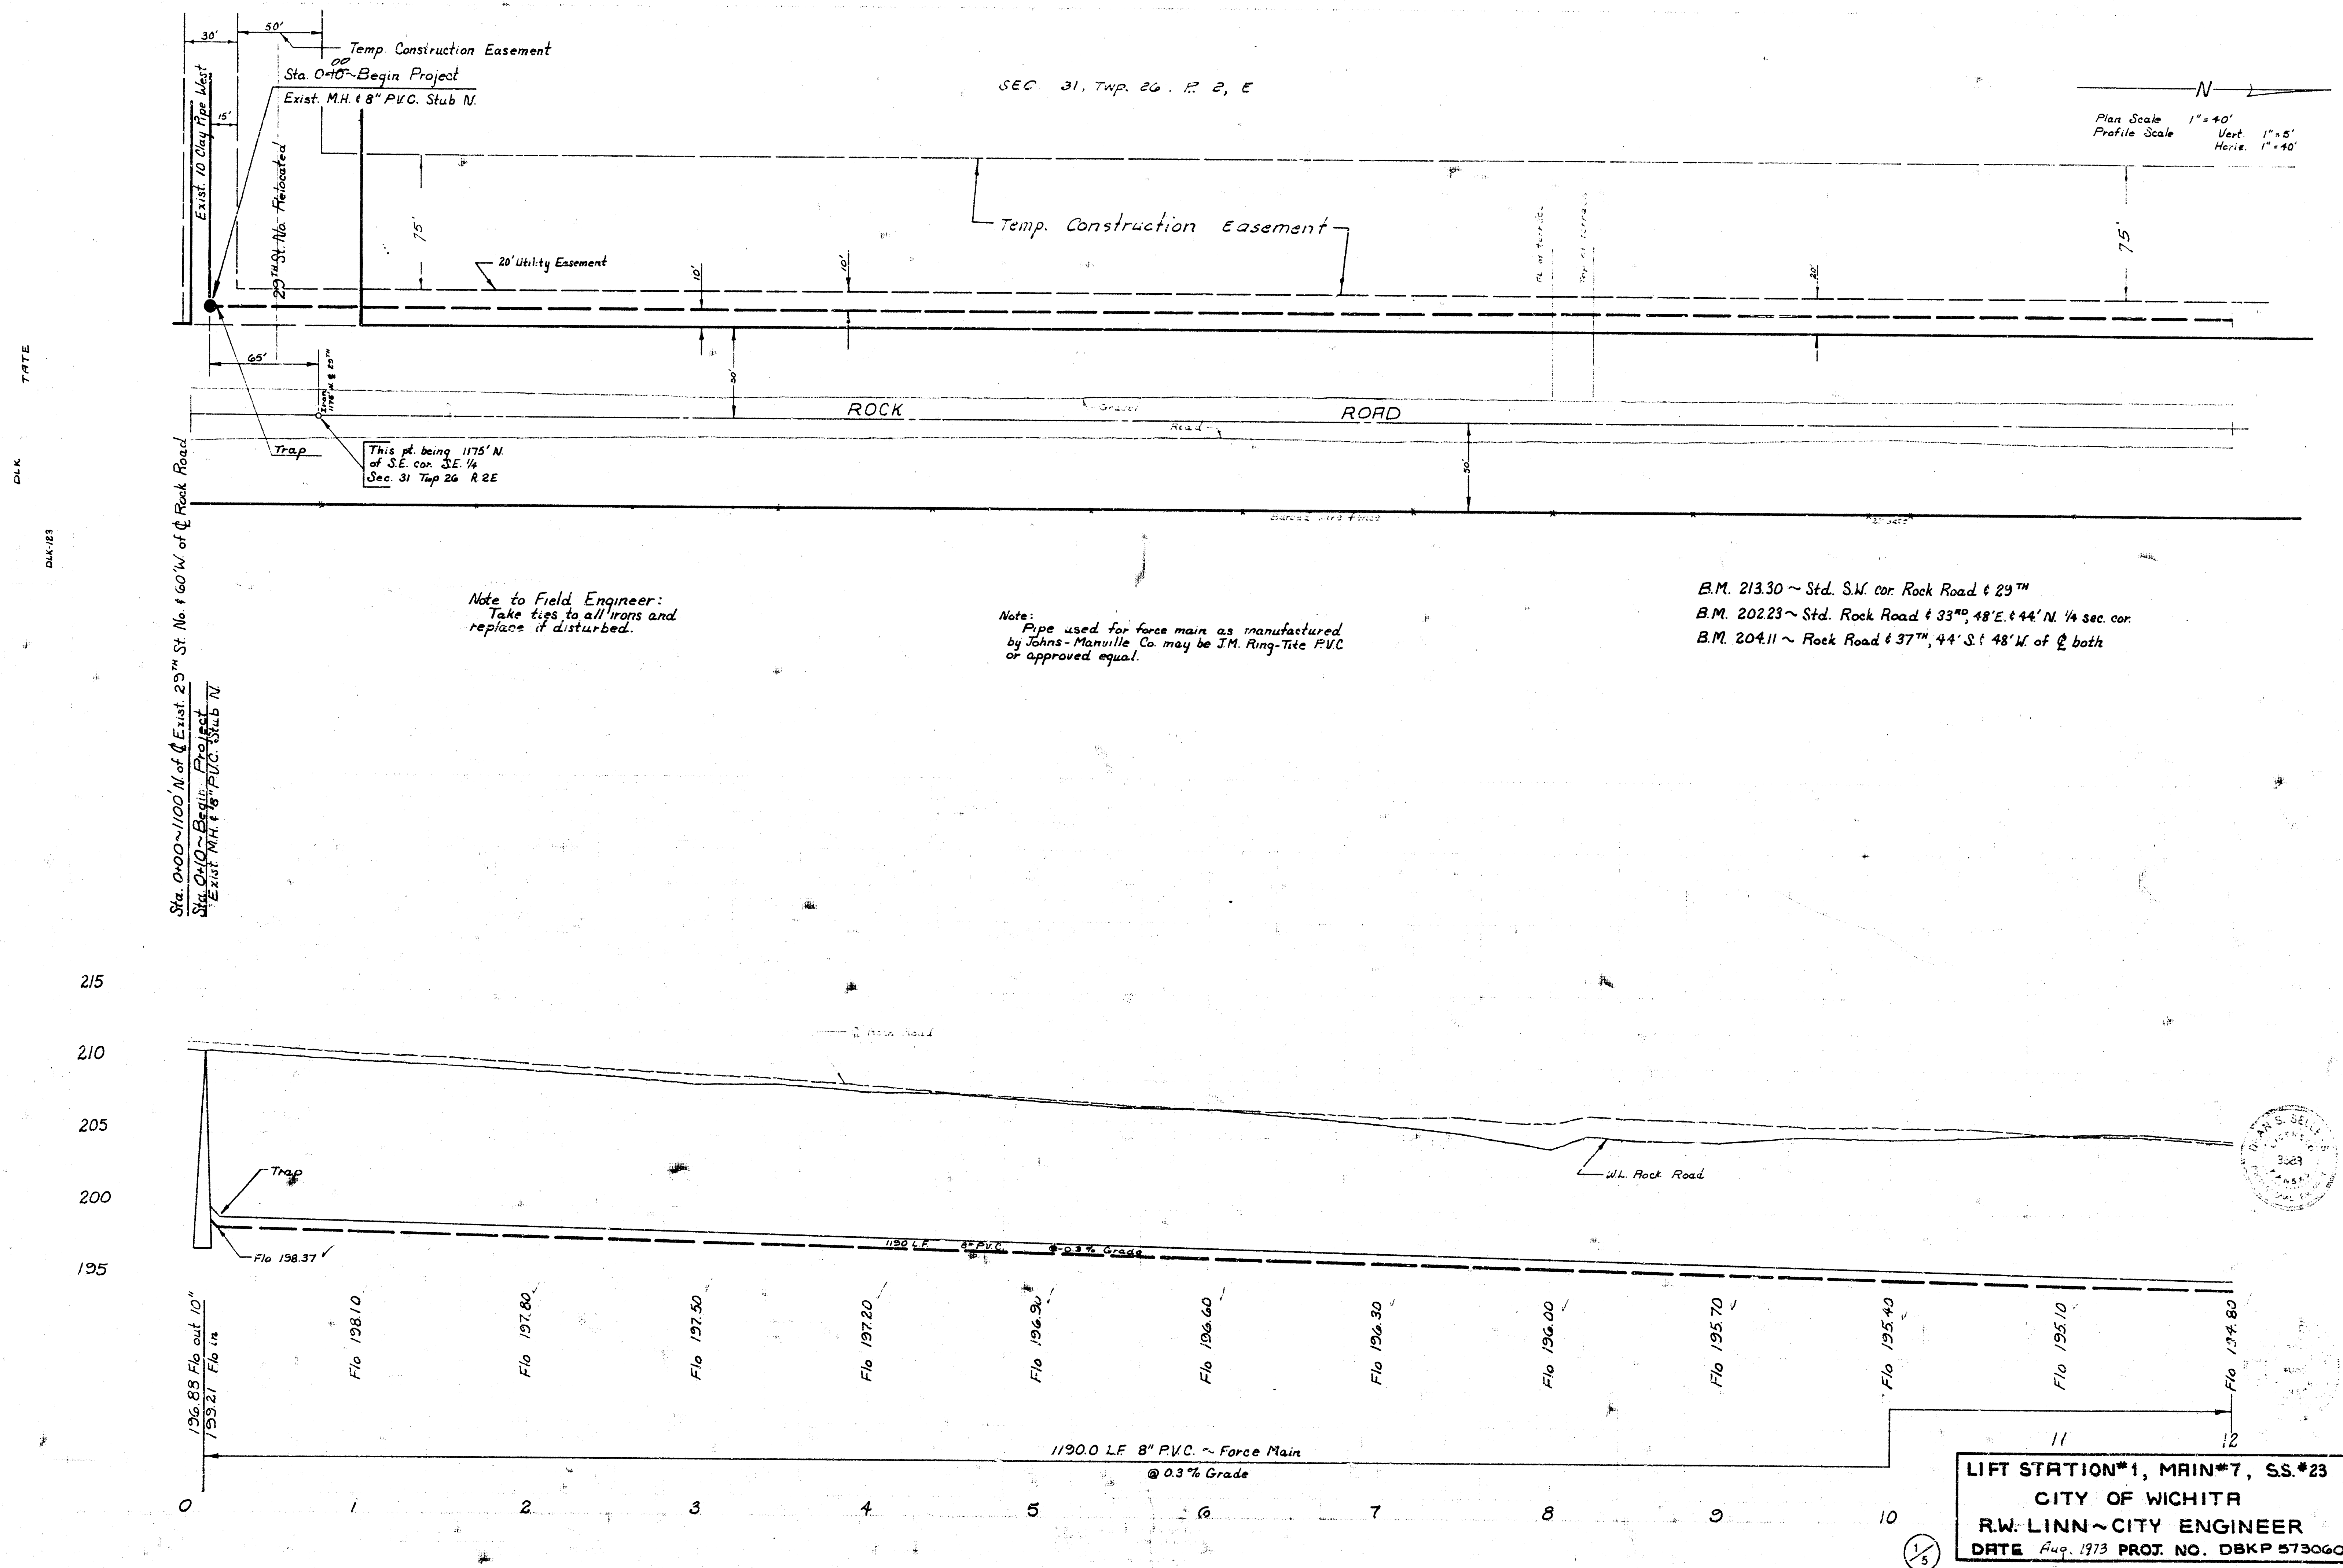


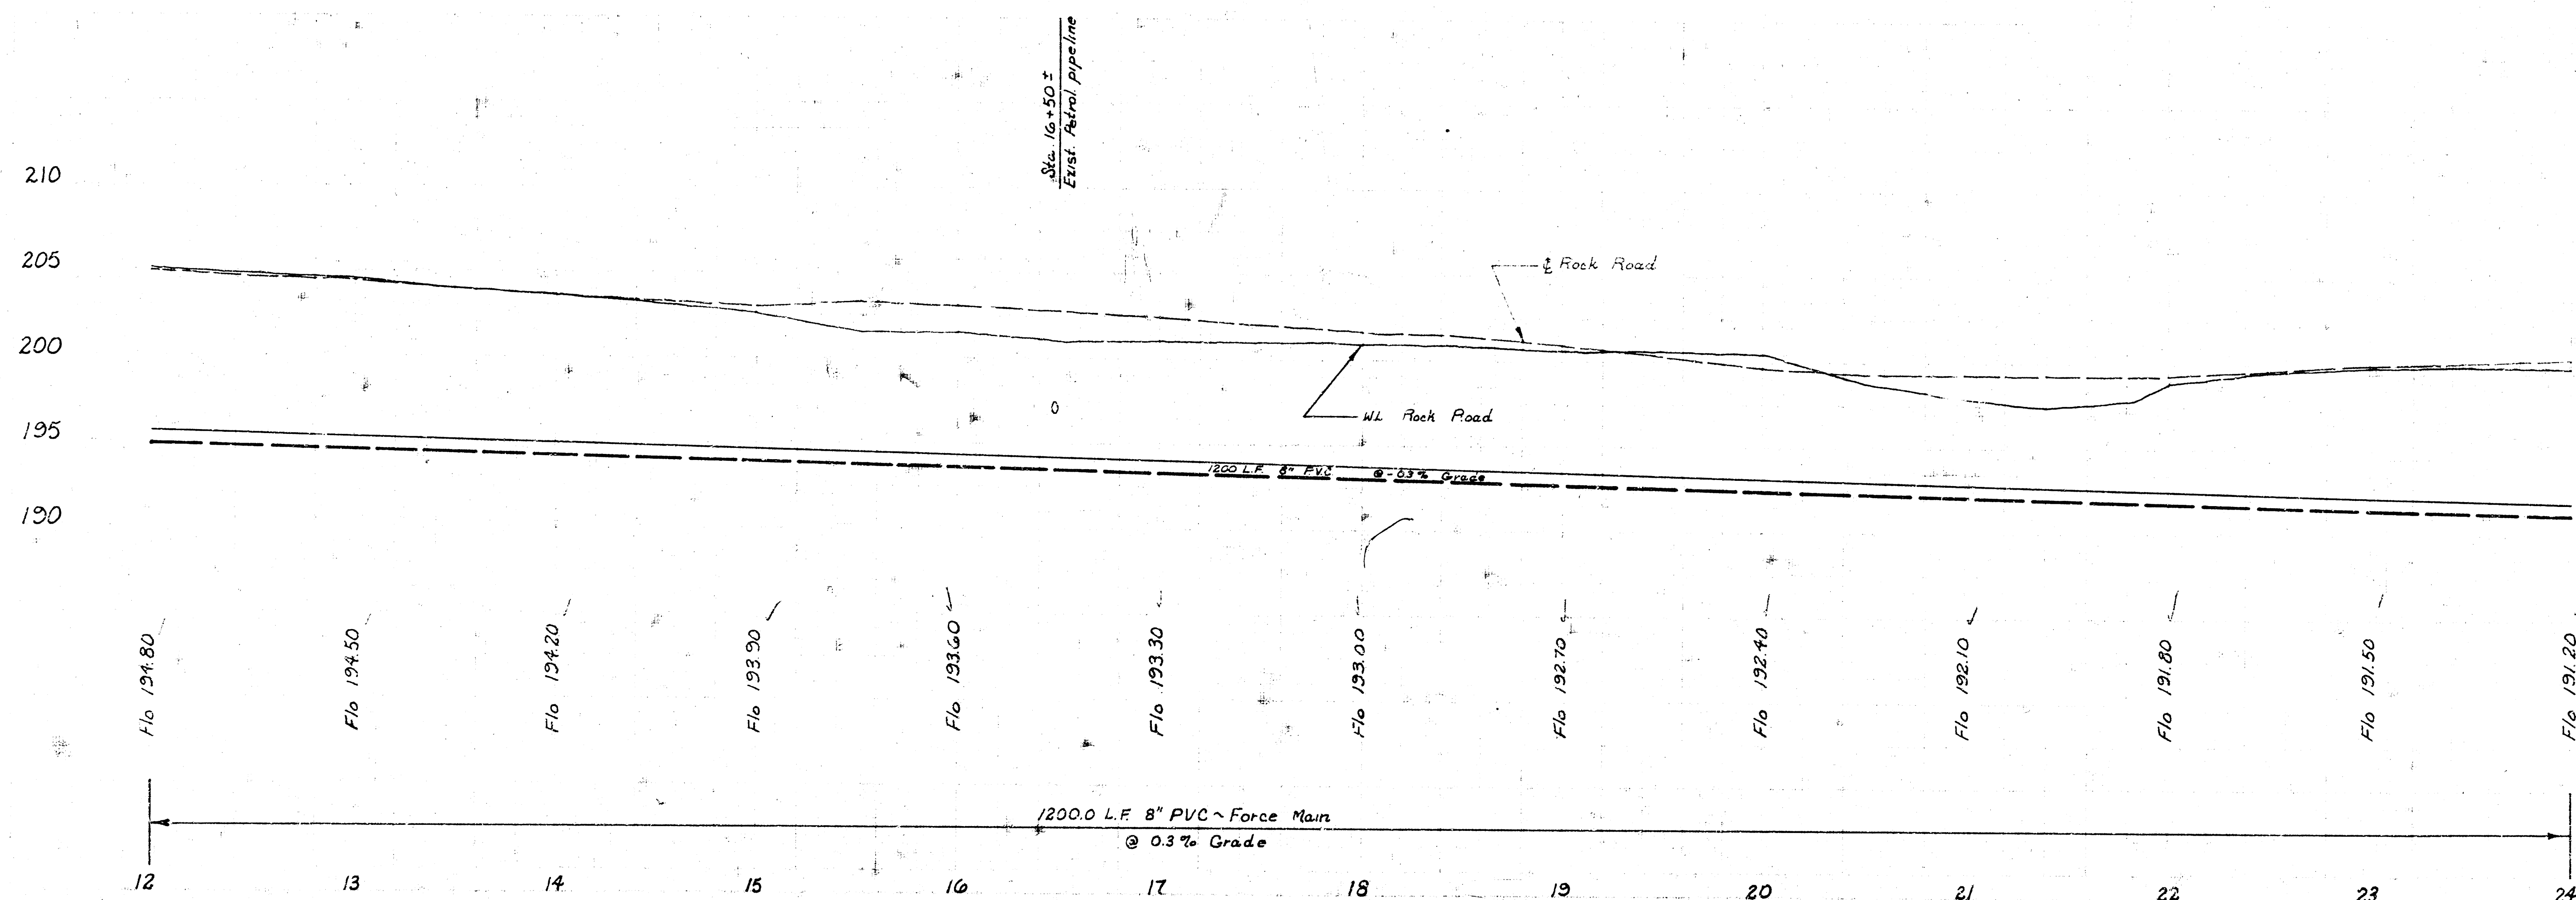


DLA TATE




DLA-123

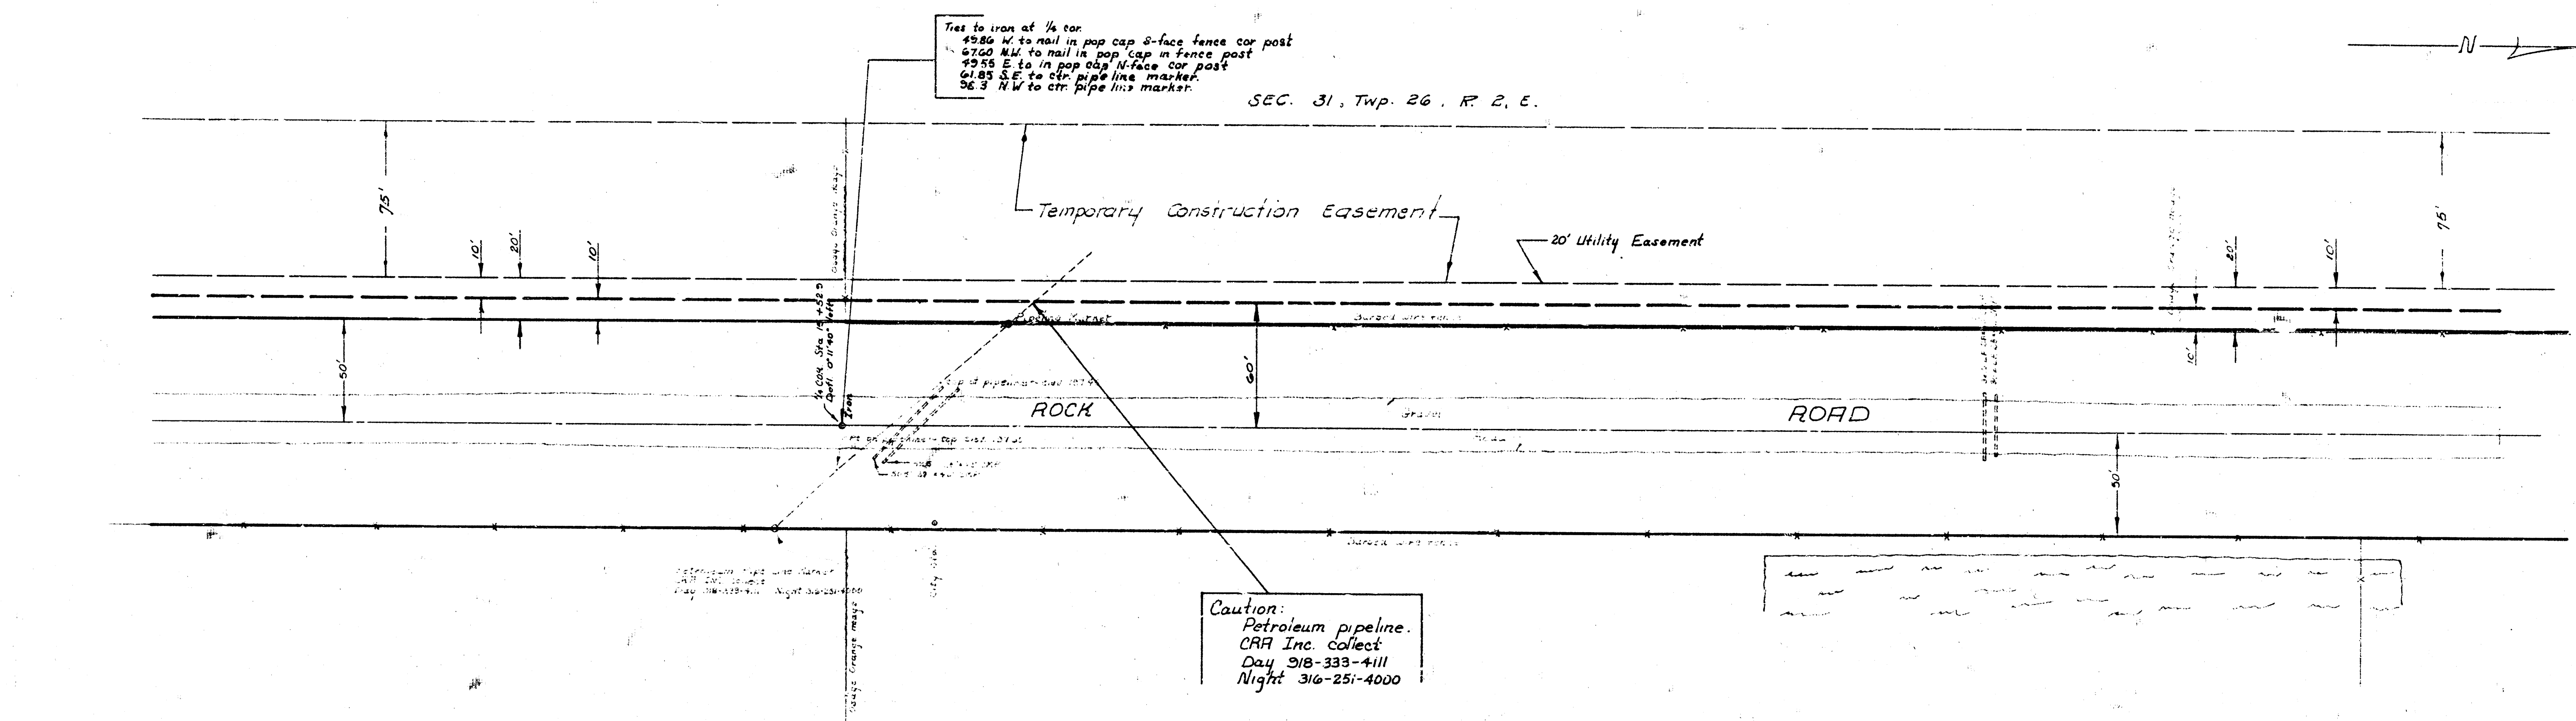

LIFT STA. *1, MAIN *7, SS. *23
PROJ. NO. DBKP 573060



2/6

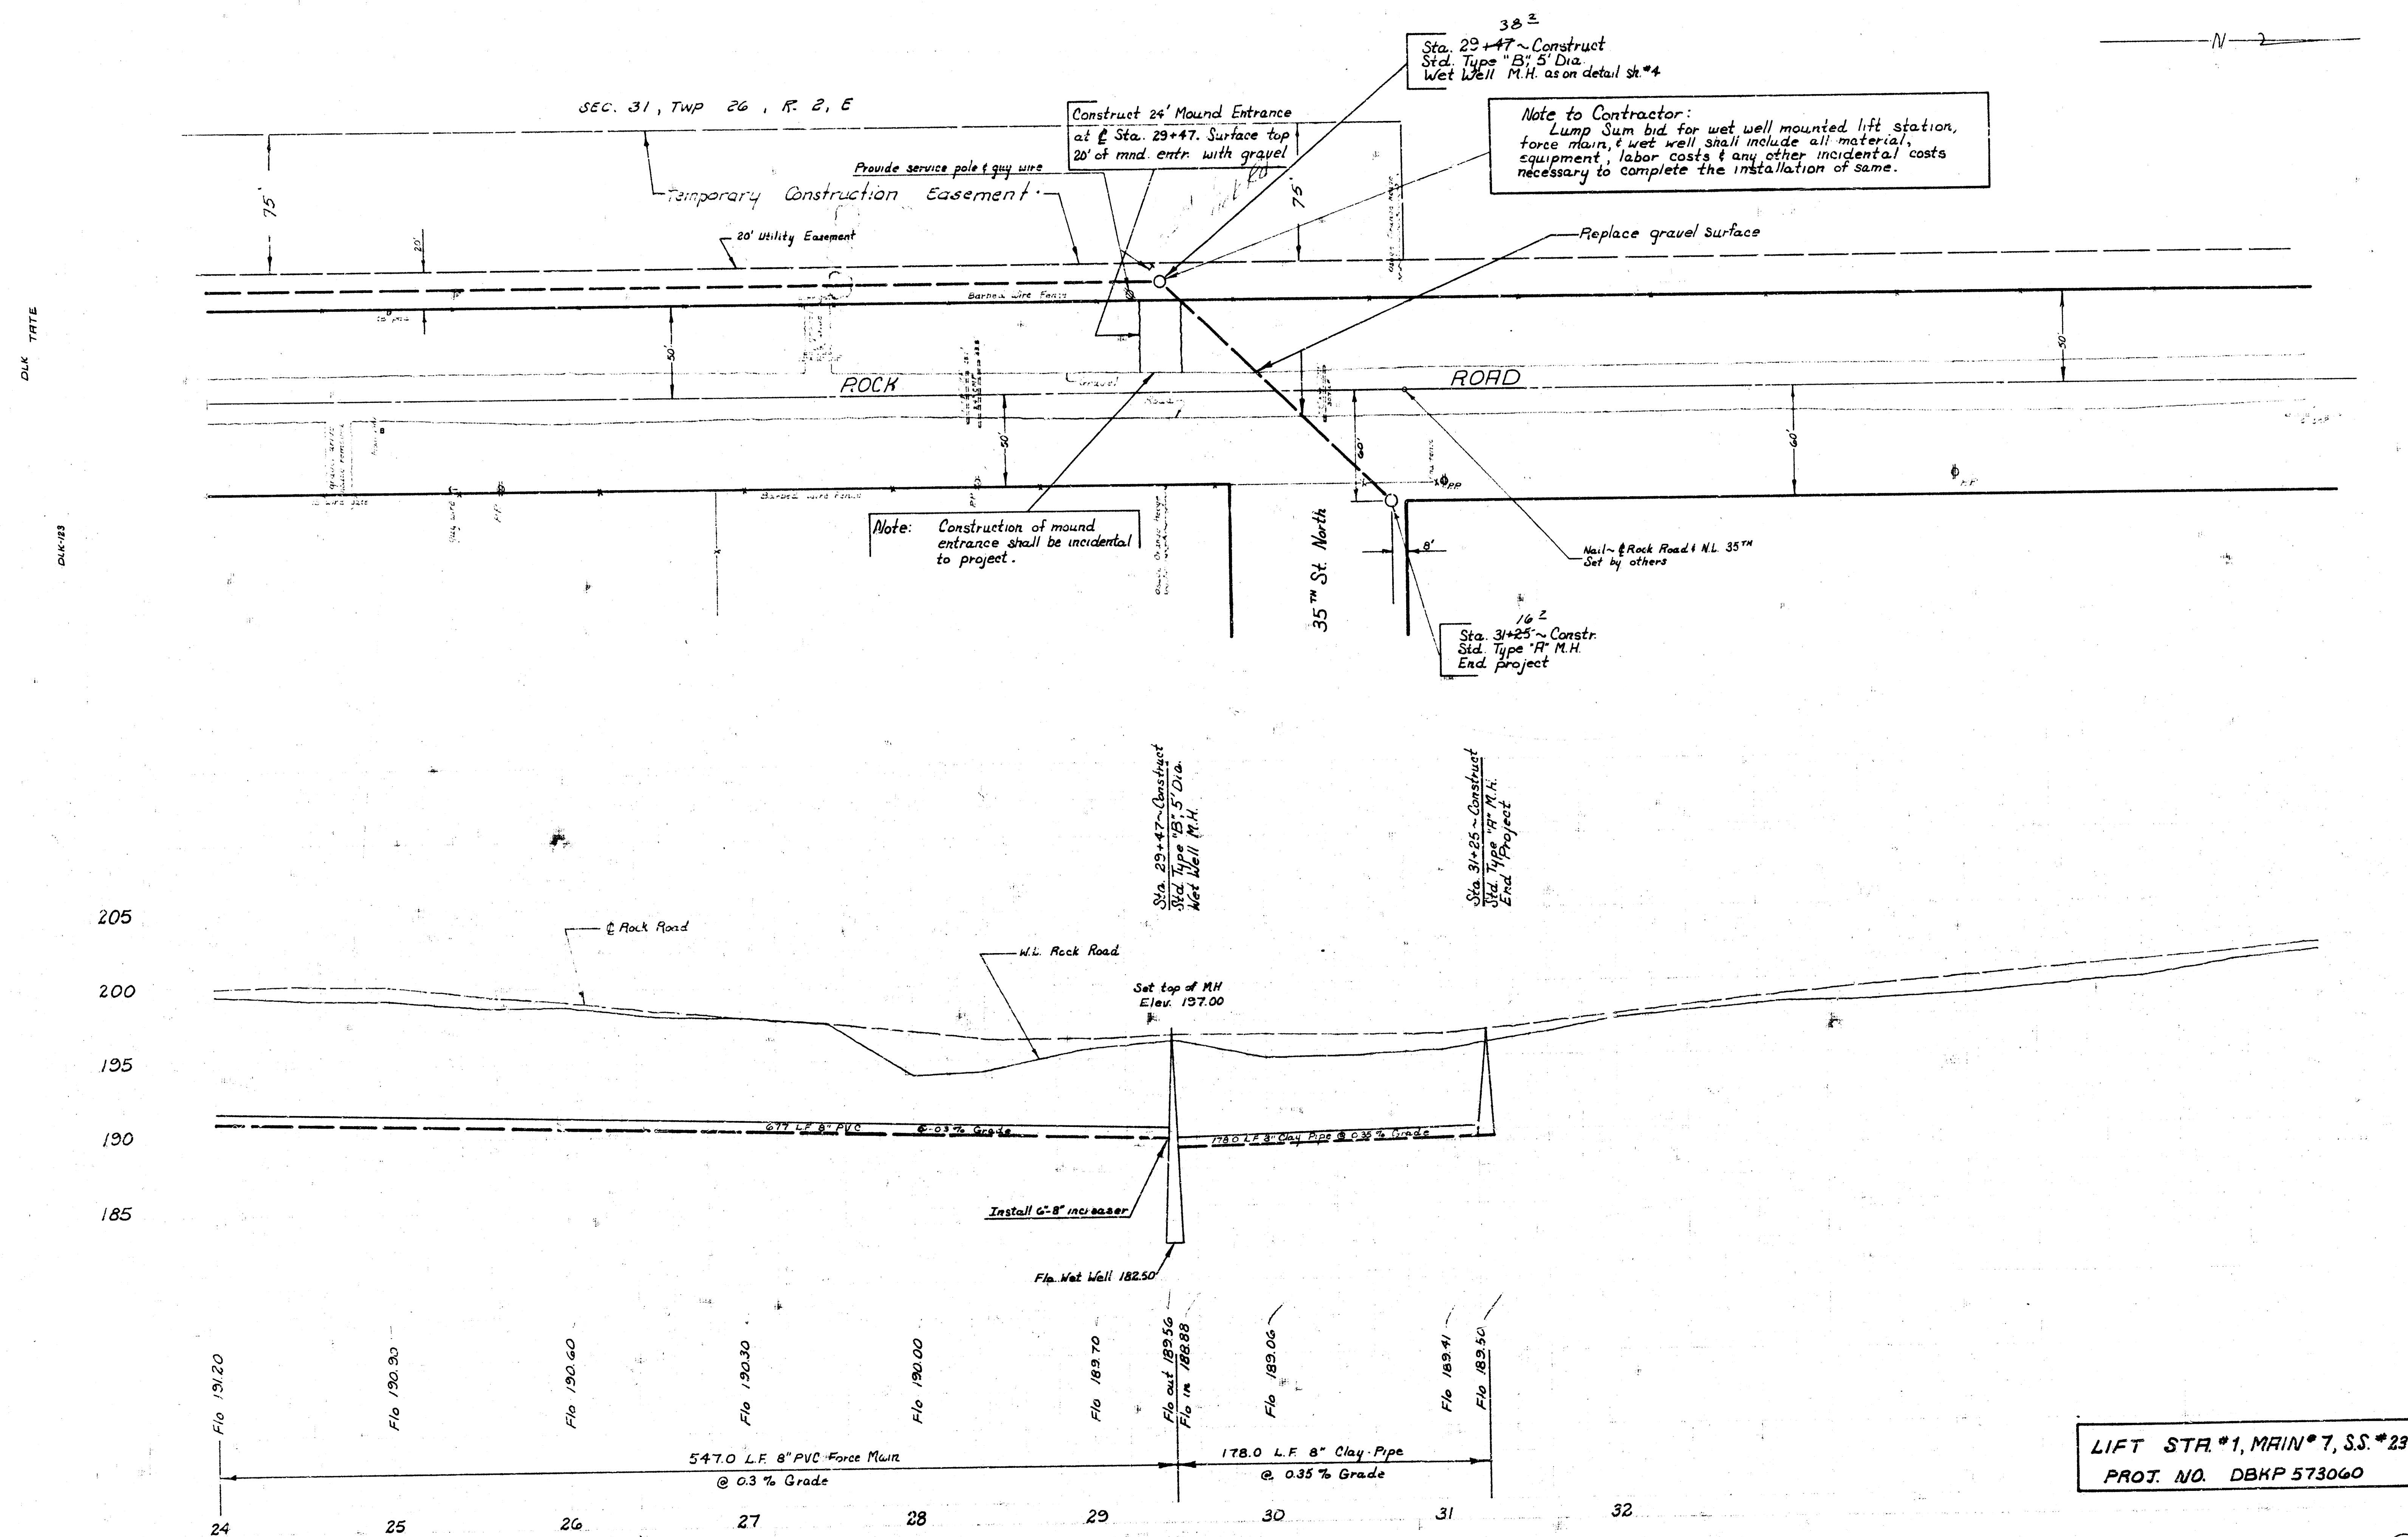

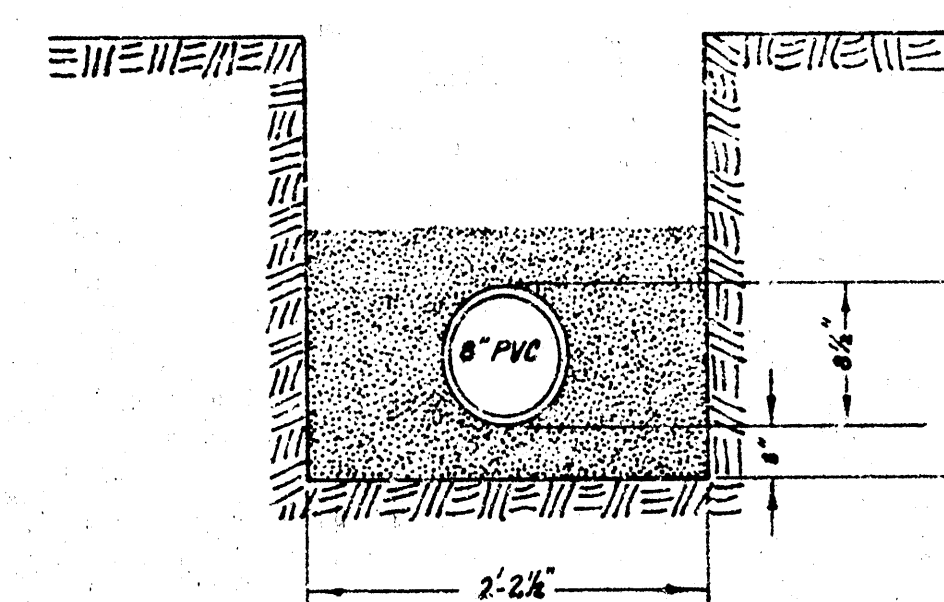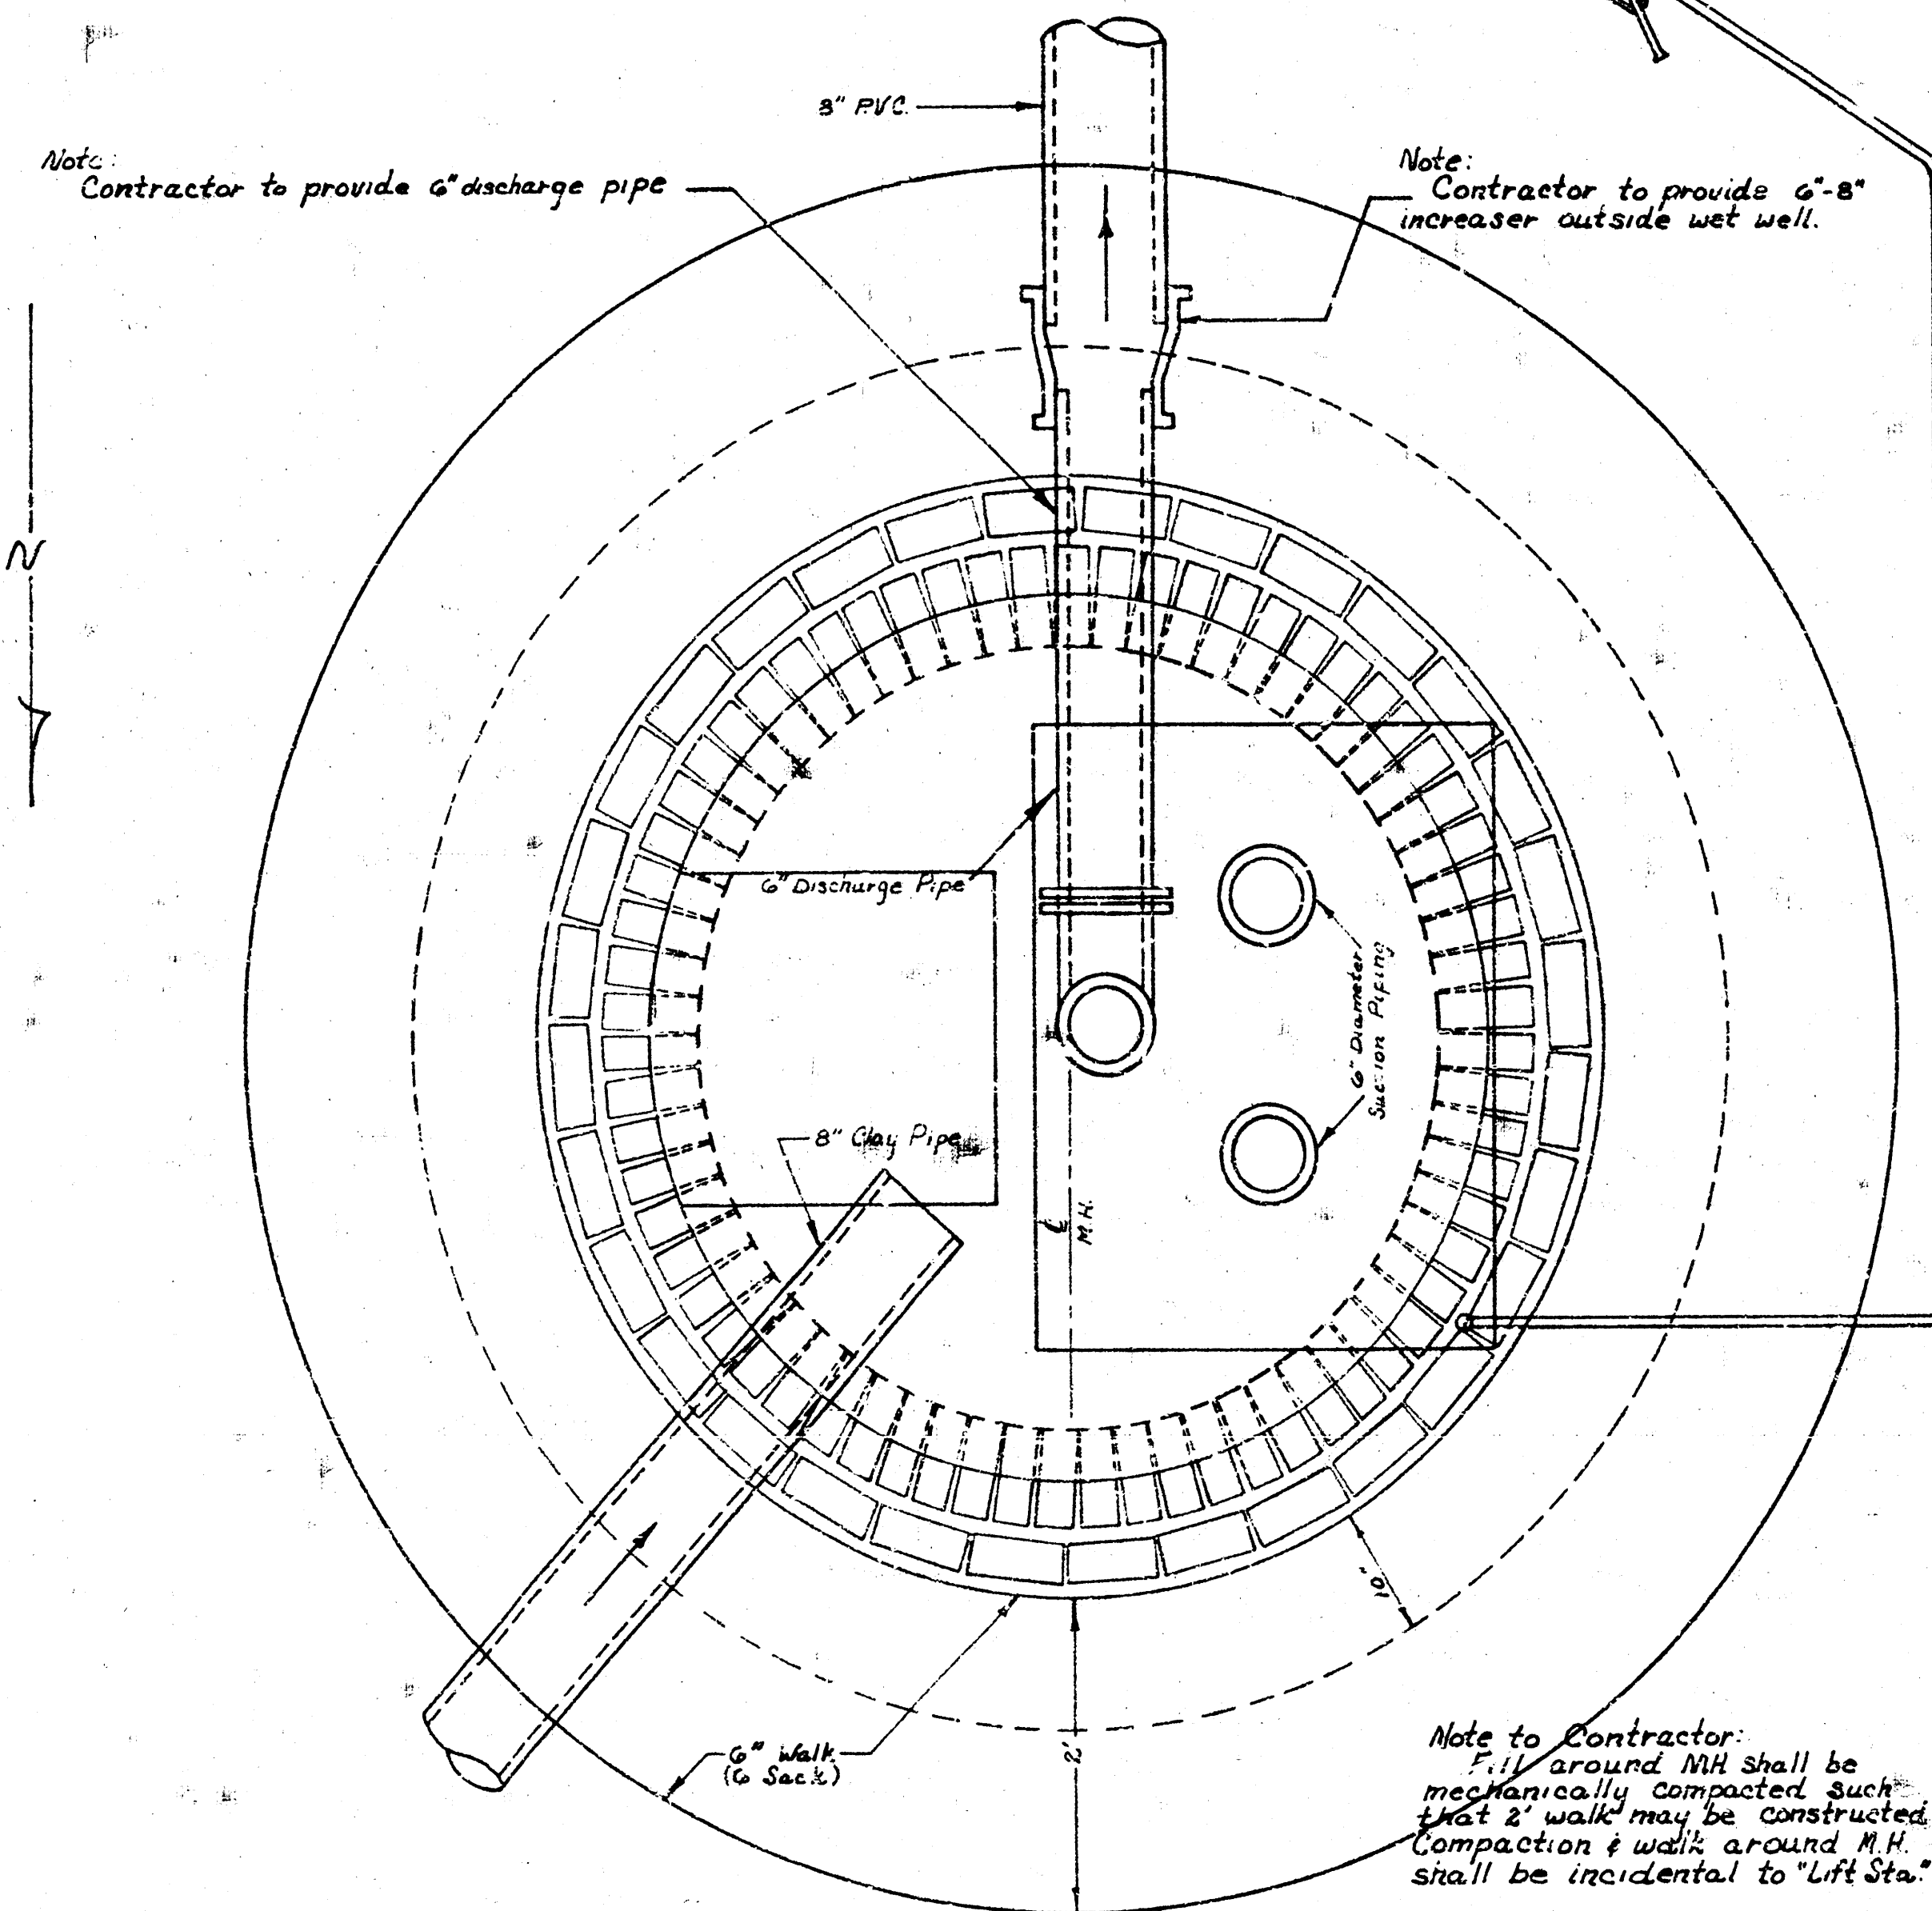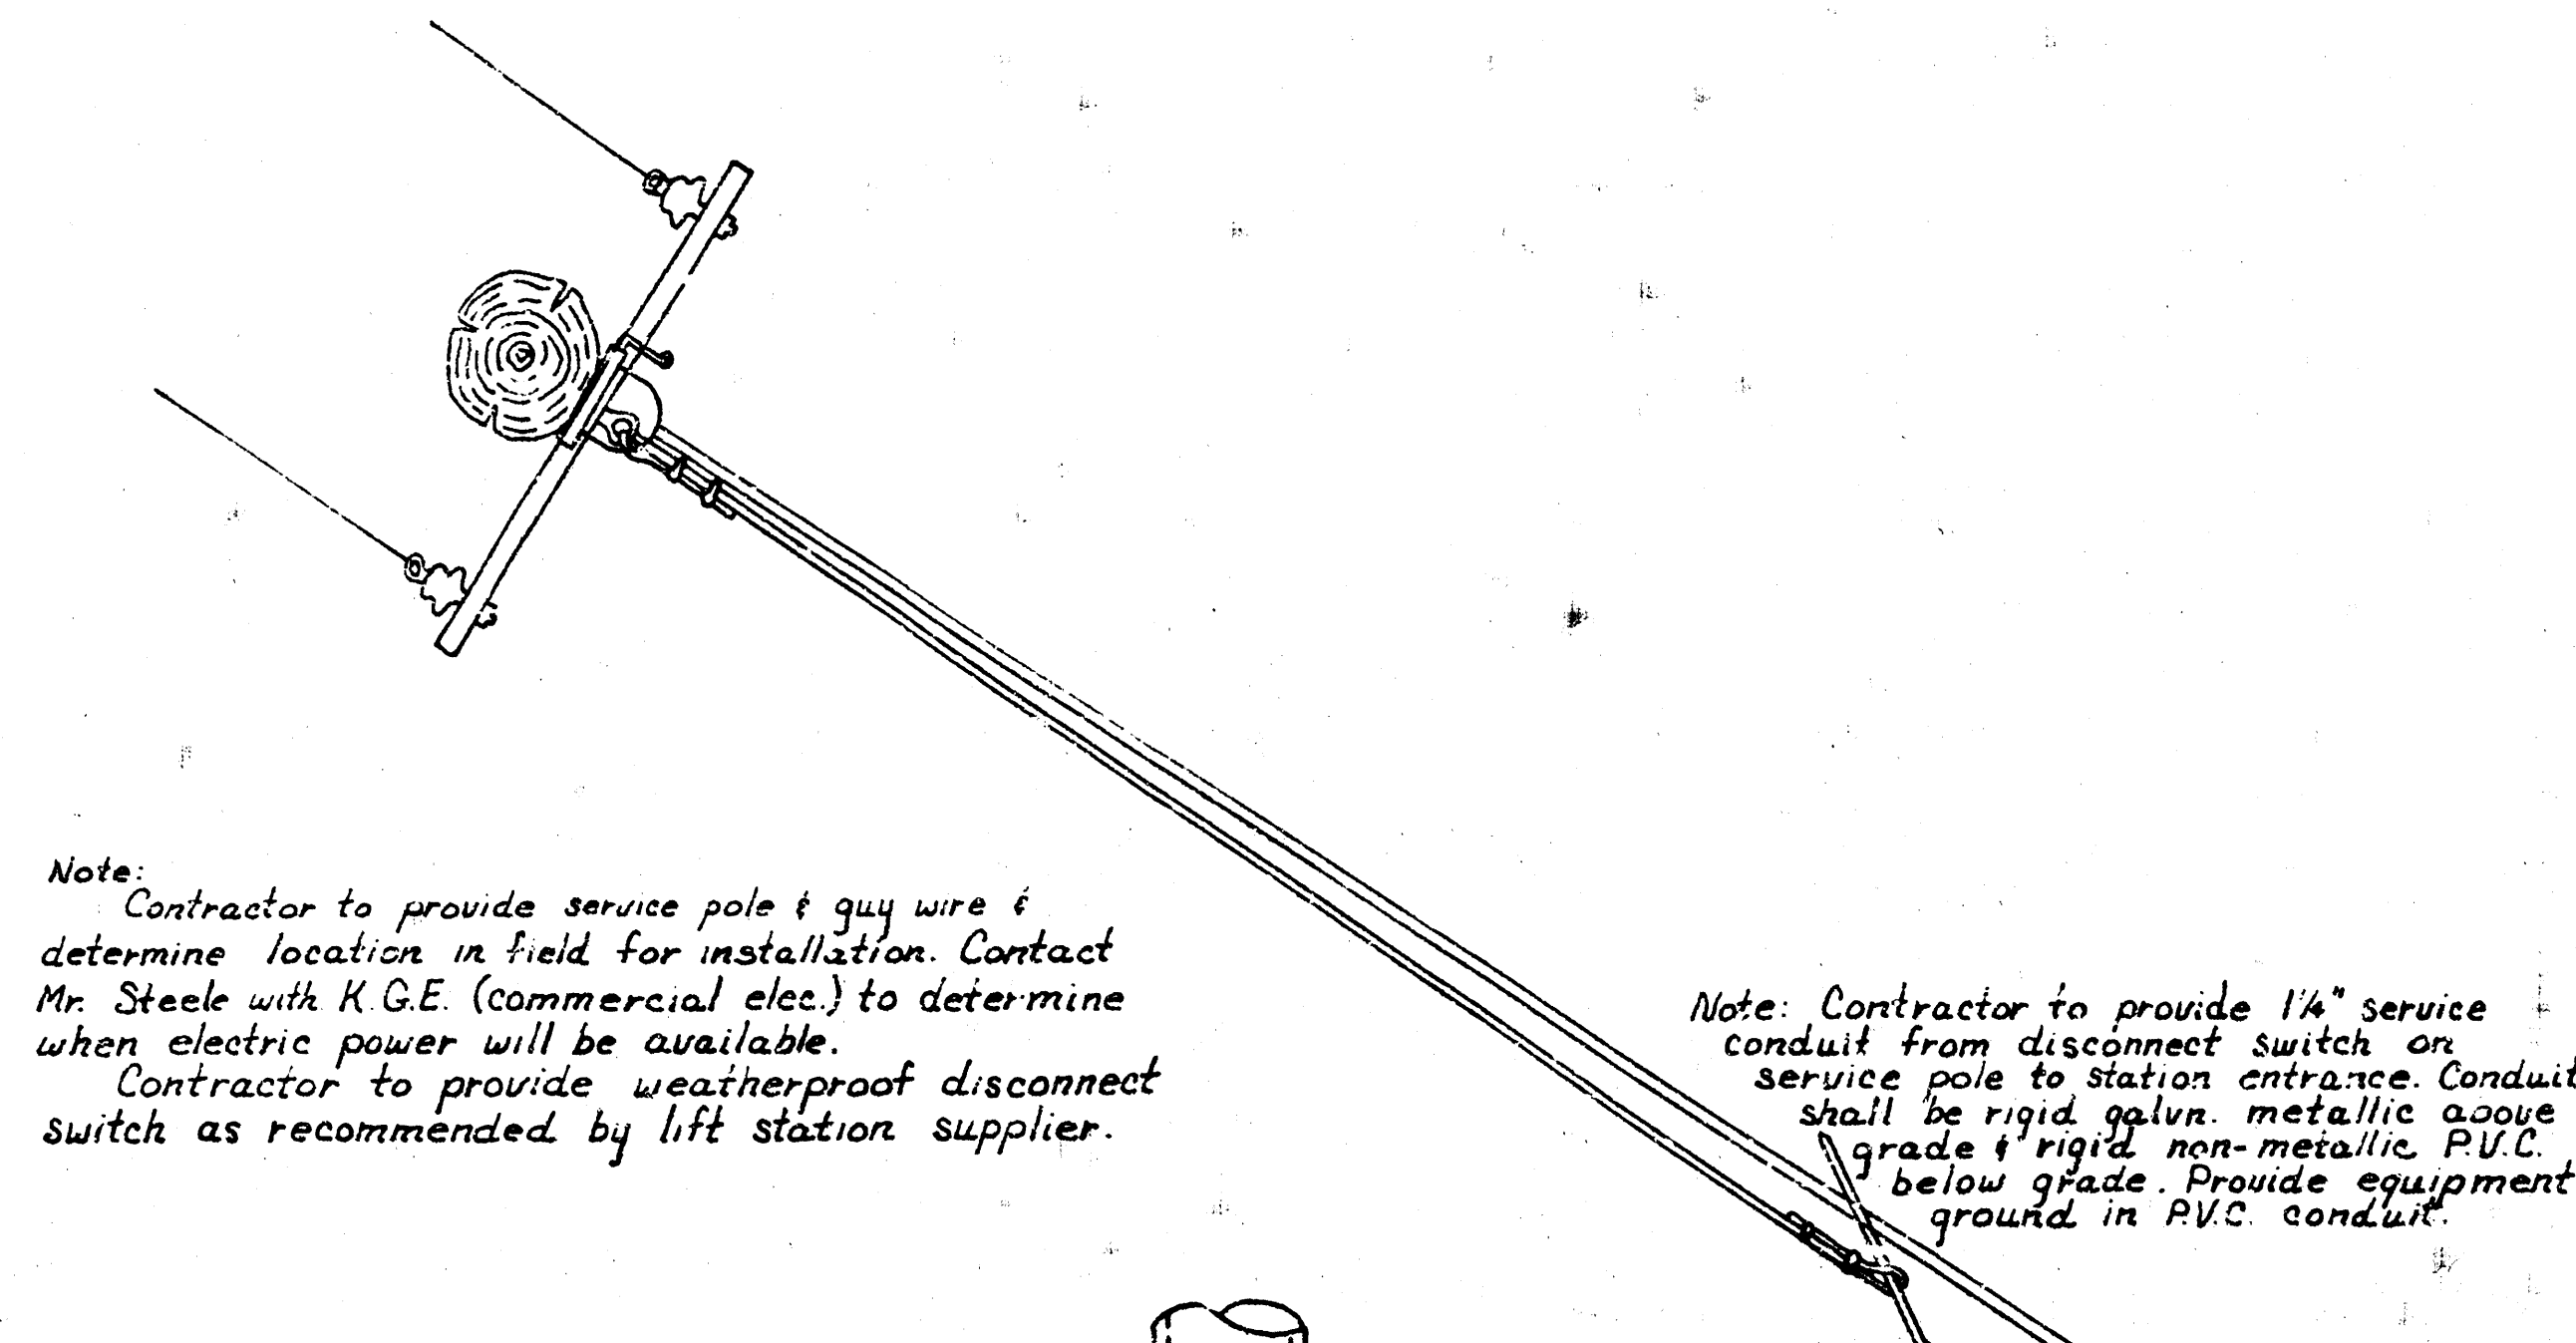

Typical Trench Section

Note: Contractor shall sand backfill force main trench. Cost of furnishing sand, placing, vibrating & flushing same shall be included in Lump Sum bid of Lift Sta.

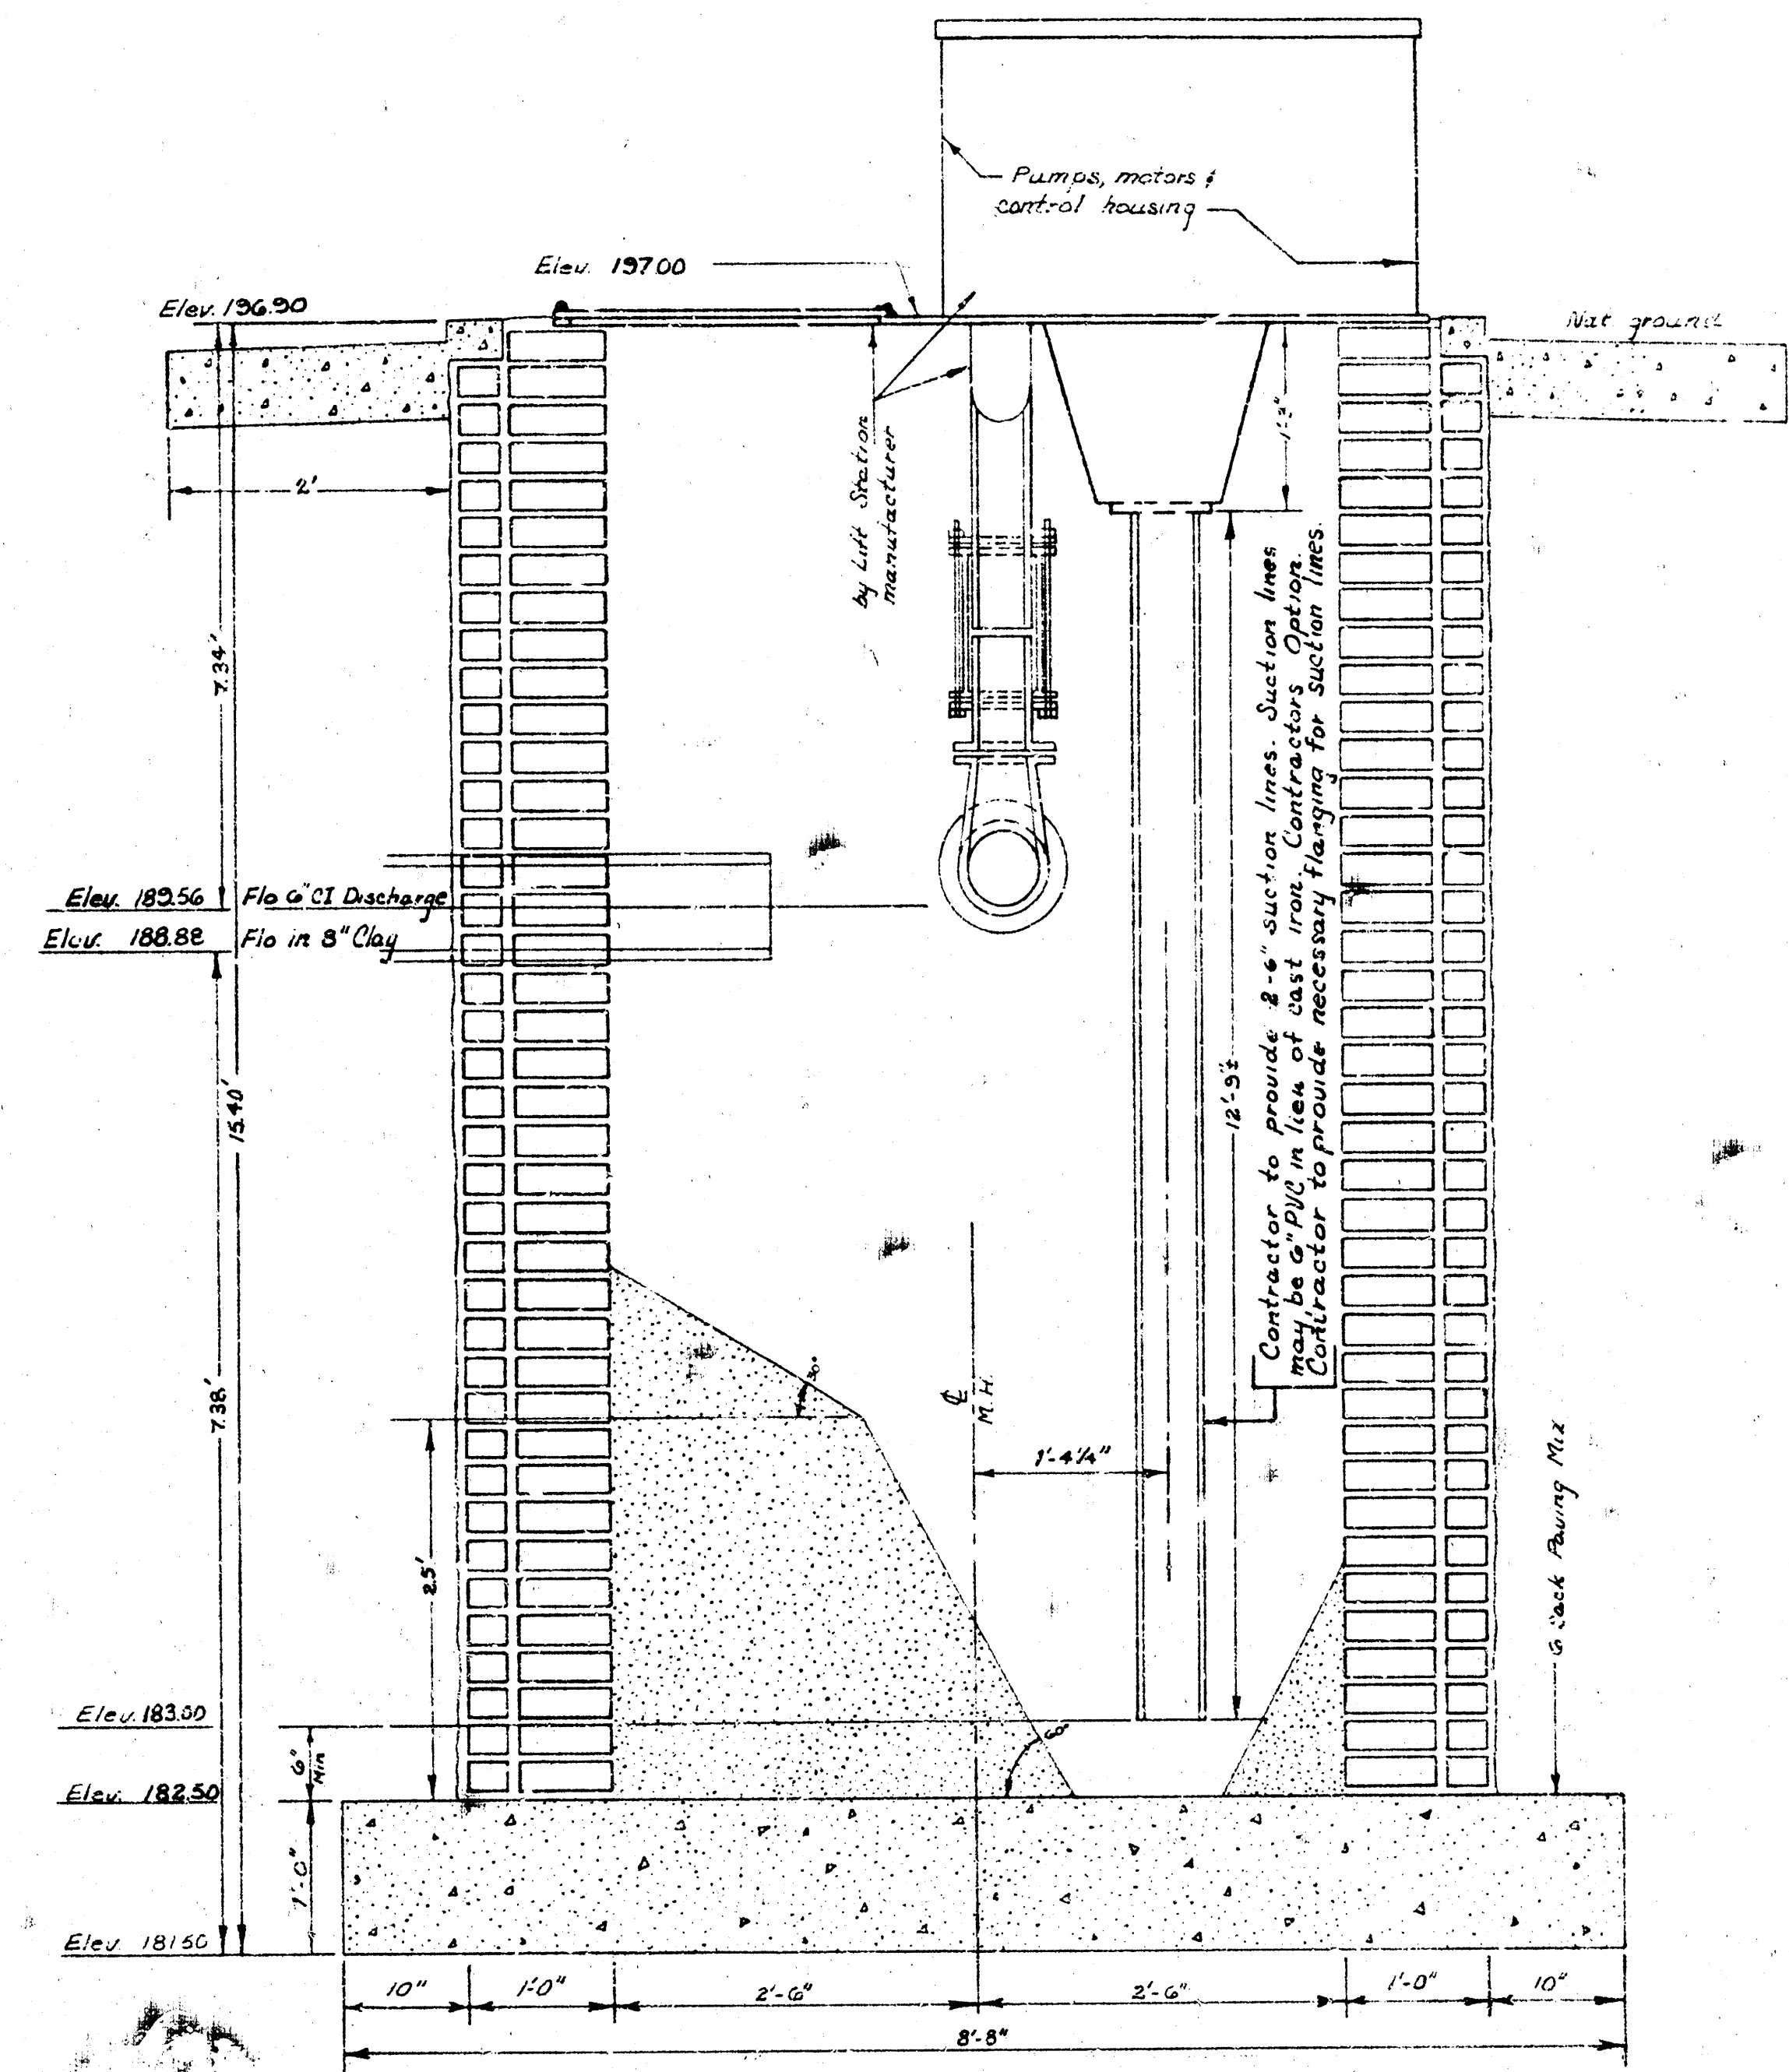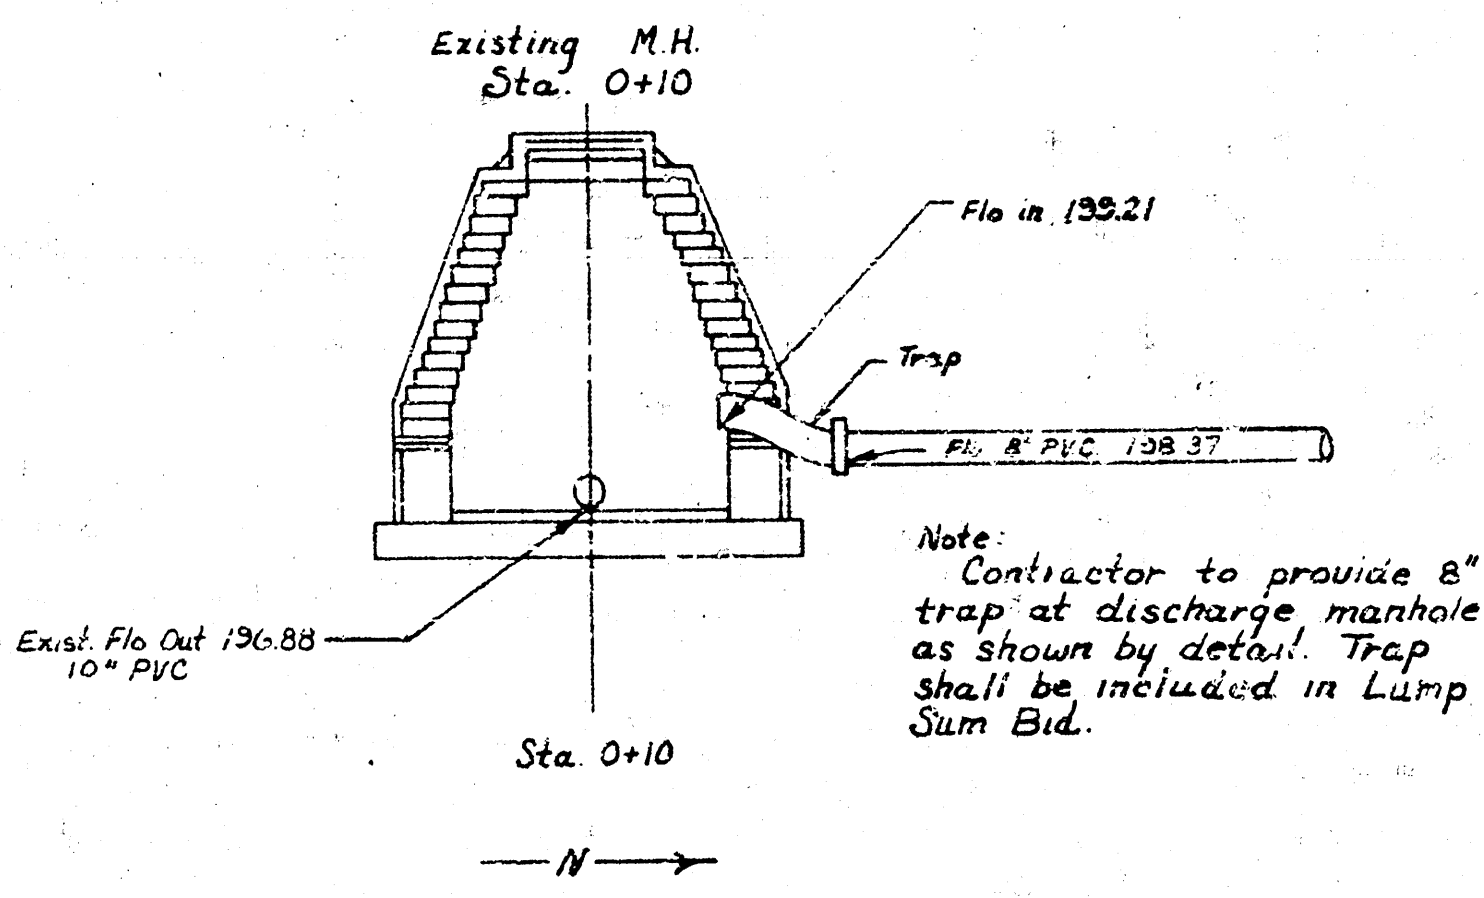


Type "B" 5' Diameter Wet Well

4/5

LIFT STA.#1, MAIN#7, S.S.#23

PROJ. NO. DBKP 573060

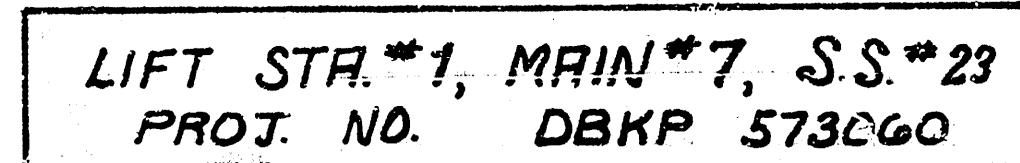

PATENTED IN THE U.S.A. & FOREIGN COUNTRIES		N71-1B	
