LATERAL 20, MAIN 7, S.S. NO. 23

PROJECT NO.
468-76-245-80837-000-000-001

CITY OF WICHITA, KANSAS
DEAN SELLERS, ACTING CITY ENGINEER

NOTE: CONTRACTOR SHALL GIVE KANEB PETROLEUM PIPELINE COMPANY ADVANCE NOTICE PRIOR TO STARTING ANY WORK IN OR ADJACENT TO THEIR PIPELINE EASEMENT.

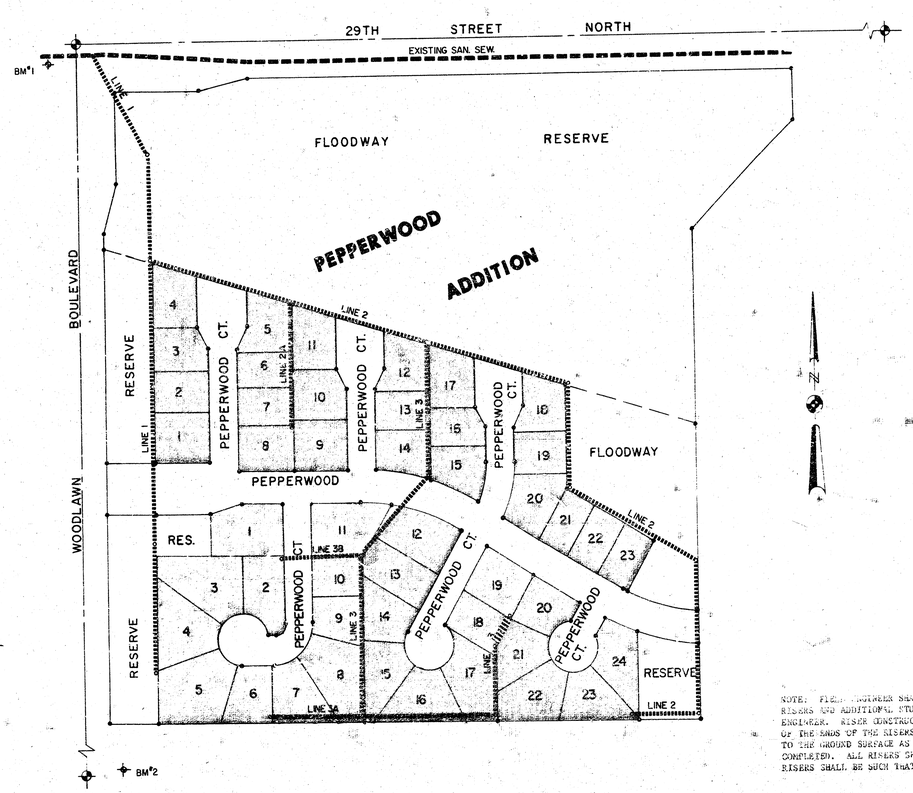

INDEX TO DRAWINGS

SHEET NO.	DESCRIPTION
1	TITLE SHEET
2	LINE 1, LINE 2
3	LINE 2, LINE 2A, LINE 3
4	LINE 3A, LINE 3B

NOTE: FIELD ENGINEER SHALL SET TOPS OF MANHOLES TO MATCH PROPOSED FINISHED GRADE AS DETERMINED BY THE DEVELOPER. RISERS FOR ADDITIONAL STUBS SHALL BE INSTALLED ON THIS PROJECT TO SERVE INDIVIDUAL LOTS WHEN ORDERED BY THE FIELD ENGINEER. RISER CONSTRUCTION SHALL CONFORM TO THE REQUIREMENTS AS SHOWN ON STANDARD RISER DETAIL SHEET. LOCATIONS OF THE ENDS OF THE RISERS SHALL BE MARKED BY FASTENING GREEN PLASTIC COLORED TAPE TO THE END OF THE RISER AND BE KEPT TO THE GROUND SURFACE AS THE EXCAVATION IS BACKFILLED SUCH THAT THE COLORED TAPE WILL BE VISIBLE WHEN THE PROJECT IS COMPLETED. ALL RISERS SHALL BE CONSTRUCTED USING S.D.R. 23.5 A.S.T. OR P.V.C. PIPE. ELEVATIONS OF STUBS AND TOPS OF RISERS SHALL BE SUCH THAT WILL FACILITATE CONNECTION OF BASEMENT DRAINS WHEN THESE LOTS ARE DEVELOPED.

Kenneth N Bray

Van Doren - Hazard - Stallings
Architects • Engineers • Planners
Topeka Wichita Minneapolis

Sheet 1 of 4

GENERAL NOTE: Contractor May Use Either VCP, ABS Or PVC Pipe.

29TH STREET NORTH

FLOODWAY RESERVE

PEPPERWOOD COURT

PEPPERWOOD

RESERVE

Sta. 0+00 - Line 1 Exist. MH.

Sta. 1+96.8 Line 1 Const. Std. Type "C" MH

Sta. 3+92.4 Line 1 via 0+00 - Line 2 Const. Outside Drop MH Type "C"

Sta. 6+91.3 Line 1 Const. Std. Type "C" MH

Sta. 9+73.4 Line 1 Const. Std. Type "C" MH

Sta. 11+22.1 Line 1 Const. Std. Type "C" MH W/4 Stub S.E. & N.E.

Scale: 1" = 50' Horz. 1" = 5' Vert.

WOODLAWN BOULEVARD

232 L.F. 8" Pipe @ 0.38%

191 L.F. 8" Pipe @ 0.38%

259 L.F. 8" Pipe @ 10%

265 L.F. 8" Pipe @ 0.8%

274 L.F. 8" Pipe @ 0.8%

IDENTICAL ELEVATION

ex. ground

FLOODWAY RESERVE

Sta. 0+00 - Line 2 = Sta. 3+91.4 - Line 1 Const. Outside Drop MH Type "B" Or "C"

Sta. 2+94.1 Line 2 = Sta. 0+00 - Line 2A Const. Drop MH Type "C"

Sta. 5+90.3 Line 2 = Sta. 0+00 - Line 3 Const. Std. Type "C" MH

Sta. 8+87.0 Line 2 Const. Std. Type "C" MH

294 L.F. 8" Pipe @ 0.4%

296 L.F. 8" Pipe @ 0.4%

296 L.F. 8" Pipe @ 0.4%

B.M. #1: "O" in E and N. headwall RCB 49' W, 17' N. of Woodlawn & 89 M. Elev = 175.85

B.M. #2: Spk. Stp. NE fa temporary pp 80' S. of S. line Pepperwood, 60' E. & Woodlawn Elev. = 186.53

As Built

4-81

2 2/4

GENERAL NOTE : Contractor May Use Either VCP, ABS, Or PVC Pipe.

PEPPERWOOD COURT

FLOODWAY RESERVE

PEPPERWOOD VILLAGE SECOND ADDITION

Scale : 1" = 50' Horz. 1" = 5' Vert.

Kaneb Petroleum Pipeline

33' Pipeline Esmt.

30' Util Esmt.

20' Util Esmt.

10' Util Esmt.

FLOODWAY


















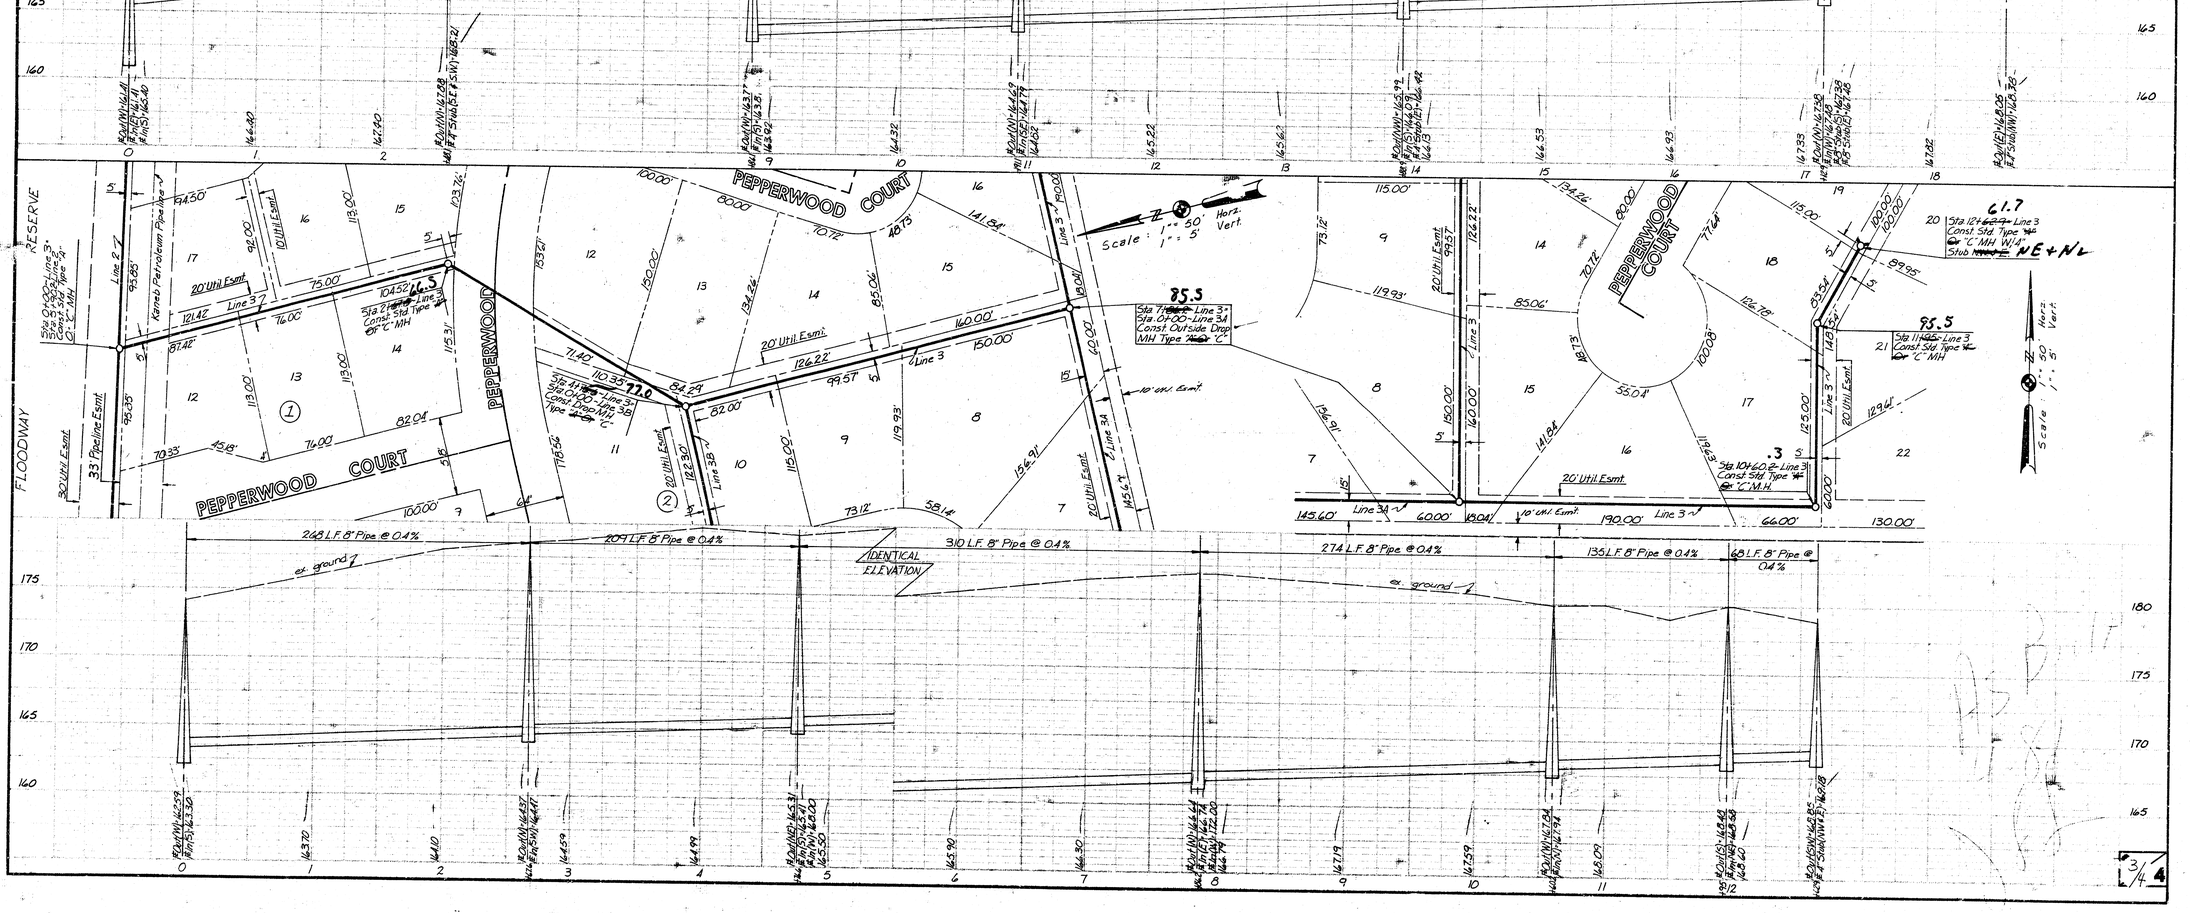

3/4 4

16 7 4 16

4

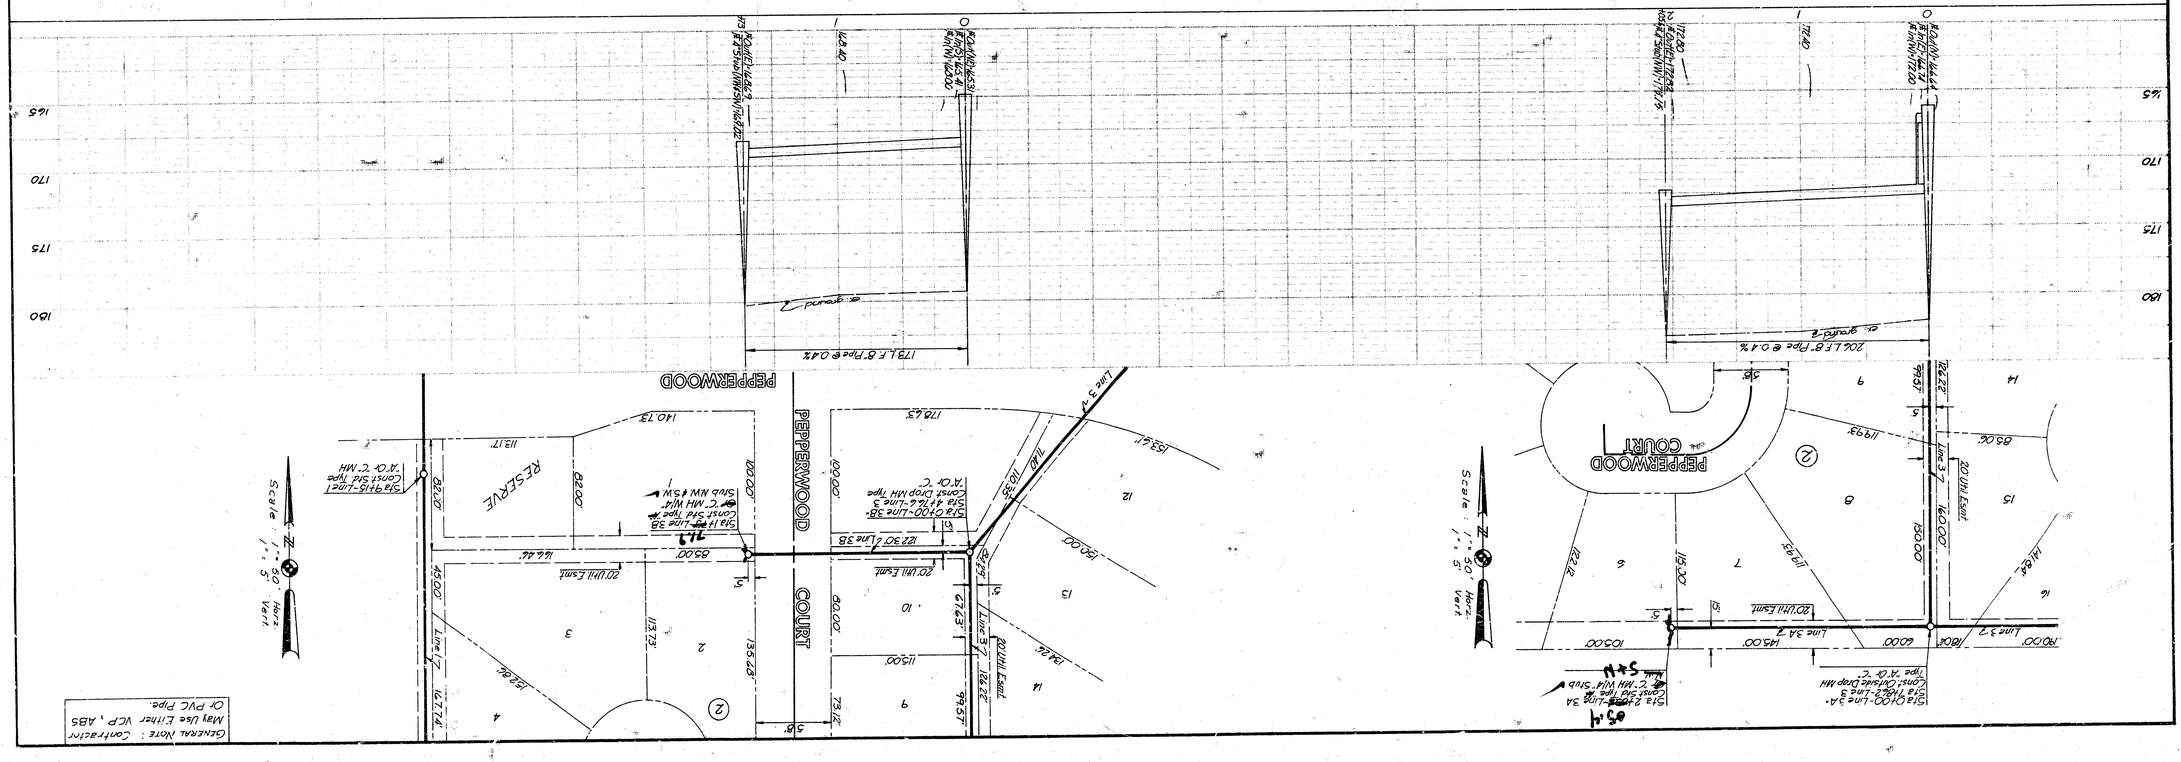
PEPPERWOOD
COURT
PEPPERWOOD COURT
RESERVE
Line 3 A
Line 3 B
