


LATERAL 8, MAIN 9, SS 23

TO SERVE LOTS 1 AND 2, NORTHBROOK 2ND ADDITION

PROJECT NO.


468-76-245-81336-000-000-001

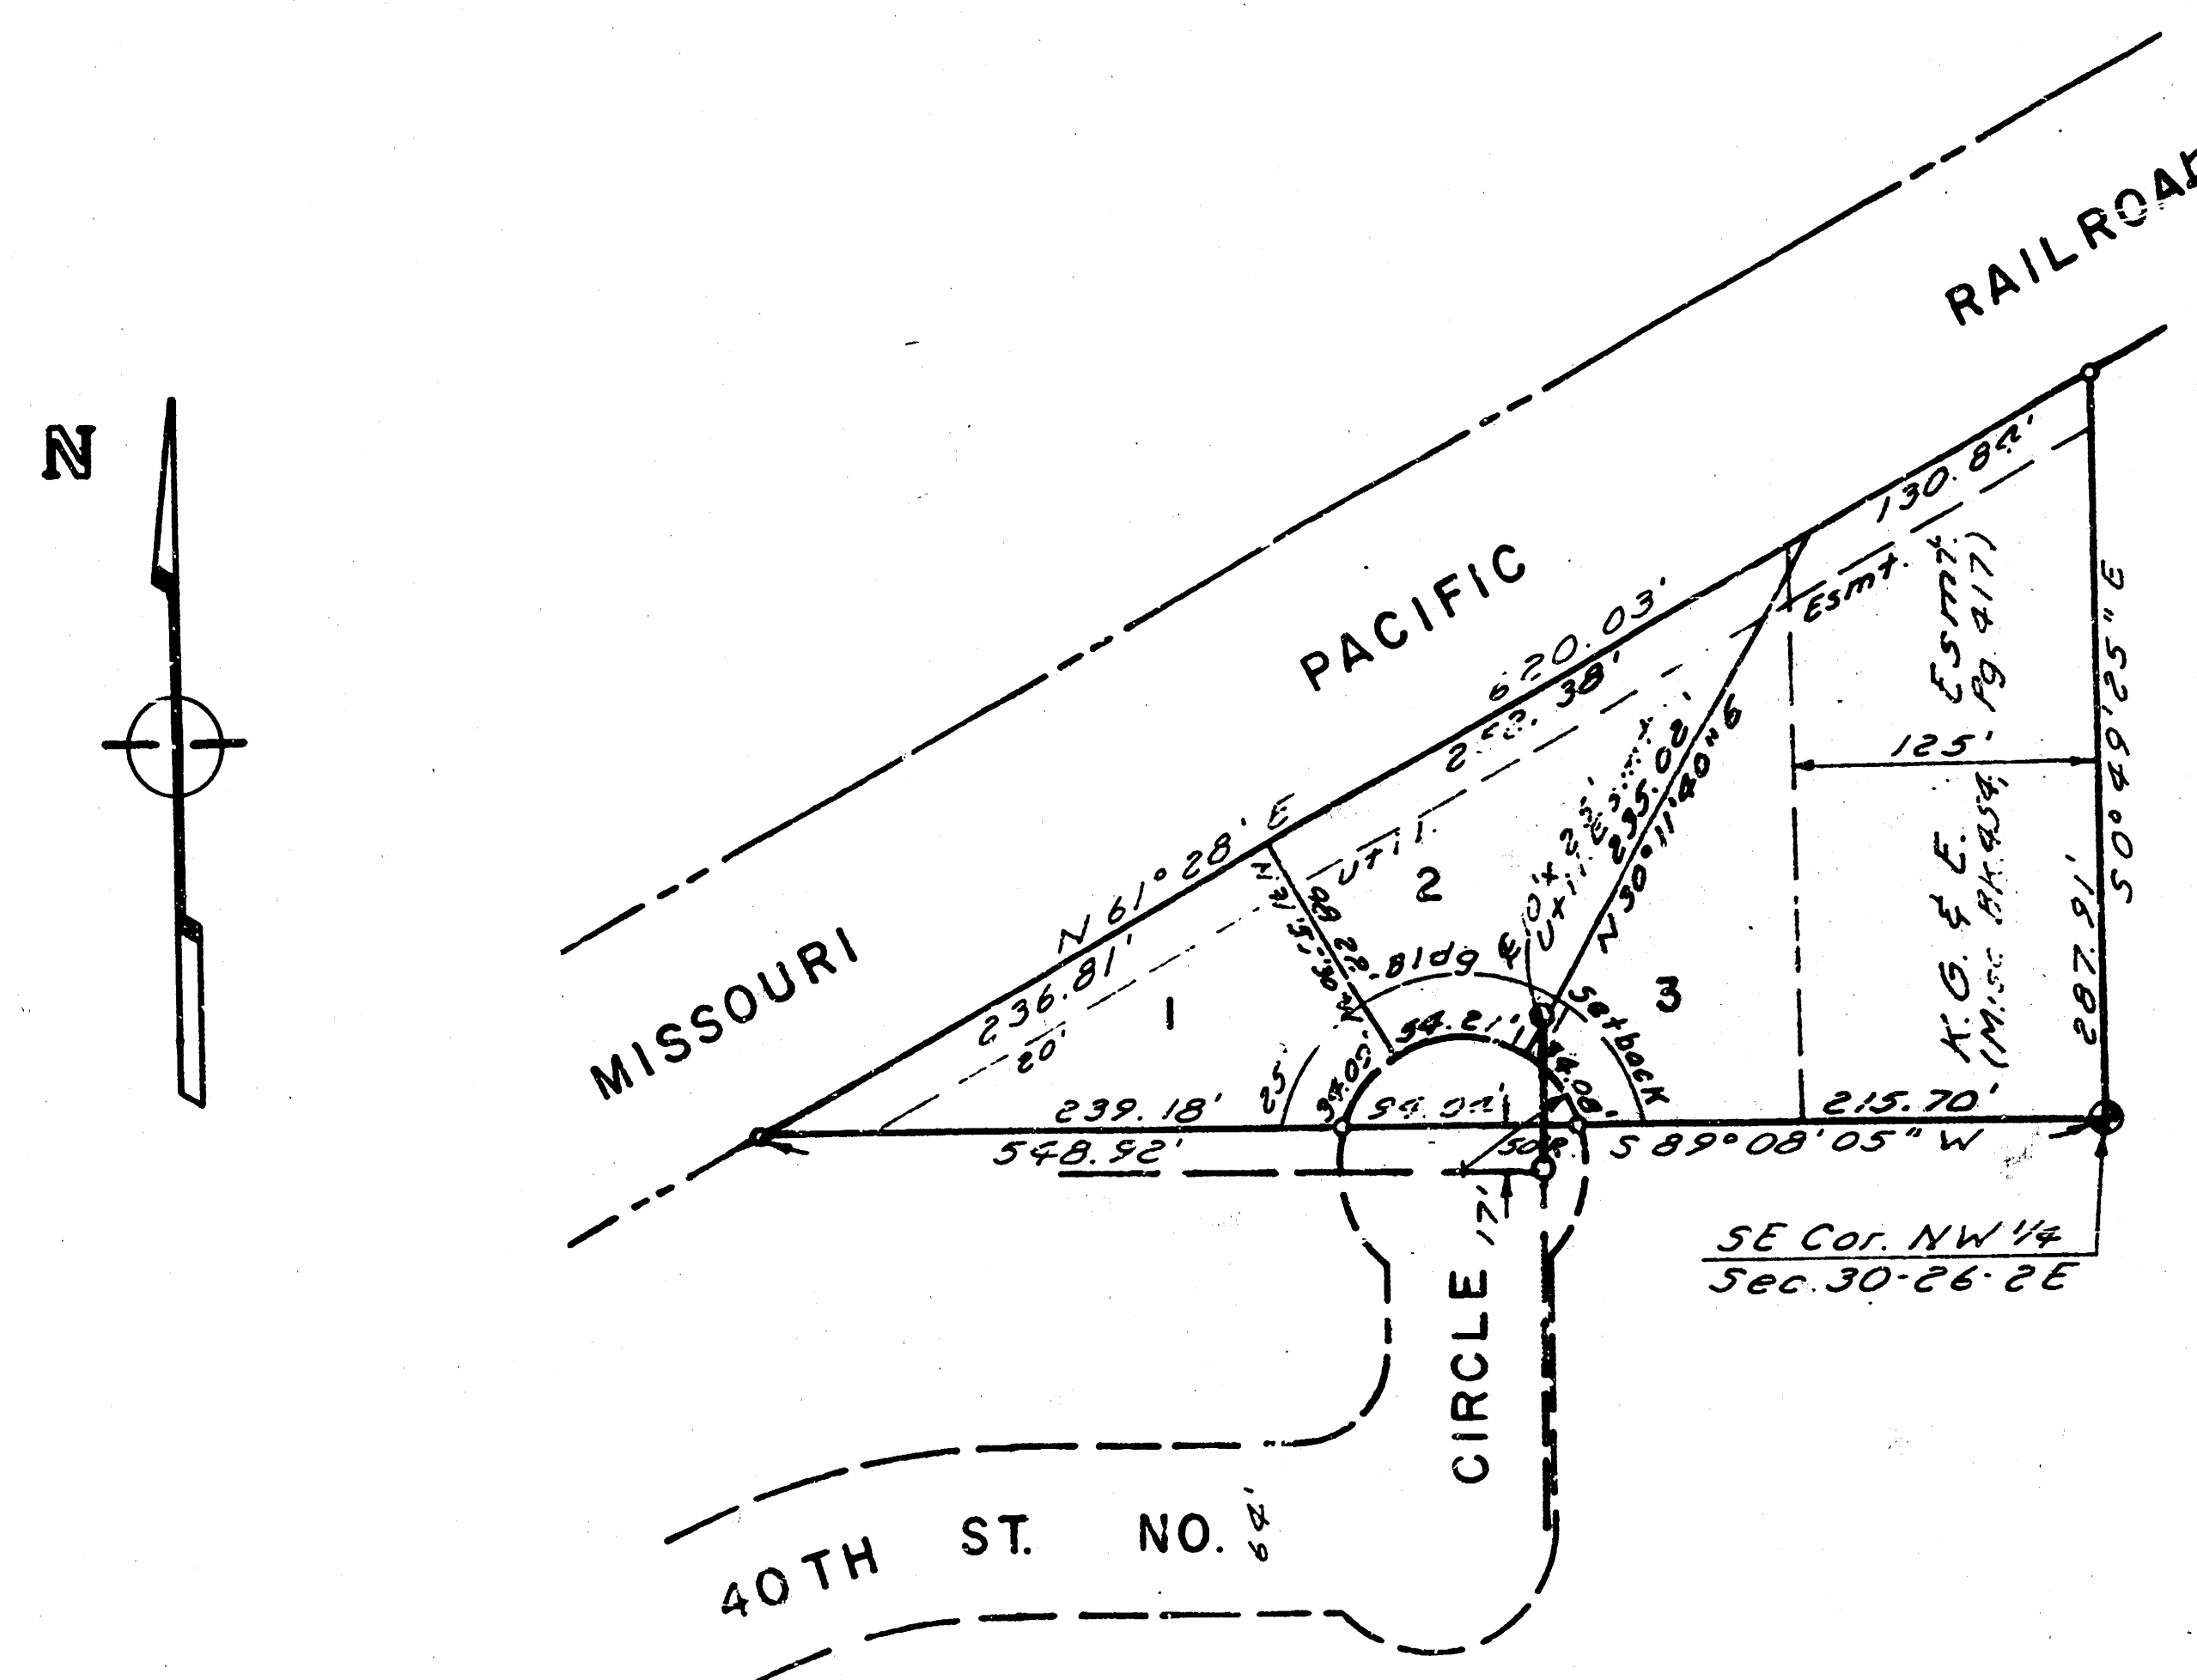

LOCATION MAP


CITY OF WICHITA, KS

MICHAEL E. LINDEBAK
CITY ENGINEER

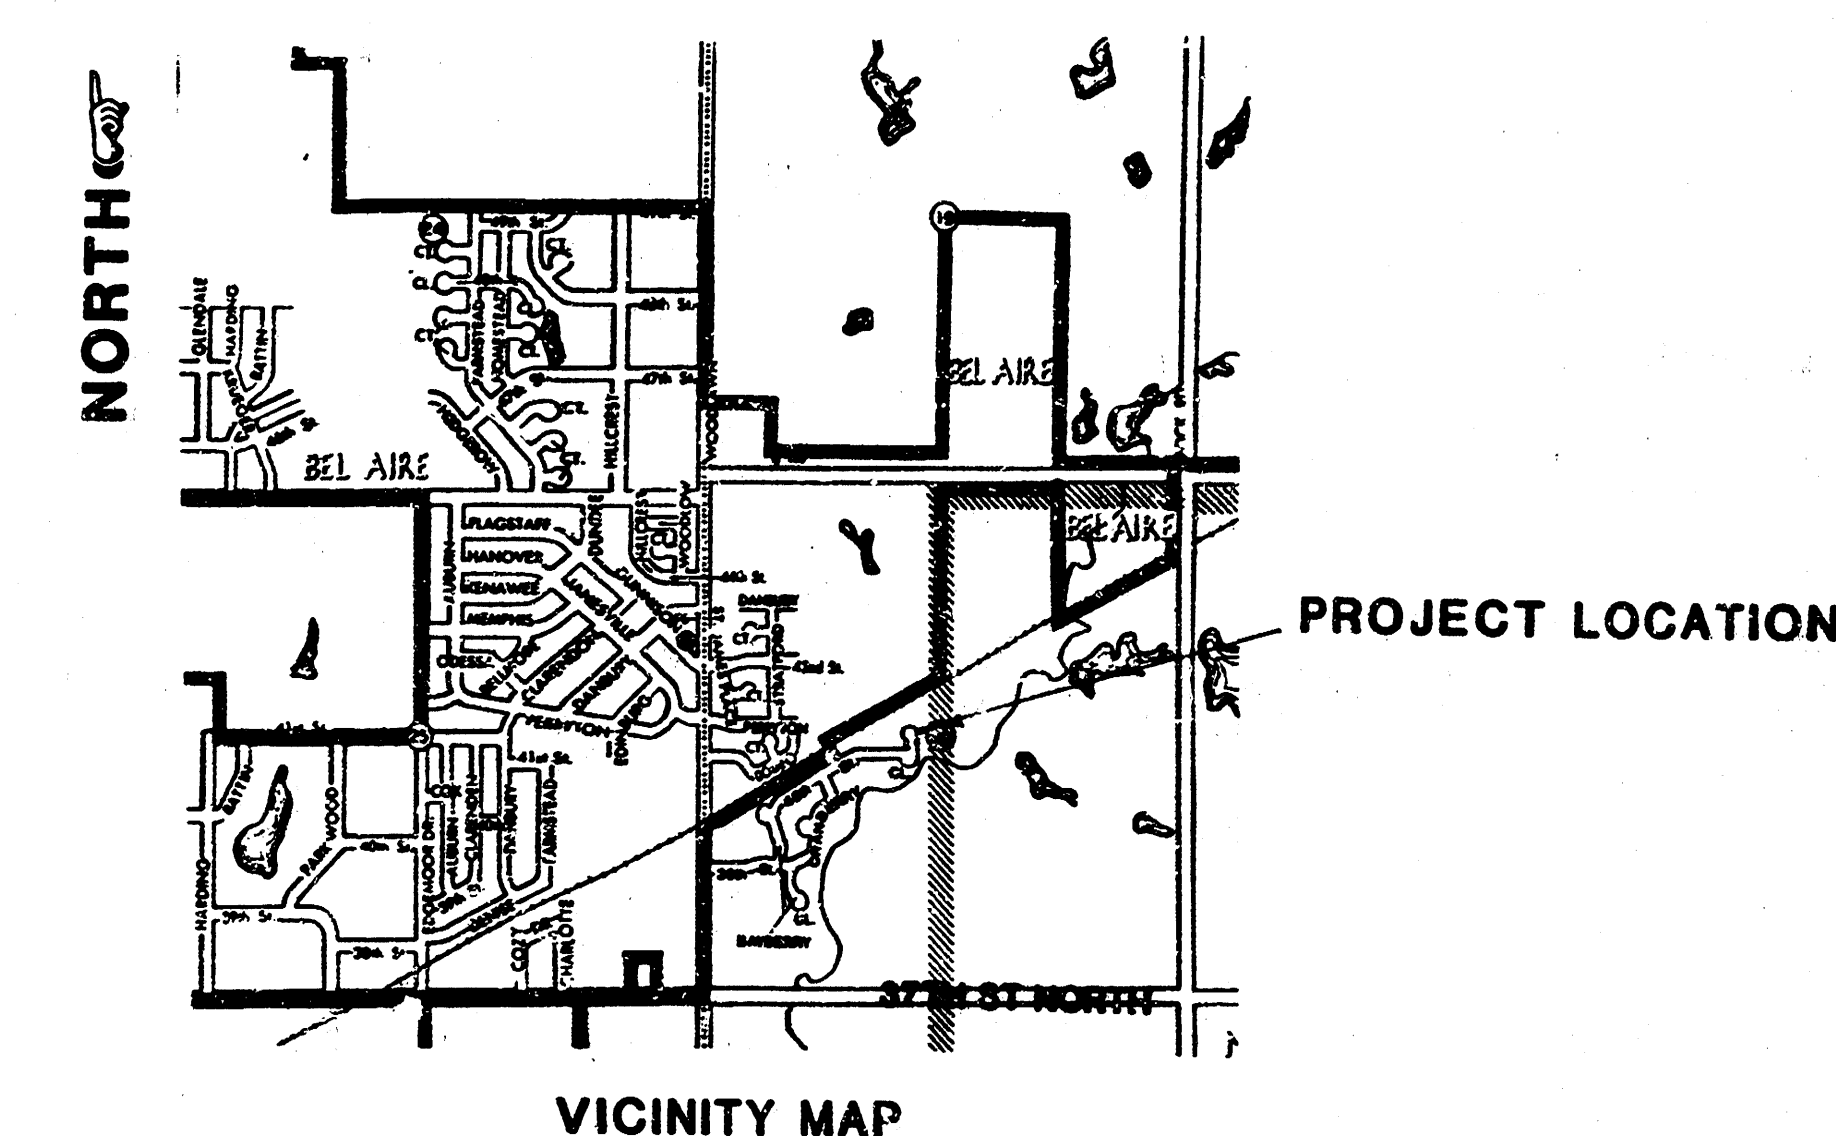

VICINITY MAP

AB BUILT
R/L
1-87

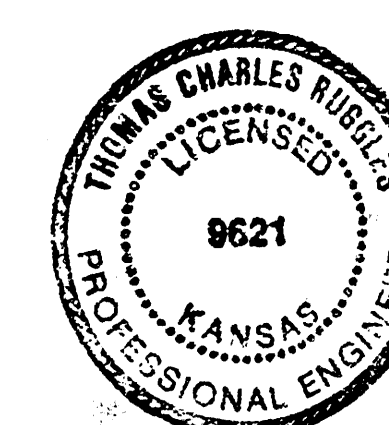

OCTOBER 1988


ED BAUGHMAN COMPANY, P.A.
SURVEYING & ENGINEERING
316/262-7271 • 330 LAURA • WICHITA, KANSAS 67211

FILMED FROM THE BEST
AVAILABLE COPY

BENCHMARK: SPIKE SET IN WEST FACE OF
K&E 'H' POLE NEAR THE EAST
LINE OF BLOCK 1, NORTHBROOK
ELEVATION 179.00



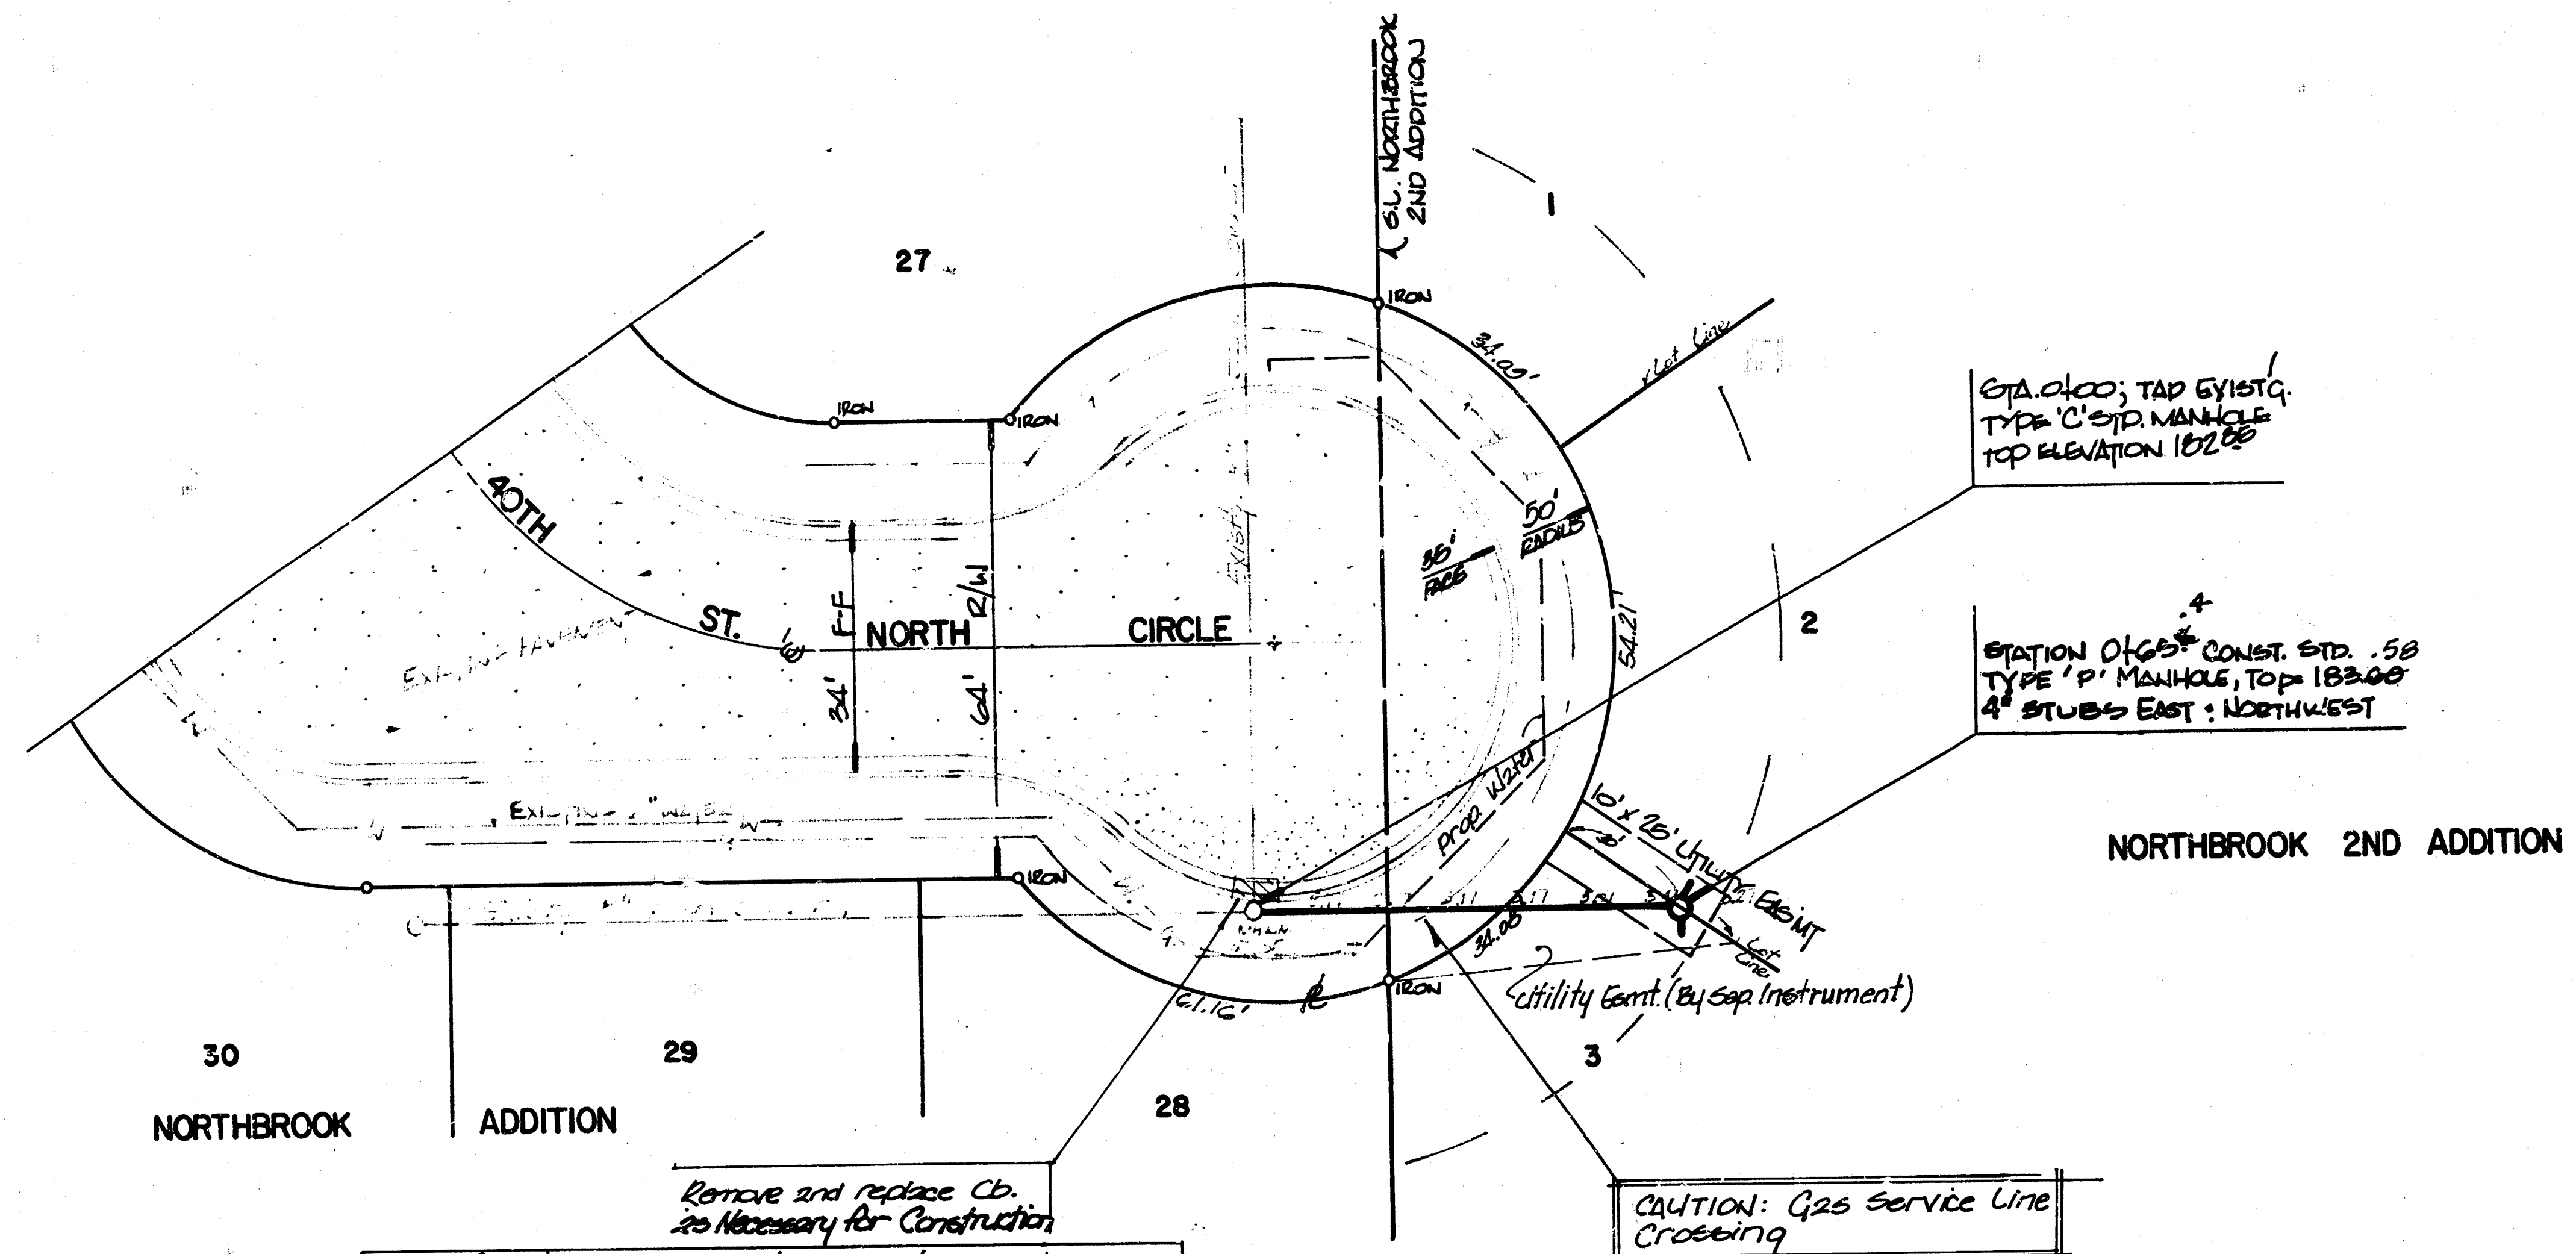

SCALE
PLAN 1"=20'
PROFILE 1"=5'


GENERAL NOTES

Contractor will be required to provide a minimum advance notice of twenty-four (24) hours to utility companies prior to starting any excavation as follows:

Utility Company	Emergency Contact
Kansas One-Call	1-800-344-7233
Cable vision	262-4270 or 263-2061
K.P. & L. Gas Service Company	263-7811
Kansas Gas & Electric	264-1141
Arkia Gas Company	942-8350 or 263-8161

The Contractor shall be responsible for preserving property irons. The Contractor will be required to re-establish any property irons which are damaged or destroyed by his construction operations. Such irons shall be re-established by a licensed land surveyor or a licensed professional engineer in accordance with state law.

Coordinate Sanitary Sewer construction with water main extension, project number 449-76-245-8812-000-000-001.

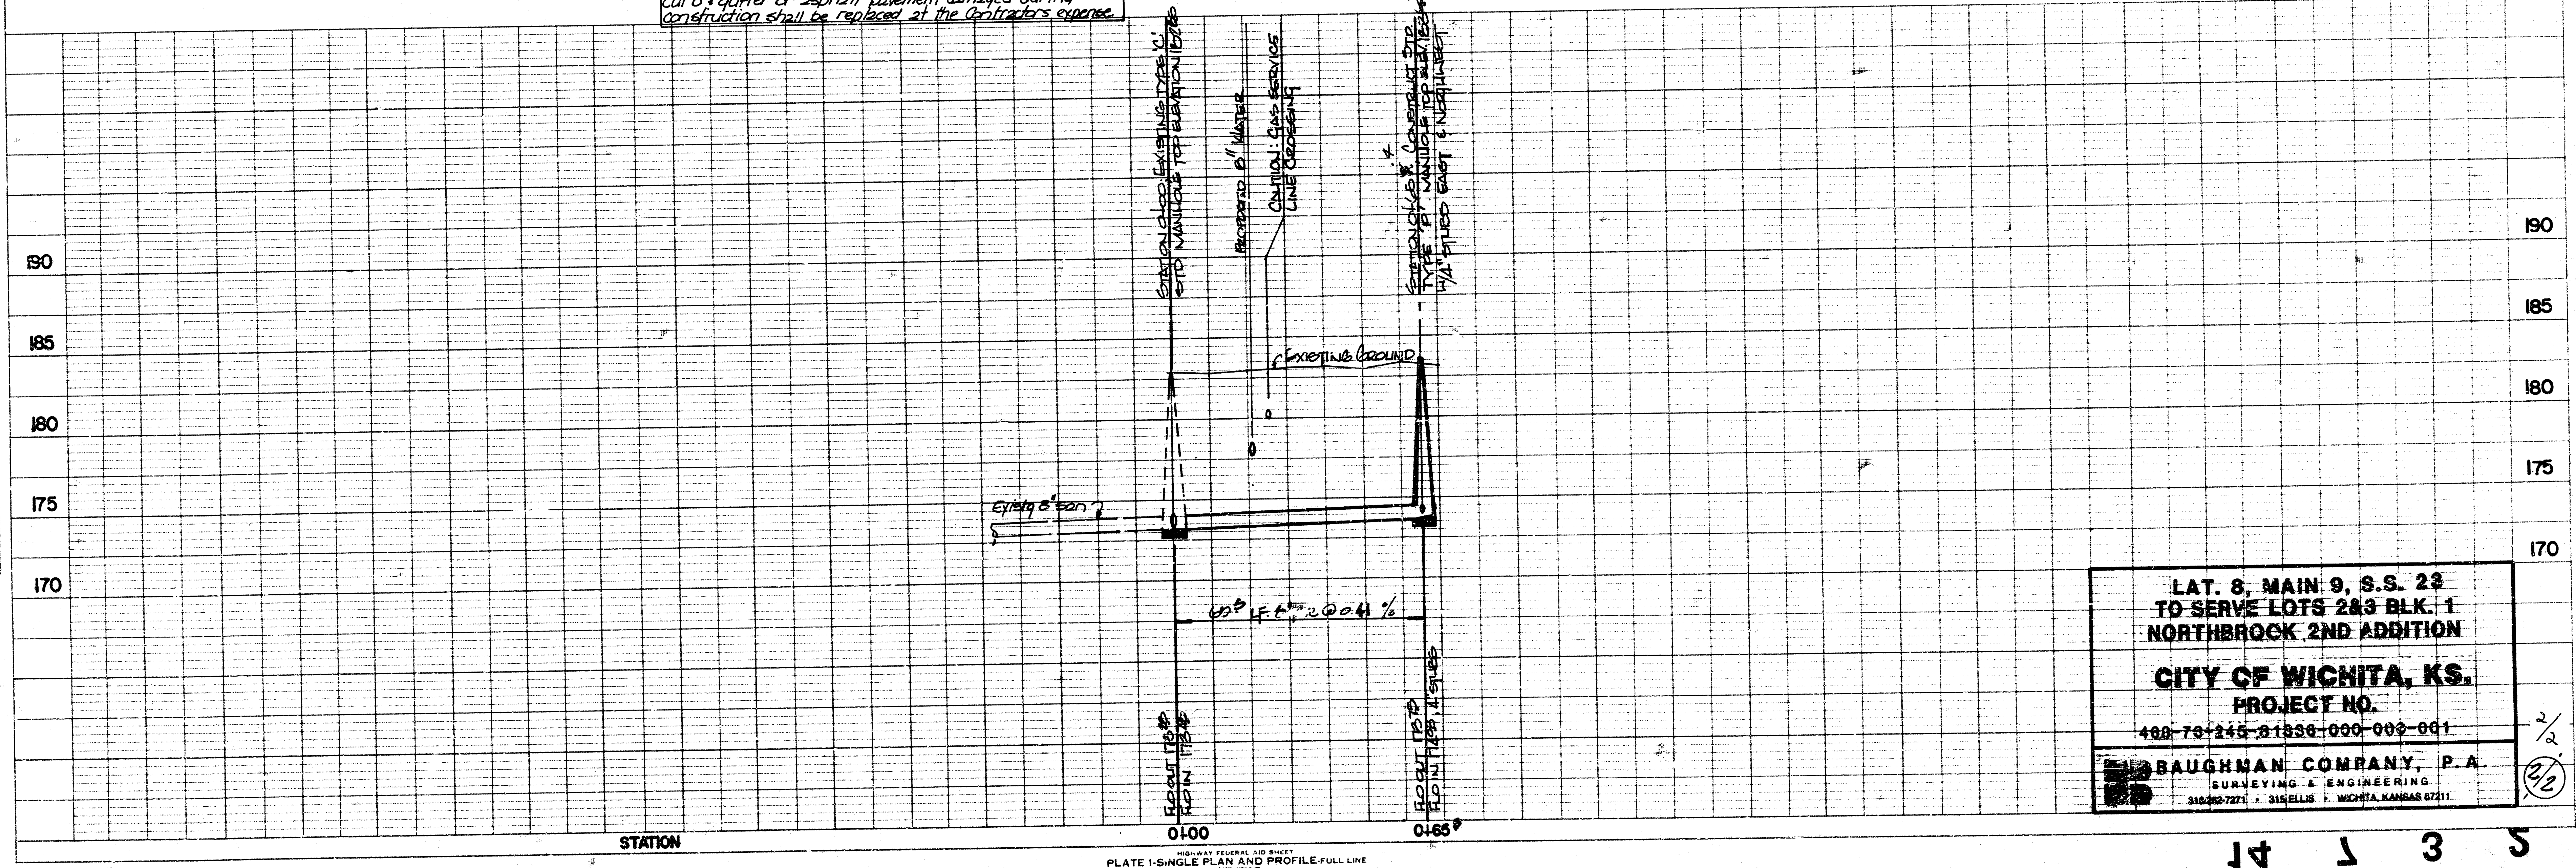

LAT. 8, MAIN 9, S.S. 23
TO SERVE LOTS 2&3 BLK. 1
NORTHBROOK 2ND ADDITION
CITY OF WICHITA, KS.
PROJECT NO.
BAUGHMAN COMPANY, P.A.
SURVEYING & ENGINEERING
310-265-7271 • 315-ELLIS • WICHITA, KANSAS 67211