
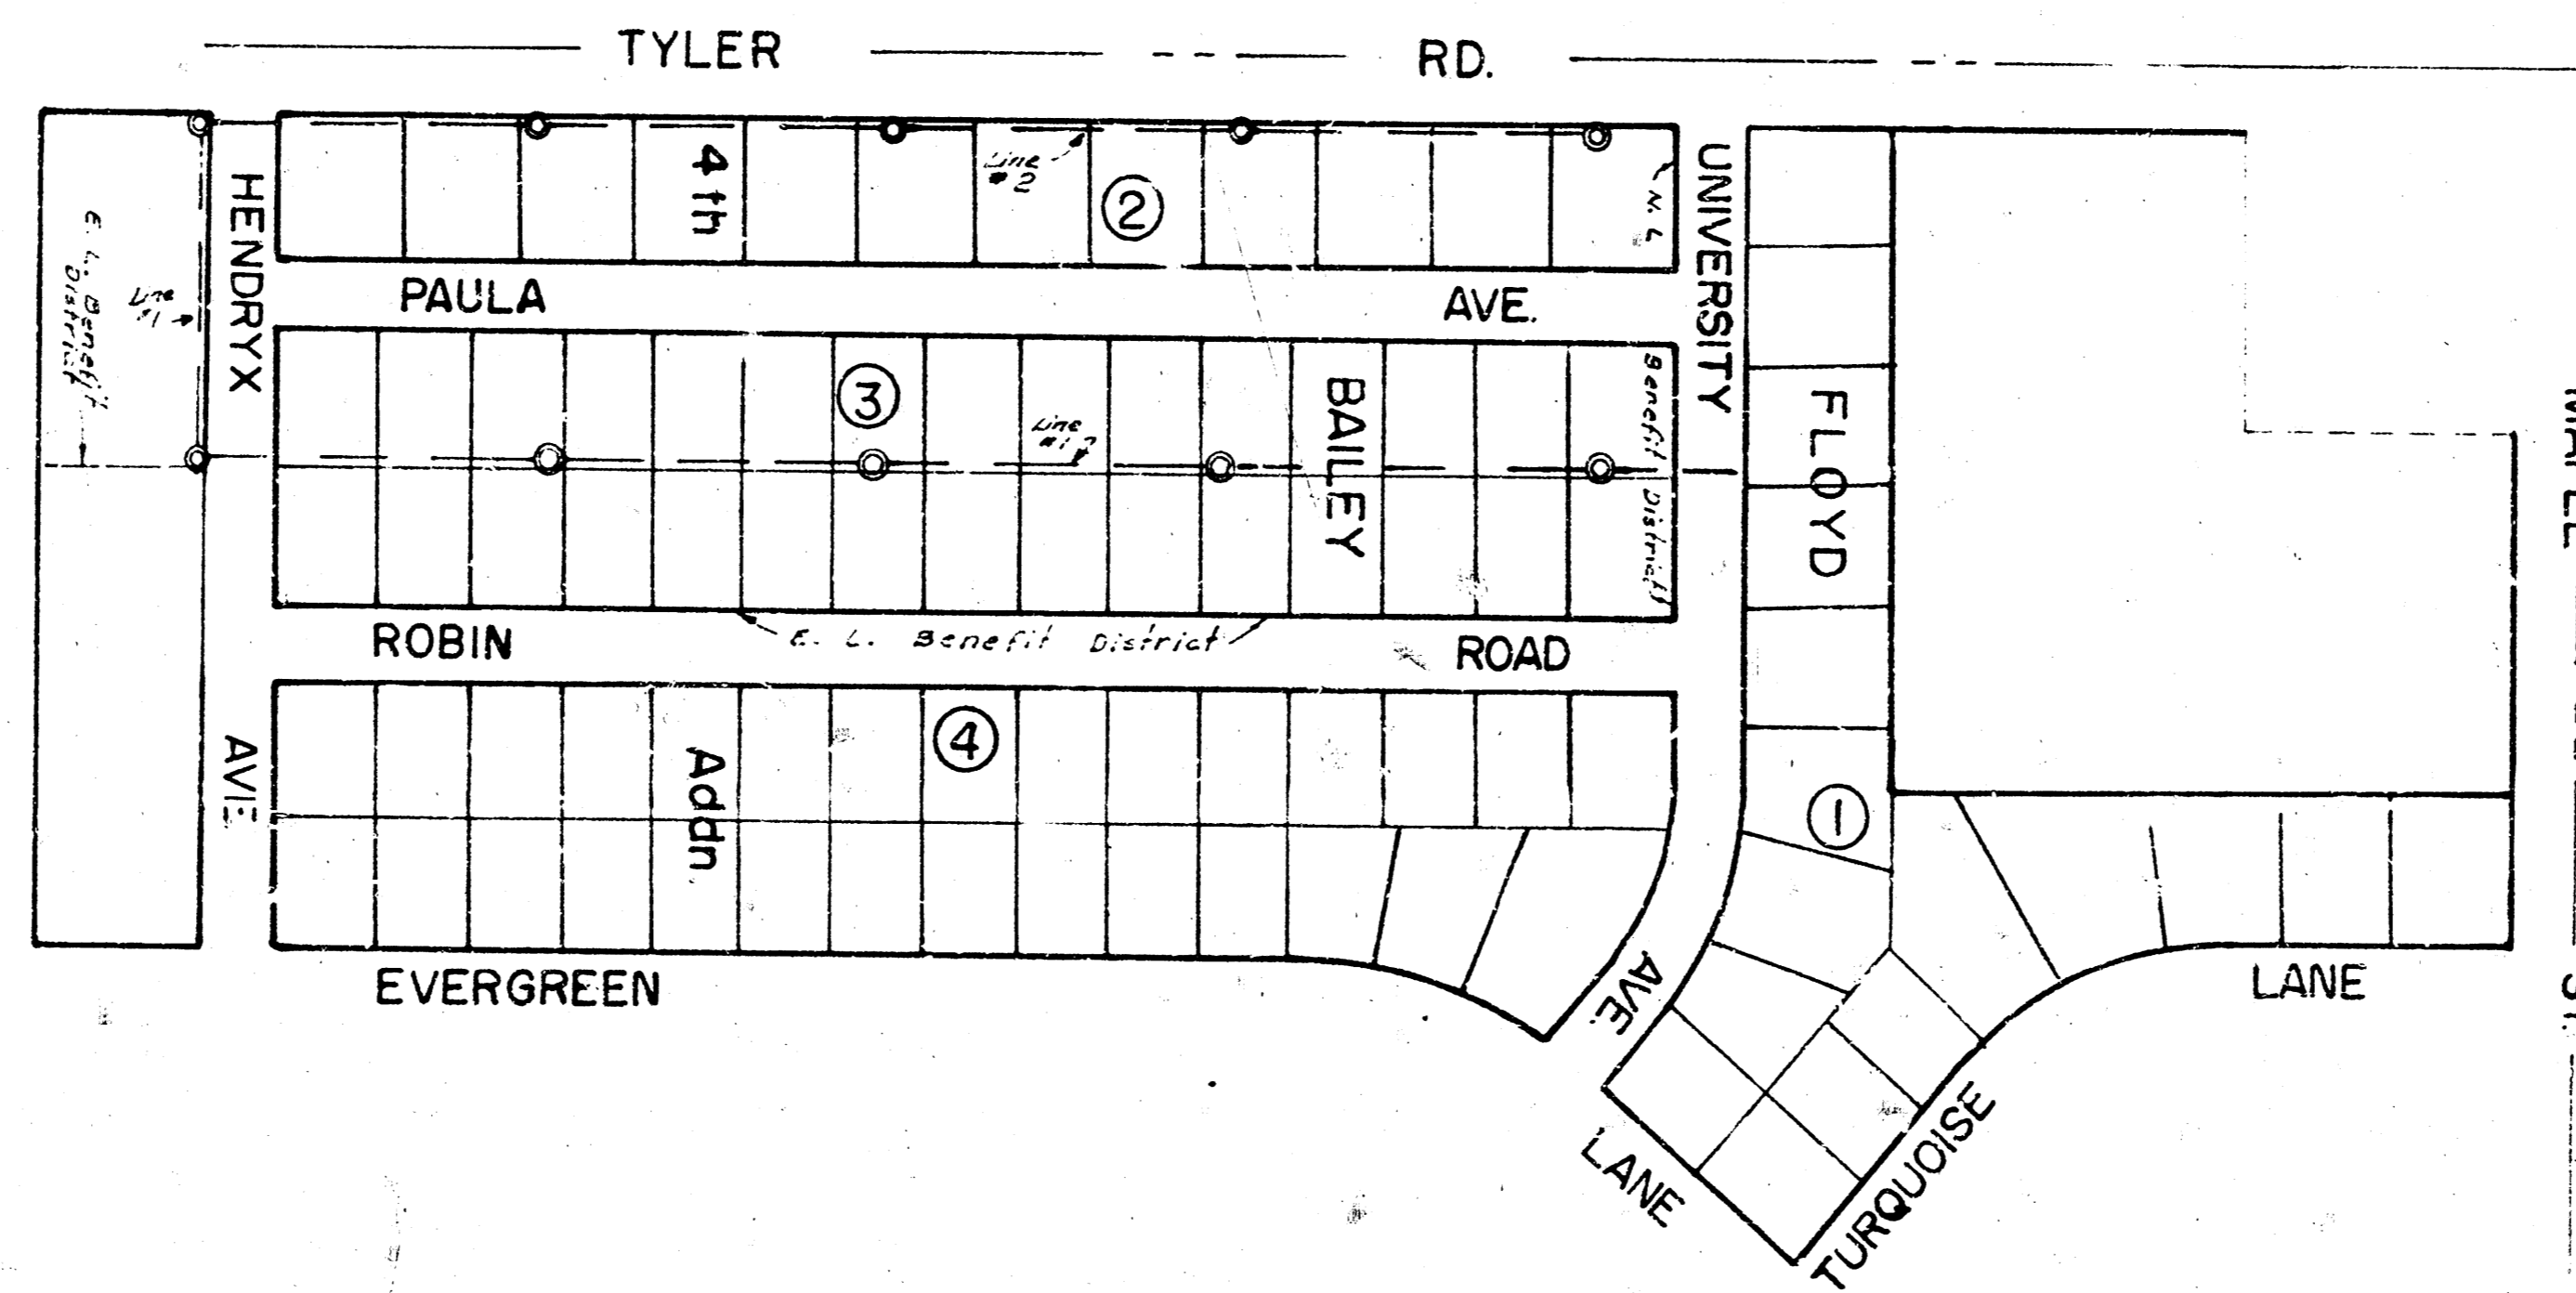


Lateral 7, Southwest Main


Project No. DBKL 568030

R. W. Linn City Engineer

City of Wichita, Kansas

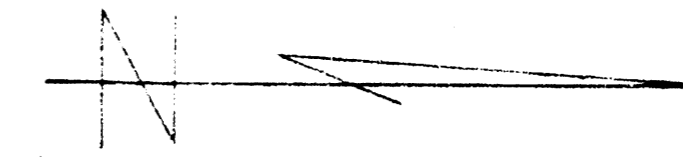


Line No.	Sheet No.
1	2 of 3
2	4

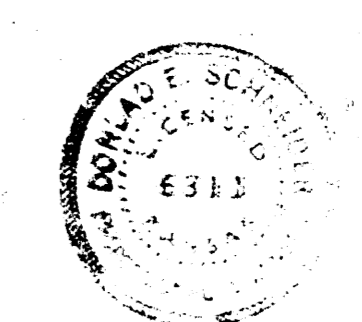

To Be Used For...  
# 105





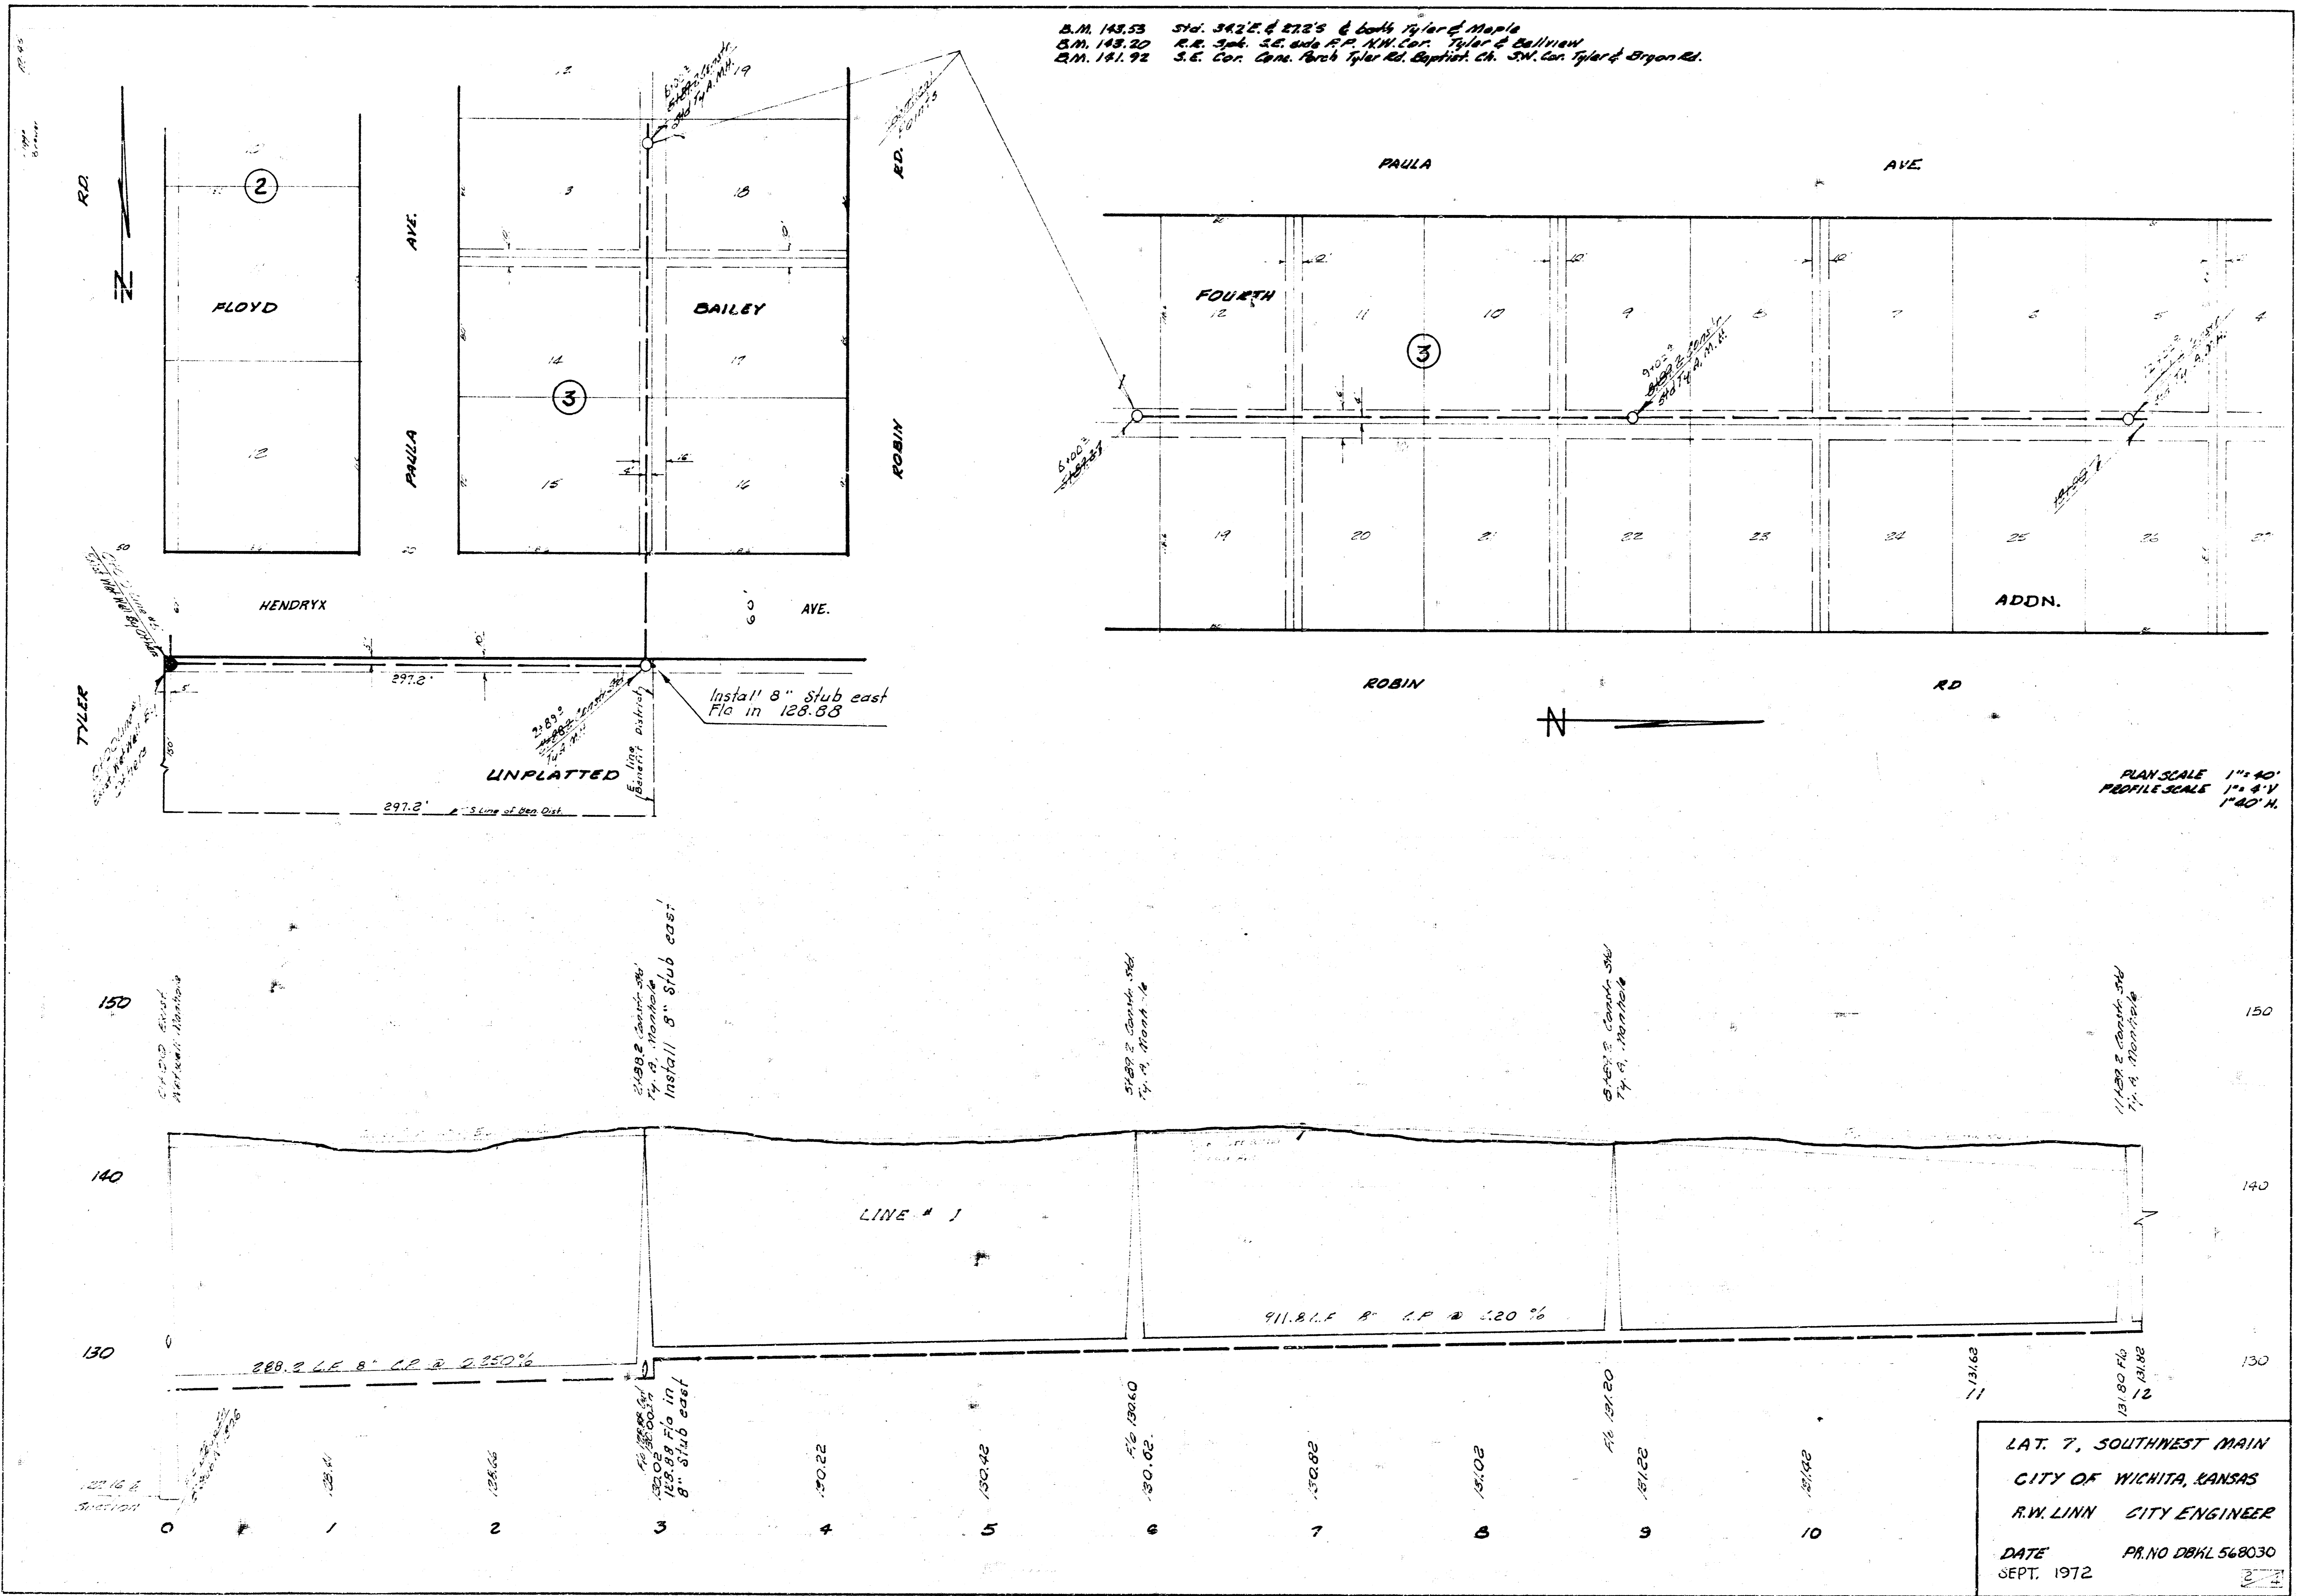


PLAN SCALE 1"=40'  
 PROFILE SCALE 1"=4' V  
 1"=40' H

LAT. 7, SOUTHWEST MAIN  
 CITY OF WICHITA, KANSAS  
 R.W. LINN CITY ENGINEER  
 DATE SEPT. 1972 PR. NO DBKL 568030

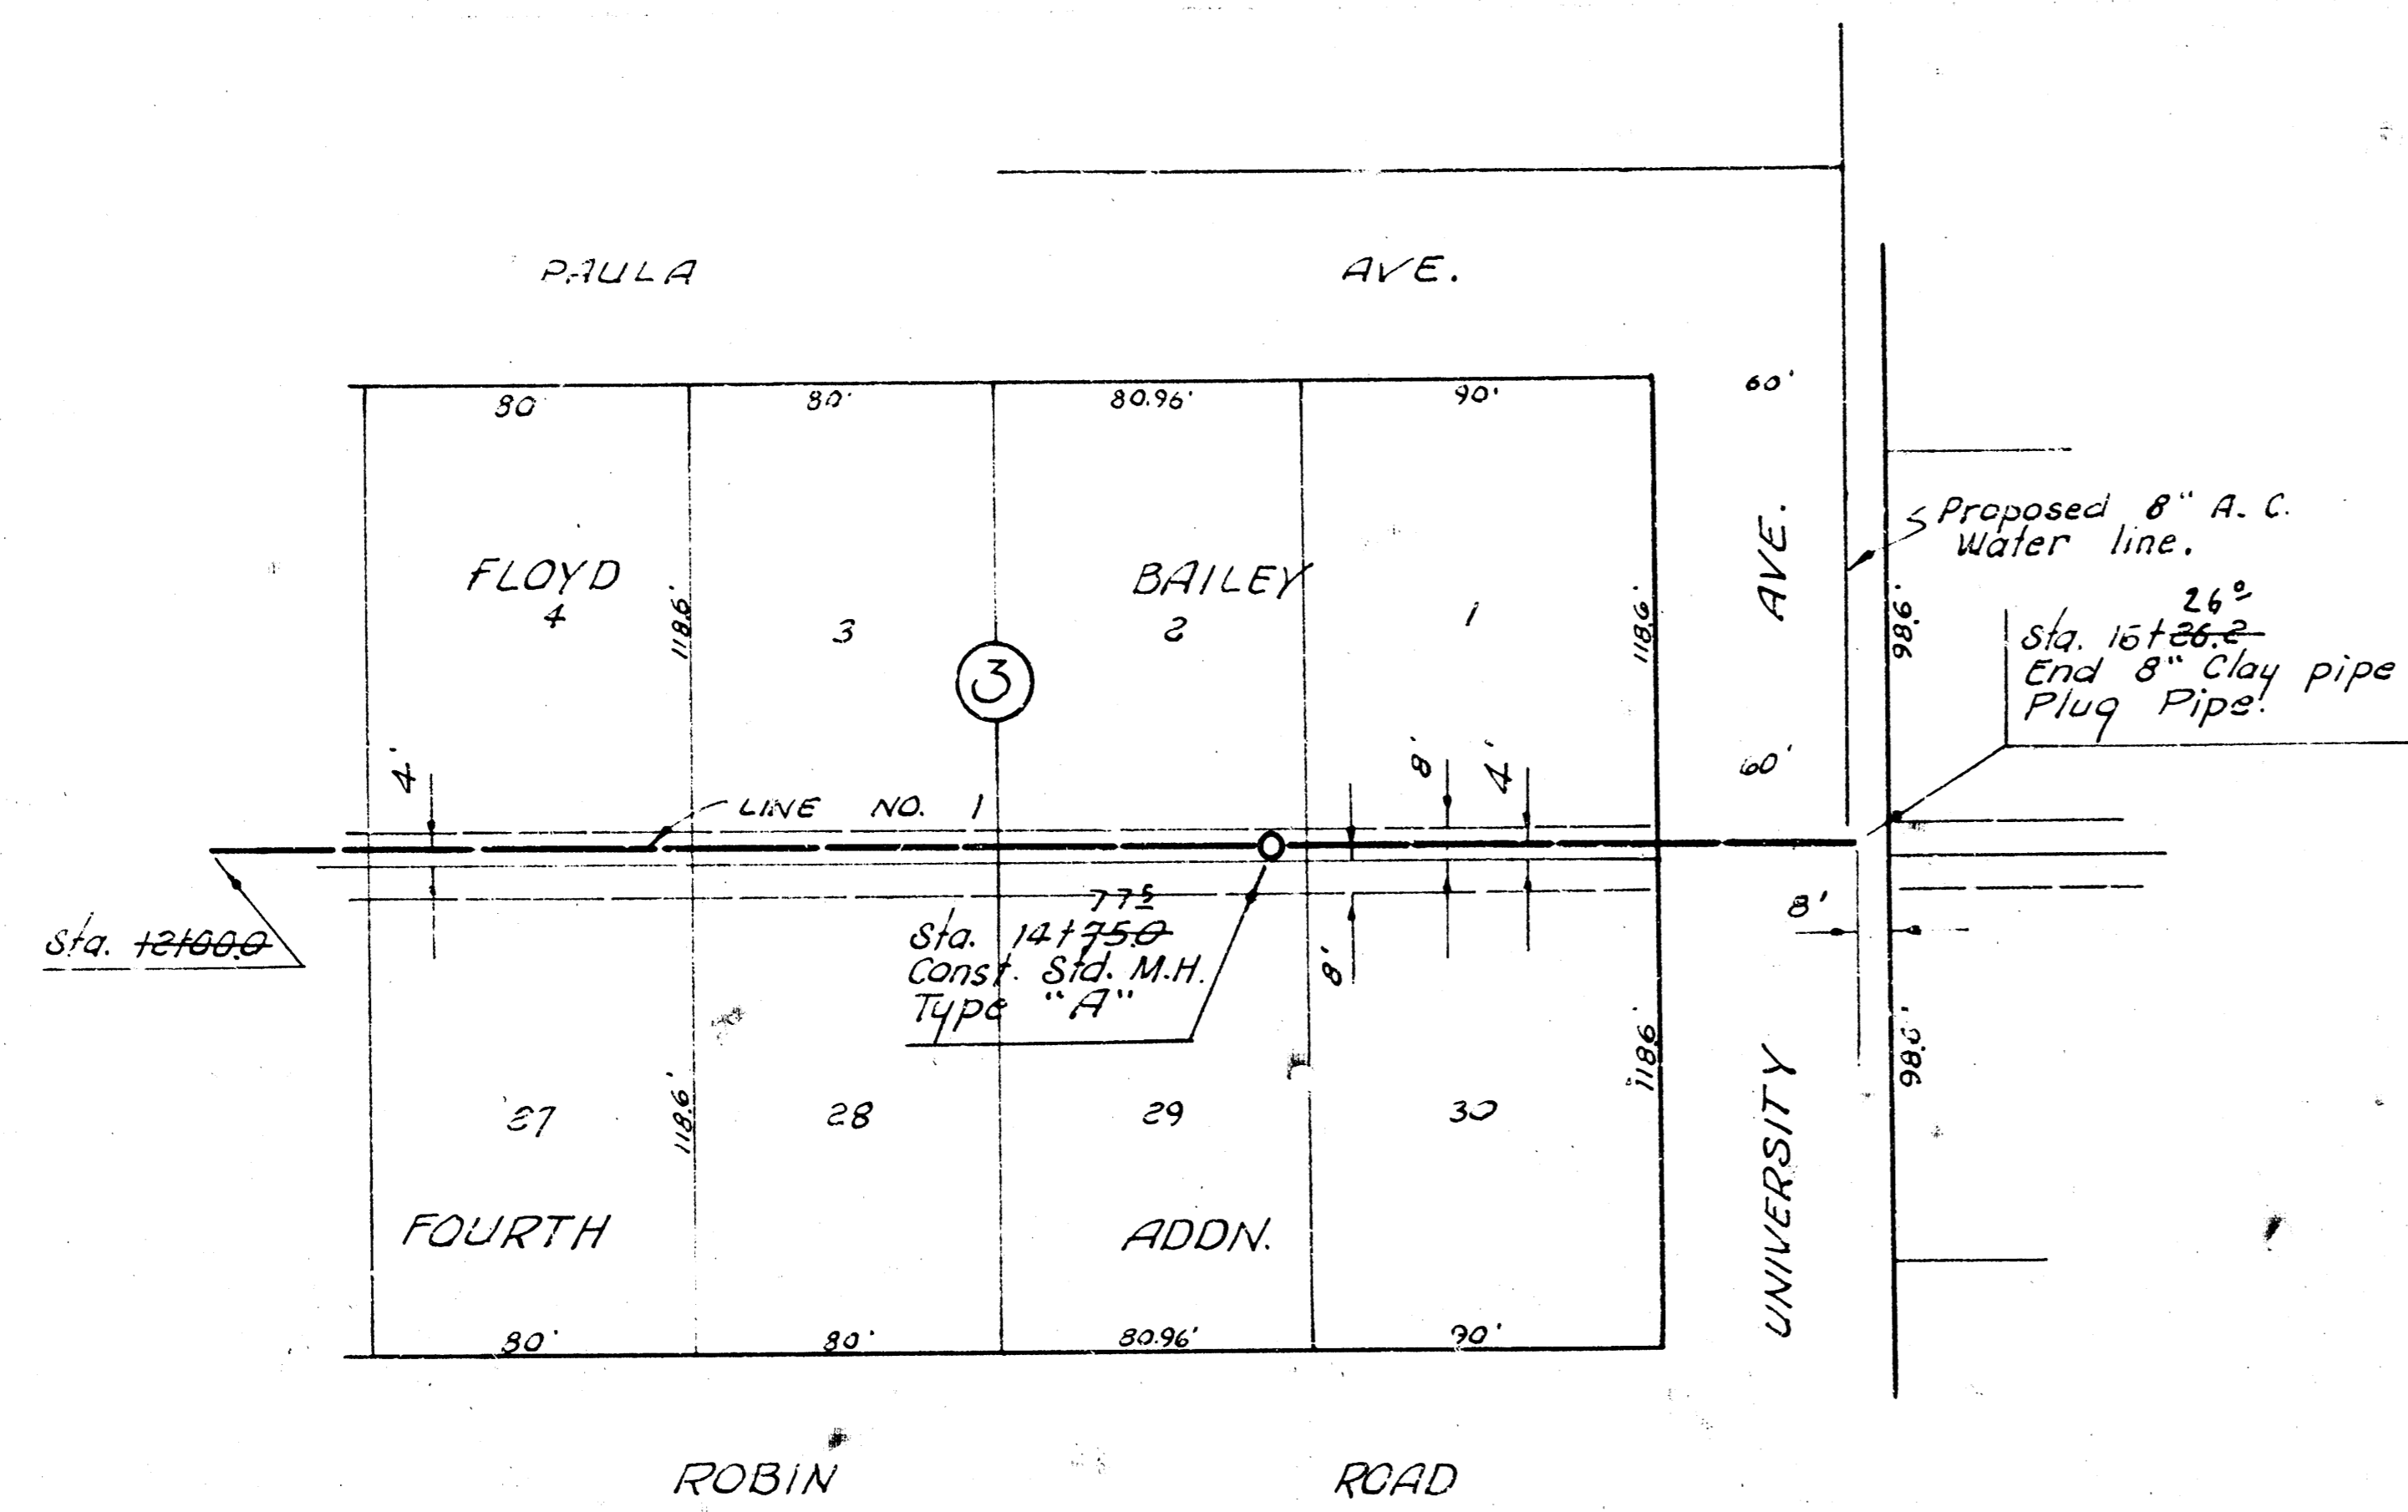

Plan Scale 1" = 40'  
 Profile Scale 1" = 40' Horiz.  
 1" = 5' Vert.

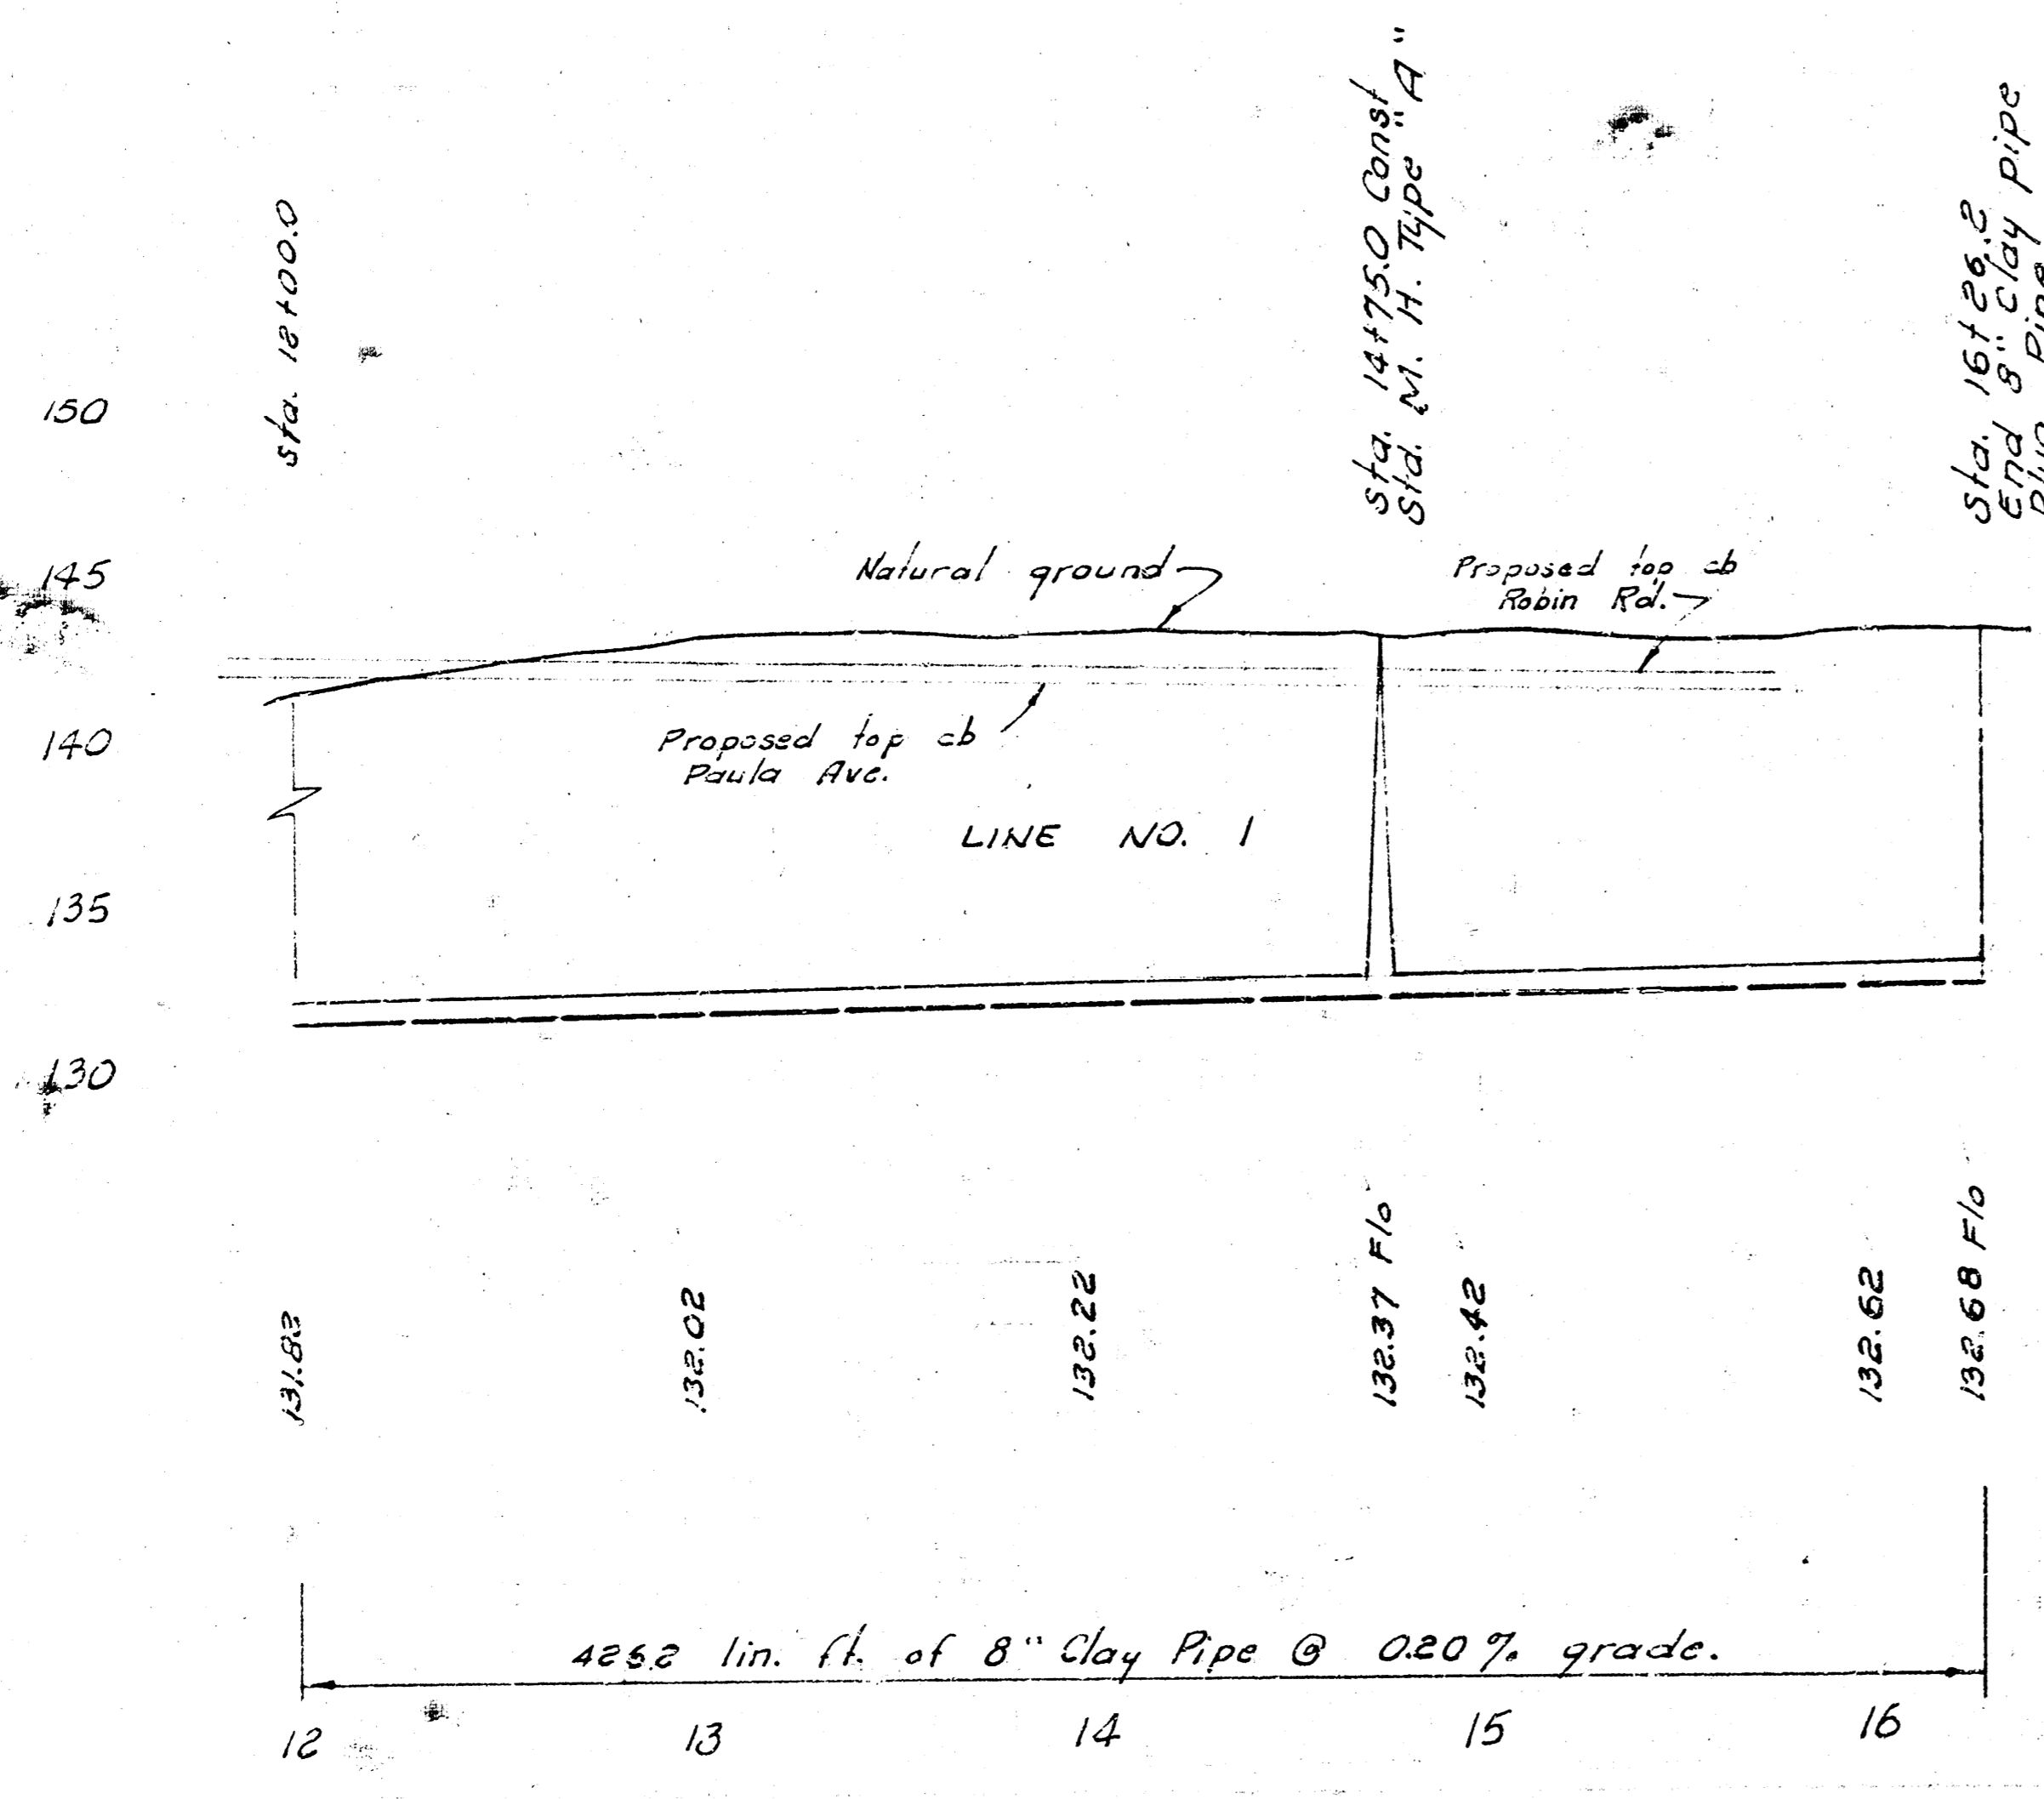

LAT. 7 S. W. MAIN  
 PROJECT NO. DBK L568030

