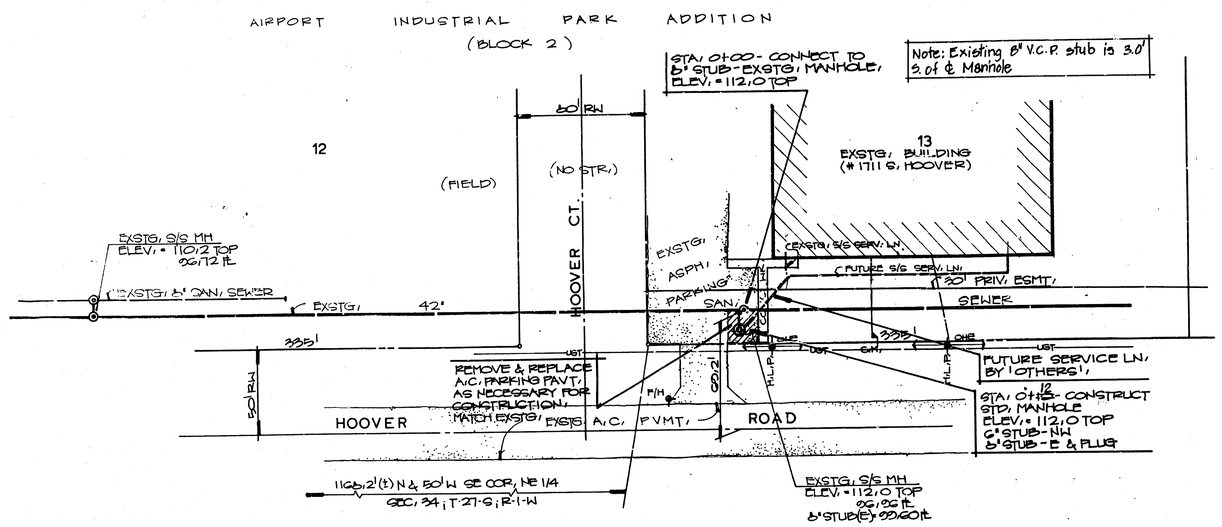

N

1" = 40' HORZ.
1" = 5' VERT.

NOTE TO CONTRACTOR

INSPECTION AND TESTING FOR THIS PROJECT IS TO BE PROVIDED BY A LICENSED CONSULTING ENGINEERING FIRM UNDER CONTRACT WITH THE OWNER/DEVELOPER. SAID INSPECTION TO BE IN ACCORDANCE WITH THE CITY OF WICHITA STANDARD CONSTRUCTION ENGINEERING PRACTICES AND CERTIFIED BY A LICENSED PROFESSIONAL ENGINEER. NO WORK SHALL BE PERFORMED IN DEDICATED EASEMENTS OR THE PUBLIC RIGHT-OF-WAY BY THE CONTRACTOR WITHOUT SUCH INSPECTION NOR SHALL ANY WORK BE COMMENCED IN DEDICATED EASEMENTS OR PUBLIC RIGHT-OF-WAY WITHOUT WRITTEN AUTHORIZATION BY THE CITY ENGINEER.

APPROVED AS NOTED
By CITY ENGINEER OF WICHITA

Sanitary Sewers VRH 5/7/90
Storm Sewers
Driveway Approaches
Water Mains
Paving

• BENCHMARKS •

1. CITY DISC - 44' S. & 45' W ℄ INTERSECTION HARRY ST. @ HOOVER RD. ELEV. = 111.94 C.D.
2. CITY DISC - 48' E & 5' S SEC. 1/4 COR. (℄ MAY AVE @ HOOVER RD. ELEV. = 110.57 C.D.

PLAN
SURVEYED
PLOTTED
NOTE BOOK
ALIGNMENT CHECKED
E. W. MAY CHECK
No.
DATE

PROFILE
SURVEYED
PLOTTED
NOTE BOOK
GRADES CHECKED
S. W. NOTED
LINE/STATIONING CHECKED
No.
DATE

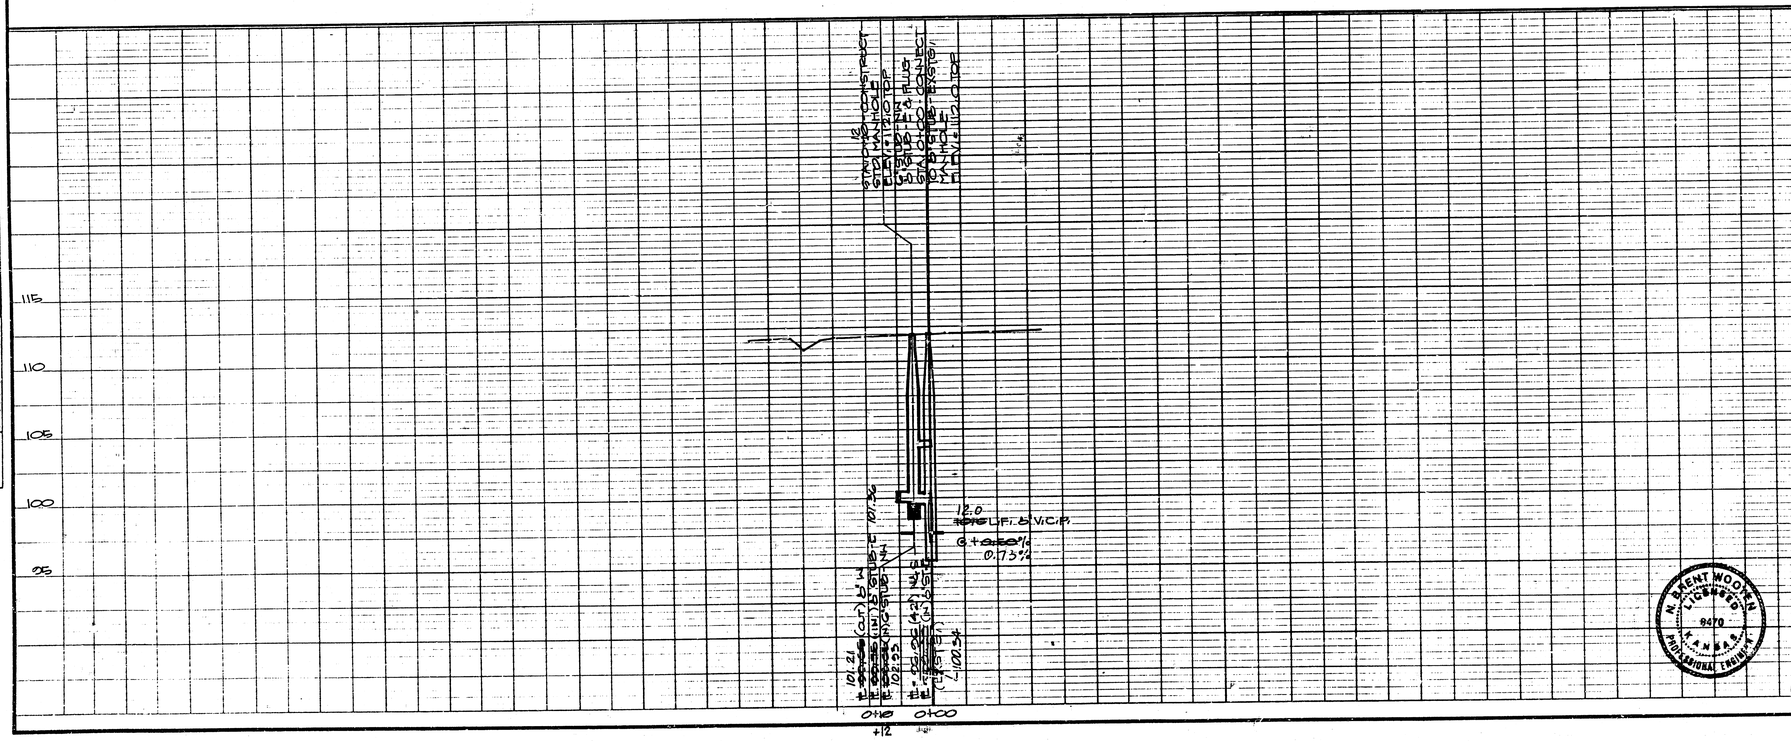

Booked 6-90 RDC

Rev. as built 5-31-90

LICENSED
9470
KANSAS
PROFESSIONAL ENGINEER

Title
PRIVATE SANITARY SEWER TO SERVE LOT 13, BLOCK 2 AIRPORT INDUSTRIAL PARK ADDN.

BAUGHMAN COMPANY, P.A.
SURVEYING & ENGINEERING
316/262-7271 • 315 ELLIS • WICHITA, KANSAS 67211

Design:	Drawn:	Approved:	Date:	Scale:
NBW	SONNY		APR. '90	NOTED

Sheet 1 of 1

PROJECT NO.: 250 PPS (607861)

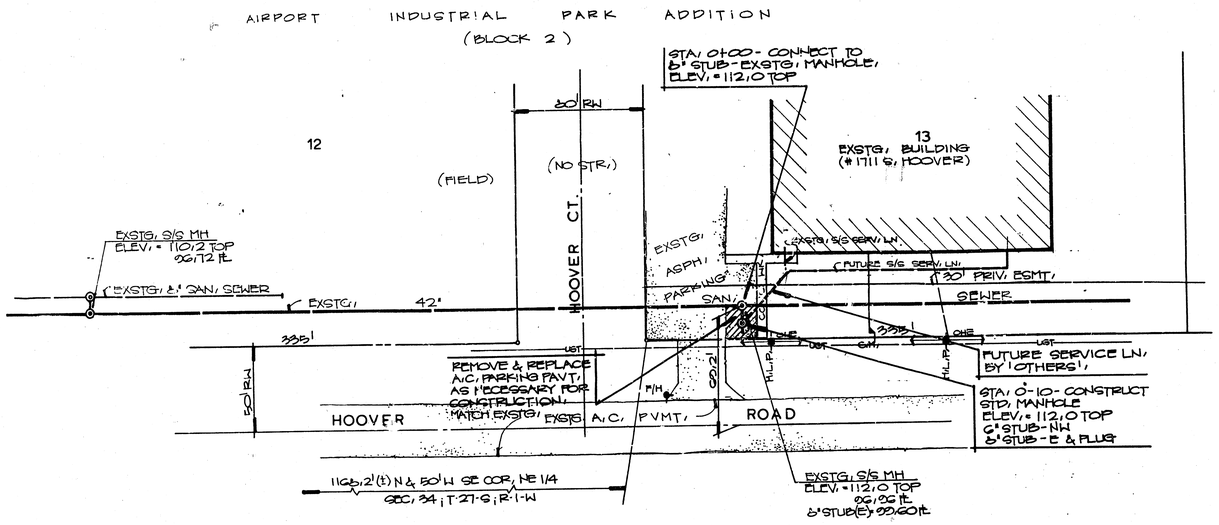

N
1" = 90' HORZ.
1" = 5' VERT.

NOTE TO CONTRACTOR

INSPECTION AND TESTING FOR THIS PROJECT IS TO BE PROVIDED BY A LICENSED CONSULTING ENGINEERING FIRM UNDER CONTRACT WITH THE OWNER/DEVELOPER. SAID INSPECTION TO BE IN ACCORDANCE WITH THE CITY OF WICHITA STANDARD CONSTRUCTION ENGINEERING PRACTICES AND CERTIFIED BY A LICENSED PROFESSIONAL ENGINEER. NO WORK SHALL BE PERFORMED IN DEDICATED EASEMENTS OR THE PUBLIC RIGHT-OF-WAY BY THE CONTRACTOR WITHOUT SUCH INSPECTION AND SHALL ANY WORK BE COMMENCED IN DEDICATED EASEMENTS OR PUBLIC RIGHT-OF-WAY WITHOUT WRITTEN AUTHORIZATION BY THE CITY ENGINEER.

APPROVED AS NOTED
By CITY ENGINEER OF WICHITA

Sanitary Sewers VRH 5/7/90
Storm Sewers
Driveway Approaches
Water Mains
Paving

• BENCHMARKS •

1. CITY DISC - 44' S. & 45' W ℄ INTERSECTION HARRY ST. @ HOOVER RD. ELEV. = 111.04 C.D.
2. CITY DISC - 46' E & 5' S SEC. 1/4 COR. (℄ MAY AVE @ HOOVER RD. ELEV. = 110.37 C.D.

PLAN — SURVEYED / PLOTTED / NOTE BOOK / No. — BY / DATE — ALIGNMENT CHECKED / GRADE CHECKED

PROFILE — SURVEYED / PLOTTED / NOTE BOOK / No. — GRADES CHECKED / H. = V. = NOTED / STRUCTURE LOCATIONS CHECKED — BY / DATE

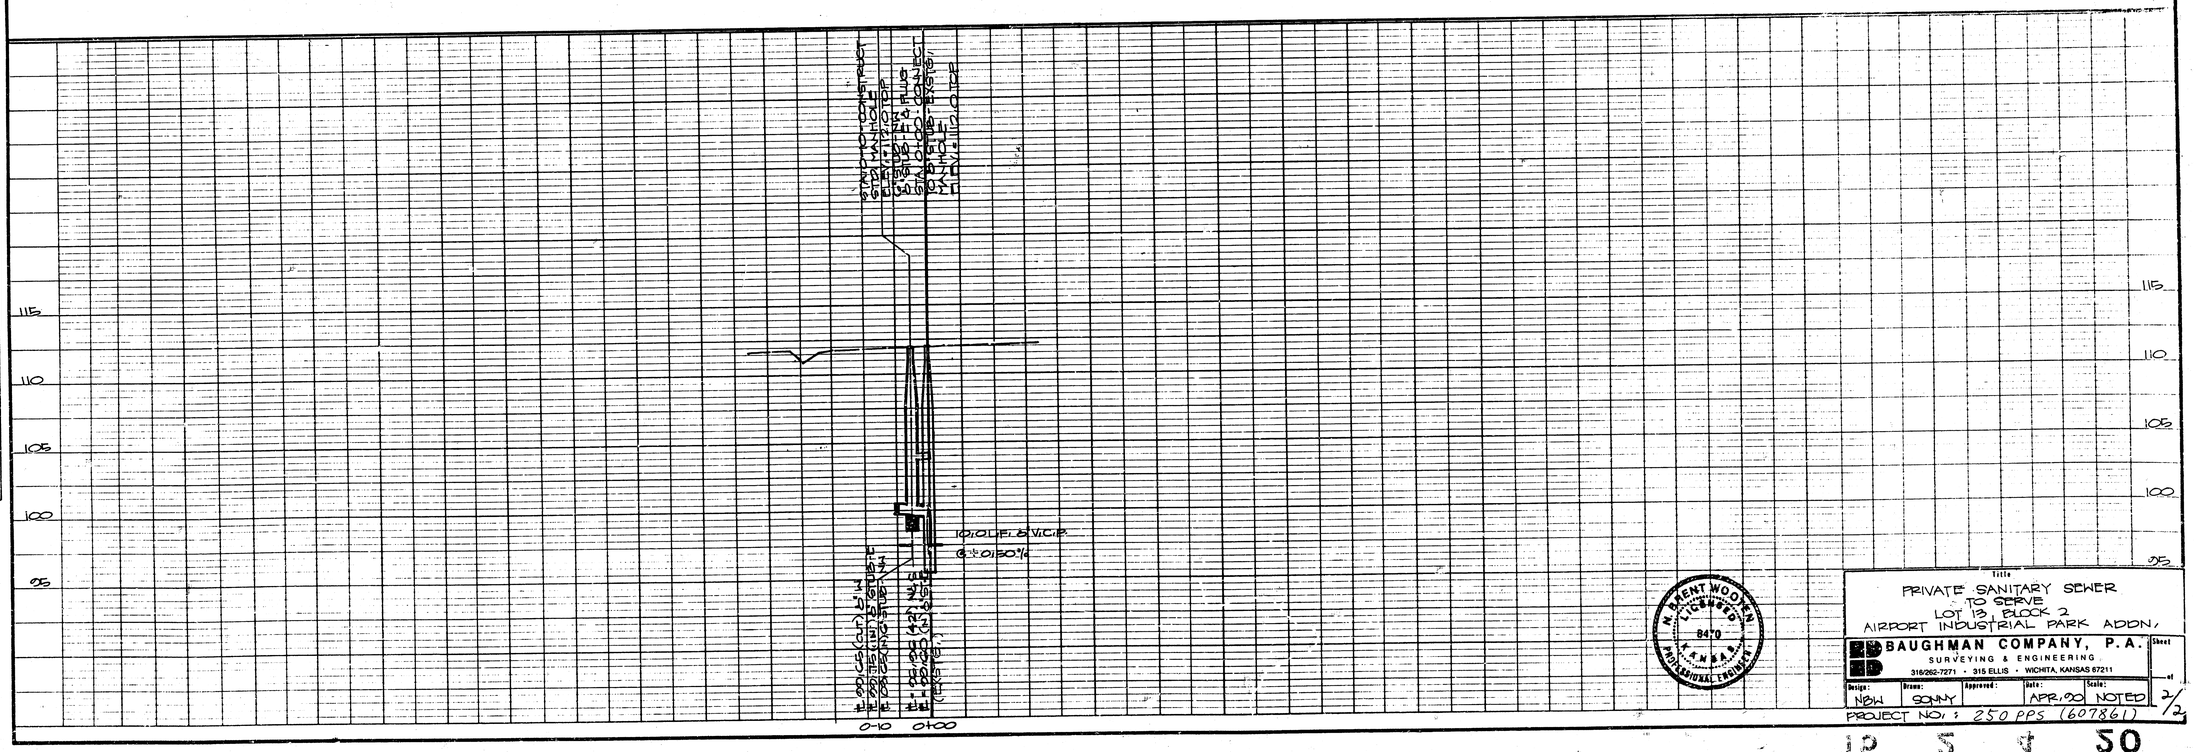

N. KENT WOOTEN LICENSED 8470 KANSAS PROFESSIONAL ENGINEER

Title
PRIVATE SANITARY SEWER
TO SERVE
LOT 13, BLOCK 2
AIRPORT INDUSTRIAL PARK ADDN.

BAUGHMAN COMPANY, P.A.
SURVEYING & ENGINEERING
316/262-7271 • 315 ELLIS • WICHITA, KANSAS 67211

Design:	Drawn:	Approved:	Date:	Scale:	Sheet of
NBW	SONNY		APR. '90	NOTED	2/2

PROJECT NO.: 250 PPS (607861)

12 5 4 50