


NO.	DESCRIPTION	DATE	BY
1	DESIGNED	11/88	RES
2	CHECKED		
3	APPROVED		
4	REVISIONS		

NO.	DESCRIPTION	DATE	BY
1	DESIGNED	11/88	RES
2	CHECKED		
3	APPROVED		
4	REVISIONS		

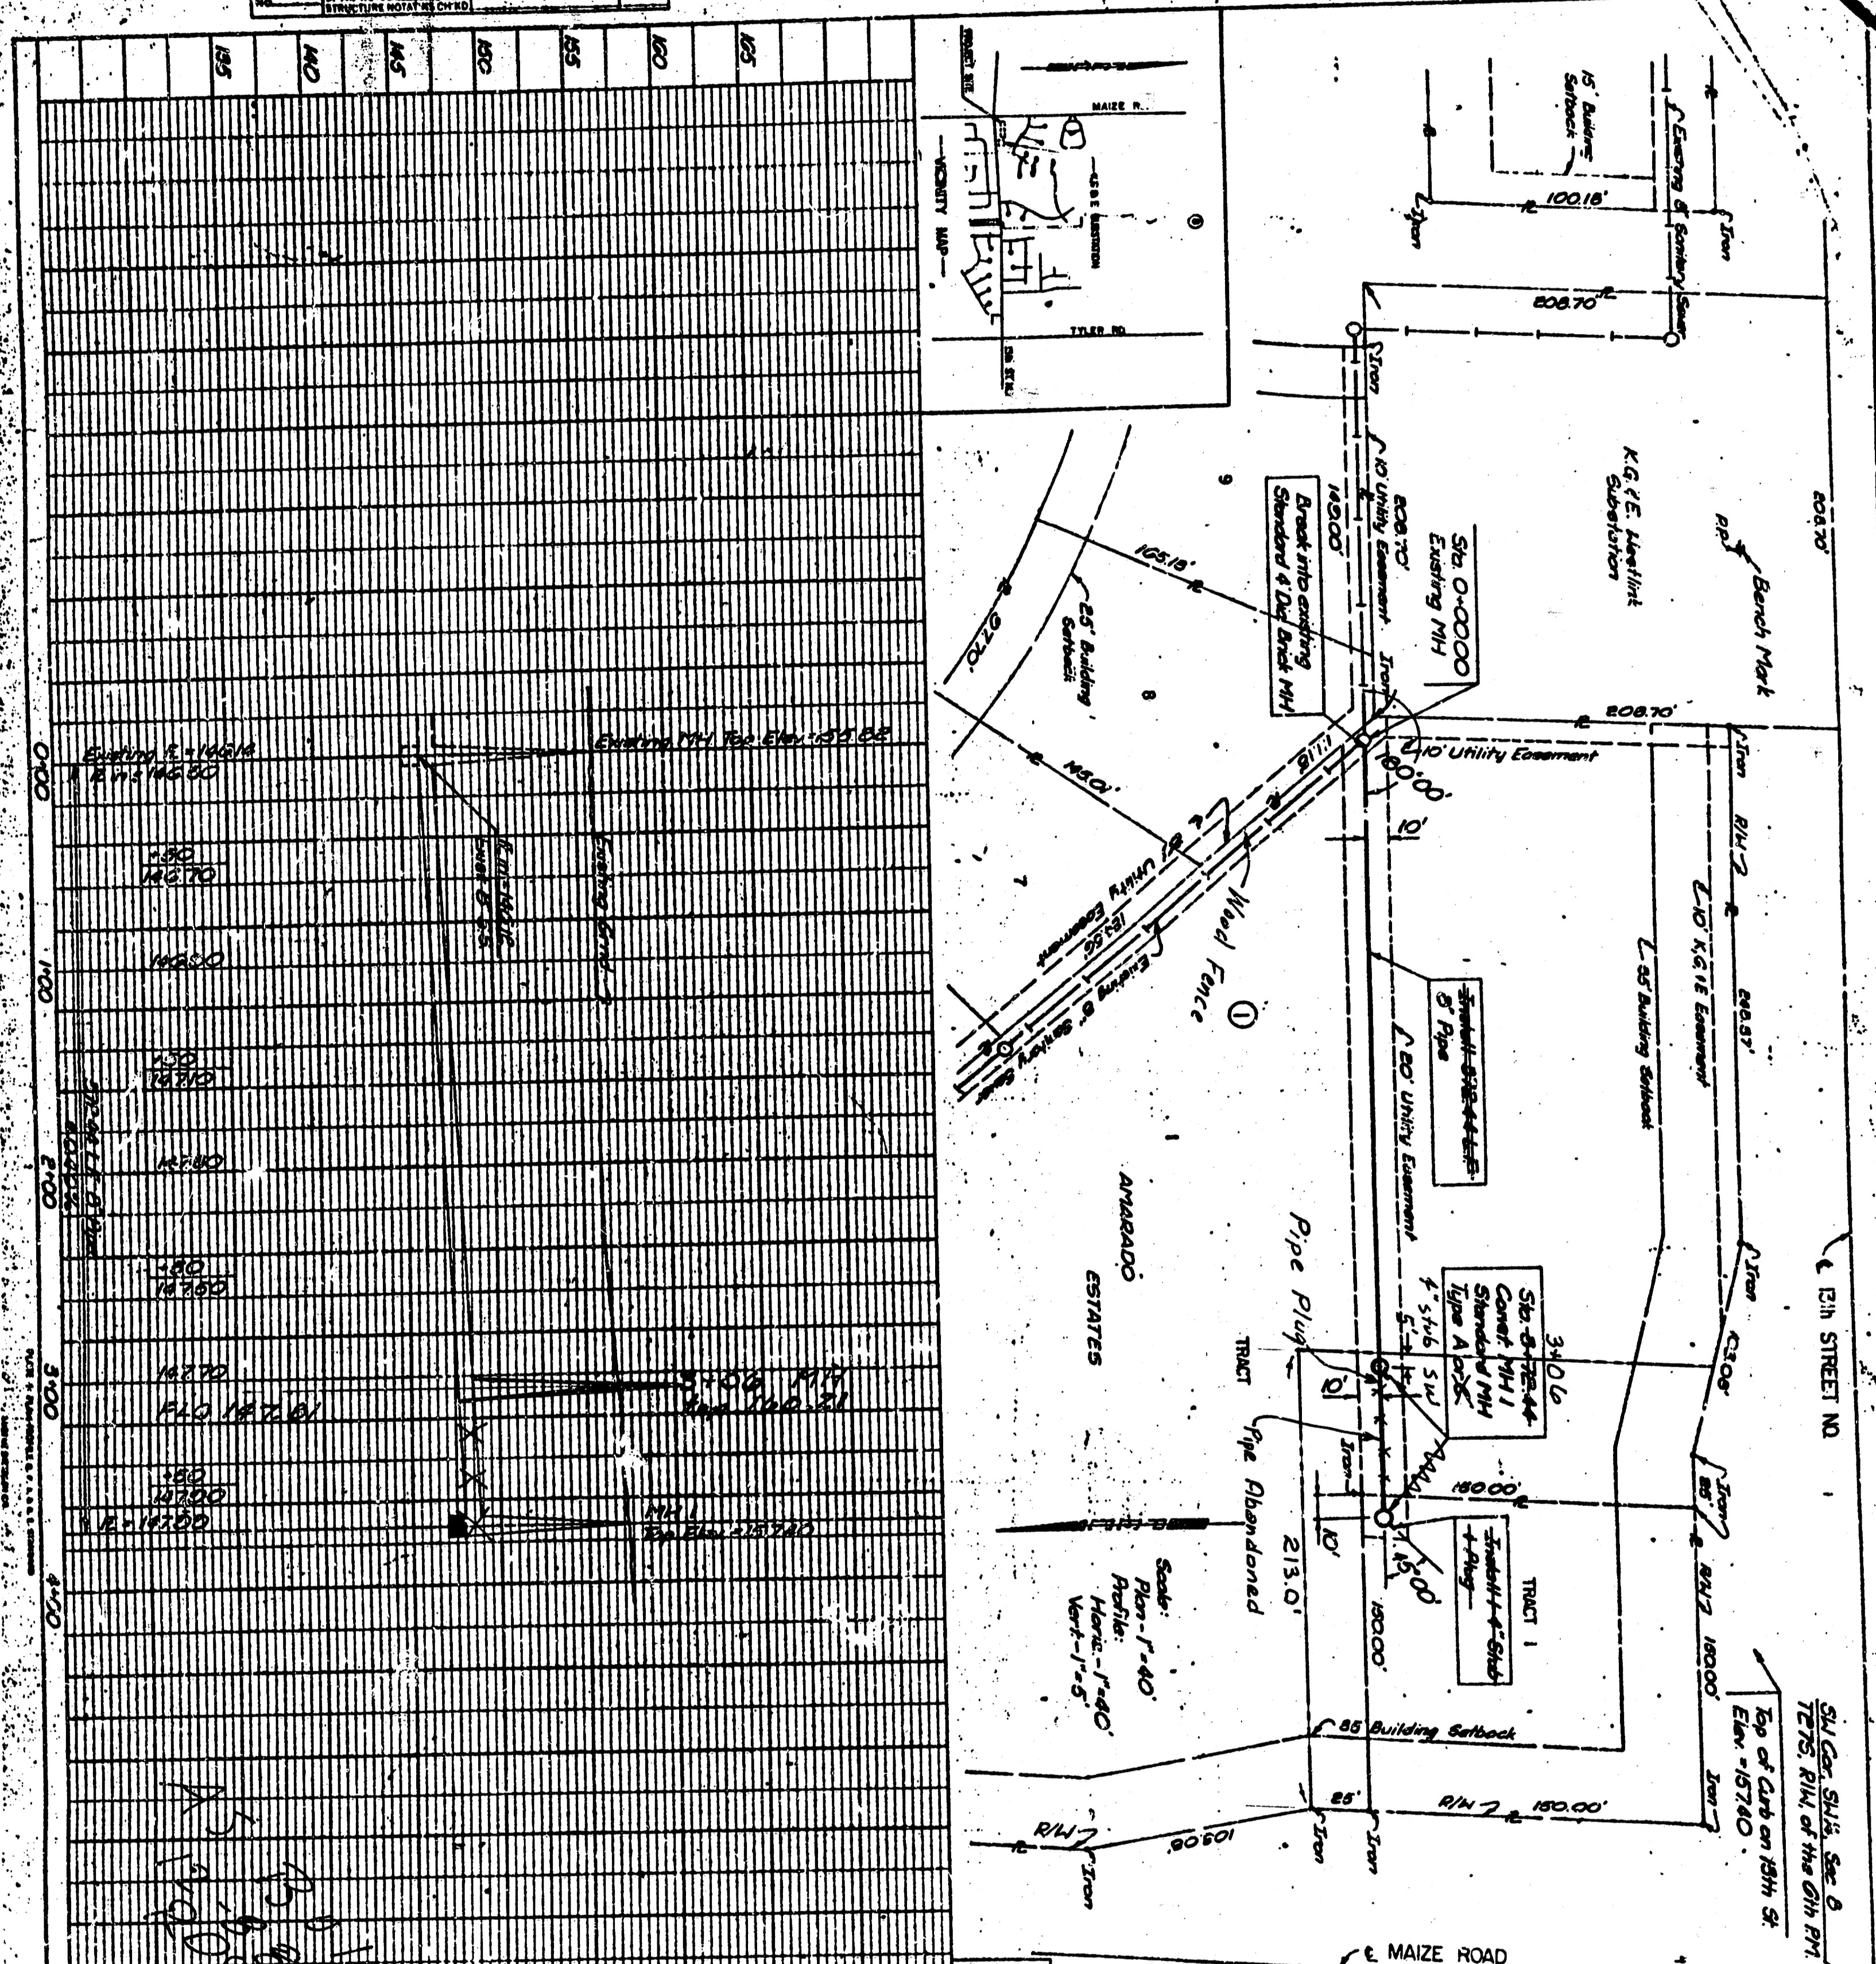

Placed S.S.
Copper & S.
20' Baulds
FILM

CONSTRUCTION PERMITS 11-88
DO NOT CHANGE TIME TO THE PROJECT

FILED FROM THE BEST AVAILABLE COPY.....

CITY OF WICHA
SEWER DEPARTMENT
SANTARY SEWER EXTENSION TO SERVE
PART OF LOT 1, BLOCK 1
AMARADO ESTATES

PROFESSIONAL ENGINEER'S SEAL
RES, CIVIL
DATE: 11/88

