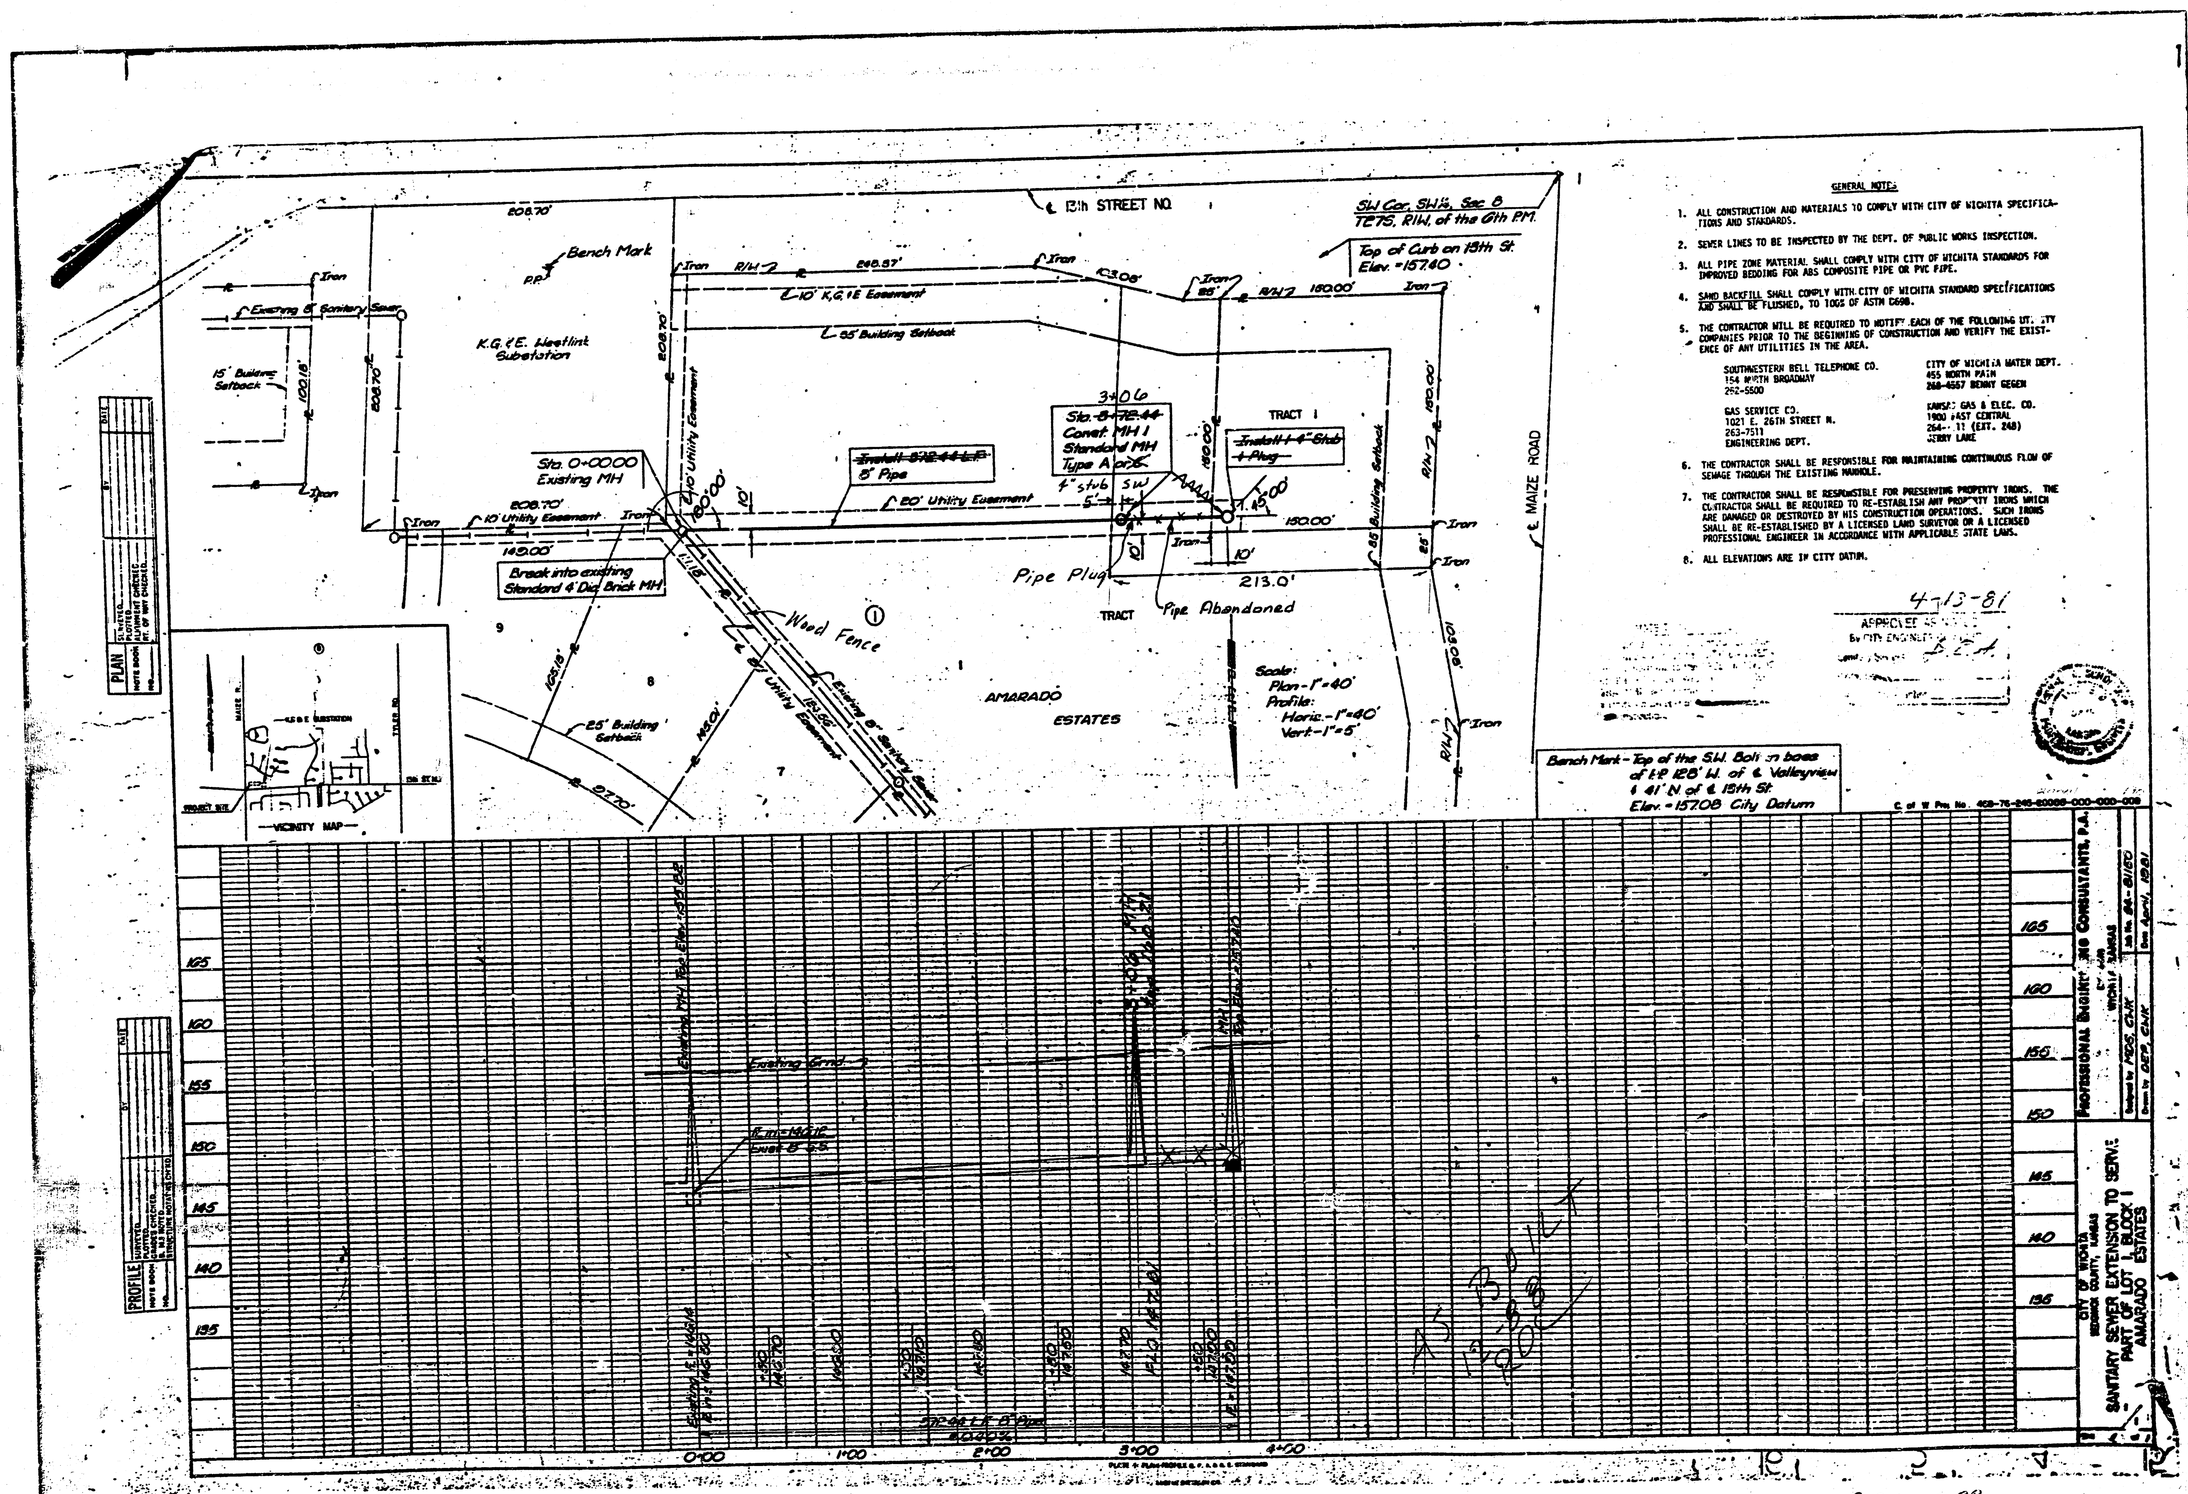


GENERAL NOTES

1. ALL CONSTRUCTION AND MATERIALS TO COMPLY WITH CITY OF WICHITA SPECIFICATIONS AND STANDARDS.
2. SEWER LINES TO BE INSPECTED BY THE DEPT. OF PUBLIC WORKS INSPECTION.
3. ALL PIPE ZONE MATERIAL SHALL COMPLY WITH CITY OF WICHITA STANDARDS FOR IMPROVED BEDDING FOR ABS COMPOSITE PIPE OR PVC PIPE.
4. SAND BACKFILL SHALL COMPLY WITH CITY OF WICHITA STANDARD SPECIFICATIONS AND SHALL BE FLUSHED, TO 100% OF ASTM C600.
5. THE CONTRACTOR WILL BE REQUIRED TO NOTIFY EACH OF THE FOLLOWING UTILITY COMPANIES PRIOR TO THE BEGINNING OF CONSTRUCTION AND VERIFY THE EXISTENCE OF ANY UTILITIES IN THE AREA.

SOUTHWESTERN BELL TELEPHONE CO. 154 N. MAIN BROADWAY 262-5500	CITY OF WICHITA WATER DEPT. 455 NORTH MAIN 268-4557 BENNY GEGEN
GAS SERVICE CO. 1021 E. 26TH STREET N. 263-7311 ENGINEERING DEPT.	KANSAS GAS & ELEC. CO. 1900 EAST CENTRAL 264-11 (EXT. 248) JERRY LAKE

6. THE CONTRACTOR SHALL BE RESPONSIBLE FOR MAINTAINING CONTINUOUS FLOW OF SEWAGE THROUGH THE EXISTING MANHOLE.
7. THE CONTRACTOR SHALL BE RESPONSIBLE FOR PRESERVING PROPERTY IRONS. THE CONTRACTOR SHALL BE REQUIRED TO RE-ESTABLISH ANY PROPERTY IRONS WHICH ARE DAMAGED OR DESTROYED BY HIS CONSTRUCTION OPERATIONS. SUCH IRONS SHALL BE RE-ESTABLISHED BY A LICENSED LAND SURVEYOR OR A LICENSED PROFESSIONAL ENGINEER IN ACCORDANCE WITH APPLICABLE STATE LAWS.
8. ALL ELEVATIONS ARE IN CITY DATUM.

4-13-81
APPROVED AS NOTED
by CITY ENGINEER

C of S Pro. No. 429-76-845-82009-000-000-000

CITY OF WICHITA
DEPARTMENT OF PUBLIC WORKS
PROFESSIONAL ENGINEERS 200 CONSULTANTS, P.A.
WICHITA, KANSAS
Date No. 84-81210
Date April, 1981
Drawn by MSS, CHK
Traced by DES, CHK

SANITARY SEWER EXTENSION TO SERVE PART OF LOT 1, BLOCK 1 AMARADO ESTATES

CONSTRUCTION PLAN 11-98
DO NOT CHARGE TIME TO THIS PROJECT 1/1

Private S.S.
Original & as Built
FILM

FILMED FROM THE BEST AVAILABLE COPY.....