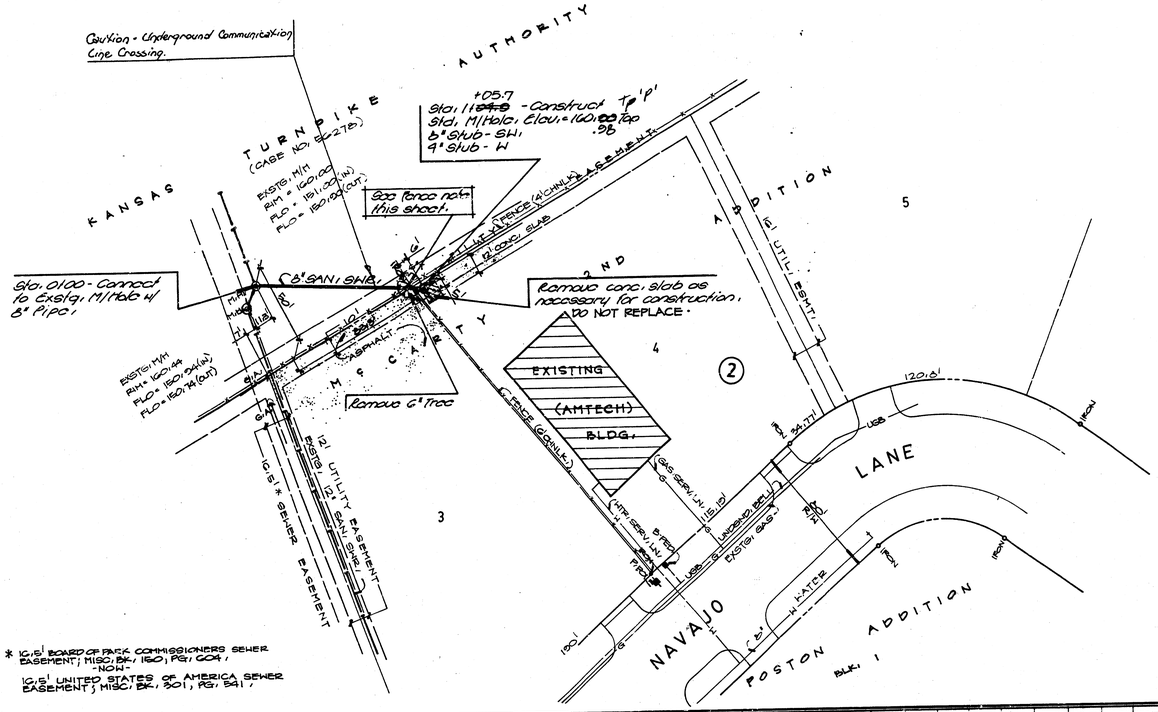


1" = 40' HORZ.
1" = 5' VERT.

• FENCE NOTE •

Contractor to remove & replace K.T.A. wire fence DAILY as necessary. At no time during construction shall the K.T.A. fence be left unattended or open for any time without temporarily closing the fence opening.

Contractor to contact K.T.A. officials and make arrangements for construction within K.T.A. property. This shall include any bonds, deposits, permits, and fees thereof which may be required by the Kansas Turnpike Authority.

NOTE TO CONTRACTOR

INSPECTION AND TESTING FOR THIS PROJECT IS TO BE PROV... BY A LICENSED CONSULTING ENGINEERING FIRM U... CONTRACT WITH THE OWNER/DEVELOPER SAID INSPECTIO... IN ACCORDANCE WITH THE CITY OF WICHITA CO... CONSTRUCTION ENGINEERING PRACTICES AS D... SUCH INSPECTION SHALL BE PERFORMED BY A LICENSED PROFESSIONAL ENGINEER, EMPLOYED BY THE OWNER/DEVELOPER OR BY LICENSED REPRESENTATIVES OF THE... CONSULTING ENGINEERING FIRM. IN ADDITION, THE CONTRACTOR SHALL NOTIFY THE CITY INSPECTOR AT LEAST 48 HOURS IN ADVANCE OF THE TIME WORK IS TO BE COMMENCED AND SHALL NOT PROCEED WITH THE WORK IN THE PUBLIC RIGHT-OF-WAY WITHOUT WRITTEN AUTHORIZATION FROM THE CITY ENGINEER.

• BENCHMARK •
"O" TC, EAST OF SO. PC, IRON AT NE. COR. POSTON ADDN. ELEV. = 1581.71 CITY DATUM

APPROVED AS NOTED
By CITY ENGINEER OF WICHITA
Sanitary Sewers VRH 5/3/90
Storm Sewers
Drive-ins, approaches
Water Mains
Paving

Revised as built 6-20-90 TCB
PROJECT NO. 239 PPS

Title
PRIVATE SANITARY SEWER
AMTECH SITE
LOT 4, BLK 2
McCARTY 2nd ADDITION

1/2

BAUGHMAN COMPANY, P.A.
SURVEYING & ENGINEERING
316/262-7271 • 315 ELLIS • WICHITA, KANSAS 67211


Design:	Drawn:	Approved:	Date:	Scale:
NBWOOTEN	SONNY		FEB 90	NOTED

Sheet 1 of 1

N. BRENT WOOTEN LICENSED 9479 KANSAS PROFESSIONAL ENGINEER

PLAN: SUBMITTED, REVISED, CHECKED, APPROVED, SPECIFICATIONS CHECKED

PROFILE: SUBMITTED, REVISED, CHECKED, APPROVED, NOTE BOOK, No.

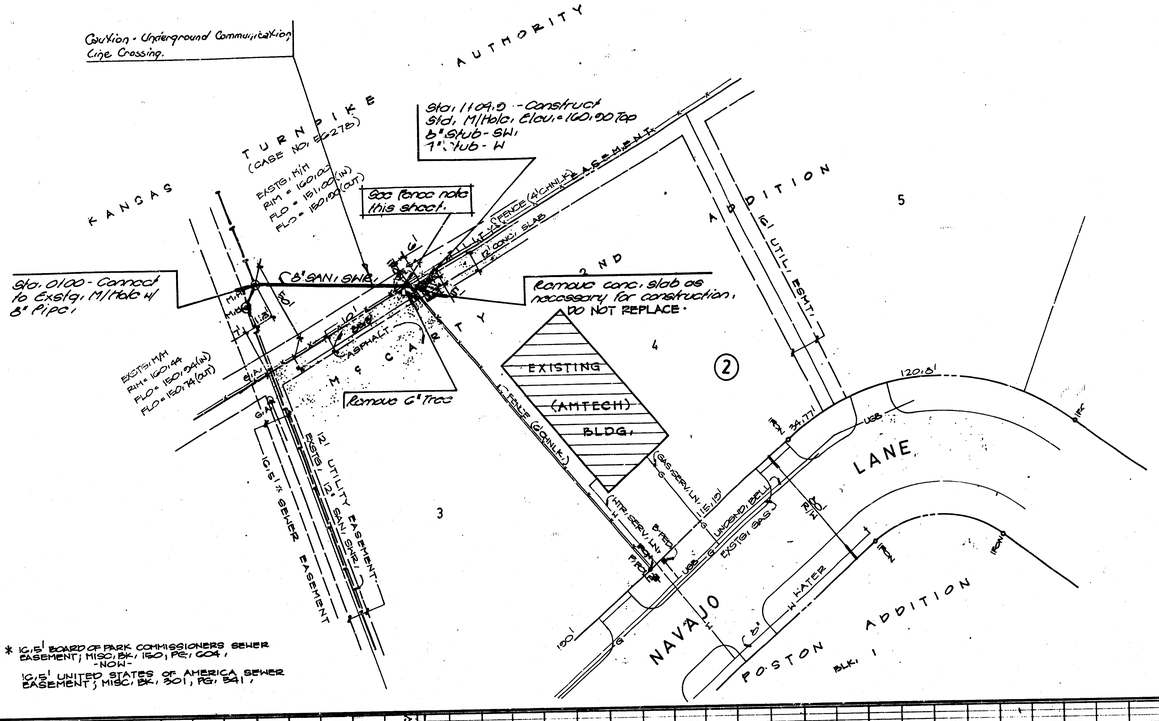

• FENCE NOTE •

Contractor to remove & replace K.T.A. Wire fence ONLY as necessary. At no time during construction shall the K.T.A. fence be left unattended or open for any time without temporarily closing the fence opening.

Contractor to contact K.T.A. officials and make arrangements for construction within K.T.A. property; This shall include any bonds, deposits, permits, and fees thereof which may be required by the Kansas Turnpike Authority.

NOTE TO CONTRACTOR

INSPECTION AND TESTING FOR THIS PROJECT IS TO BE PROVIDED BY A LICENSED CONSULTING ENGINEERING FIRM UNDER CONTRACT WITH THE OWNER/DEVELOPER. SAID INSPECTION IS IN ACCORDANCE WITH THE CITY OF WICHITA CONSTRUCTION ENGINEERING PRACTICES AND THE KANSAS STATE BOARD OF TECHNICAL ENGINEERS. NO UNAUTHORIZED CHANGES OR DEVIATIONS FROM APPROVED PLANS OR FIELD CHANGES SHALL BE MADE WITHOUT SUCH CHANGES BEING APPROVED BY THE ENGINEER. NO WORK SHALL BE COMMENCED IN DEDICATED PUBLIC RIGHT-OF-WAY WITHOUT WRITTEN APPROVAL FROM THE CITY ENGINEER.

APPROVED AS NOTED
By CITY ENGINEER OF WICHITA

Sanitary Sewers VRH 5/3/90

Storm Sewers

Driveway Approaches

Water Mains


Paving

• BENCHMARK •

"O" TC, EAST OF SO. PIC. IRON AT NE. COR. FOSTON ADDN. ELEV. = 1581.11 CITY DATUM

PLAN
NOTE BOOK
No.
SURVEYED
PLOTTED
AUTOMATIC CHECKED
BY HAND CHECKED
DATE
BY

PROFILE
NOTE BOOK
No.
SURVEYED
PLOTTED
CHECKED
H. & V. NOTED
STRUCTURE POSITIONS CHECKED

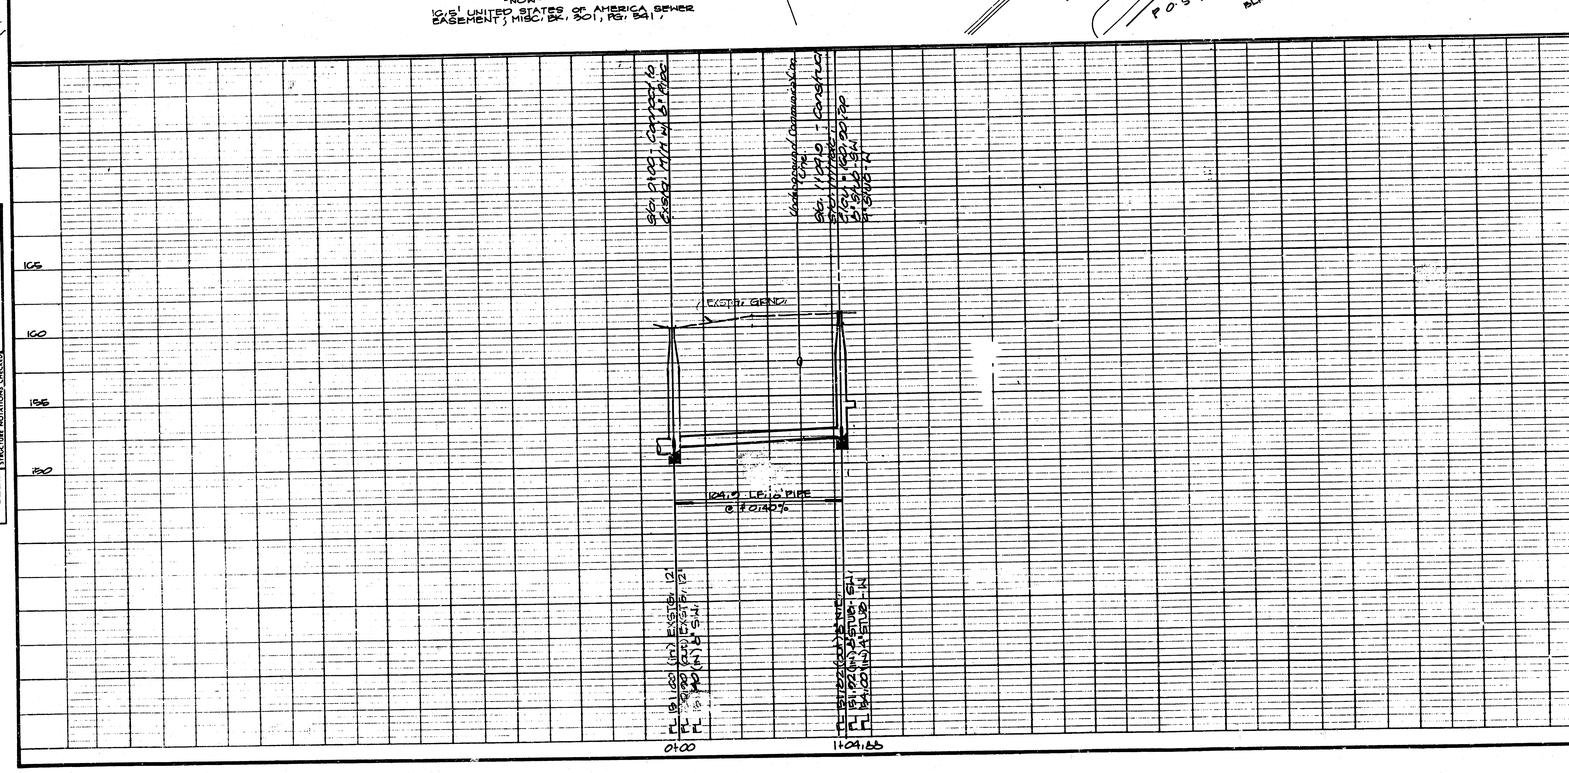

PROJECT NO. 239 PPS

Title
PRIVATE SANITARY SEWER
AMTECH SITE
LOT 4, BLK. 2
McCARTY 2nd ADDITION

N. BRENT WOOTEN LICENSED 8470 KANSAS PROFESSIONAL ENGINEER

BAUGHMAN COMPANY, P.A.
SURVEYING & ENGINEERING
316/262-7271 • 315 ELLIS • WICHITA, KANSAS 67211

Design:	Drawn:	Approved:	Date:	Scale:	Sheet
NBWOOTEN	BDHAY		FEB 90	NOTED	1 of 2