PLANS

FOR

SANITARY SEWER SYSTEM

BEL AIRE-COZY HOMES ADD.

SE0987

468-76-245-80001-000-000-153

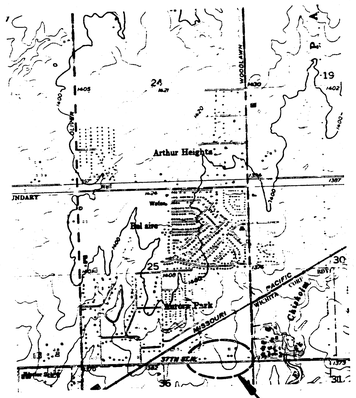

PROJECT LOCATION

APPROVED AS NOTED
By CITY ENGINEER OF WICHITA
Sanitary Sewers DVG 3/3/88
Storm Sewers _____
Driveway Approaches _____
Water Mains _____
Paving _____

NOTE TO CONTRACTOR

This project will be constructed under the supervision of the CITY ENGINEER and conforming to the SPECIFICATIONS of the CITY OF WICHITA. The CONTRACTOR will pay the City of Wichita for all costs of plan review, inspection and booking per contract.

CHARLES M. GOODNESS LICENSED 2733 KANSAS PROFESSIONAL ENGINEER

AS CONSTRUCTED

DEISS & GOODNESS ENGINEERS
2160 WEST 21ST STREET
WICHITA, KANSAS 67203
(316) 832-0233

1/4

REVISION		DRAWN BY		CHECKED BY	DESIGNED BY	PROJECT
		DEJ			C G	

CUSTOMER

REVISED 2/10/88

SCALE	NONE	PROJECT NO. SE0987
DATE	1-29-88	SHEET 1 OF 6

FILMED FROM THE BEST AVAILABLE COPY.....

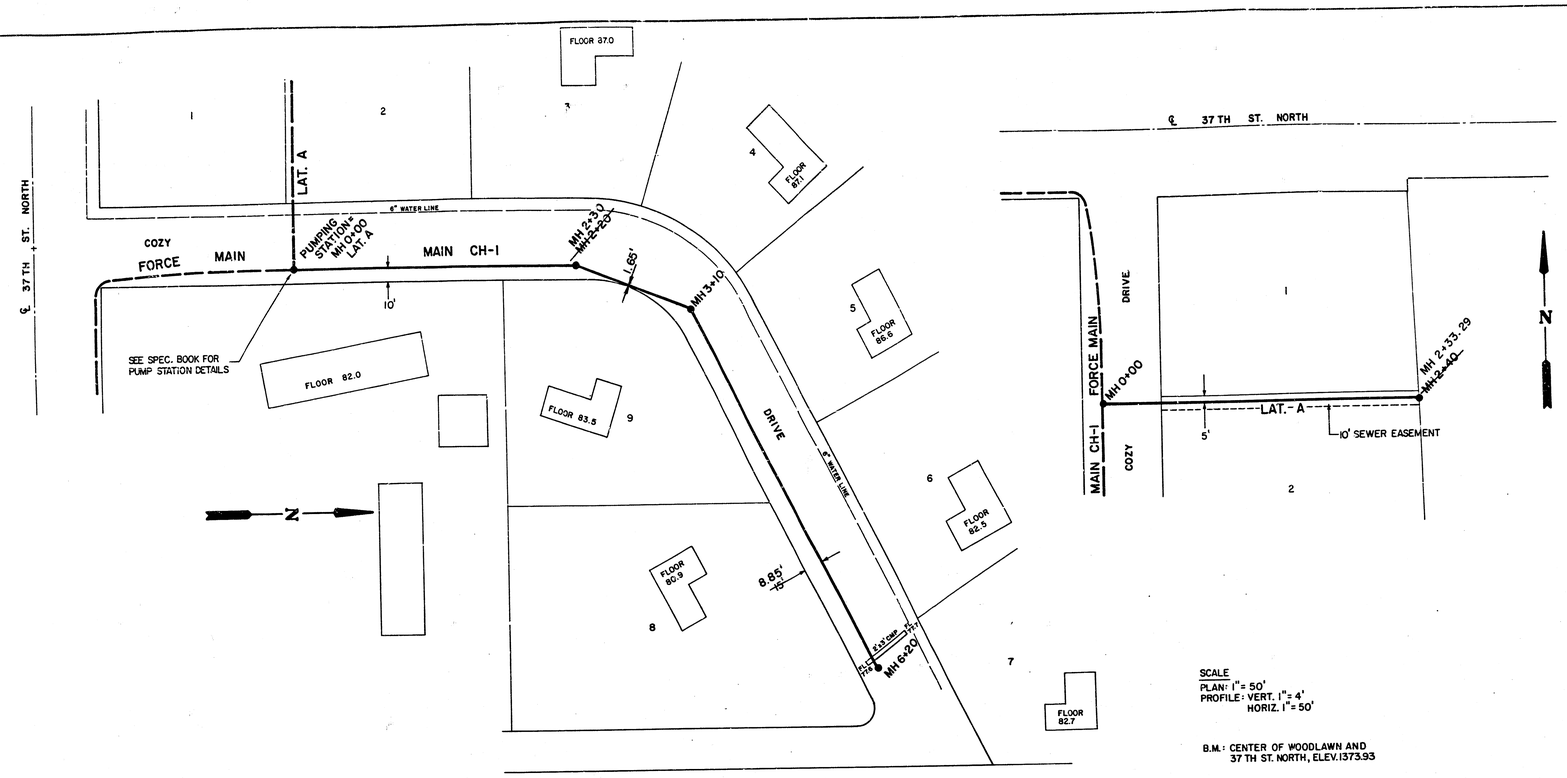

SCALE
PLAN: 1"= 50'
PROFILE: VERT. 1"= 4'
HORIZ. 1"= 50'

B.M.: CENTER OF WOODLAWN AND
37 TH ST. NORTH, ELEV. 1373.93

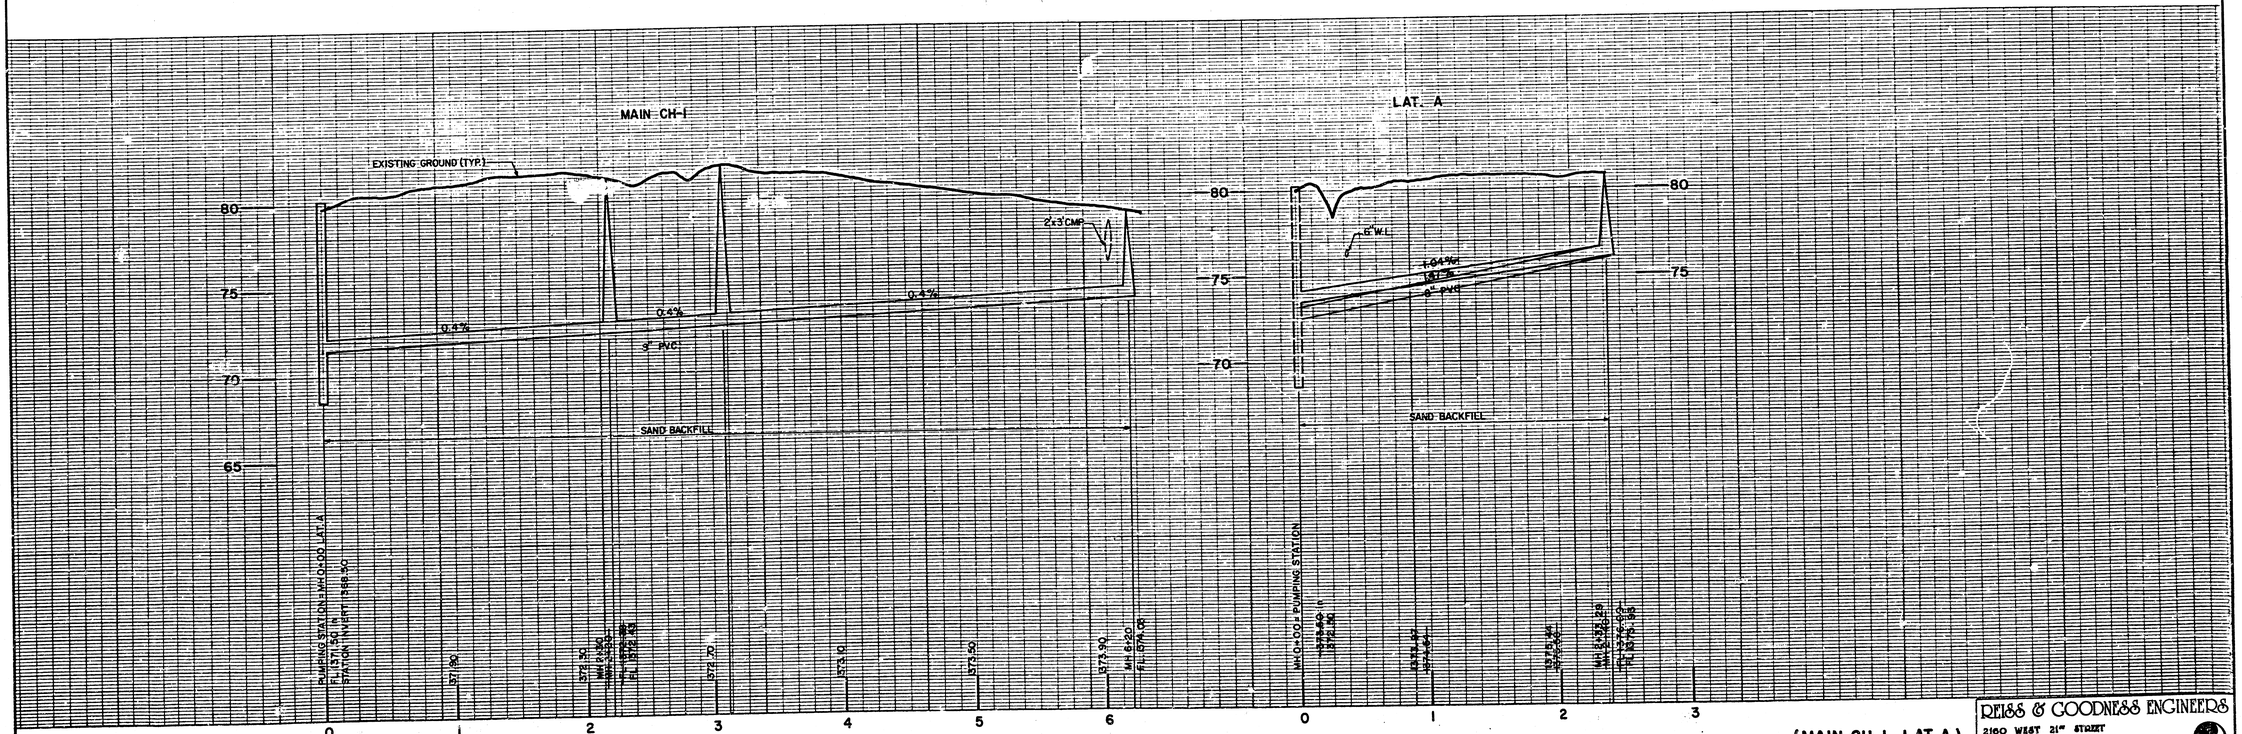

(MAIN CH-I, LAT. A)

REISS & GOODNESS ENGINEERS
2160 WEST 21ST STREET
WICHITA, KANSAS 67204
(316) 832-0253

2/4

REVISION		DRAWN BY		CHECKED BY	DESIGNED BY	PROJECT
		DEJ			C G	SANITARY SEWER SYSTEM

CUSTOMER: BEL AIRE-COZY HOMES ADD.

REVISED 2/10/68

SCALE	NOTED	PROJECT NO.	560987
DATE	1-29-68	SHEET	2 OF 6

FILMED FROM THE BEST AVAILABLE COPY....

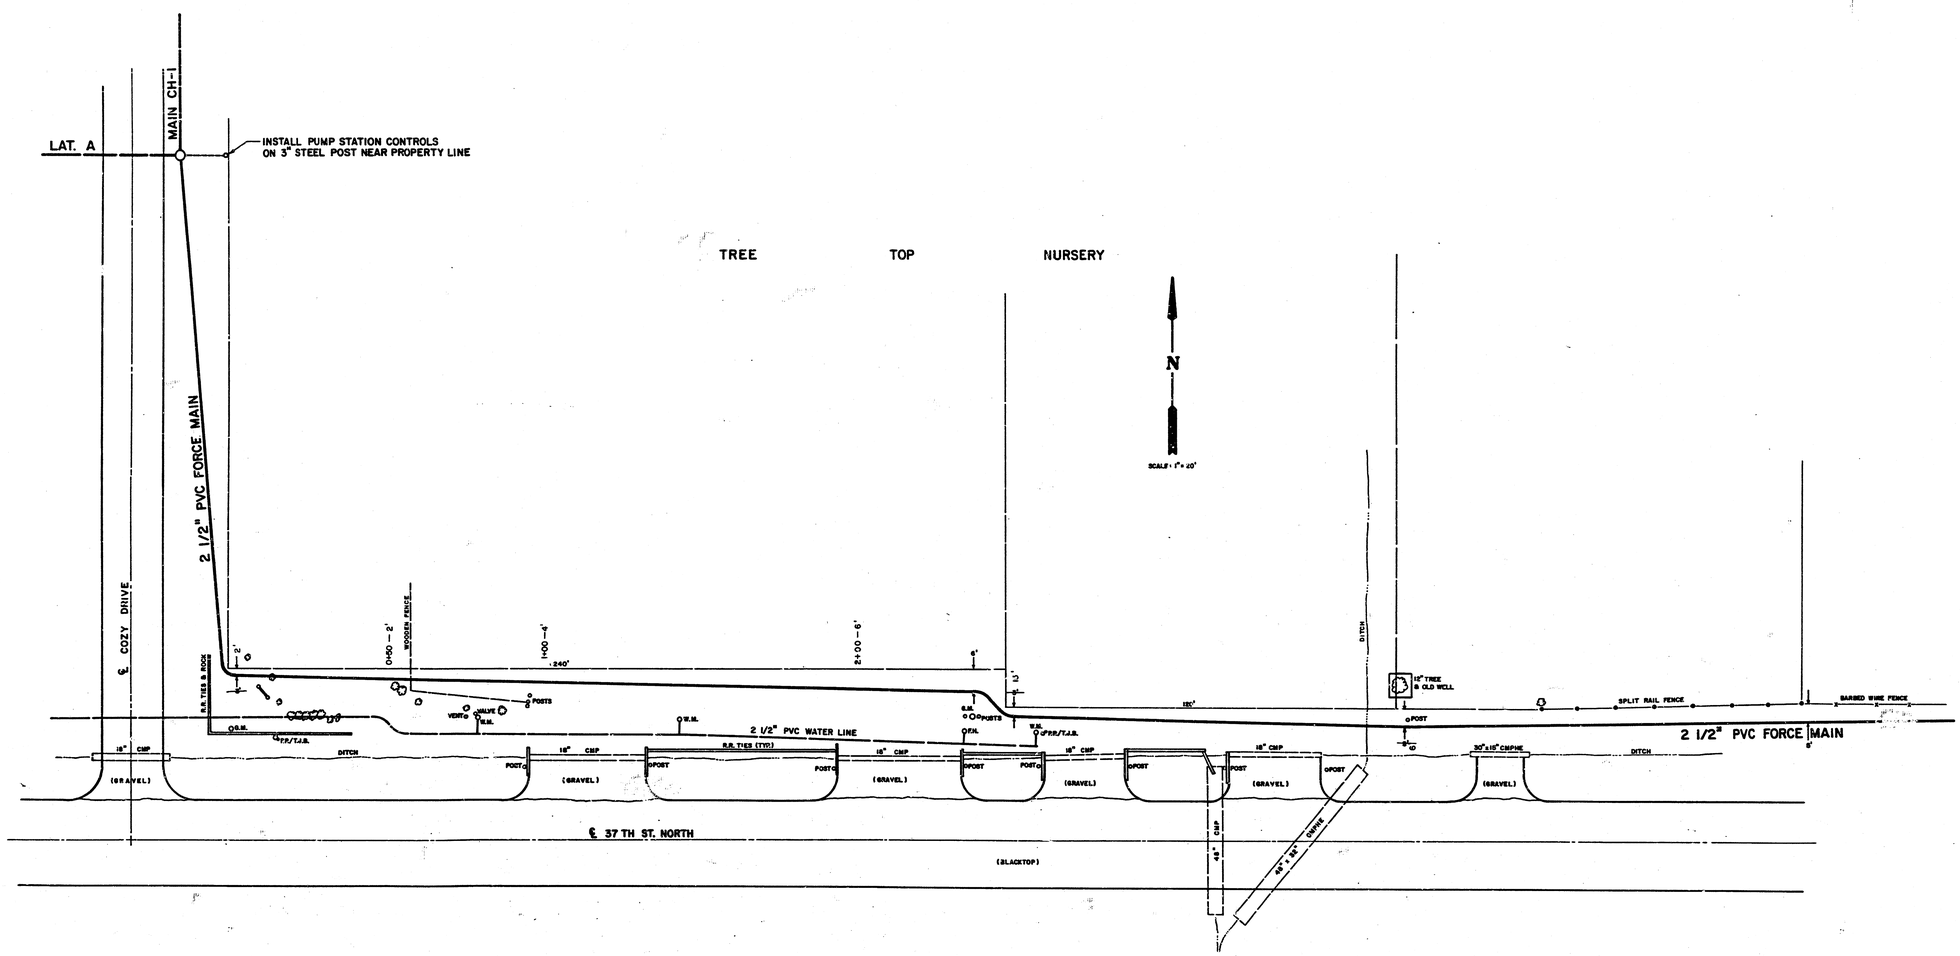

LEGEND

- W.M. —— WATER METER
- G.M. —— GAS METER
- P.P. —— POWER POLE
- T.J.B. —— TELEPHONE JUNCTION BOX
- F.H. —— FIRE HYDRANT
- ○ —— TREE OR BUSH

NOTE: CONTRACTOR SHALL REMOVE ALL CONSTRUCTION EQUIPMENT FROM PARKING AREA ON WEEKENDS.

REISS & GOODNESS ENGINEERS
2160 WEST 21ST STREET
WICHITA, KANSAS 67203
(316) 832-0223

3/4

REVISION	DRAWN BY	CHECKED BY	DESIGNED BY	PROJECT	CUSTOMER	SCALE	PROJECT NO.
2-10-88	DEJ		C G	SANITARY SEWER SYSTEM	BEL AIRE-COZY HOMES ADD.	1"=20'	SE0987
REVISED 2/10/88						DATE 1-29-88	SHEET 3 OF 6

FILMED FROM THE BEST AVAILABLE COPY

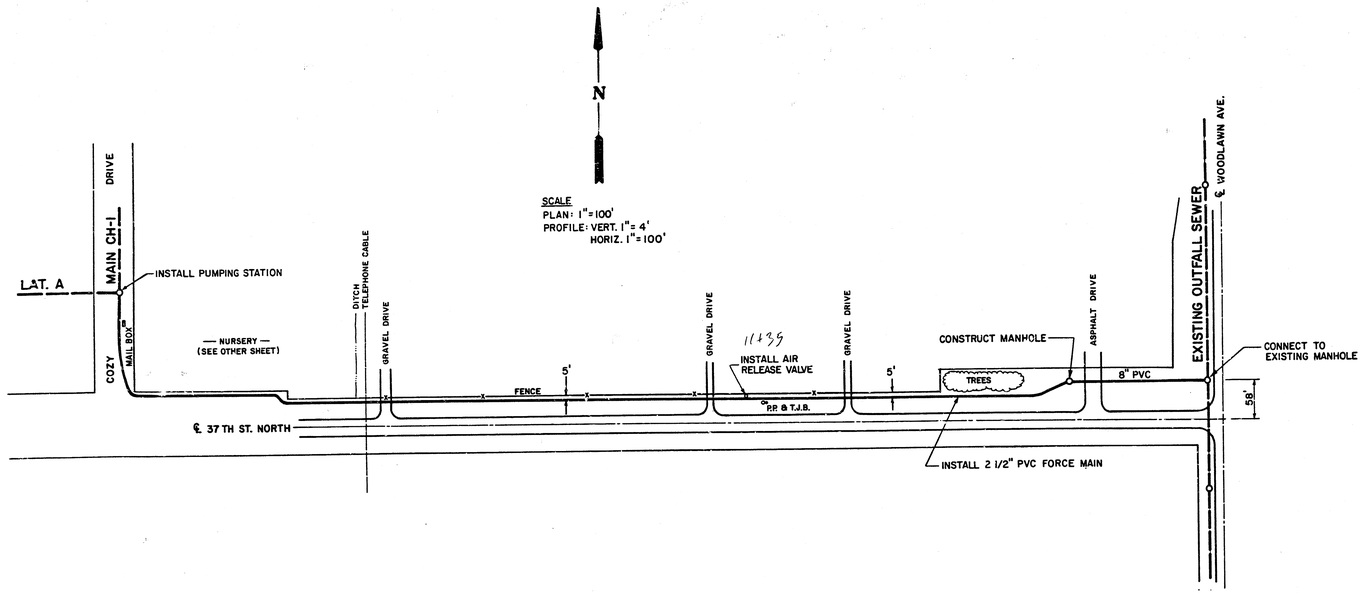

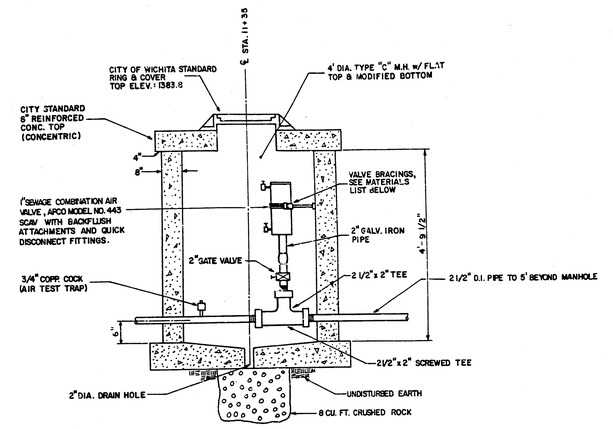

SECTIONAL ELEVATION
AIR RELEASE MANHOLE

VALVE BRACING MATERIALS

1 - DUCTILE IRON, DBL.: STRAP SERVICE SADDLE, CASCO. CAT. CDS2, 3/4" I.P. TOP
1 - 3/4" IRON PIPE NIPPLE - LENGTH TO FIT
1 - MALLEABLE IRON CEILING/FLOOR FLANGE, 3/4" I.P. THREADED. ANCHOR TO CONCRETE MH WALL W/4-#14 SCREWS & 1/4" x SHORT LAG SHIELDS

(FORCE MAIN)

REISS & GOODNESS ENGINEERS
2160 WEST 21ST STREET
WICHITA, KANSAS 67204
(316) 832-0213

4/4

REVISION		DRAWN BY		CHECKED BY	DESIGNED BY	PROJECT
		DEJ			C.G.	

SANITARY SEWER SYSTEM

CUSTOMER

BEL AIRE-COZY HOMES ADD.

REVISED 2/10/88

SCALE NOTED	PROJECT NO. SEC0887.
DATE 1-29-88	SHEET 4 OF 6

FILMED FROM THE BEST AVAILABLE COPY....