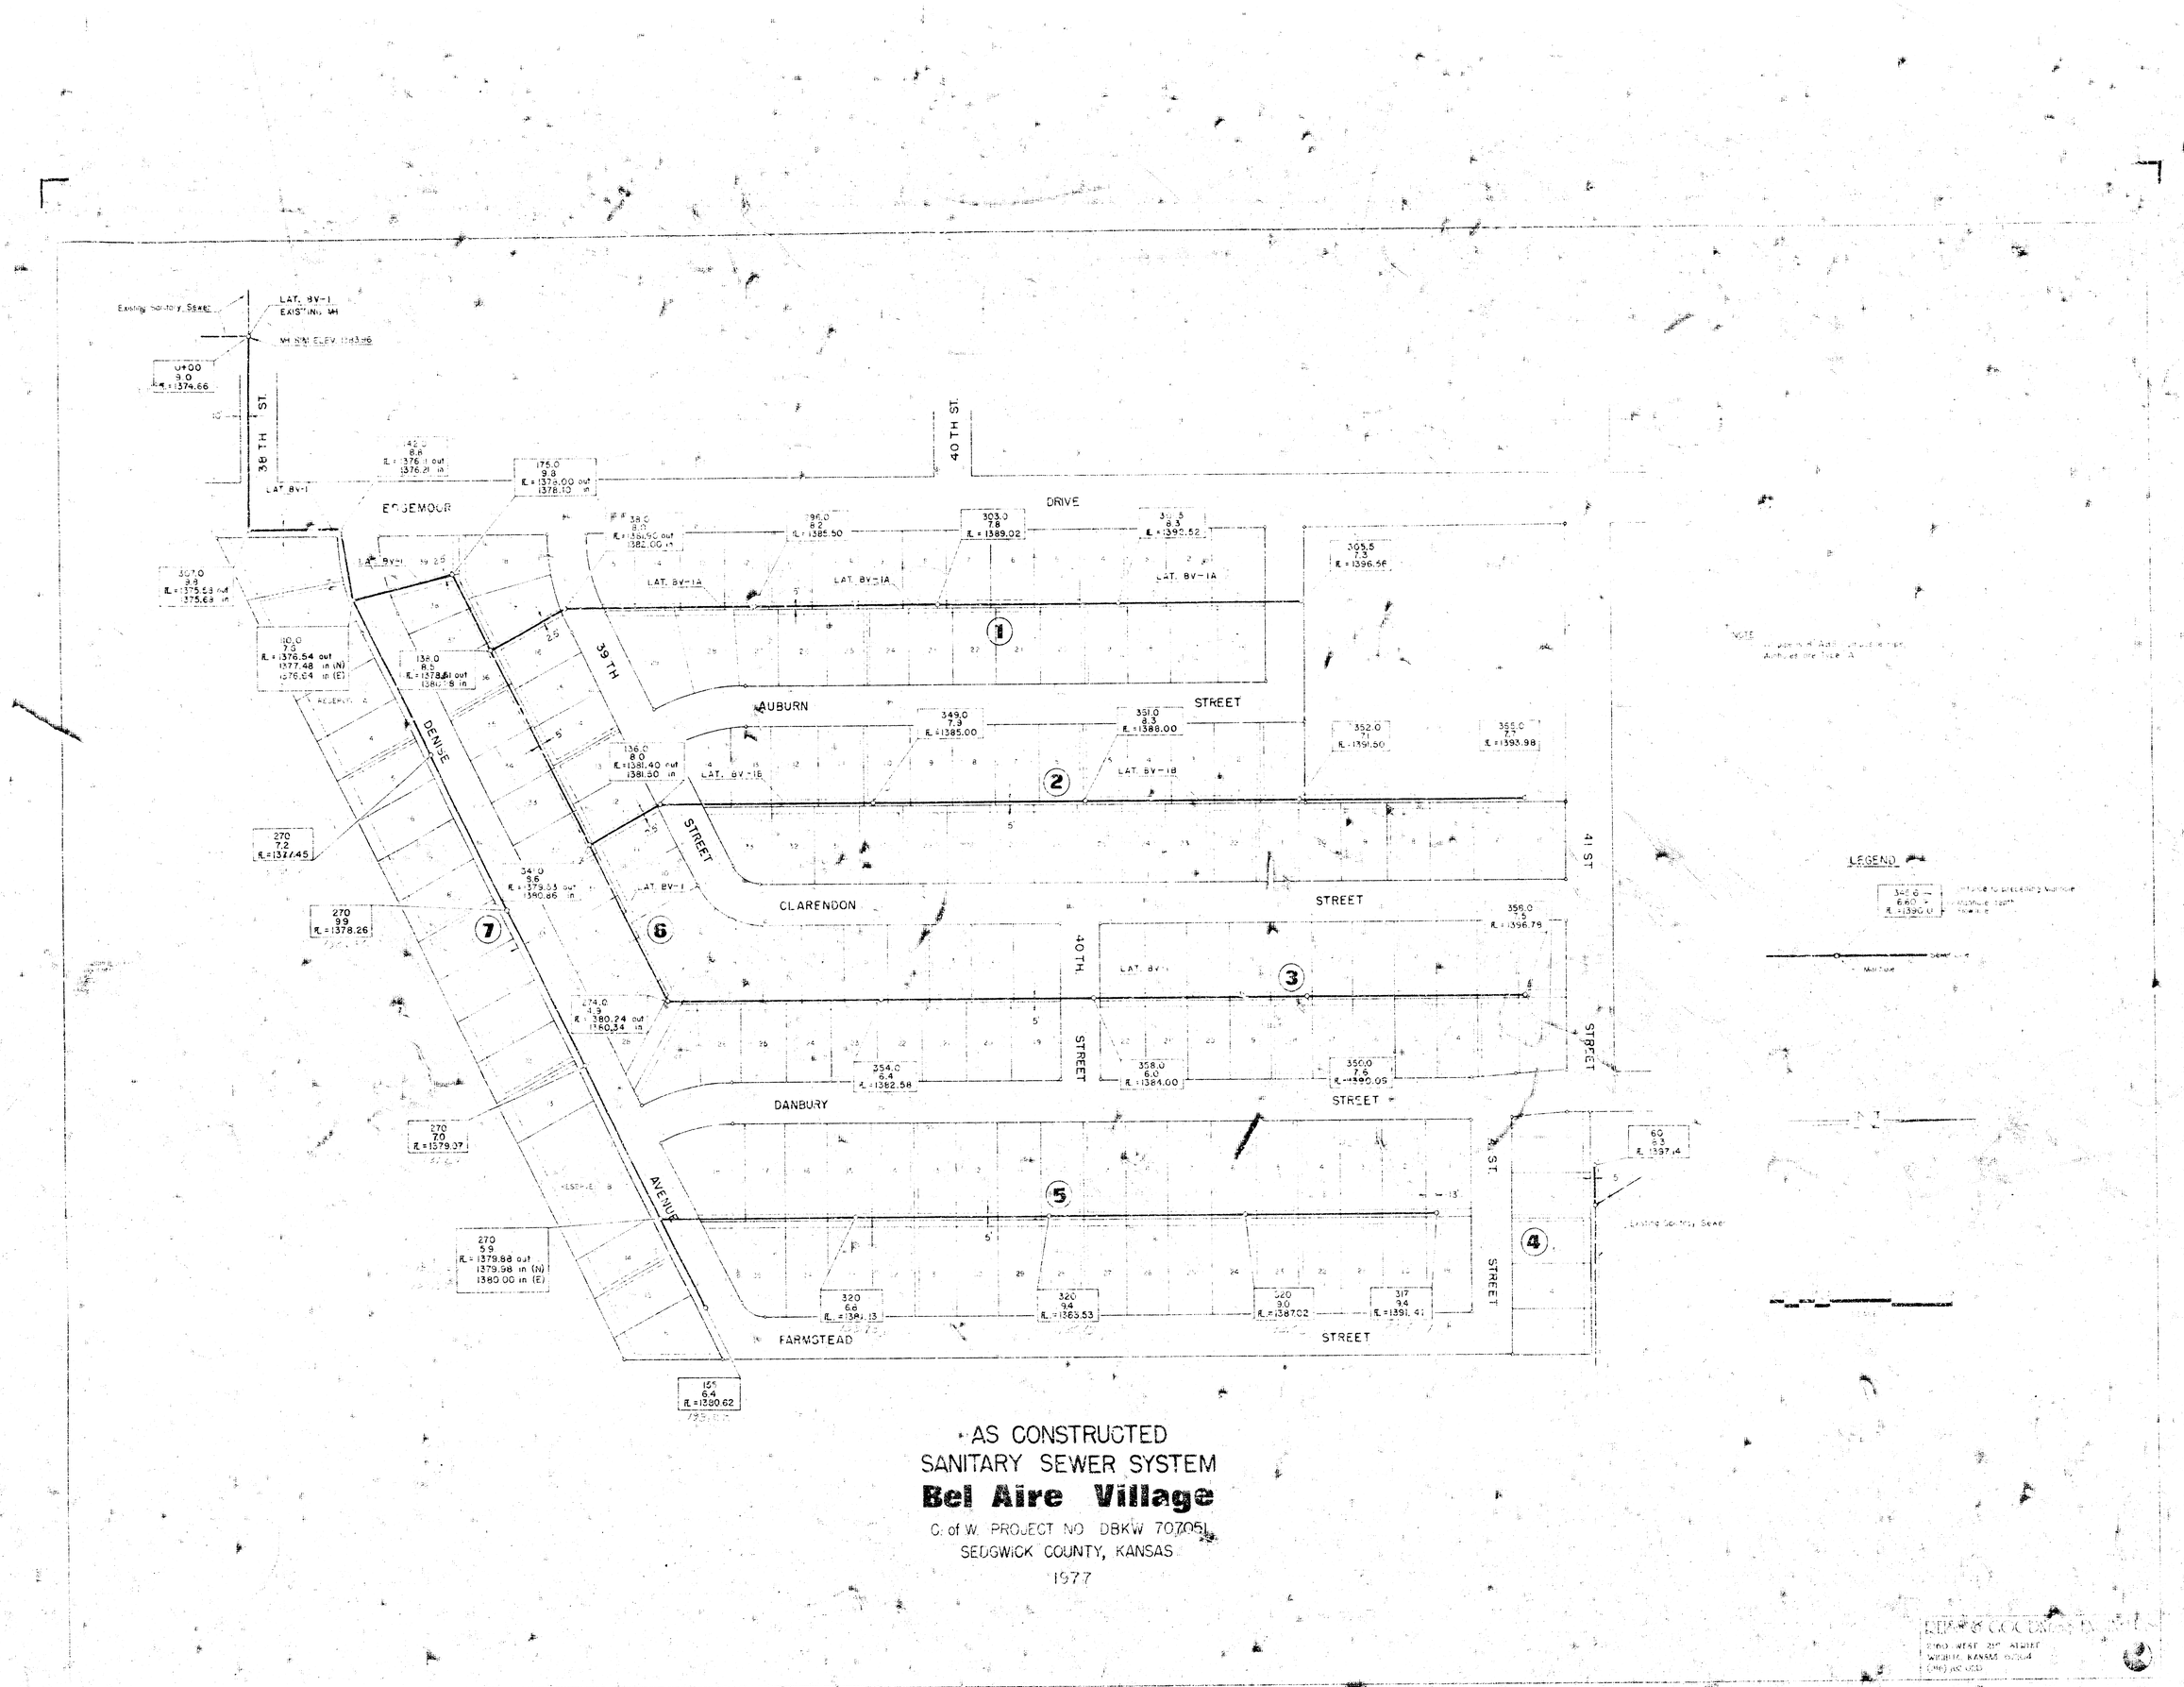
38 TH ST.
40 TH ST.
41 ST.
EDGEMOOR
DRIVE
39 TH
DENISE
AVENUE
AUBURN
STREET
CLARENDON
STREET
40 TH
STREET
DANBURY
STREET
FARMSTEAD
STREET
LEGEND
NOTE
N.T.
AS CONSTRUCTED
SANITARY SEWER SYSTEM
Bel Aire Village
C. of W. PROJECT NO DBKW 70705
SEDGWICK COUNTY, KANSAS
1977