PLANS

FOR

SANITARY SEWER EXTENSION

ARTHUR HEIGHTS ADDITION

BEL AIRE, KANSAS

1988

SE0688

CITY OF WICHITA PROJECT NO. 468-75-245-80001-000-000-181

APPROVED AS NOTED
By CITY ENGINEER OF WICHITA
Sanitary Sewers GJB 9/22/88
Storm Sewers _____
Driveway Approaches _____
Water Mains _____
Paving _____

NOTE TO CONTRACTOR

INSPECTION AND TESTING FOR THIS PROJECT IS TO BE PROVIDED BY A LICENSED CONSULTING ENGINEERING FIRM UNDER CONTRACT WITH THE OWNER/DEVELOPER. SAID INSPECTION TO BE IN ACCORDANCE WITH THE CITY OF WICHITA STANDARD CONSTRUCTION ENGINEERING PRACTICES AND CERTIFIED BY A LICENSED PROFESSIONAL ENGINEER. NO WORK SHALL BE PERFORMED IN DEDICATED EASEMENTS OR THE PUBLIC RIGHT-OF-WAY BY THE CONTRACTOR WITHOUT SUCH INSPECTION NOR SHALL ANY WORK BE COMMENCED IN DEDICATED EASEMENTS OR PUBLIC RIGHT-OF-WAY WITHOUT WRITTEN AUTHORIZATION BY THE CITY ENGINEER.

NOTE TO CONTRACTOR

INSPECTION AND TESTING FOR THIS PROJECT IS TO BE PROVIDED BY A LICENSED CONSULTING ENGINEERING FIRM UNDER CONTRACT WITH THE OWNER/DEVELOPER. SAID INSPECTION TO BE IN ACCORDANCE WITH THE CITY OF WICHITA STANDARD CONSTRUCTION ENGINEERING PRACTICES AND CERTIFIED BY A LICENSED PROFESSIONAL ENGINEER. NO WORK SHALL BE PERFORMED IN DEDICATED EASEMENTS OR THE PUBLIC RIGHT-OF-WAY BY THE CONTRACTOR WITHOUT SUCH INSPECTION NOR SHALL ANY WORK BE COMMENCED IN DEDICATED EASEMENTS OR PUBLIC RIGHT-OF-WAY WITHOUT WRITTEN AUTHORIZATION BY THE CITY ENGINEER.

AS BUILT

CHARLES M. GOODNESS LICENSED KANSAS PROFESSIONAL ENGINEER
Charles M. Goodness 9/23/88

REV. 9-23-88

REISS & GOODNESS ENGINEERS
2160 WEST 21ST STREET
WICHITA, KANSAS 67203
(316) 832-0213

REVISION		DRAWN BY		CHECKED BY	DESIGNED BY

DATE 8-18-88

PROJECT NO SE0688

SHEET 1 OF 7

1/3

FILMED FROM THE BEST AVAILABLE COPY

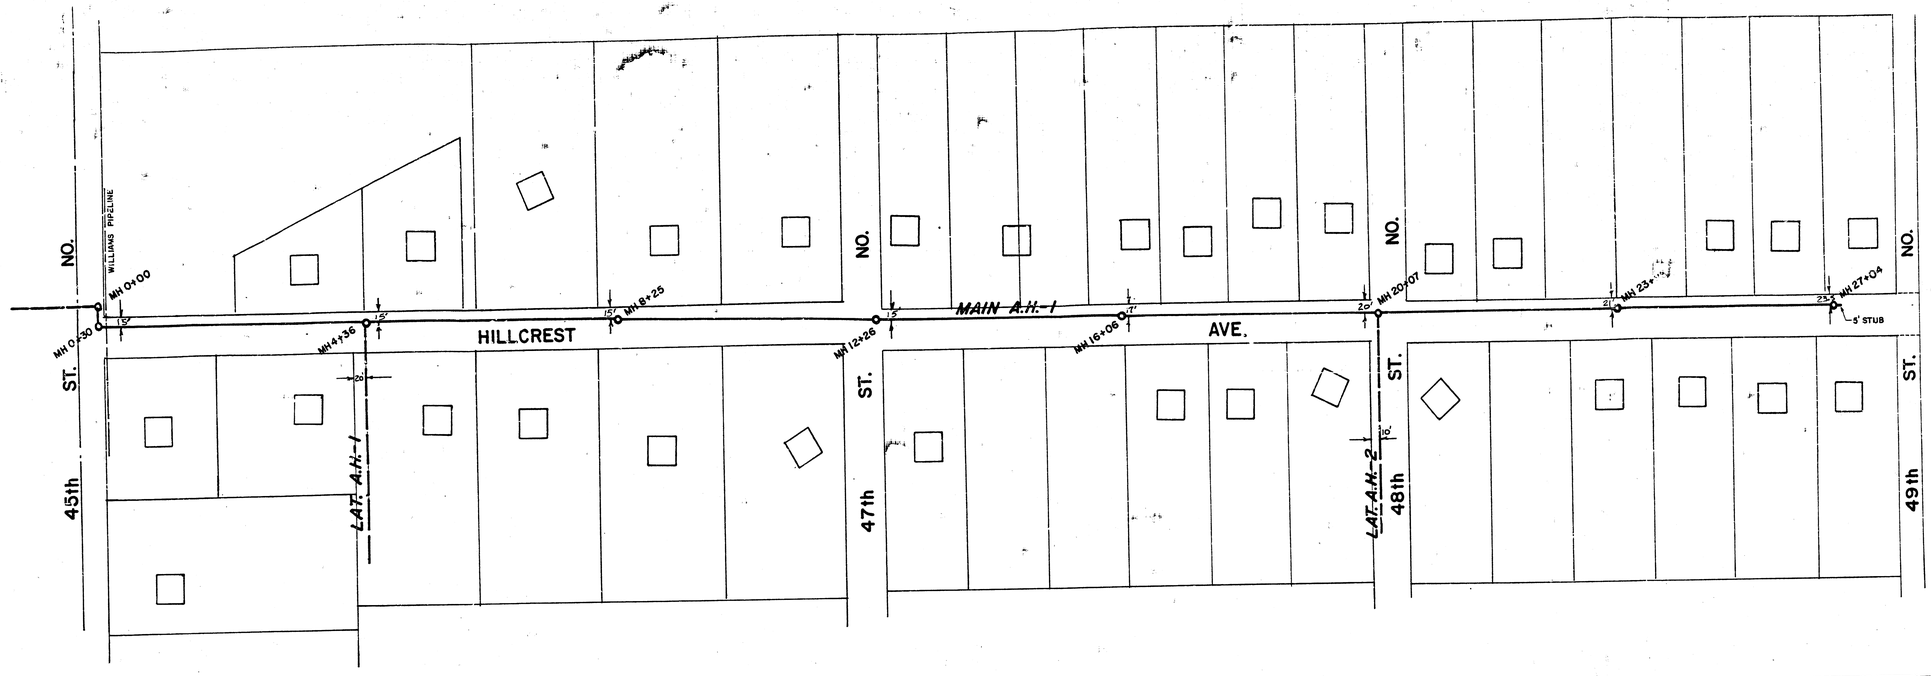

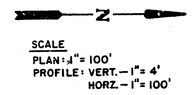

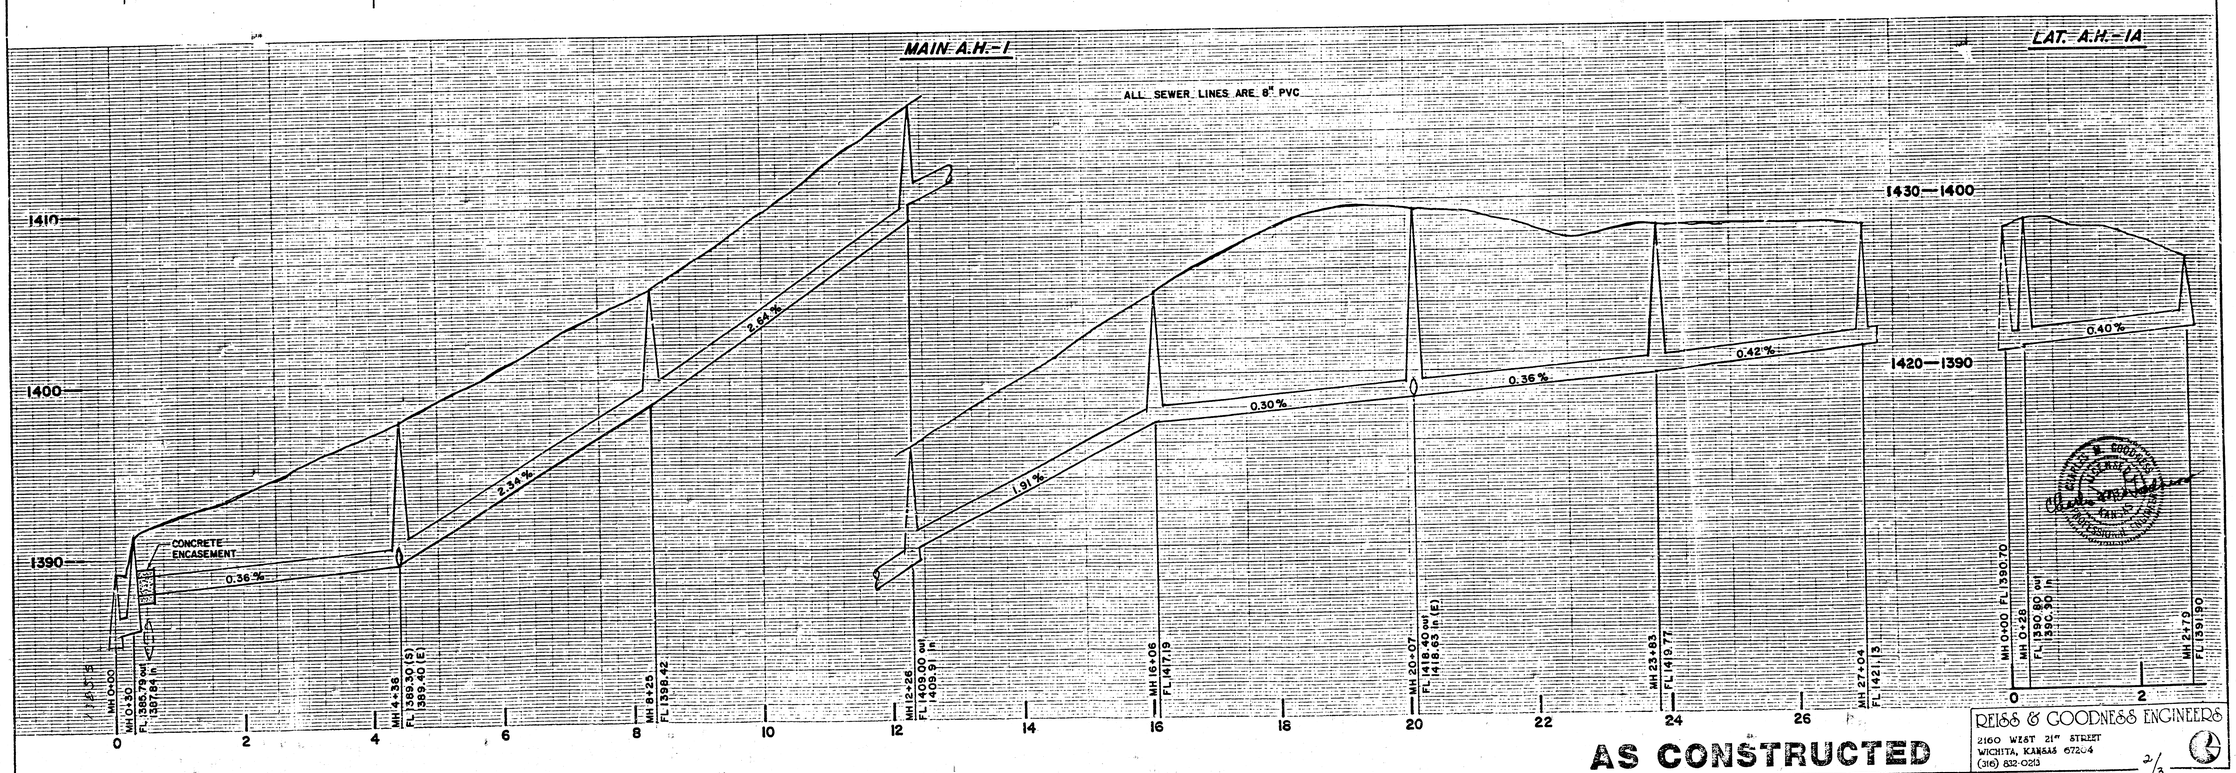

REISS & GOODNESS ENGINEERS
2160 WEST 21ST STREET
WICHITA, KANSAS 67204
(316) 832-0213

2/3

AS CONSTRUCTED

REVISION		DRAWN BY	CHECKED BY	DESIGNED BY	PROJECT
		CG DEJ	CG	CG	SANITARY SEWER EXTENSION

CUSTOMER: ARTHUR HEIGHTS ADD.-BEL AIRE, KANSAS

SCALE	NOTED	PROJECT NO.	SE0-88
DATE	1-3-89	SHEET	2 OF 3

FILMED FROM THE BEST AVAILABLE COPY

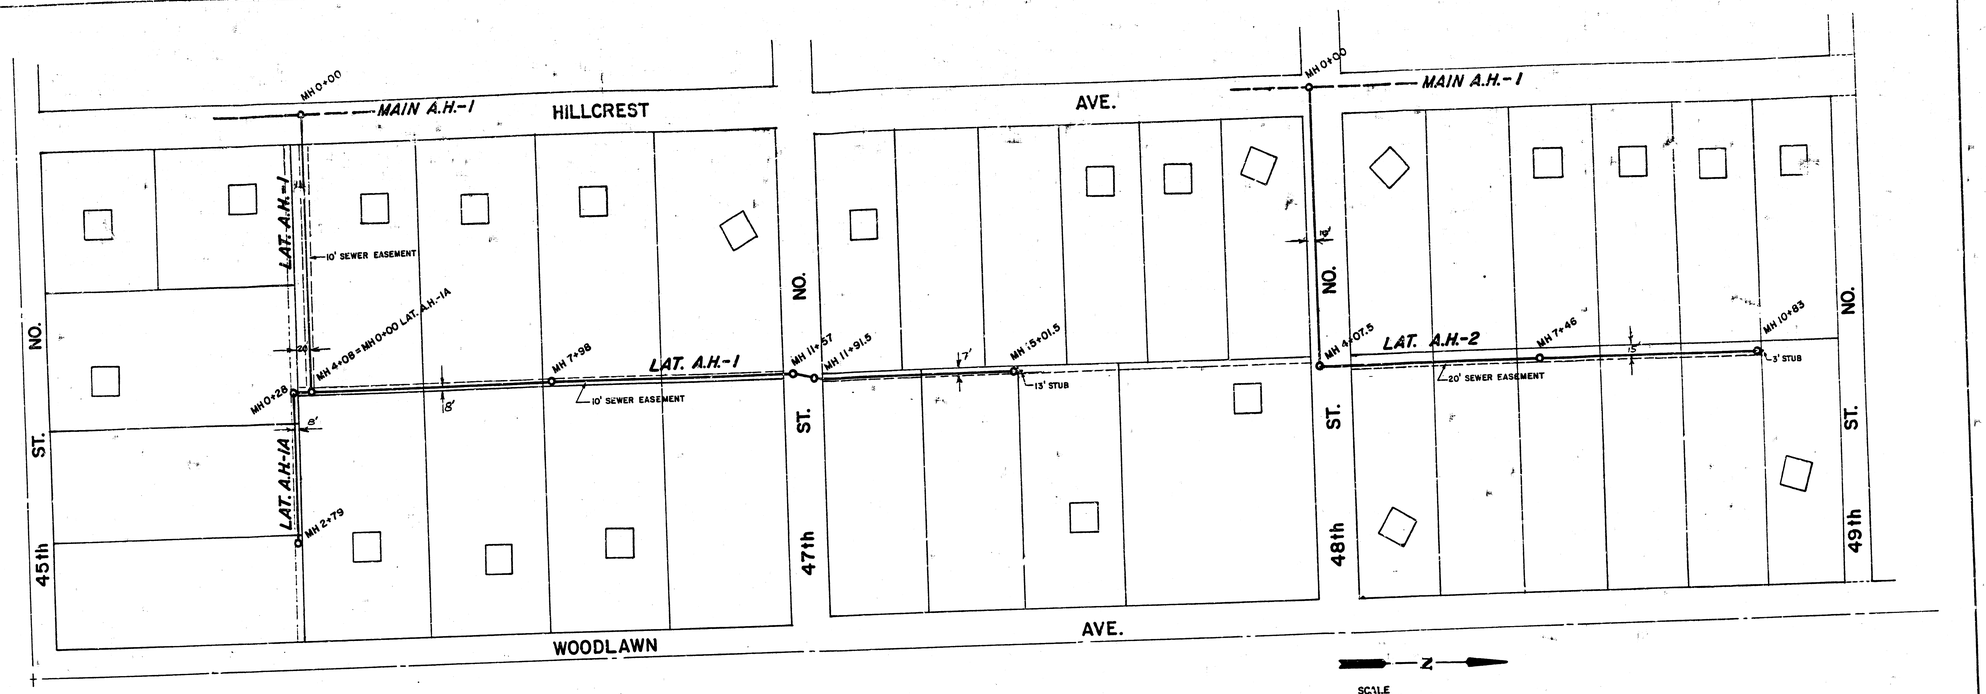

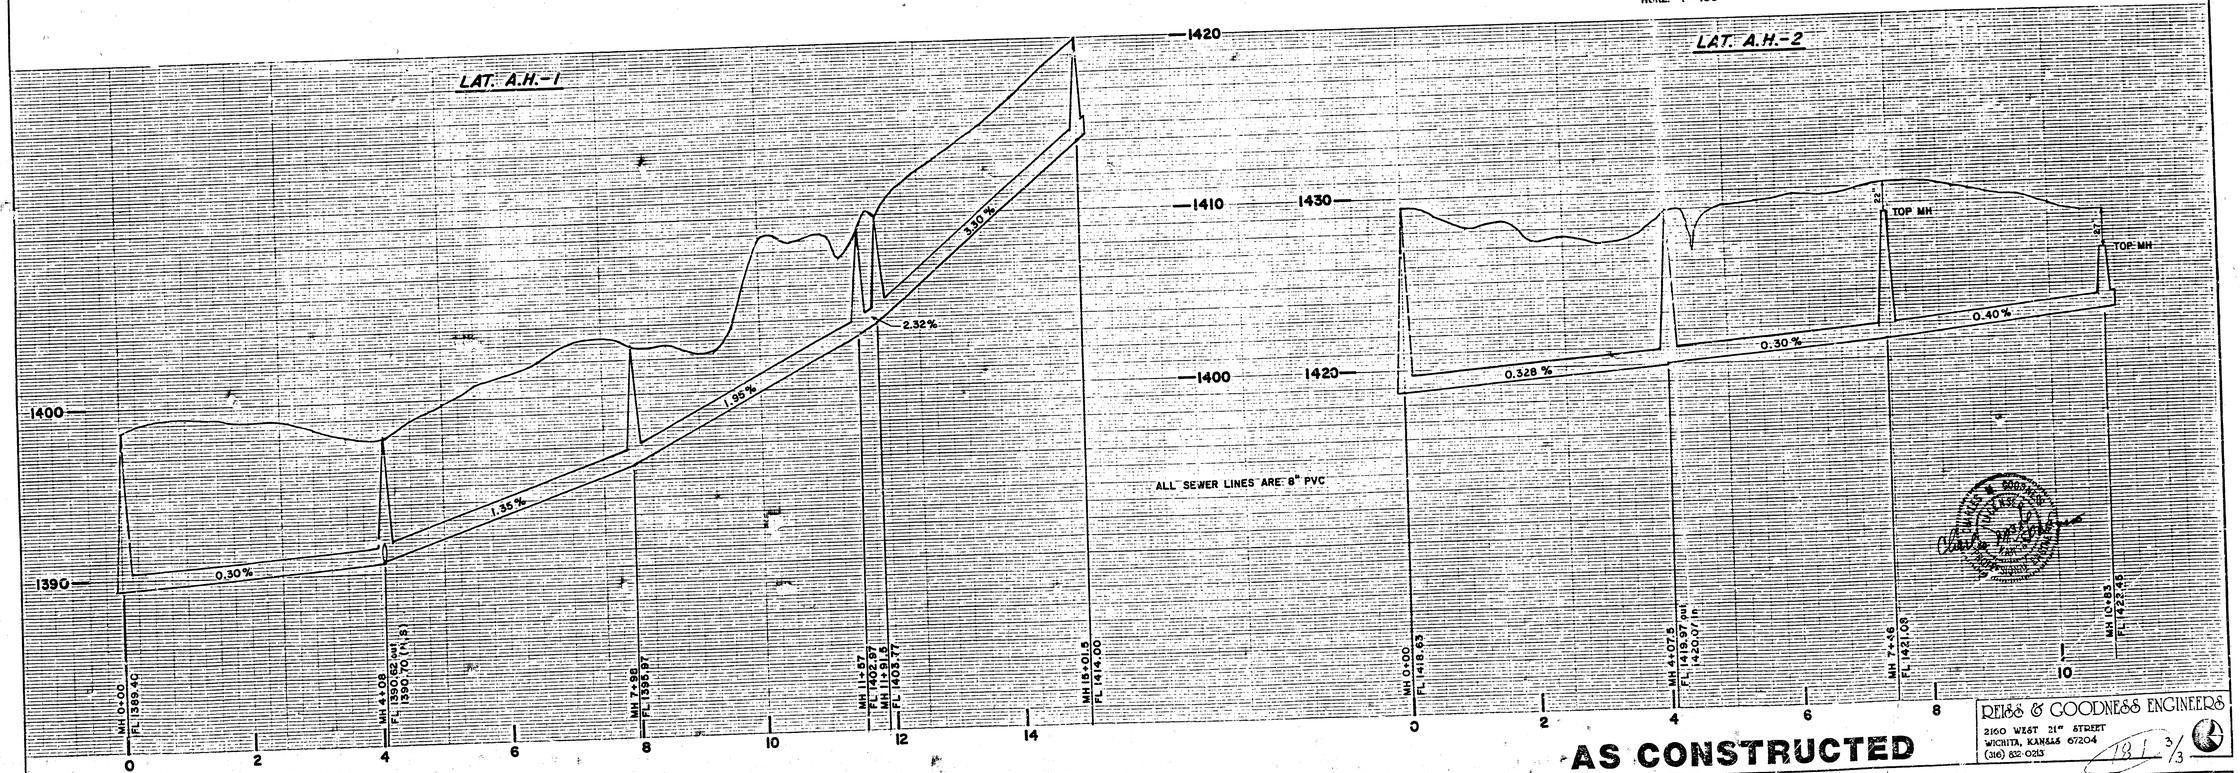

AS CONSTRUCTED

REES & GOODNESS ENGINEERS
2160 WEST 21st STREET
WICHITA, KANSAS 67204
(316) 832-0213

REVISION		DRAWN BY		CHECKED BY	DESIGNED BY	PROJECT
		C G		C G	C G	SANITARY SEWER EXTENSION
		DEJ				

CUSTOMER: ARTHUR HEIGHTS ADD.-BEL AIRE, KANSAS

SCALE NOTED	PROJECT NO. SE 0662
DATE 1-3-89	SHEET 3 OF 3

FILMED FROM THE BEST AVAILABLE COPY