NOTE TO CONTRACTOR

THIS PROJECT WILL BE CONSTRUCTED UNDER THE SUPERVISION OF THE CITY ENGINEER & CONFORMING TO THE SPECIFICATIONS OF THE CITY OF WICHITA. THE CONTRACTOR WILL REIMBURSE THE CITY OF WICHITA FOR ALL COST OF INSPECTION.

NOTE TO CONTRACTOR
This project will be constructed under the supervision of the CITY ENGINEER and conforming to the SPECIFICATIONS of the CITY OF WICHITA. The CONTRACTOR will reimburse the City of Wichita for all cost of engineering inspection.

12-2-80
APPROVED AS NOTED
By CITY ENGINEER OF WICHITA
Sanitary Sewers
Storm Sewers
Driveway Approaches

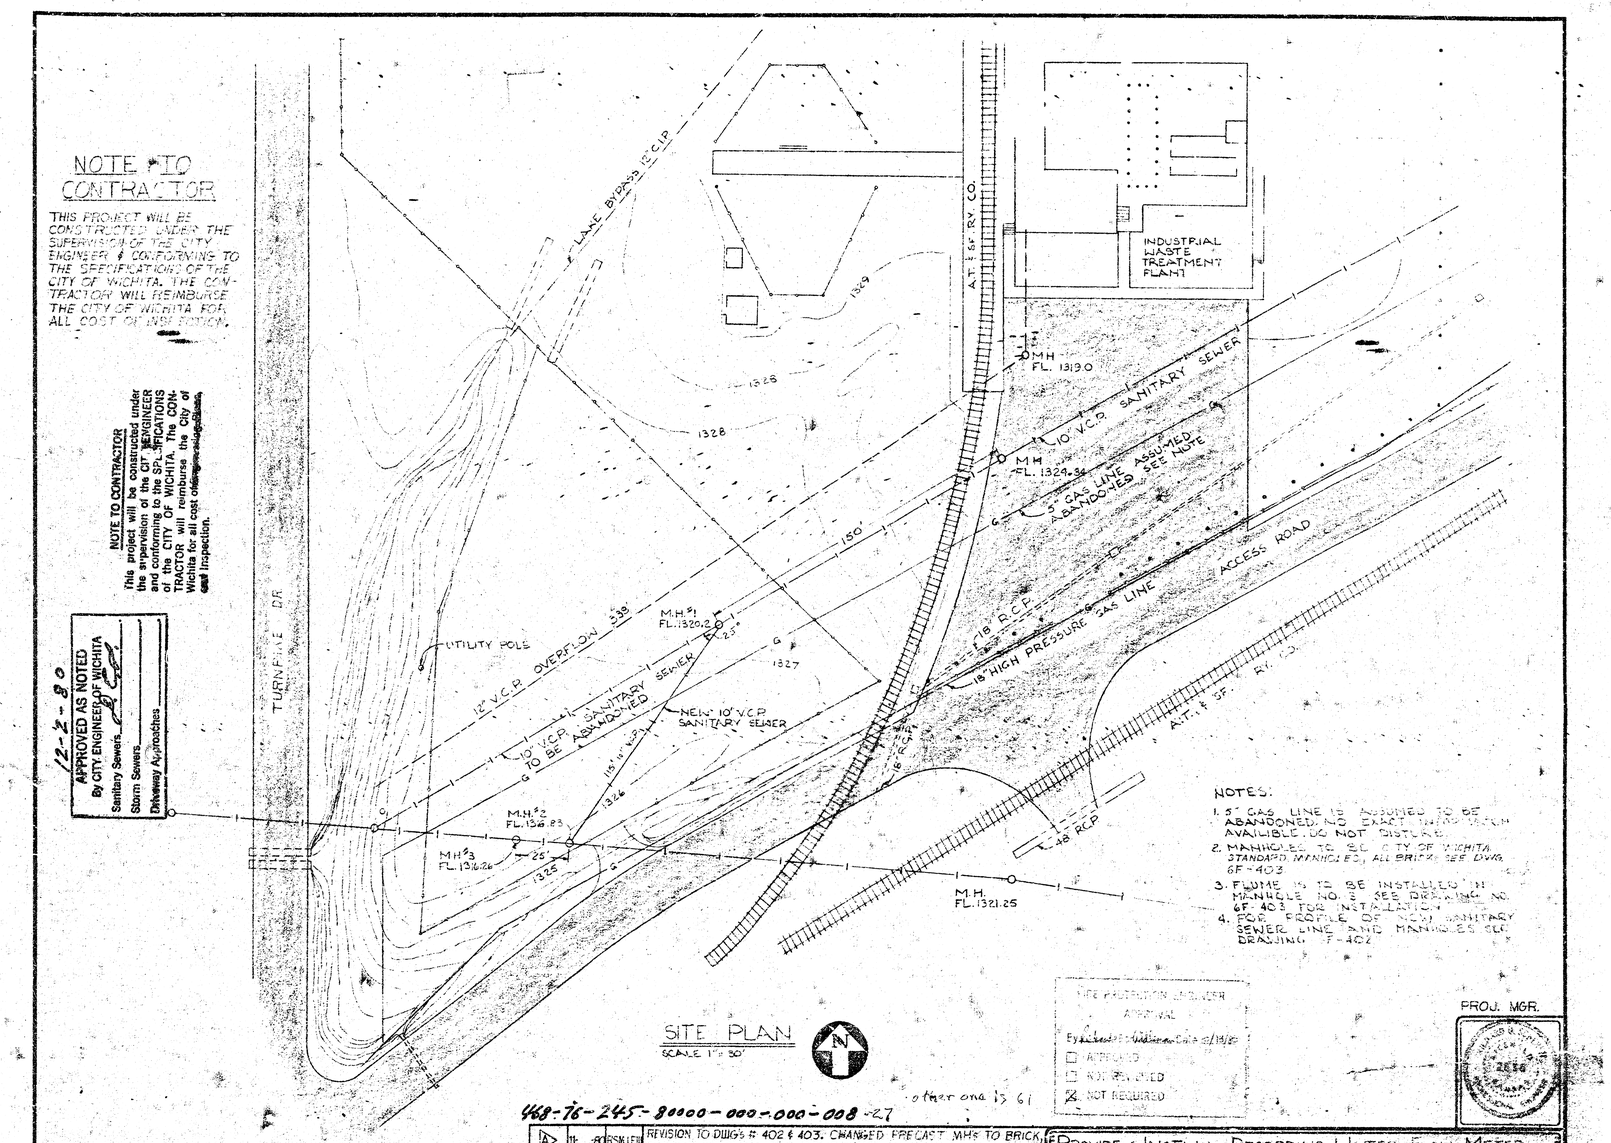

SITE PLAN
SCALE 1" = 50'

By _____ Date 12/19/80
☐ APPROVED
☐ NOT APPROVED
☒ NOT REQUIRED

PROJ. MGR.

468-76-245-80000-000-000-008-27

other one is 61

REV.	DATE	BY	DESCRIPTION
A	11-80	RSM/LEW	REVISION TO DWG'S # 402 & 403. CHANGED PRECAST MH'S TO BRICK, CHANGED INV. @ M.H.#2 ON NEW 10" V.C.P. ADDED NOTES

CITY PROJ. # 468-76-245-80000-000-000-008.

PROVIDE & INSTALL RECORDING WATER FLOW METER

DRAWN	S. MORTS	10-30-80	BOEING FACILITIES ENGINEERING
CHECKED	P.K. WARE JR.	10-30-80	GF-401 GT-2934
MGR. LIAISON		11-26-80	1/4

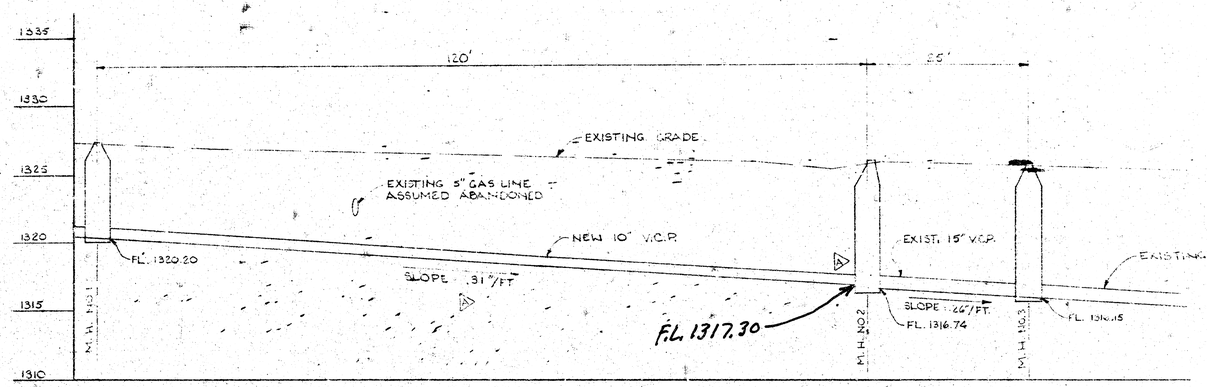

PROFILE - MANHOLE #1 THRU #3

HORIZ. SCALE 1" = 10'
VERT. SCALE 1" = 2'

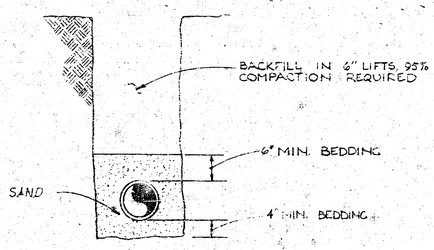

TYPICAL TRENCH DETAIL

NO SCALE

NOTES

1. FOR LOCATION AND LAYOUT PLAN OF SANITARY SEWER AND MANHOLES SEE DWG. 6F-401
2. FOR MANHOLE DETAILS SEE DWG. 6F-403
3. NEW SANITARY SEWER BETWEEN MANHOLE NO. 1 AND MANHOLE NO. 2 IS TO BE 10" V.C.P.
4. TOP OF NEW 10" VCP TO MATCH TOP OF EXISTING 15" S.S. @ MH. NO. 2

FILE FOR RECORD ONLY
APPROVED
BY _____
☐ NOT APPROVED
☐ NOT REQUIRED
☒ NOT REQUIRED

PROJ. MGR.

REV.	BY	DATE	DESCRIPTION
B	RCM	11/13/80	REVISED SLOPE OF NEW 10" V.C.P.

PROVIDE & INSTALL RECORDING WATER FLOW METER

DRWN E. MORTS 6-6-80
AND P.K. HARRIS 6-10-80

BOEING FACILITIES ENGINEERING

6F-407-4
69-3334

2/4

FILMED FROM THE BEST COPY OBTAINABLE

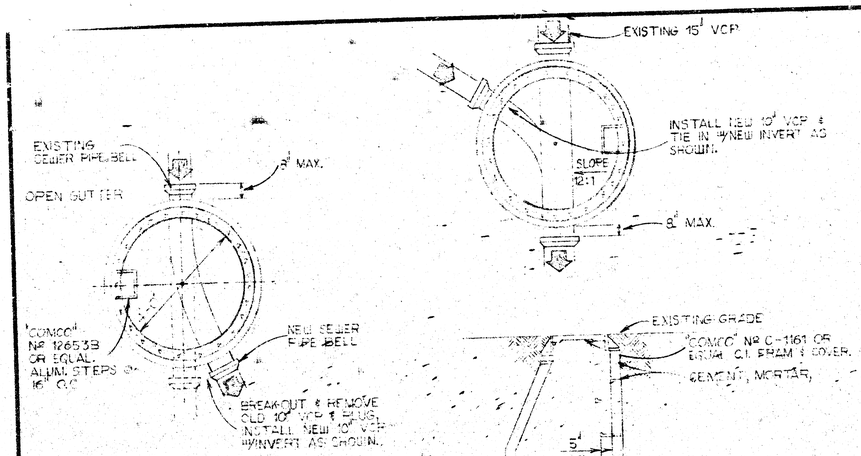

DETAIL MH # 1

DETAIL MH # 2

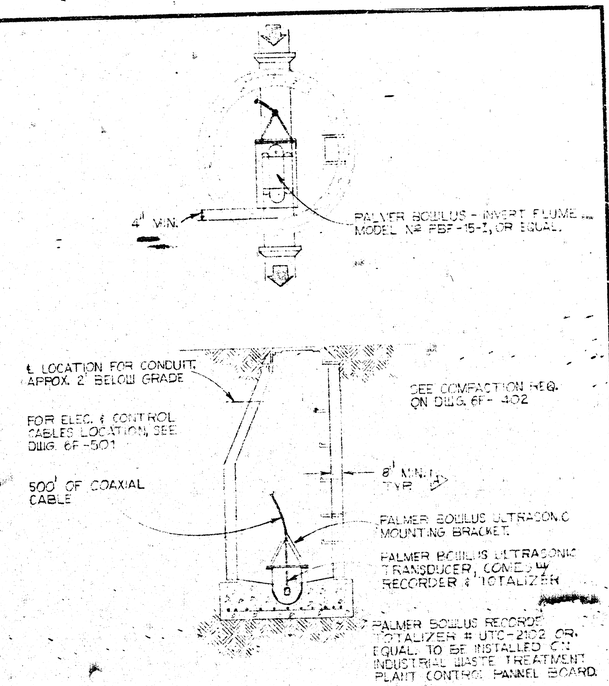

DETAIL MH # 3

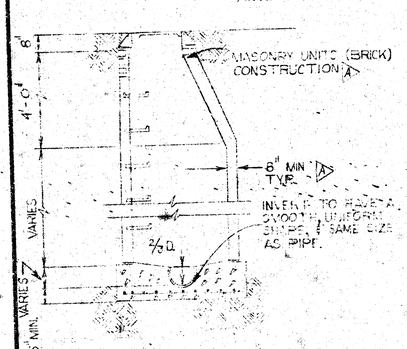

DETAIL MH # 1

NOTES:

1. ALL MANHOLES TO BE STD. 4' DIA., HEIGHTS TO BE FIGURED FROM DWG. 6F-401
2. ALL MANHOLE TOPS TO BE FLUSH WITH FINISH GRADE
3. FOR LOCATION OF MANHOLES SEE DWG. 6F-401
4. ALL MANHOLES TYP. EXCEPT INVERTS & HEIGHTS
5. NEW LINE TO BE FILLED WITH WATER, FOR LEAKAGE TEST IN ACCORDANCE WITH N.P.C.
6. ALL MANHOLES TO BE CONSTRUCTED OF BRICK & MUST BE WATER TIGHT WITHOUT LEAKS.
7. NEW 10" LINE MUST BE AIR TESTED & TELEVISED BY CITY PERSONNEL.

MANHOLE DETAILS

3/8" = 1'-0"

PROJ. MGR.

REV.	DATE	BY	DESCRIPTION
A	11-80	LEW	Changed PreCast MHs to BRICK & NOTES #6 & 7

PROVIDE & INSTALL A RECORDING WATER FLOW METER

DRAWN L.E. NELSON 10-1980
CHK'D T.K. WARD 10.10.80
APPD. L. BAXTER 11-24-80

THE BOEING COMPANY FACILITIES ENGINEERING

6F-402-4
69 03-45

3/4

FILMED FROM THE BEST AVAILABLE COPY....

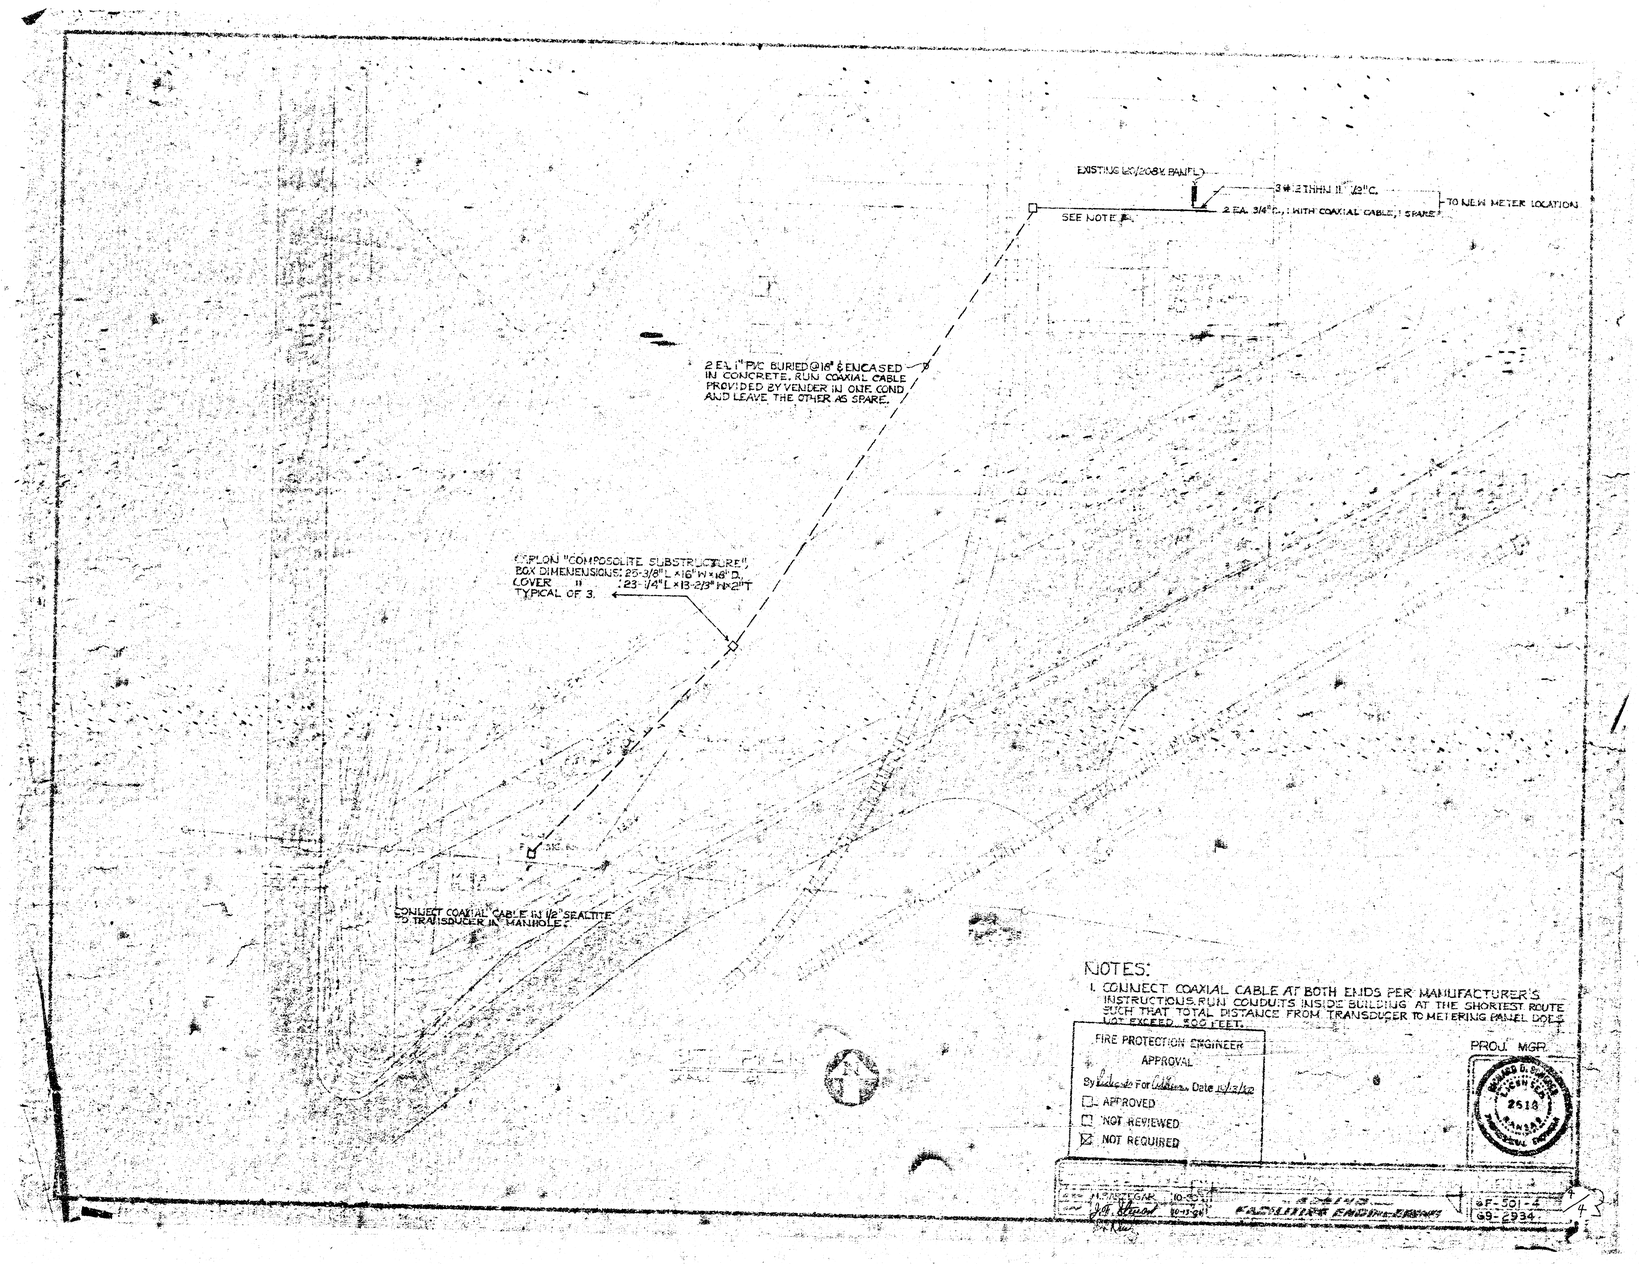

FILMED FROM THE BEST