


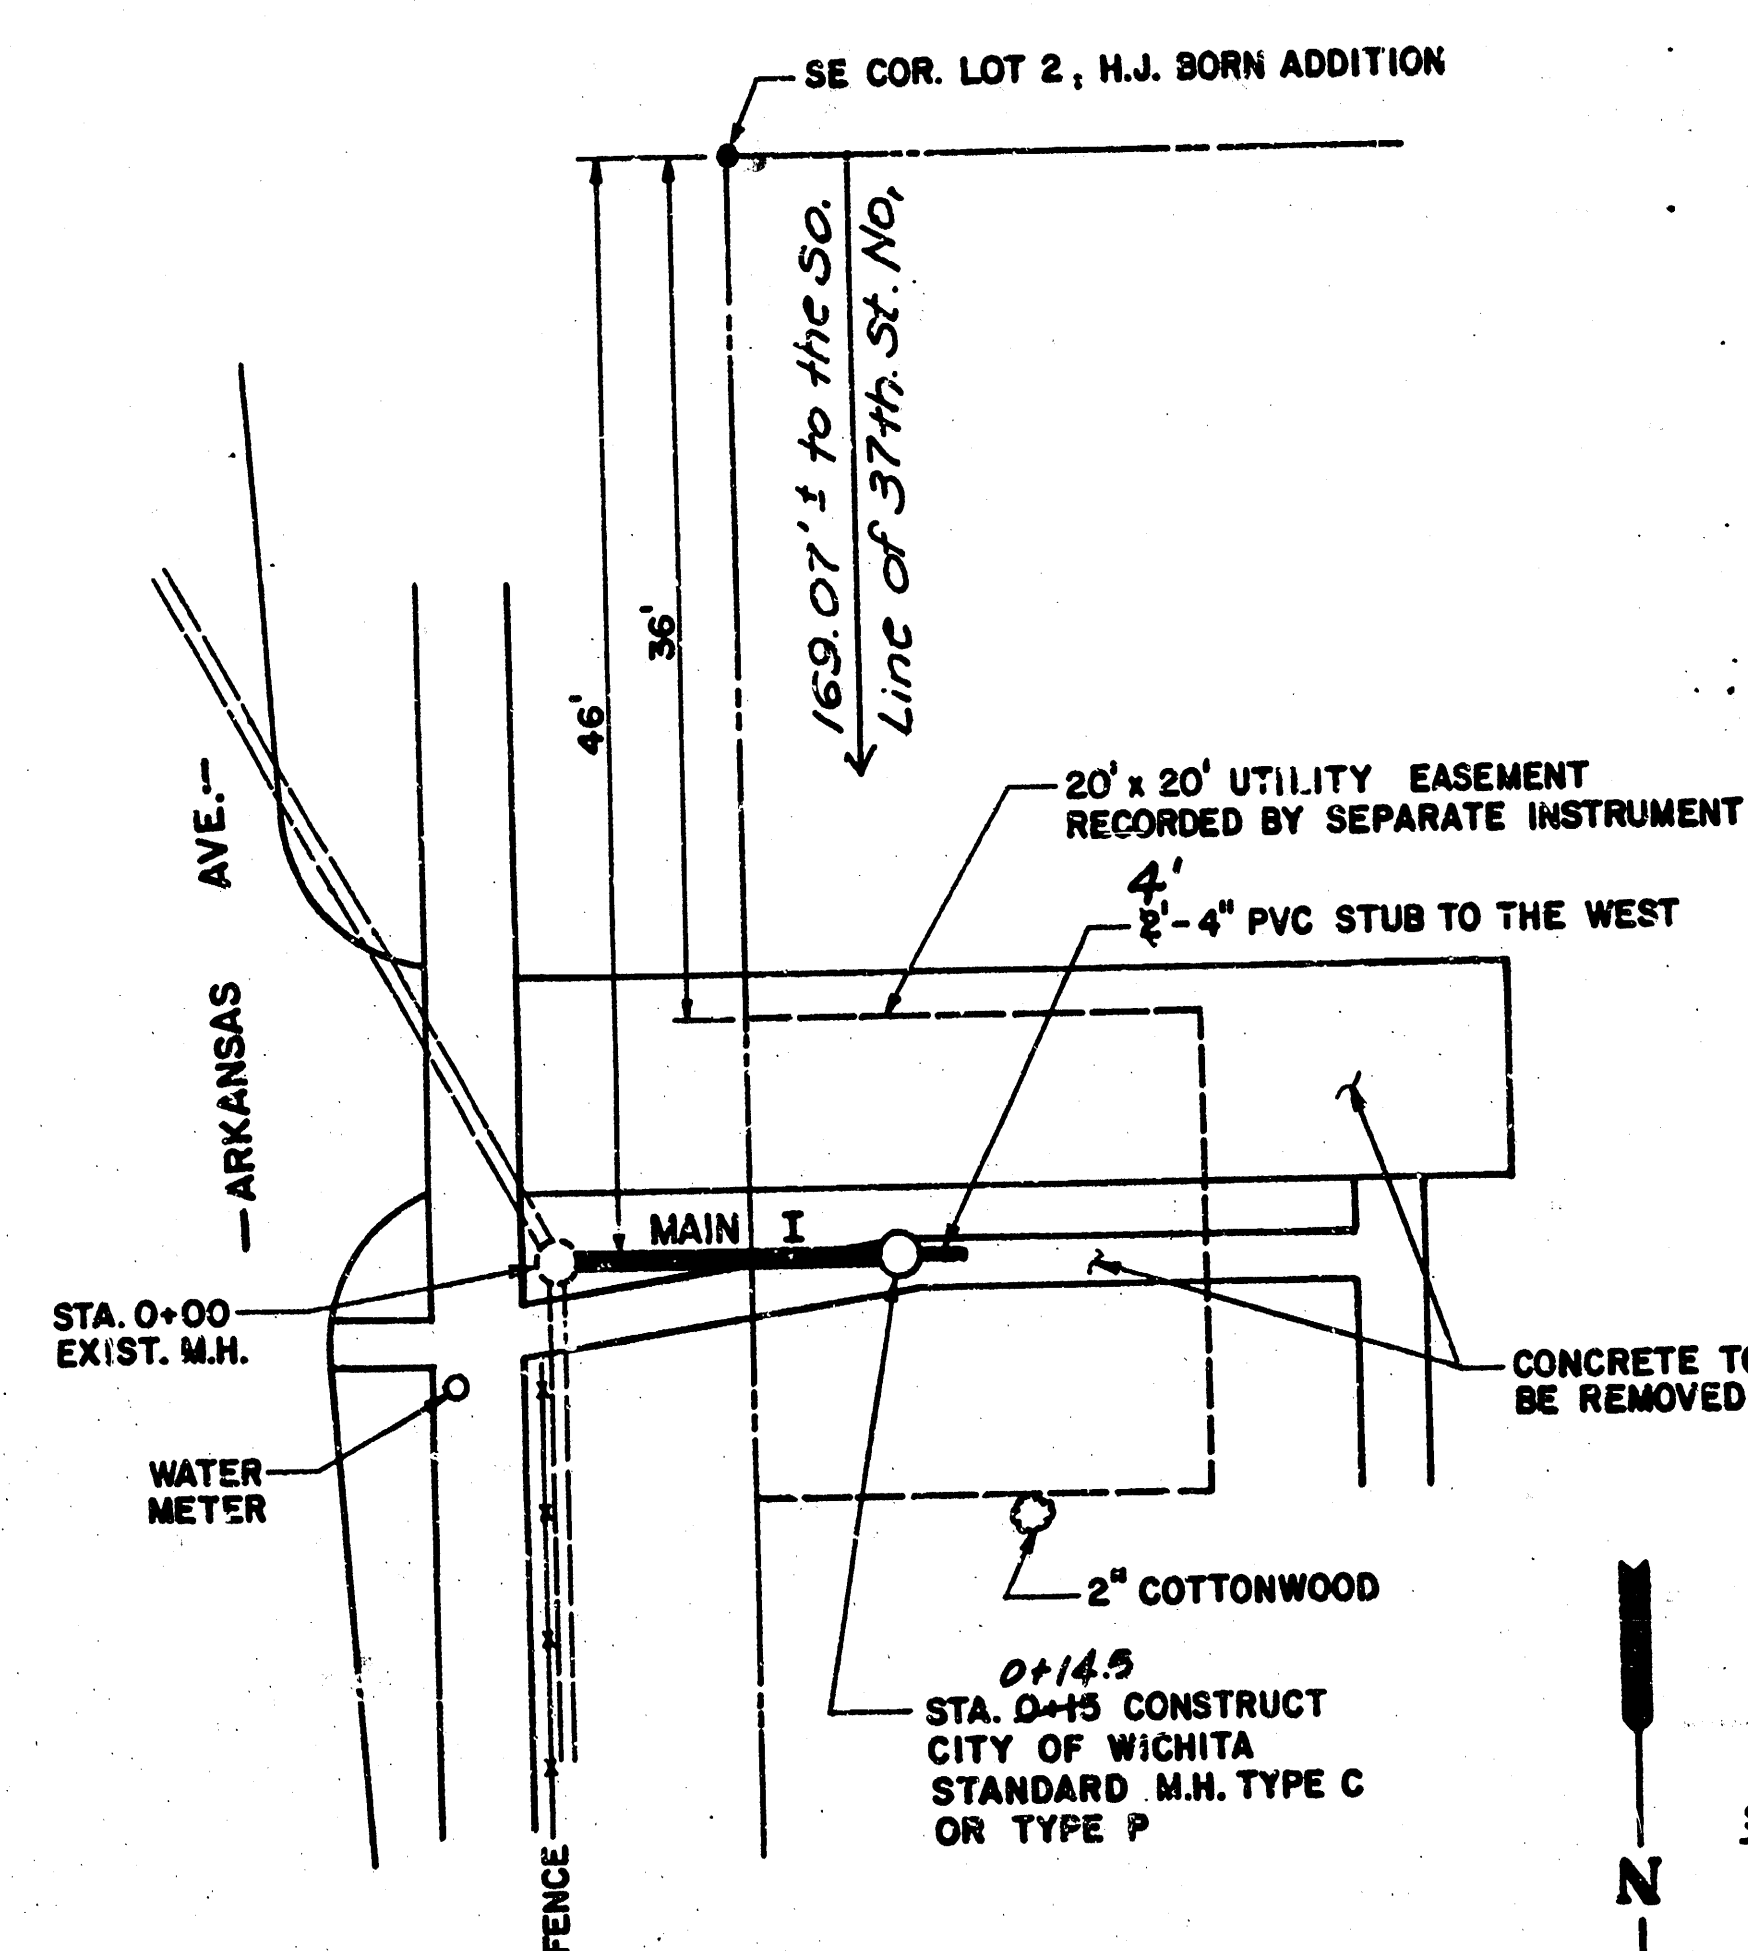


PLANS FOR SANITARY SEWER SYSTEM FOR

E. 150' OF LOT 2 EXCEPT S. 0.19' THEREOF
H.J. BOHN ADD.
SEDGWICK COUNTY, KANSAS
CITY OF WICHITA PRIVATE PROJECT NO. 468-76-245-80001-000-000-175
1988

SCALE
HORIZONTAL: 1" = 10'
VERTICAL: 1" = 5'

B.M. = CITY DISC WEST FACE WALK
EAST SIDE ARKANSAS ON FLOOD CONTROL
DIKE, 100.4' NORTH OF 37th ST.
ELEV. = 135.75

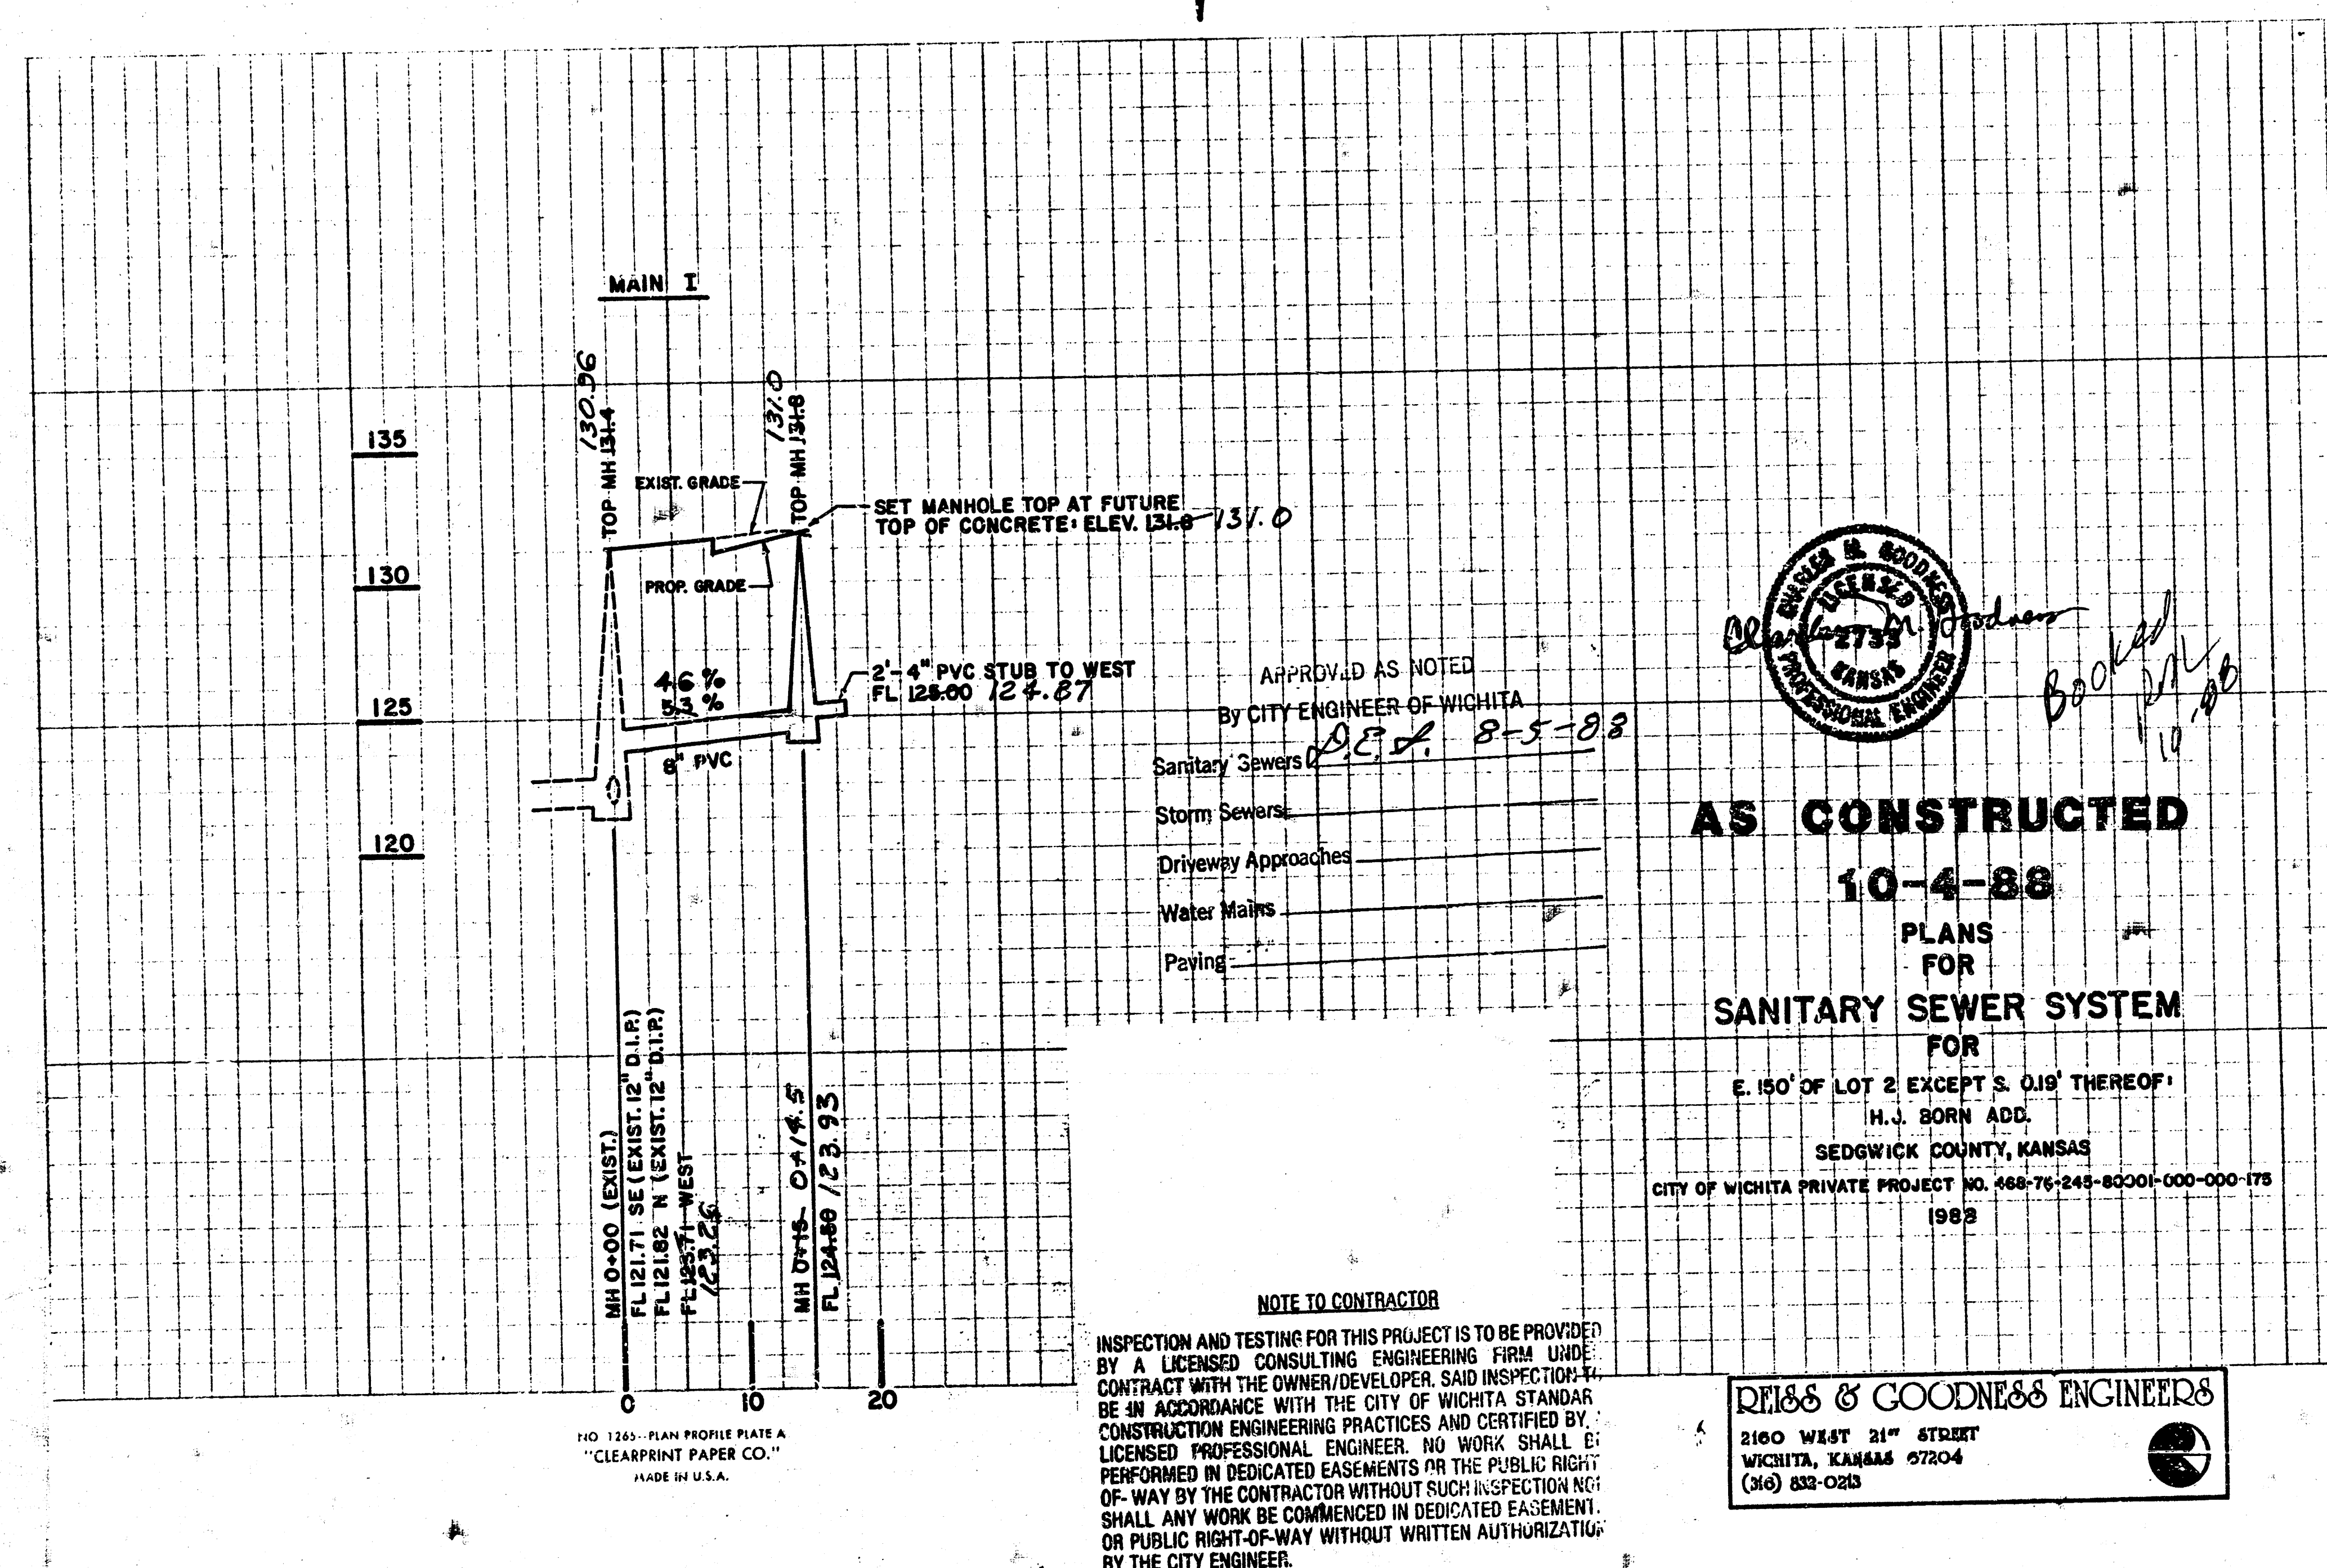

FILMED FROM THE BEST
AVAILABLE COPY