
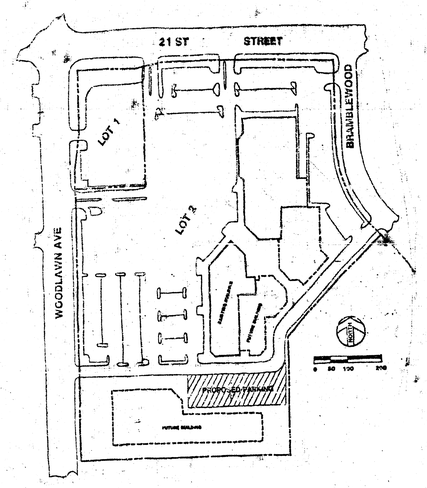


B VICINITY MAP

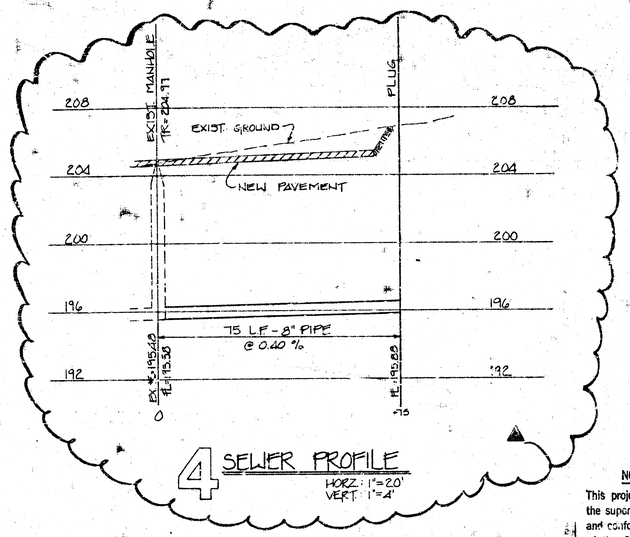

4 SEWER PROFILE
HORZ: 1"=20'
VERT: 1"=4'

APPROVED AS NOTED
By CITY ENGINEER OF WICHITA
Sanitary Sewers
Storm Sewers
Driveway Approaches

GENERAL NOTES

1. CONTRACTOR TO COORDINATE PAVEMENT GRADES WITH "FUTURE PAVEMENT" TO PROVIDE FOR POSITIVE DRAINAGE OF PAVEMENT.
2. REFER TO "ONE BRITTANY PLACE" SPECIFICATIONS, DIVISION 2, FOR EARTHWORK AND PAVEMENT.
3. ALL DIMENSIONS ARE TO THE FACE OF CURB.
4. LANDSCAPE FILL MATERIAL-INSTALL FILL TO WITHIN 2" OF TOP OF CURB ELEVATION. FROM TOPSOIL MATERIAL, STOCK PILED ADJACENT TO ROCKHILL LANE, MINIMUM TOPSOIL 8".


THE CONTRACTOR SHALL BE RESPONSIBLE FOR PRESERVING PROPERTY IRONS. THE CONTRACTOR SHALL BE REQUIRED TO RE-ESTABLISH ANY PROPERTY IRONS WHICH MAY BE DAMAGED OR DESTROYED BY HIS CONSTRUCTION OPERATIONS. SUCH IRONS SHALL BE RE-ESTABLISHED BY A LICENSED LAND SURVEYOR OR A LICENSED PROFESSIONAL ENGINEER IN ACCORDANCE WITH STATE LAWS.

NOTE TO CONTRACTOR


This project will be constructed under the supervision of the CITY ENGINEER and conforming to the SPECIFICATIONS of the CITY OF WICHITA. The CONTRACTOR will prepay the City of Wichita for all costs of inspection.

LEGEND


- 47.2 EXIST. SPOT ELEV.
- 47.2 NEW SPOT ELEV.
- NEW CURB & GUTTER

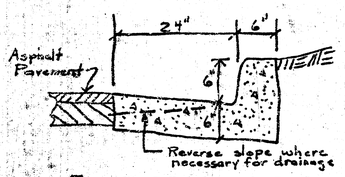


1 CURB & GUTTER
1"=1'

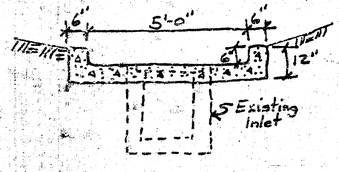



2 SECTION

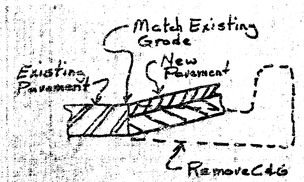

3 SECTION

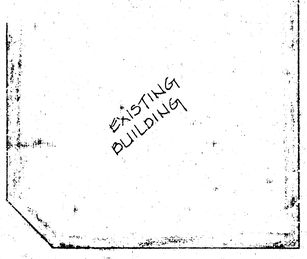

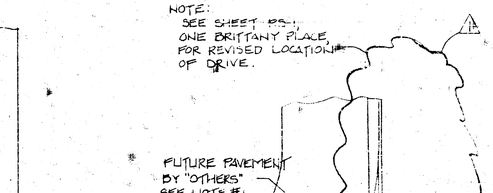

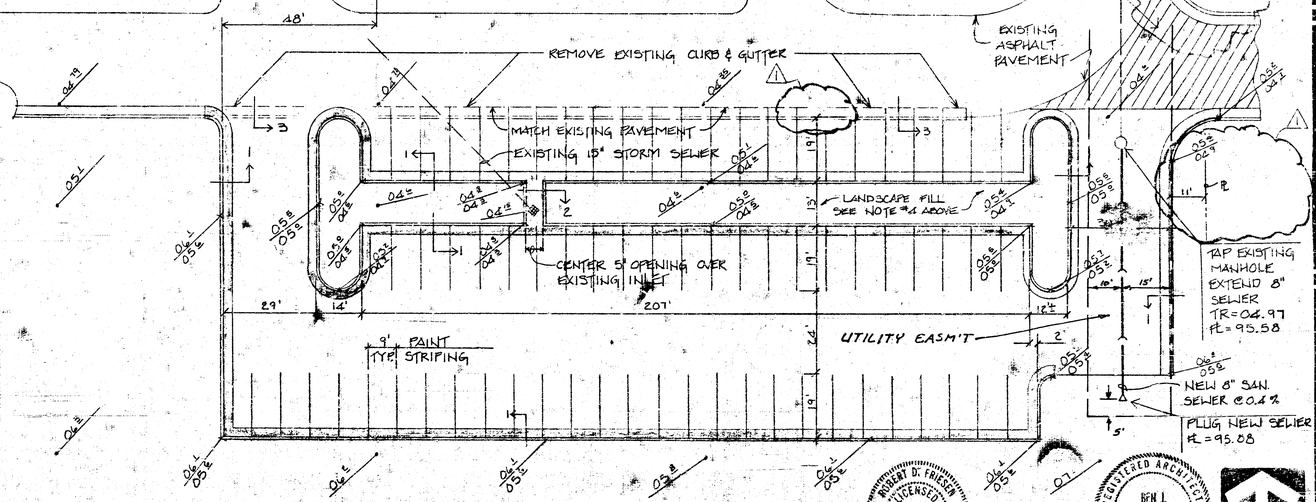

BENCH MARK
CITY DISK ON NE COR WOODLAWN & 21ST ELEV. 200.65

A PARKING PLAN
1"=20'

ROBERT D. FRIESEN LICENSED 6719 KANSAS PROFESSIONAL ENGINEER

REGISTERED ARCHITECT BEN J. KINGDON 1096 STATE OF KANSAS

NORTH

PRINTS ISSUED

DATE	PURPOSE	NO.
10-7-82	FOR OWNER W/P/L	2
10-11-82	FOR OWNER	3
11-11-82	TO CHANGE CONTRACTOR	
2-9-82	TO CONTRACTOR	0

FOR CONSTRUCTION: 10-11-82

REVISIONS

DATE	ITEM	NO.
11-10-82	SHEET NO.	1
12-8-82	SEWER PROFILE	2

LAW/KINGDON, P.A.
213 E. MARKET WICHITA, KANSAS 67202
Phone (316) 265-9564
ARCHITECTS & ENGINEERS

DRAWN	CHECKED
DPJ	FLW

BRITTANY CENTER

PROJECT NUMBER 7795

Copyright © 1982 Law/Kingdon, P.A.

S.S. EXTENSION AT BRITTANY CENTER LOT 2, BLK 1, NORTHBOROUGH ADDN.

468-----008 (132)
KEY PLAN

SITE

TENANT

PARKING PLAN

SHEET TITLE

TENANT NUMBER | SHEET NUMBER: RS-1

SHEET 1 OF 1 SHEETS

FILMED FROM THE BEST AVAILABLE COPY