

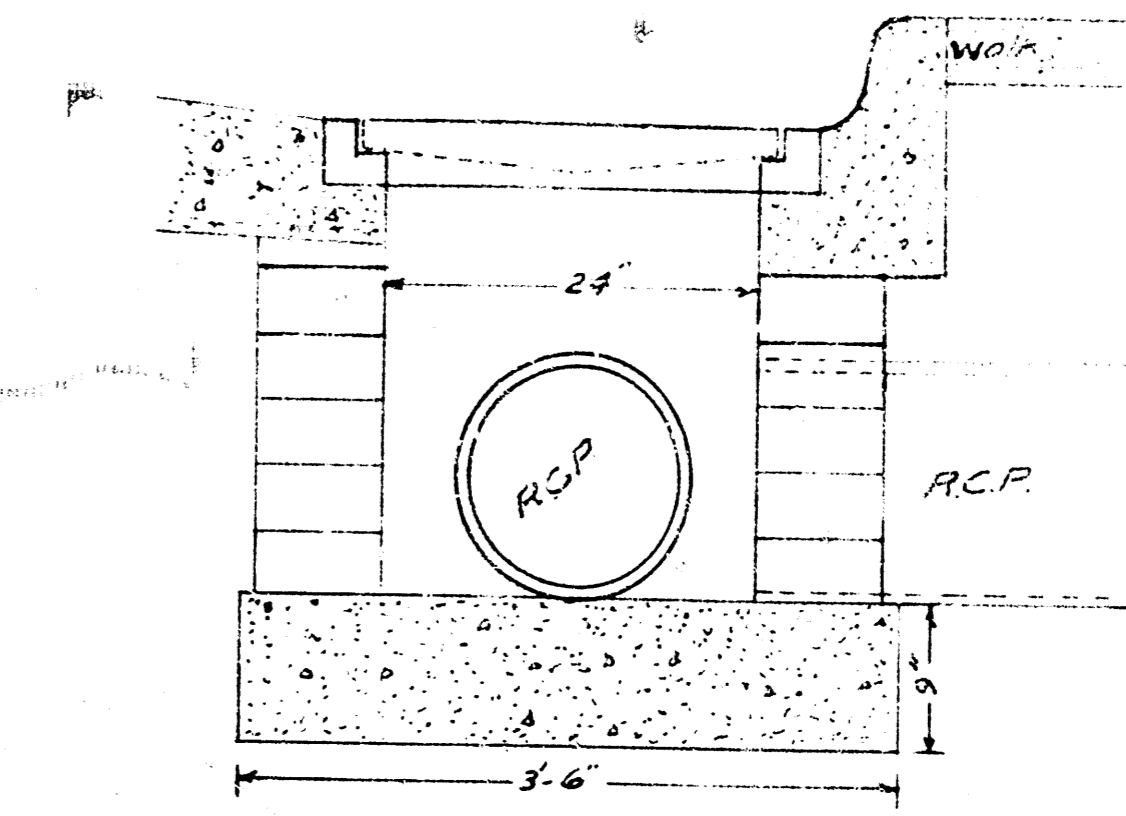
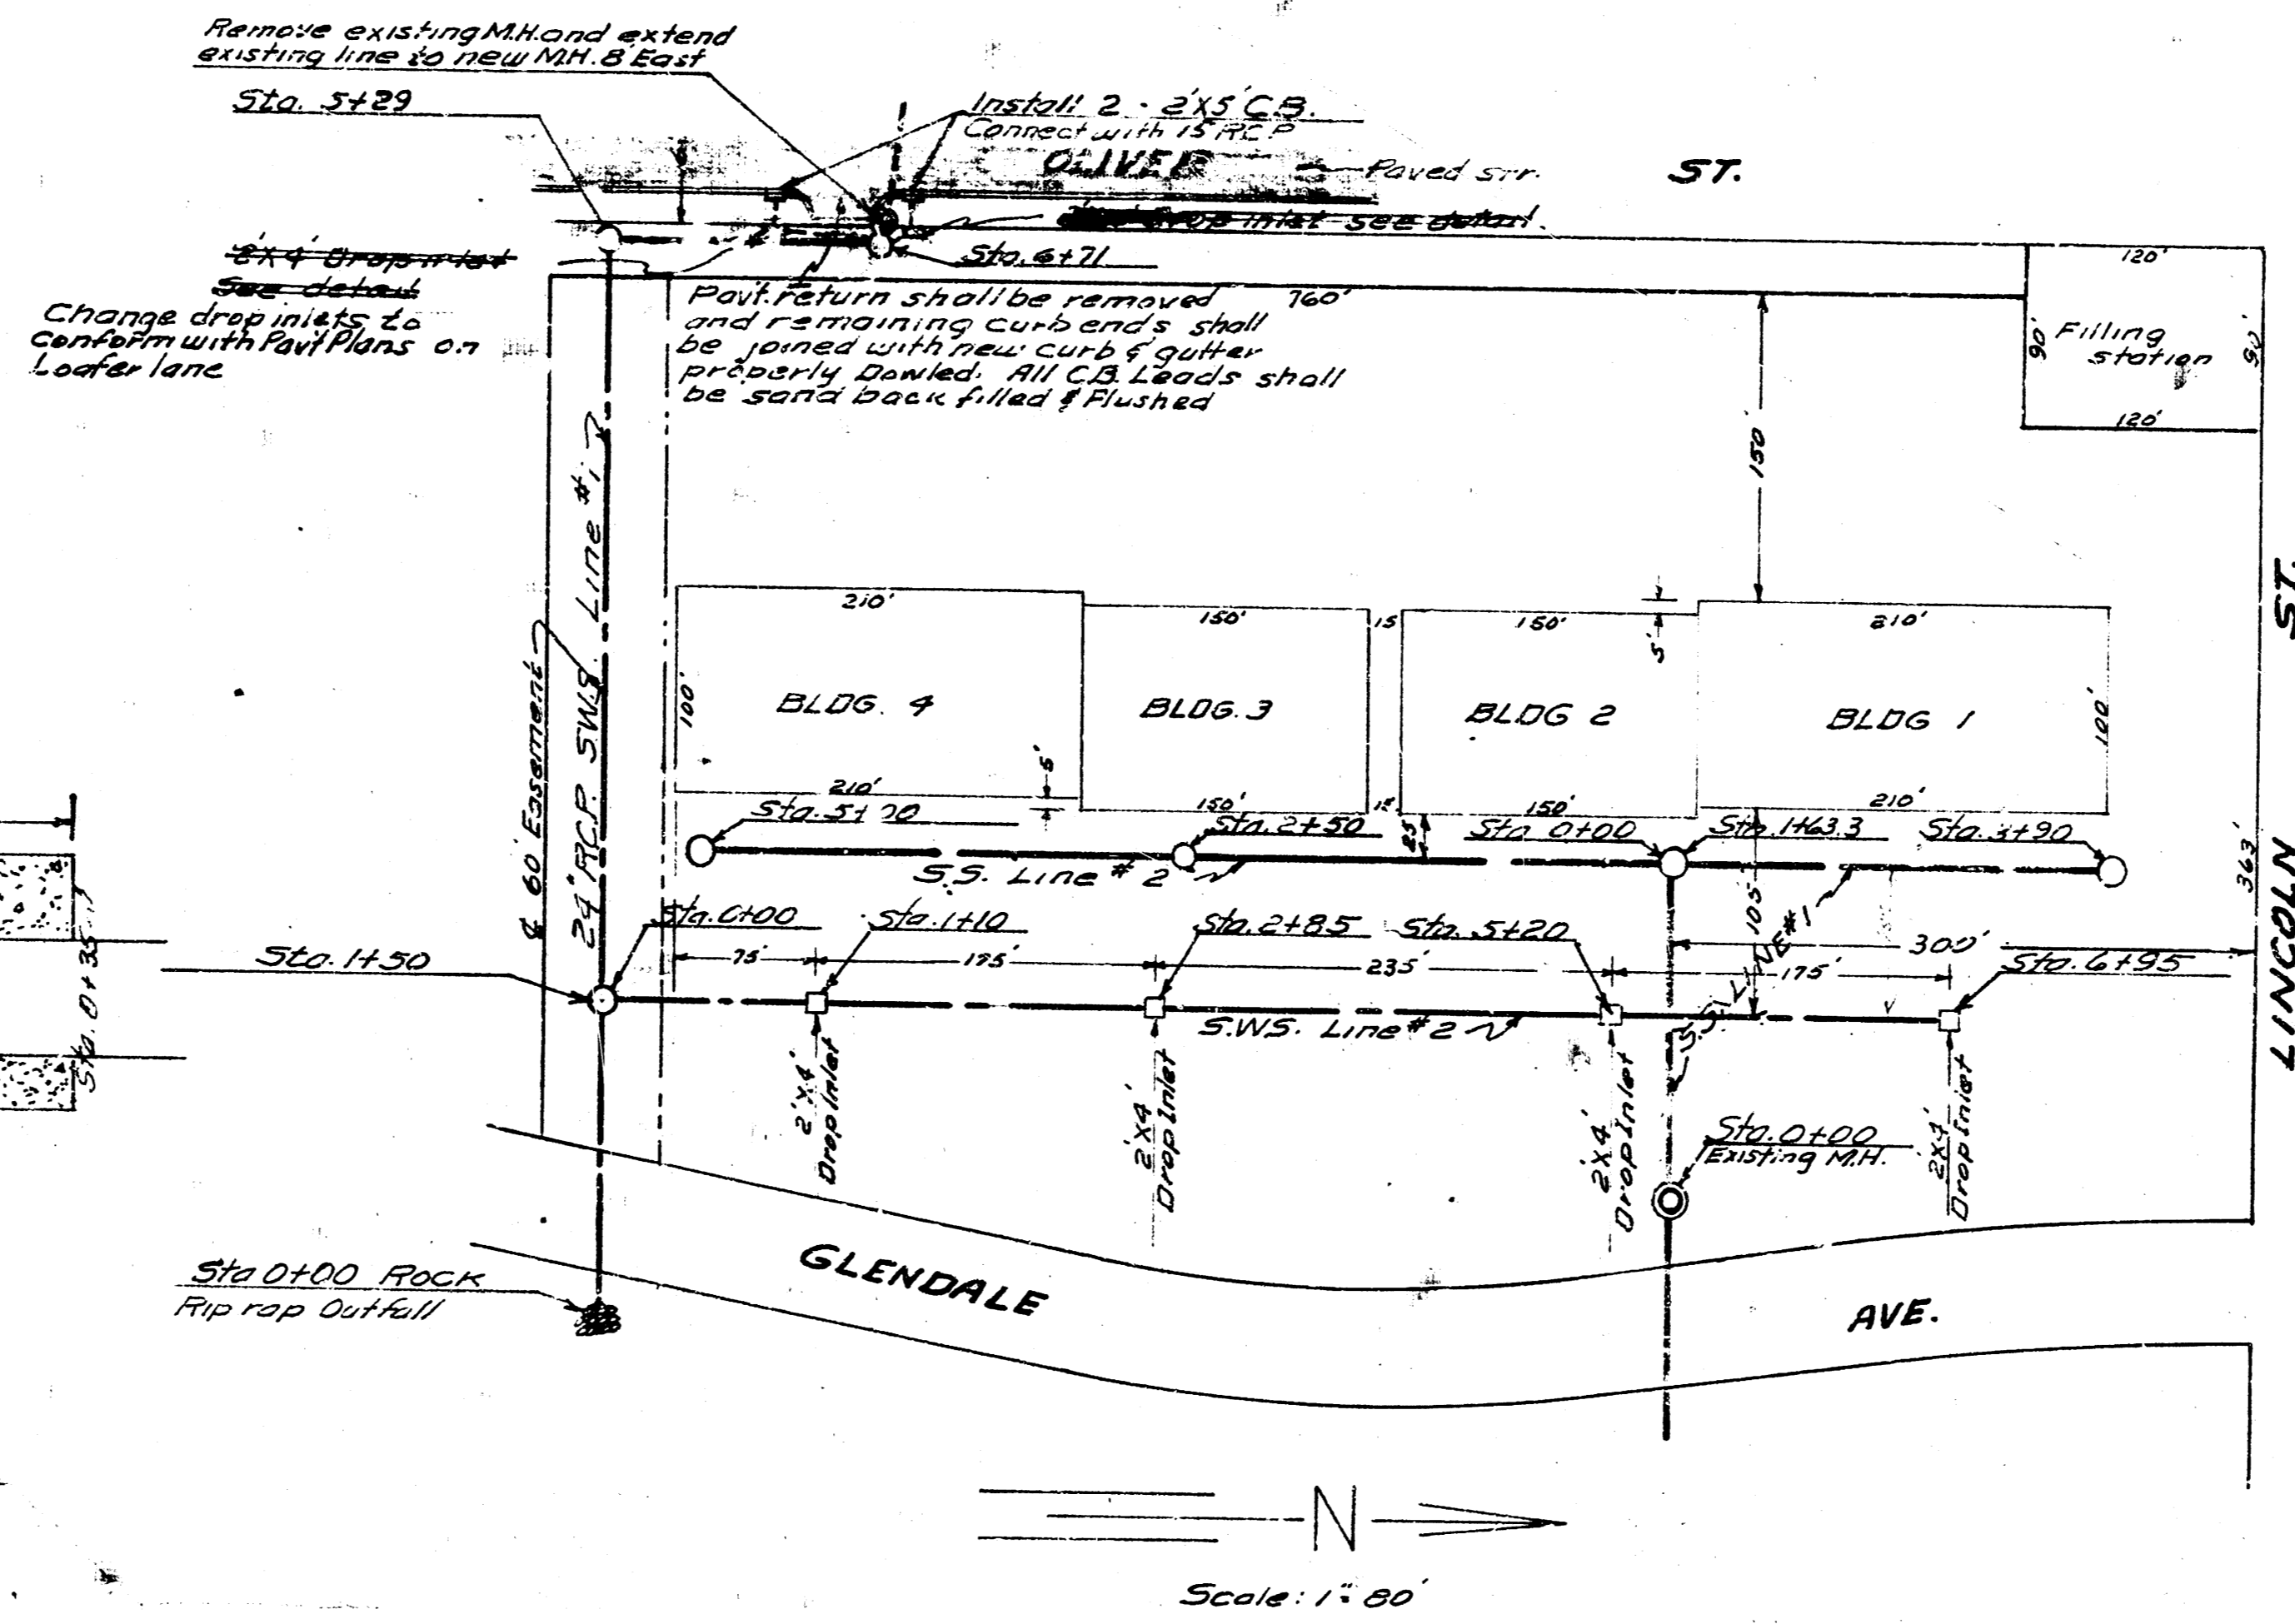
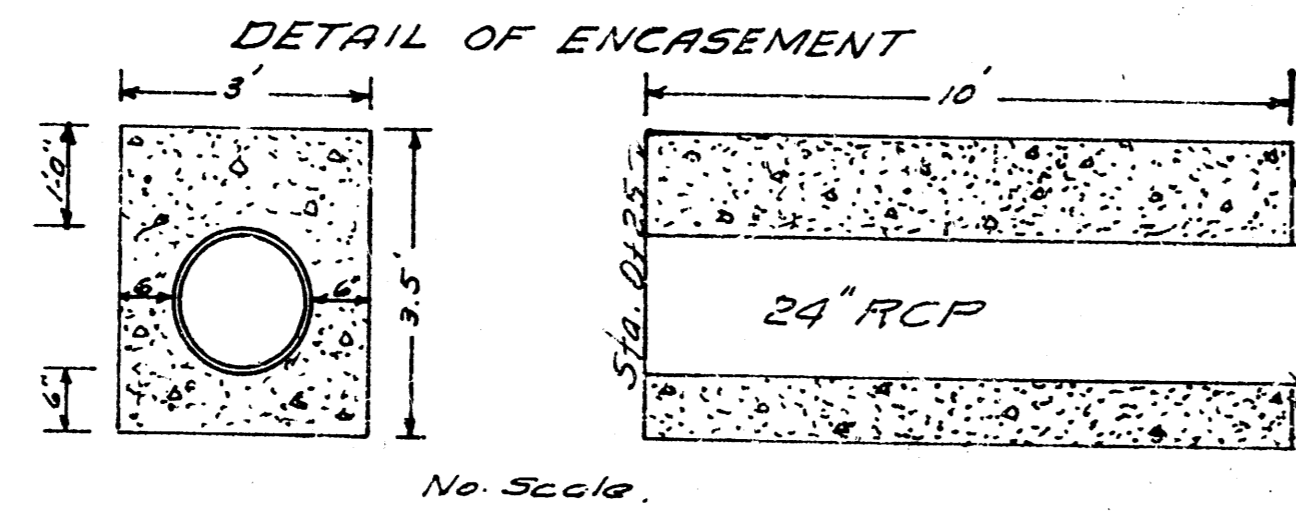


NOTE: Detailed plans on City Std. Drop inlet may be had upon request. Catch basins on Oliver shall be built to City Standards.

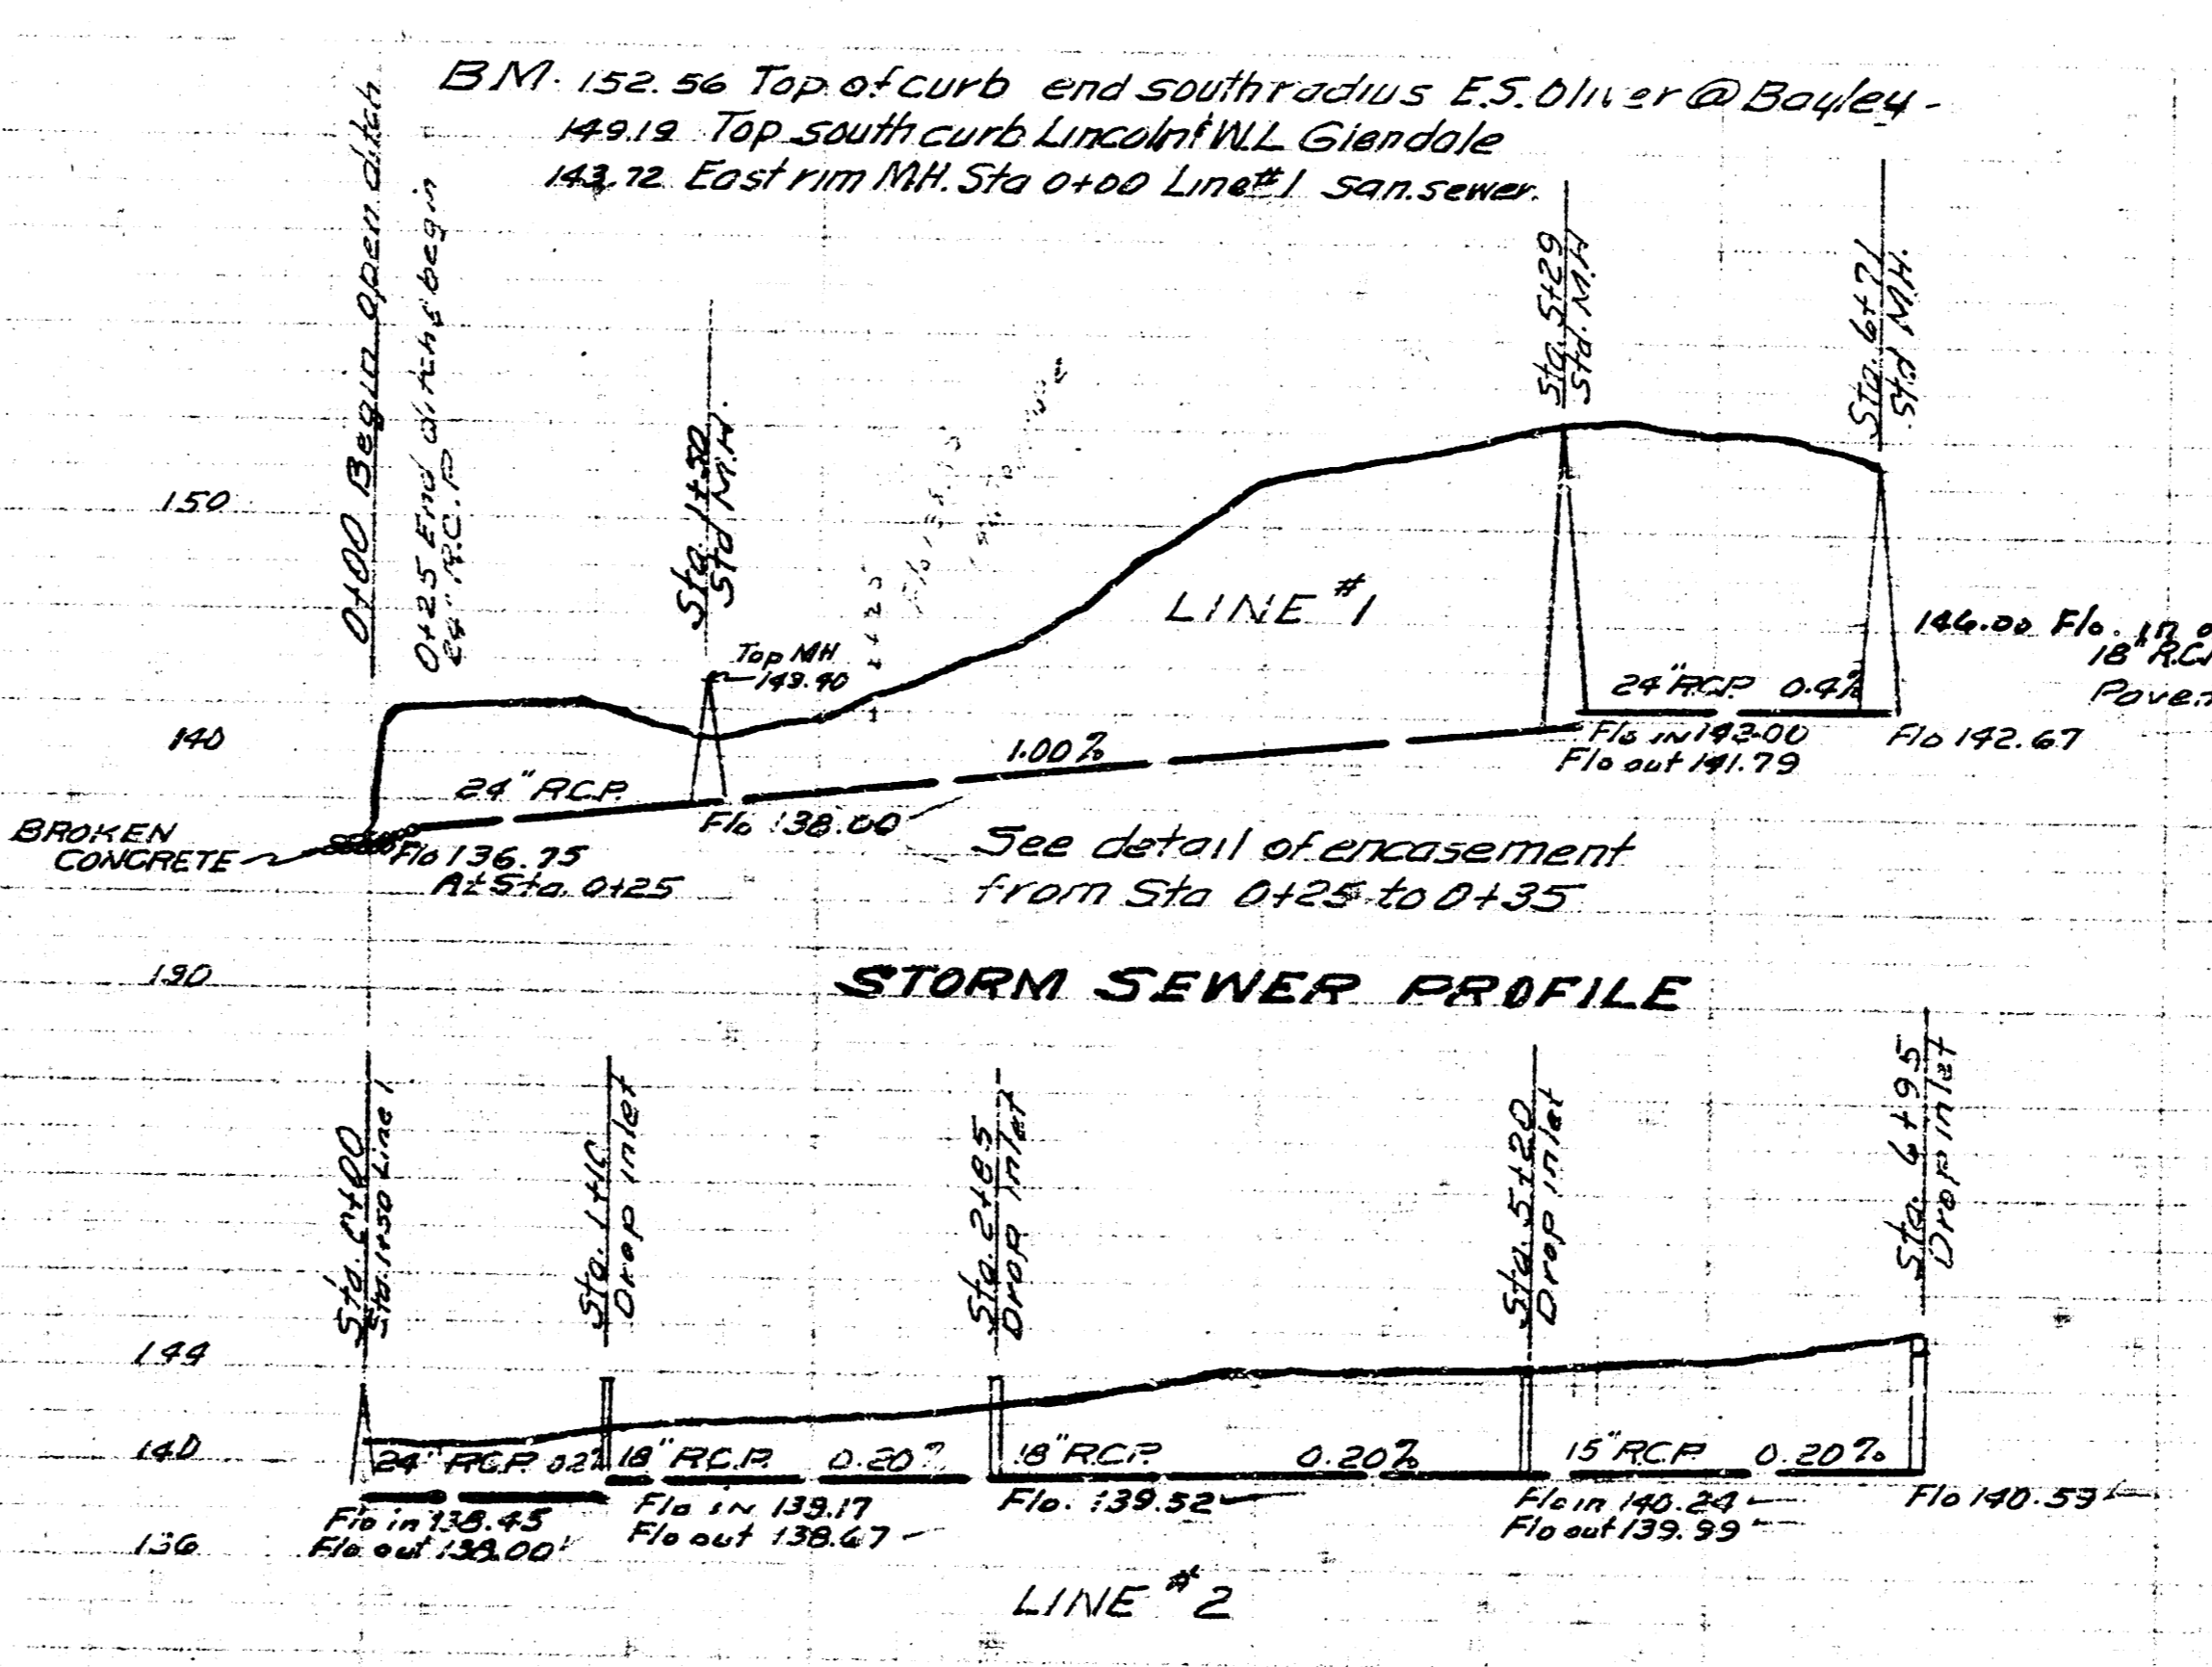

STANDARD

Date: 6-24-54
Designed by: MacLean
Checked by: Beck
H-66

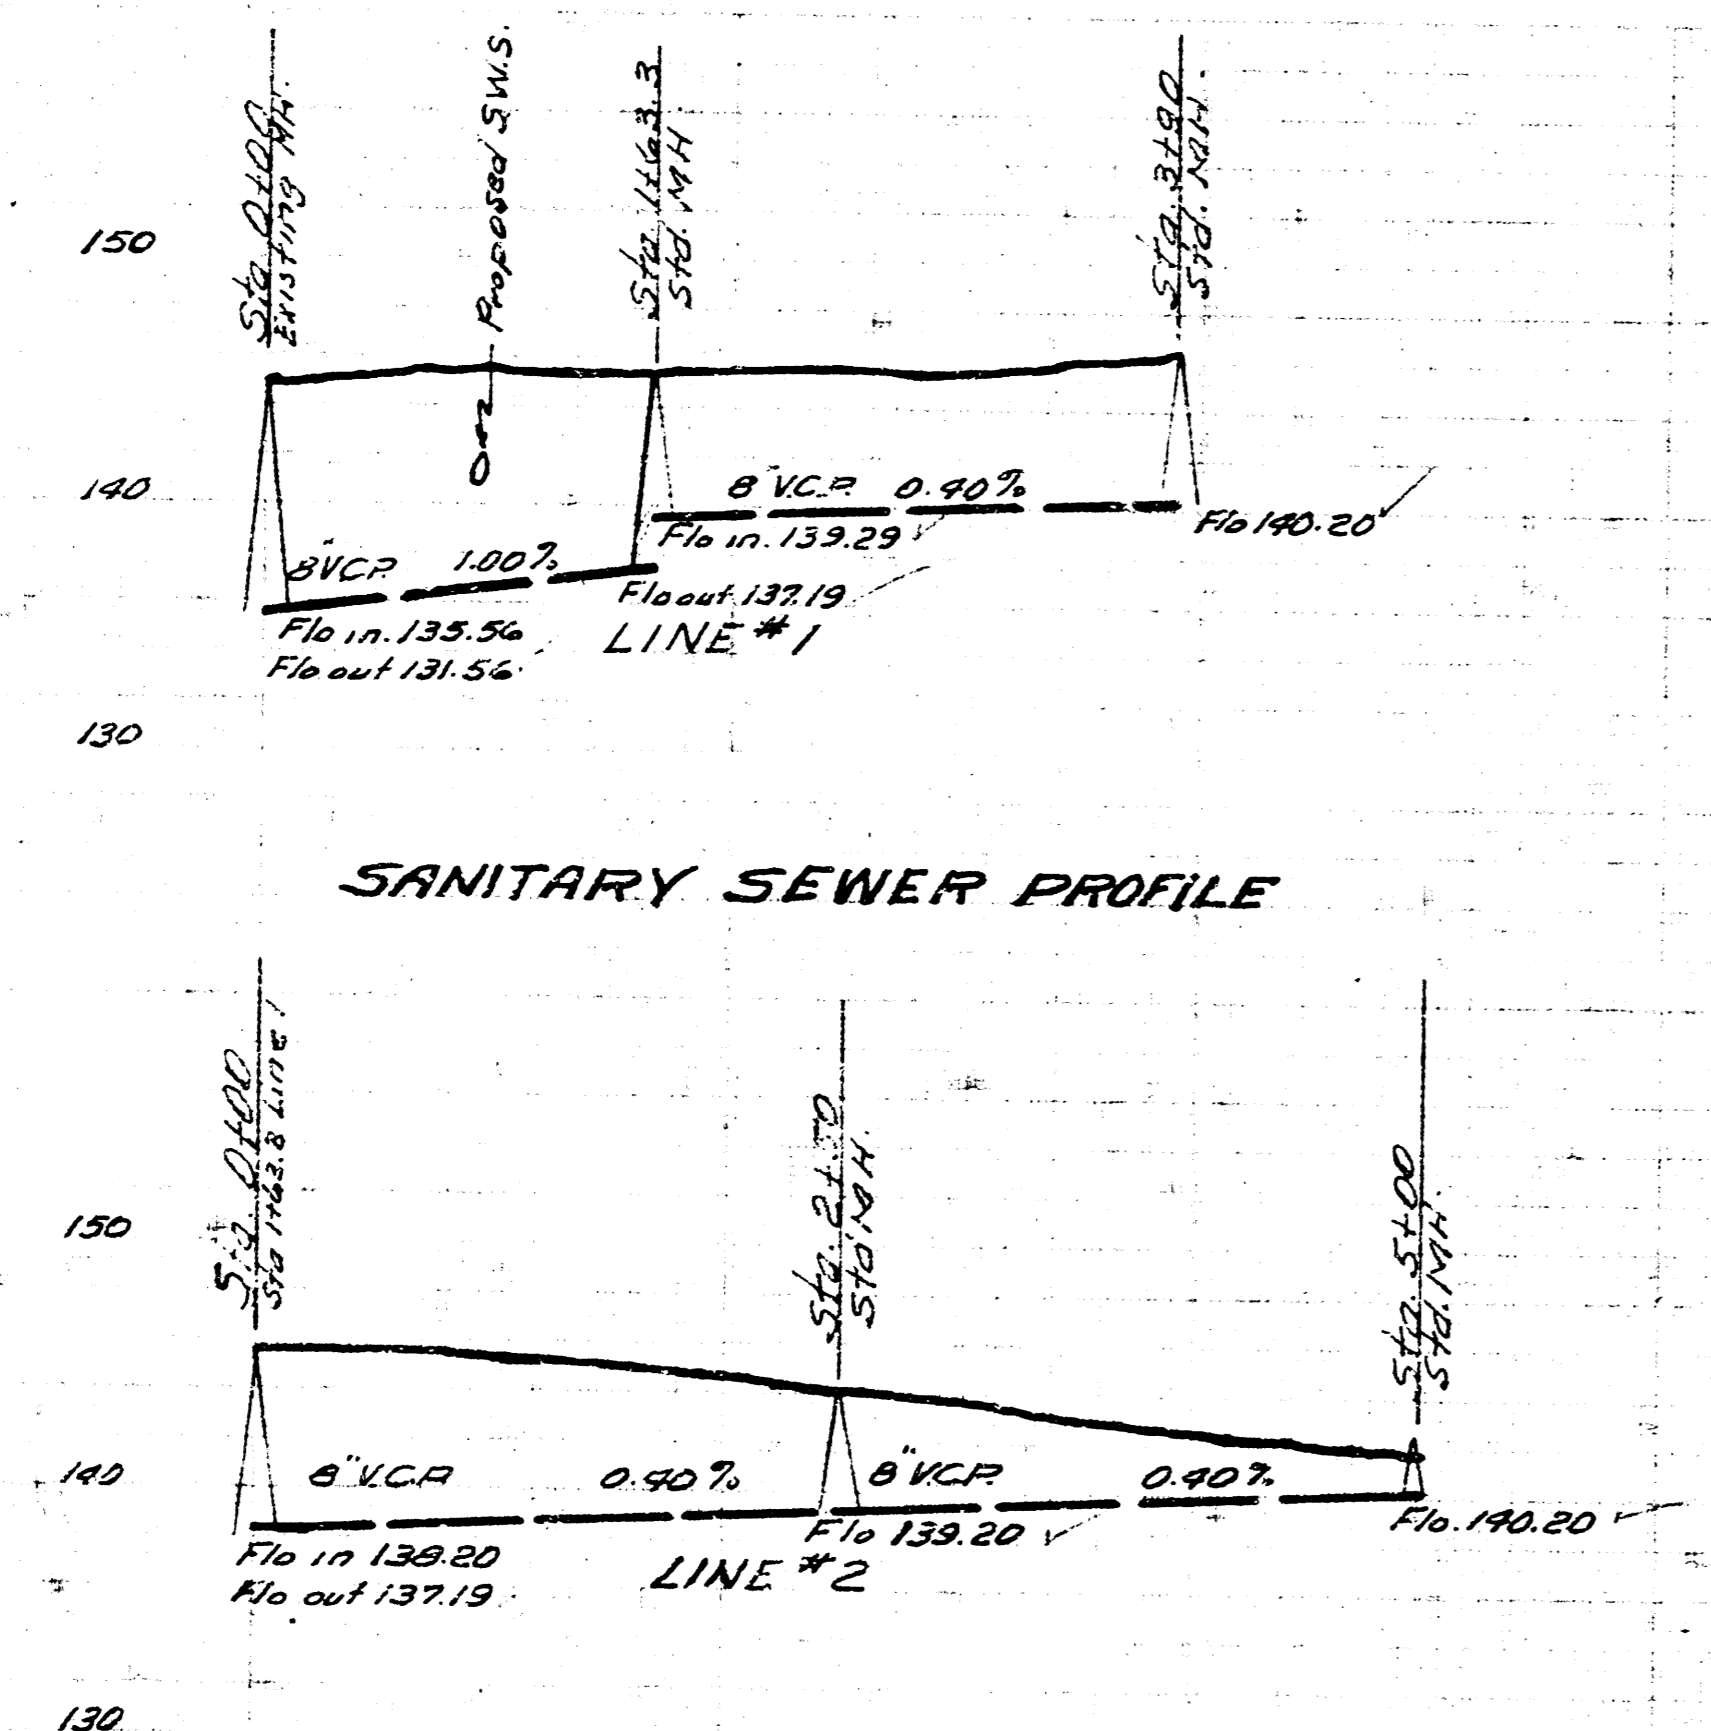

PRIVATE SANITARY & STORM SEWERS
OLIVER TO GLENDALE - LINCOLN 880.50.
BUILDERS INC.
CITY OF WICHITA KANSAS
B.E. SMITH CITY ENGINEER