



NOTE: Detailed plans on City Std. Drop inlet may be had upon request. Catch basins on Oliver shall be built to City Standards

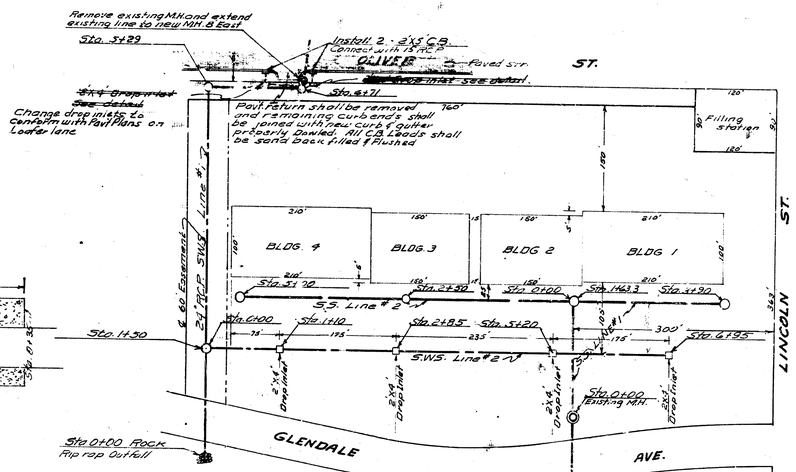

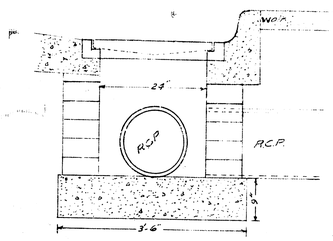



SECTION
DROP INLET
On 2x2 inlets use 2-2x2 Frame & Grates

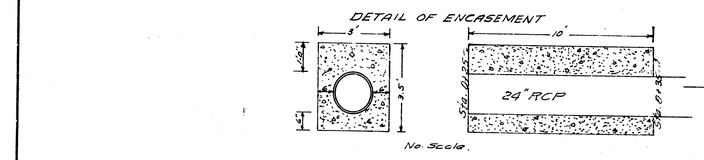

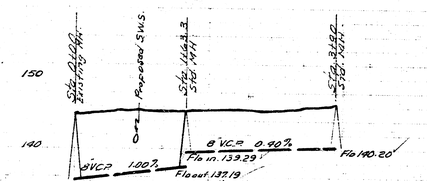


SANITARY SEWER PROFILE

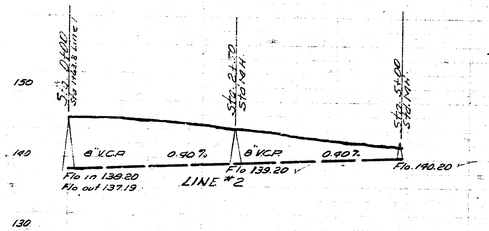

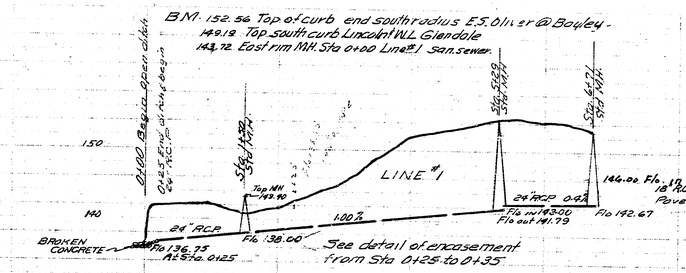

STORM SEWER PROFILE

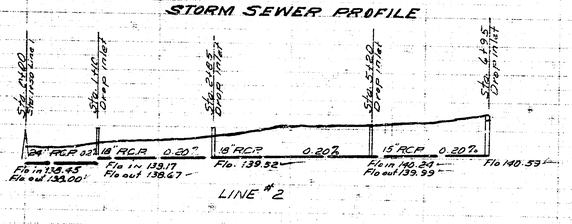

PRIVATE SANITARY & STORM SEWERS
OLIVER TO GLENDALE - LINCOLN 880 SO.
BUILDERS INC.
CITY OF WICHITA KANSAS
B.E. SMITH CITY ENGINEER

Date
Designed by
Checked by
Sheet No.