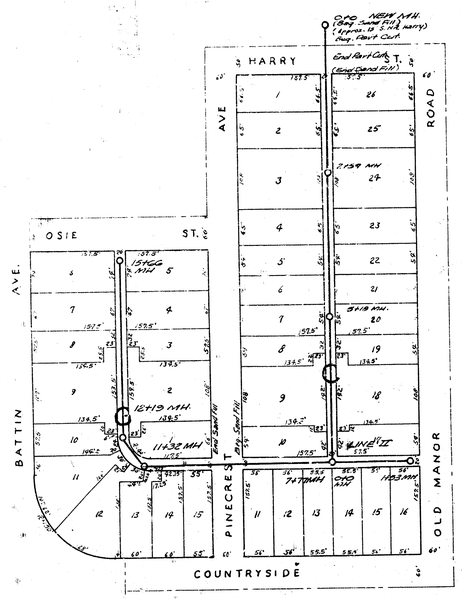

LAT. 1, DIST. 1, War Industry Sewer

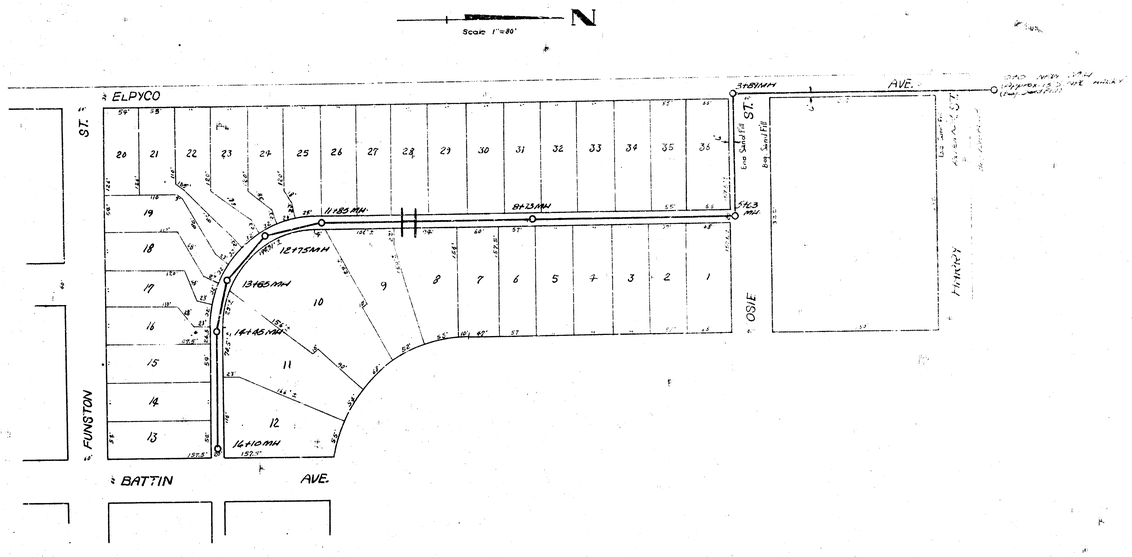

PRIVATE JOB (6" V.S.)

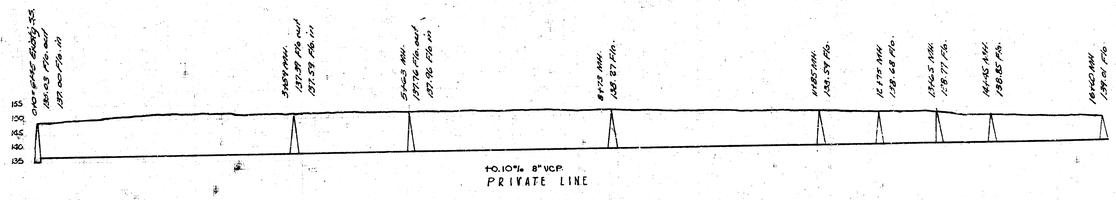

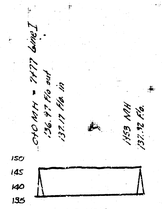

LINE II 8" VCP.

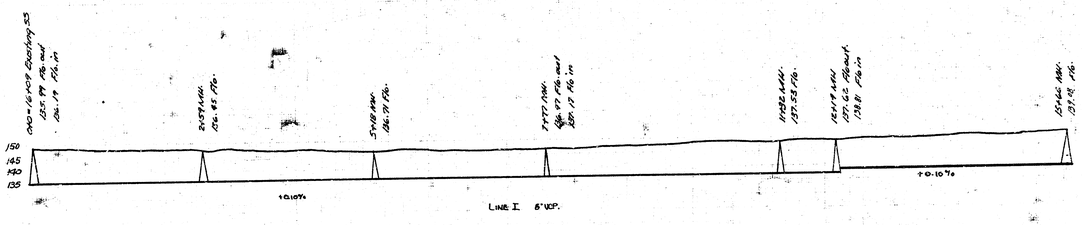

LINE I 8" VCP.

LAT. 1, DIST. 1, W.I.S.

PRIVATE JOB - RES. H
LAT. 1, DIST. 1, WAR INDUSTRY SEWER.

CITY OF WICHITA · KANSAS

L. K. WHITE · CITY ENGINEER

Date: 9-20-43 PROJ. NO. - C23-34