DATE: 9-2-70 REVISED 9-11-70 REVISED 10-7-70	REISS AND GOODNEST ENGINEERS FLOYD E. DOUGLAS WICHITA — KANSAS	SANITARY SEWER LINE EXTENSION OF LAT. 29 - WAC INDUSTRIES SEWER TO SERVE PAUL BURNETT ADDITION TO WICHITA, KANSAS	SHEET NO. 1 5

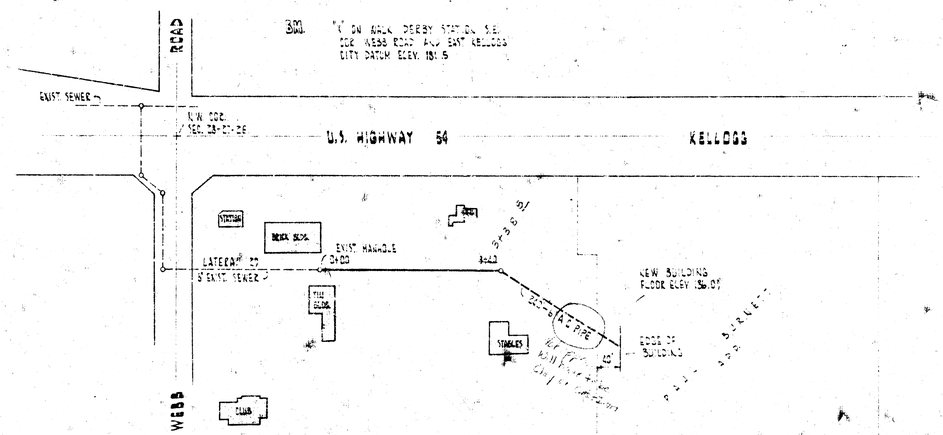

SCALE: PLAN 1" = 100'
PROFILE HORIZ. 1" = 40'
VERT. 1" = 4'

APPROVED AS NOTED
WICHITA

NOTE TO CONTRACTOR
This project will be constructed under the supervision of the CITY ENGINEER and in accordance with the SPECIFICATIONS of the CITY OF WICHITA. The CONTRACTOR must notify the City of Wichita Director of Engineering and inspection.

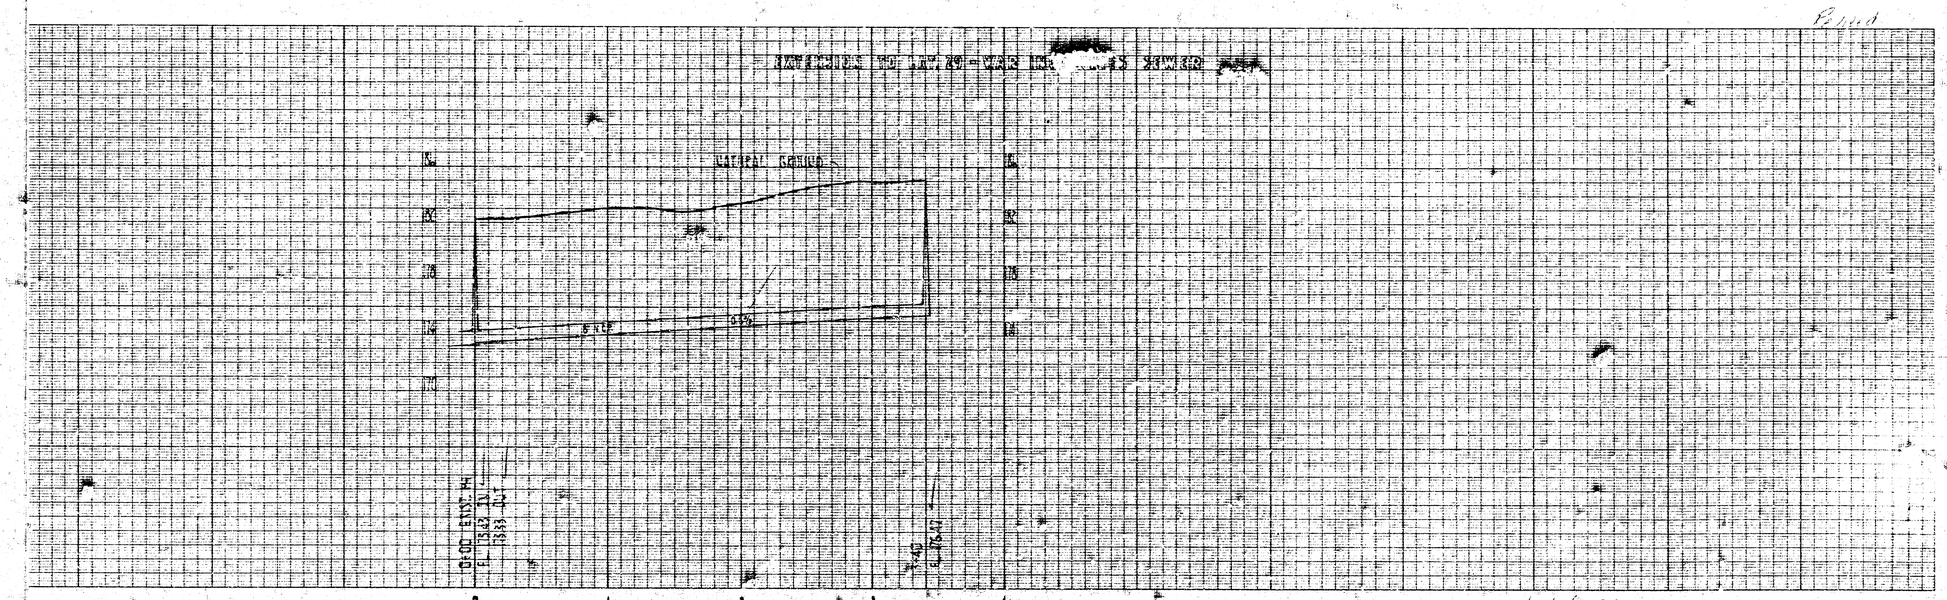

Ext. Lat. 29, W. I. S.
For Paul Burnett Addn
Private Job.

V-109
9-17-70