


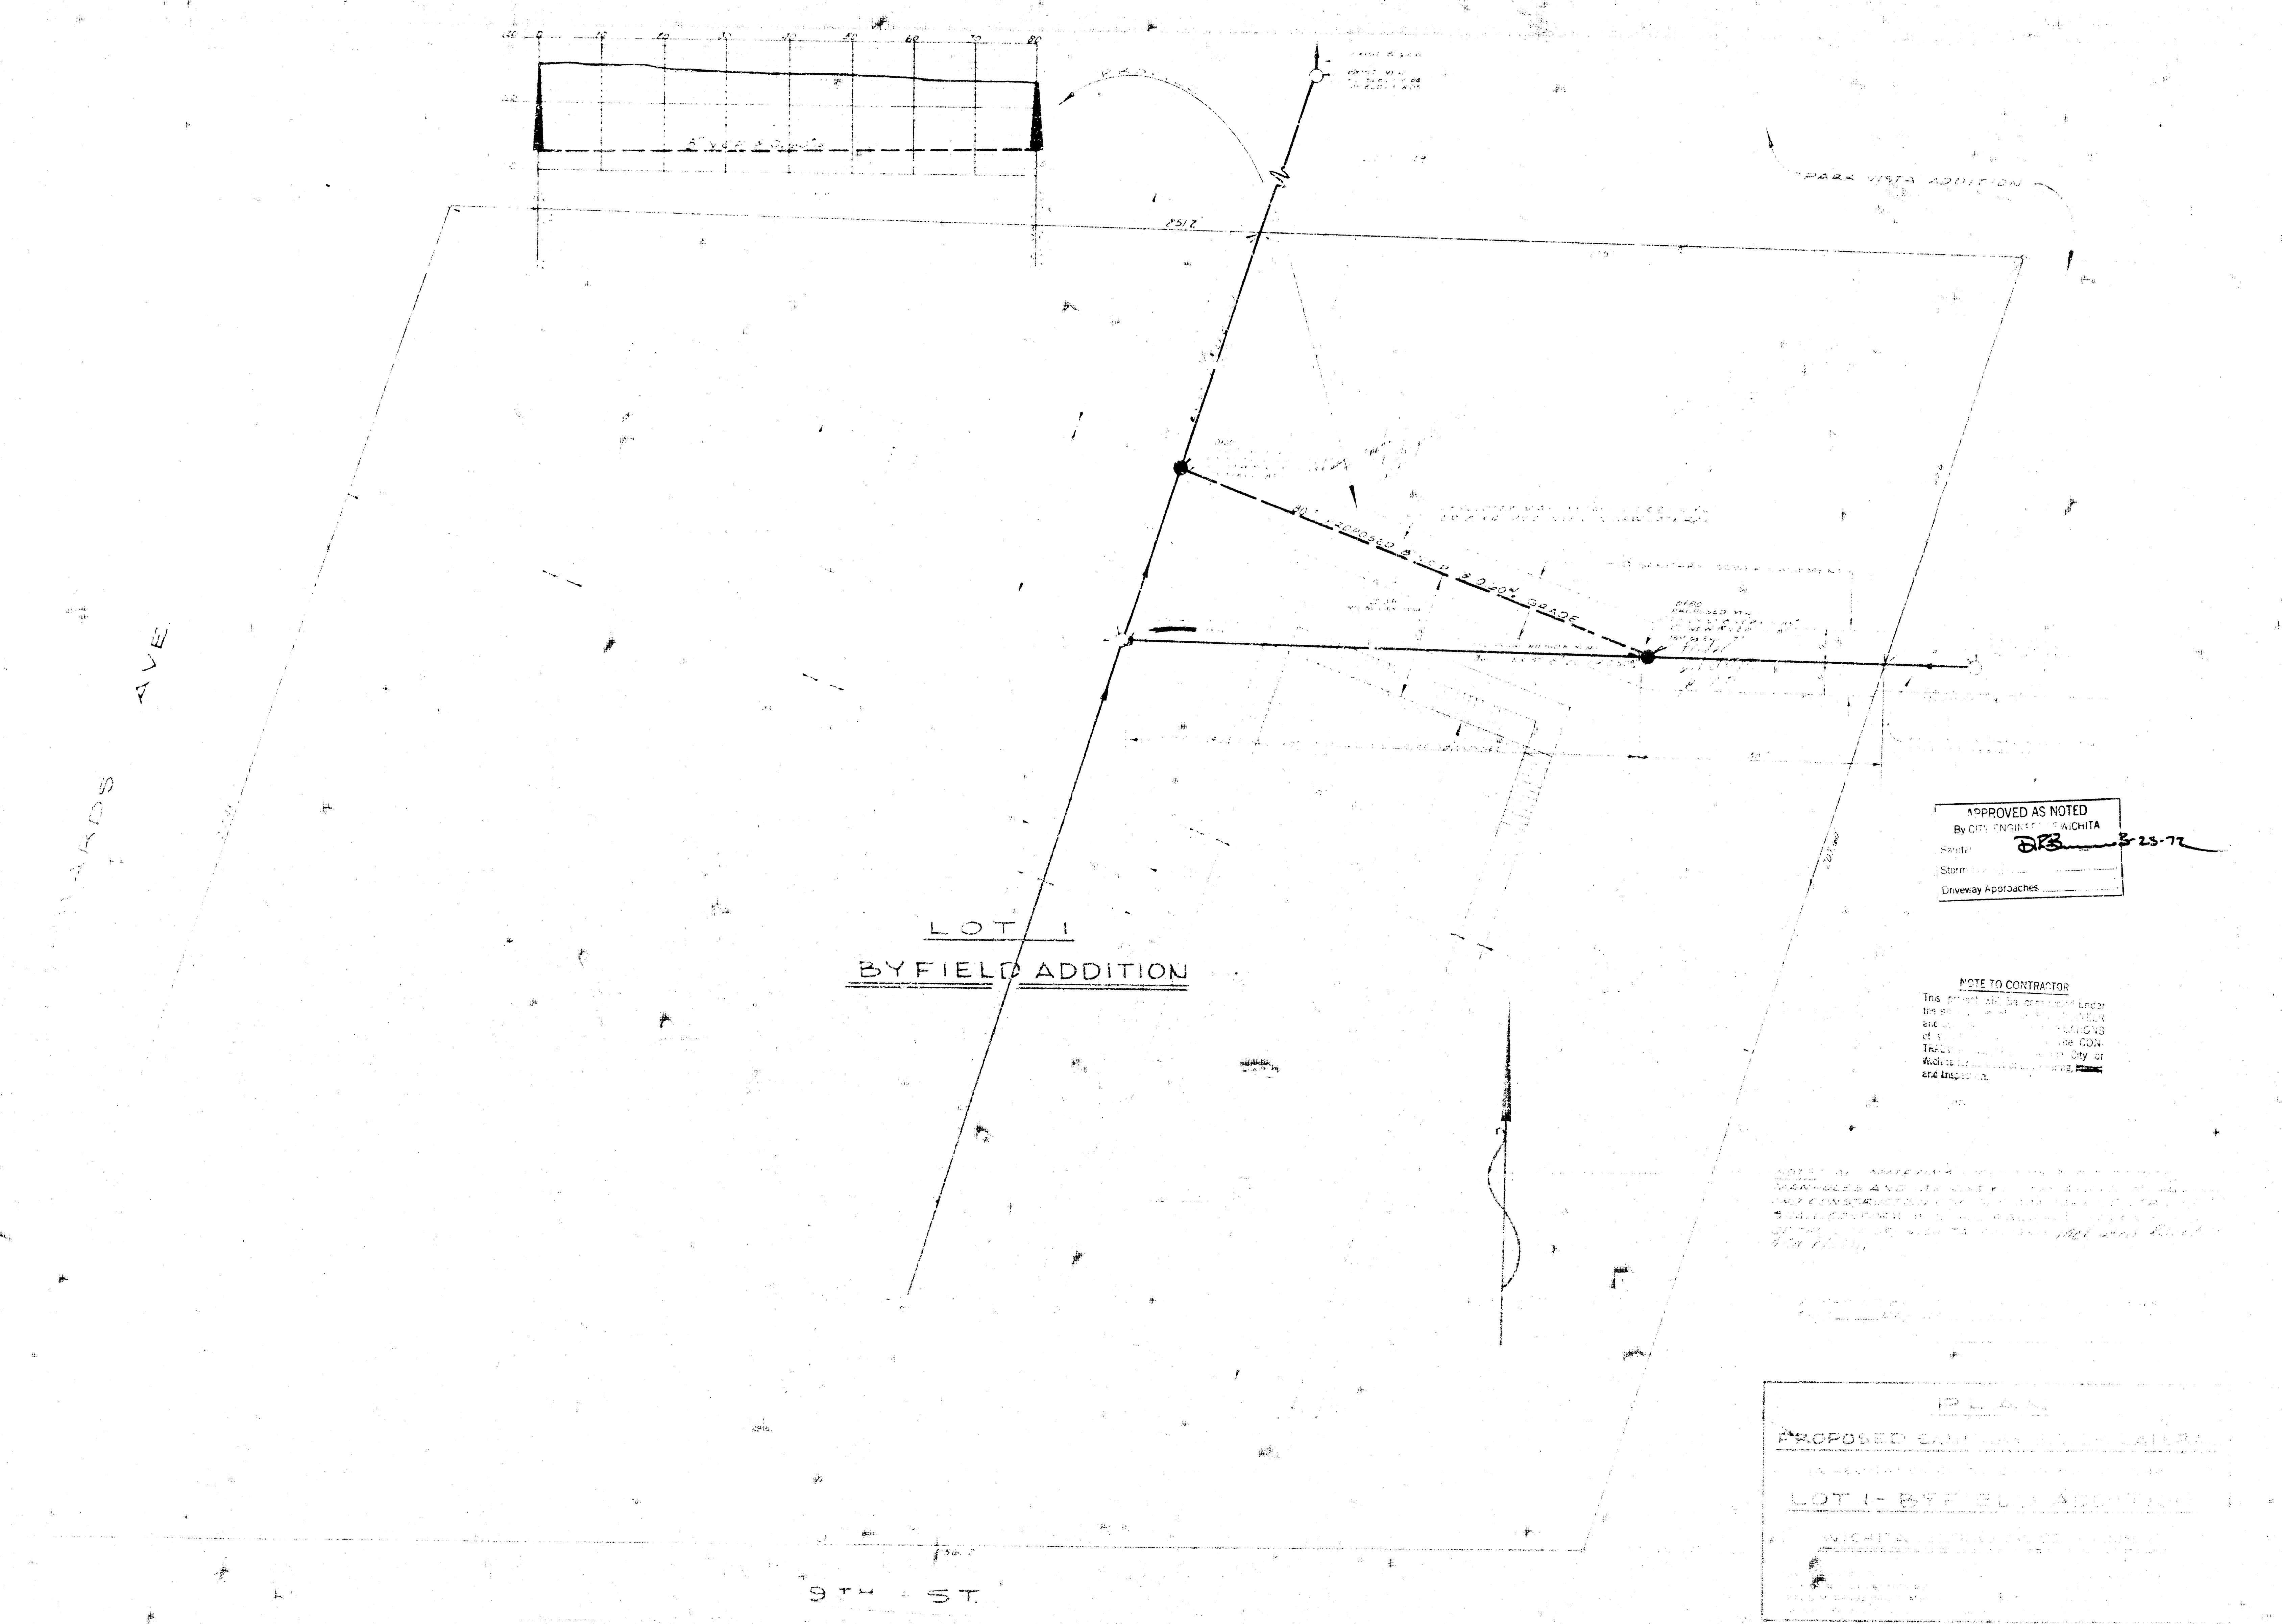

APPROVED AS NOTED
By City Engineer WICHITA
Date 8-25-72
Storm
Driveway Approaches

NOTE TO CONTRACTOR


WICHITA, KANSAS
LOT 1 - BYFIELD ADDITION
WICHITA, KANSAS
City Engineer
Date