

BENCH MARK: R.R. Spike In Power Pole Located 171.5' North and 18.5' East of Existing Manhole, Station 0+00 This Plan. Elevation = 142.37

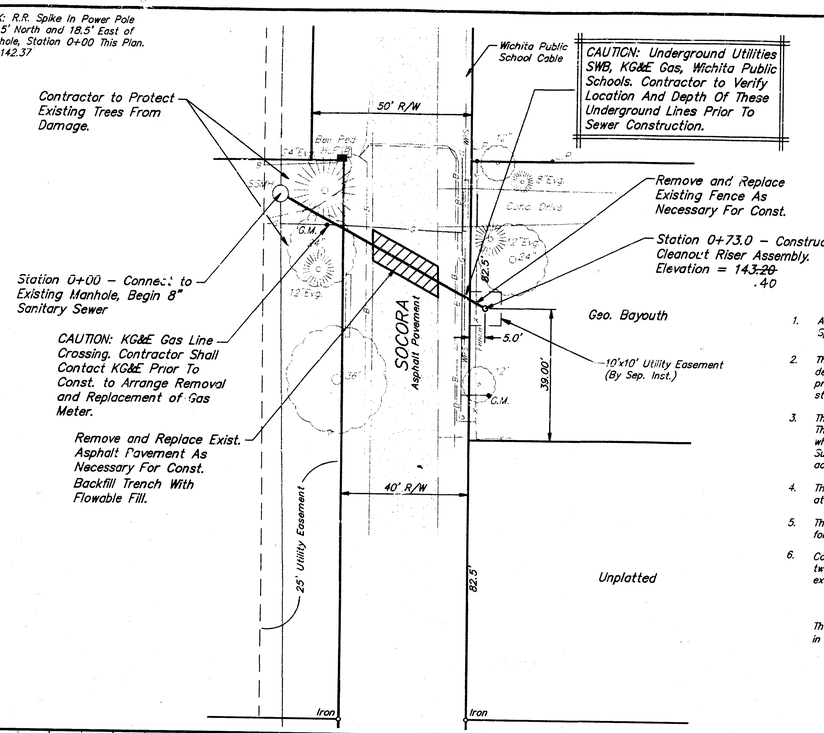

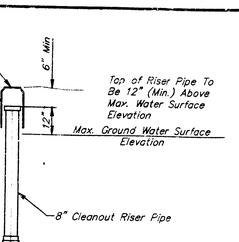

Scale: 1" = 20' Plan
1" = 5' Profile (Vert.)
o = Iron

1. All Construction to be in compliance with City of Wichita Specifications.
2. The Contractor shall give all property owners and/or tennants of developed property directly abbutting the construction of this project a minimum of ten (10) days advance notice prior to the start of construction.
3. The Contractor shall be responsible for preserving property irons. The Contractor will be required to re-establish any property irons which are damaged or destroyed by his construction operations. Such irons shall be re-established by a licensed land surveyor in accordance with state laws.
4. The Contractor shall maintain one open lane of traffic on Socora at all times during the construction of this project.
5. The Contractor shall be responsible for costs and arrangements for any necessary relocation of the KG&E Gas Meter.
6. Contractor will be required to provide a minimum notice of twenty-four (24) hours to utility companies prior to starting any excavation as follows:

Kansas One-Call 687-2470

The Contractor must notify the following before construction and in case of an emergency.


K.P.& L. Gas Service Company	263-7511
Kansas Gas & Electric	264-1141
Arkla Gas Company	942-8350 or 263-8161
Southwestern Bell Telephone Company	1-571-2611
Cablevision	262-4270 or 263-2061
City of Wichita Water Department	268-4908
City of Wichita Sewer Maintenance	268-4071


8" CLEANOUT RISER ASSEMBLY

INSPECTION AND TESTING FOR THIS PROJECT TO BE PROVIDED BY A LICENSED CONSULTING ENGINEERING FRIM UNDER CONTRACT WITH THE OWNER/DEVELOPER. SAID INSPECTION TO BE IN ACCORDANCE WITH THE CITY OF WICHITA STANDARD CONSTRUCTION ENGINEERING PRACTICES AND CERTIFIED BY A LICENSED PROFESSIONAL ENGINEER. NO WORK SHALL BE PERFORMED IN DEDICATED EASEMENTS OR PUBLIC RIGHT-OF-WAY BY THE CONTRACTOR WITHOUT SUCH INSPECTIONS, NOR SHALL ANY WORK BE COMMENCED IN DEDICATED EASEMENTS OR PUBLIC RIGHT-OF-WAY WITHOUT WRITTEN AUTHORIZATION BY THE CITY ENGINEER.

APPROVED AS NOTED
By CITY ENGINEER OF WICHITA

Sanitary Sewers VRH 5/20/93
Storm Sewers
Driveway Approaches
Water Mains
Paving

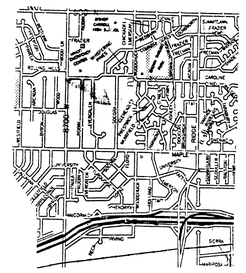

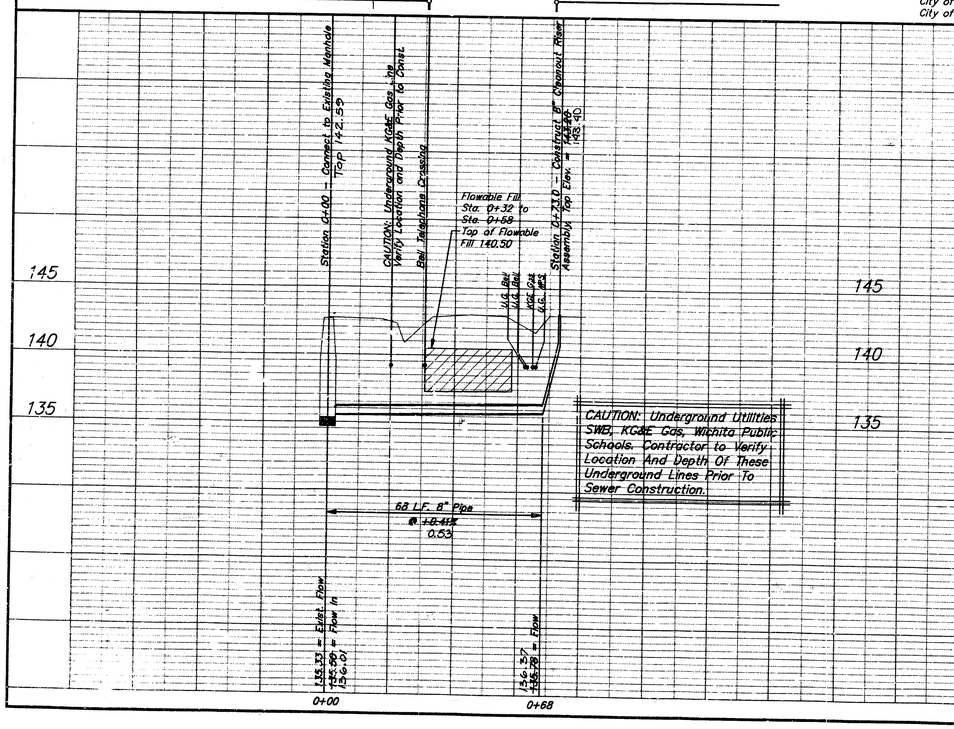

Booked 7/13-93 JKB From As Builts

REVISED AS BUILT 6-4-93 JCR

PRIVATE SANITARY SEWER EXTENSION
SERVING 156 SOUTH SOCORA
CITY OF WICHITA, KANSAS

SRB 841 SOUTH HILLSIDE WICHITA, KANSAS 67211 316-652-7754 FAX 652-7932
SAVOY, RUGGLES & BOHM, P.A.
ENGINEERING & SURVEYING

REVISED

PROJECT NUMBER 392 PPS

DRAWN	DESIGN	REVIEW	DATE	UTILITY	SRB JOB
C. Bohm	C. Bohm	TCR	5/18/93	TCR	45E

DWG FILE misc 145E

1
1