PLANS

FOR

SANITARY SEWER SYSTEM

JACK CALDWELL ONE

SEDGWICK COUNTY, KANSAS

CITY OF WICHITA PRIVATE PROJECT NO. 607861-204PPS

1989

"AS CONSTRUCTED"

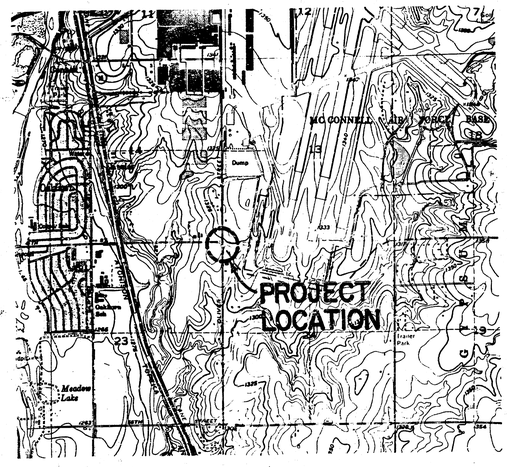

APPROVED AS NOTED
By CITY ENGINEER OF WICHITA
Sanitary Sewers GDB 3/22/89
Storm Sewers _____
Driveway Approaches _____
Water Mains _____
Paving _____

NOTE TO CONTRACTOR

INSPECTION AND TESTING FOR THIS PROJECT IS TO BE PROVIDED BY A LICENSED CONSULTING ENGINEERING FIRM UNDER CONTRACT WITH THE OWNER/DEVELOPER. SAID INSPECTION TO BE IN ACCORDANCE WITH THE CITY OF WICHITA STANDARD CONSTRUCTION ENGINEERING PRACTICES AND CERTIFIED BY A LICENSED PROFESSIONAL ENGINEER. NO WORK SHALL BE PERFORMED IN DEDICATED EASEMENTS OR THE PUBLIC RIGHT-OF-WAY BY THE CONTRACTOR WITHOUT SUCH INSPECTION NOR SHALL ANY WORK BE COMMENCED IN DEDICATED EASEMENTS OR PUBLIC RIGHT-OF-WAY WITHOUT WRITTEN AUTHORIZATION OF THE CITY ENGINEER.

Booked
RDL

REISS & GOODNESS ENGINEERS
2160 WEST 21st STREET
WICHITA, KANSAS 67203
(316) 832-0213

REVISION	DRAWN BY	CHECKED BY	DESIGNED BY	PROJECT	CUSTOMER	SCALE	PROJECT NO.
						DATE	SHEET 1 OF 3

FILMED FROM THE BEST AVAILABLE COPY

BM = TOP RING MH 0+00 = 10+11
CHELSEA INDUSTRIAL PARK
ELEV. 1316.84

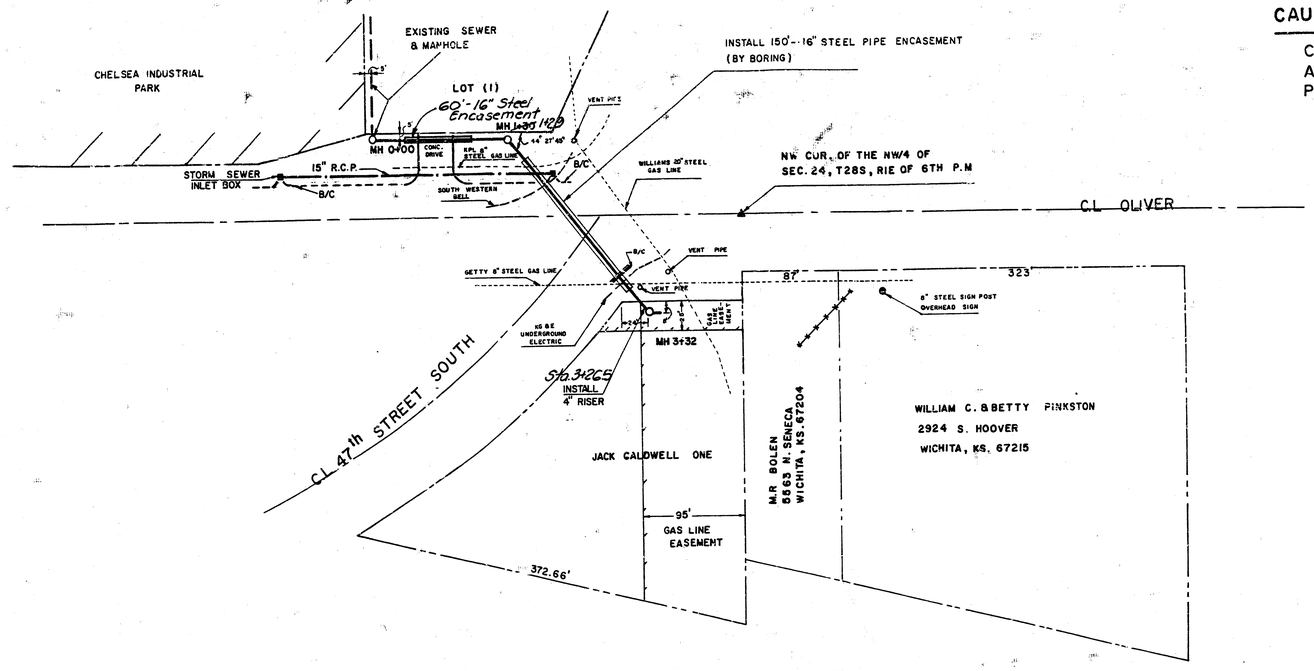

CAUTION

CONTRACTOR TO LOCATE ALL EXISTING UTILITIES PRIOR TO EXCAVATION.

SCALE
PLAN. 1"=60'
PROFILE
HORZ. 1"=40'
VERT. 1"= 4'

(ALL PIPE IS 8", ALL MANHOLES ARE PRECAST)

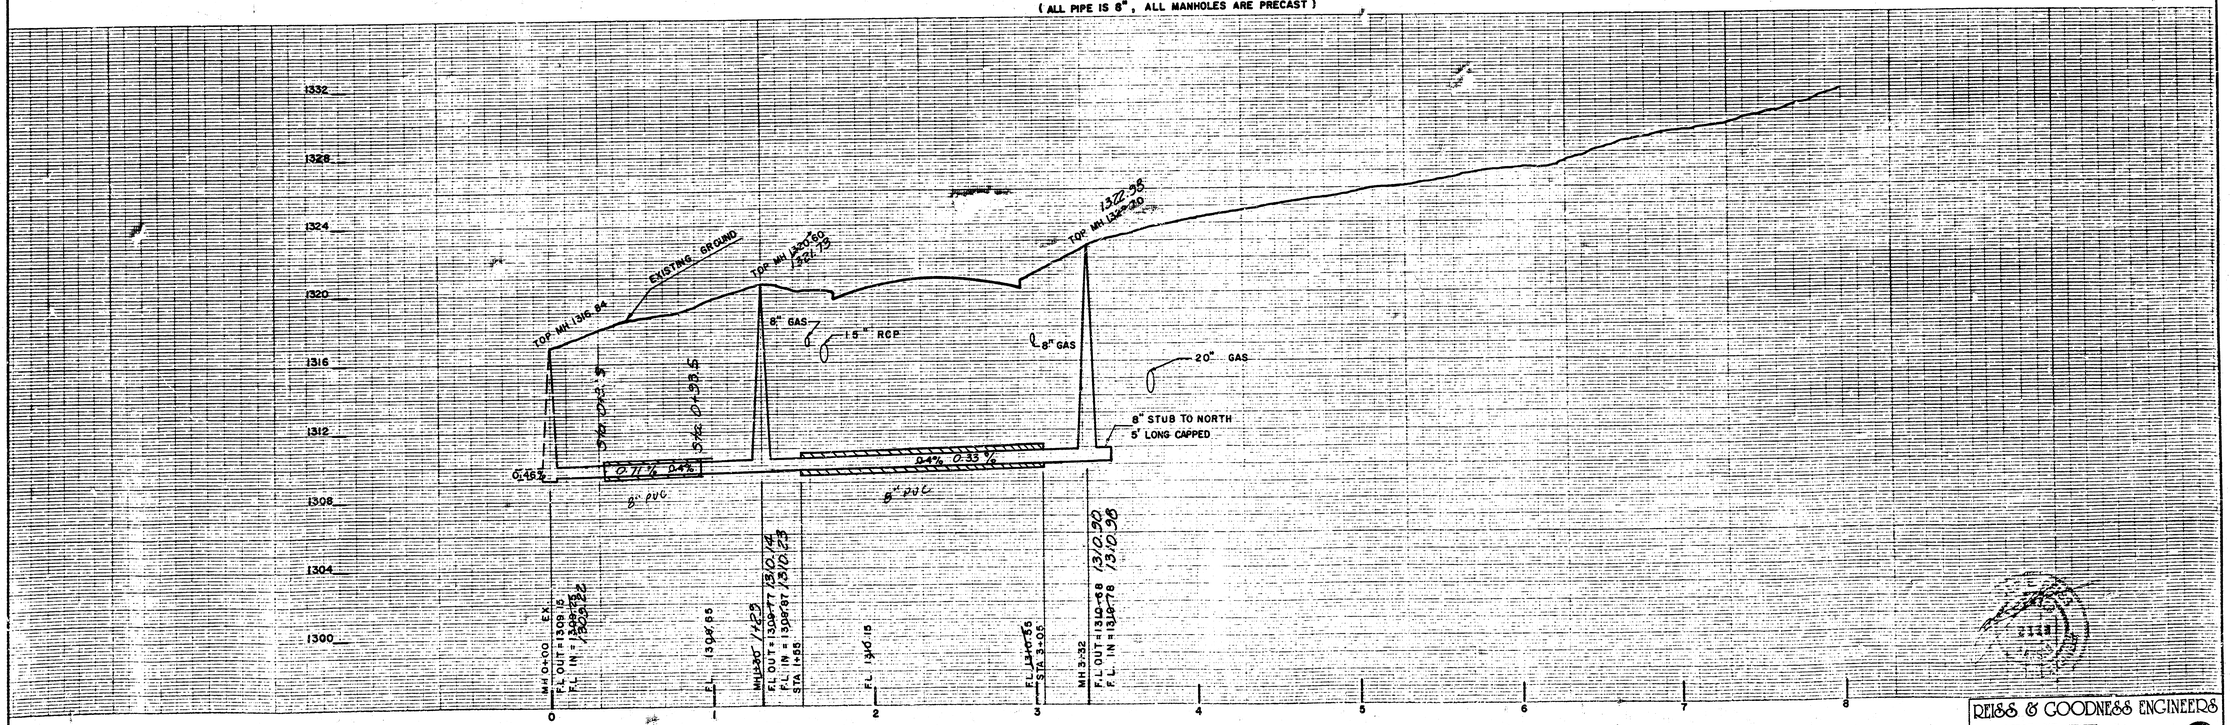

"AS CONSTRUCTED"

REISS & GOODNESS ENGINEERS
2160 WEST 21st STREET
WICHITA, KANSAS 67204
(316) 832-0213

2/2

REVISION		DRAWN BY		CHECKED BY	DESIGNED BY	PROJECT	CUSTOMER	SCALE	PROJECT NO.
						SANITARY SEWER EXTENTION	JACK CALDWELL ONE	DATE	SHEET 2 OF 3

FILMED FROM THE BEST AVAILABLE COPY