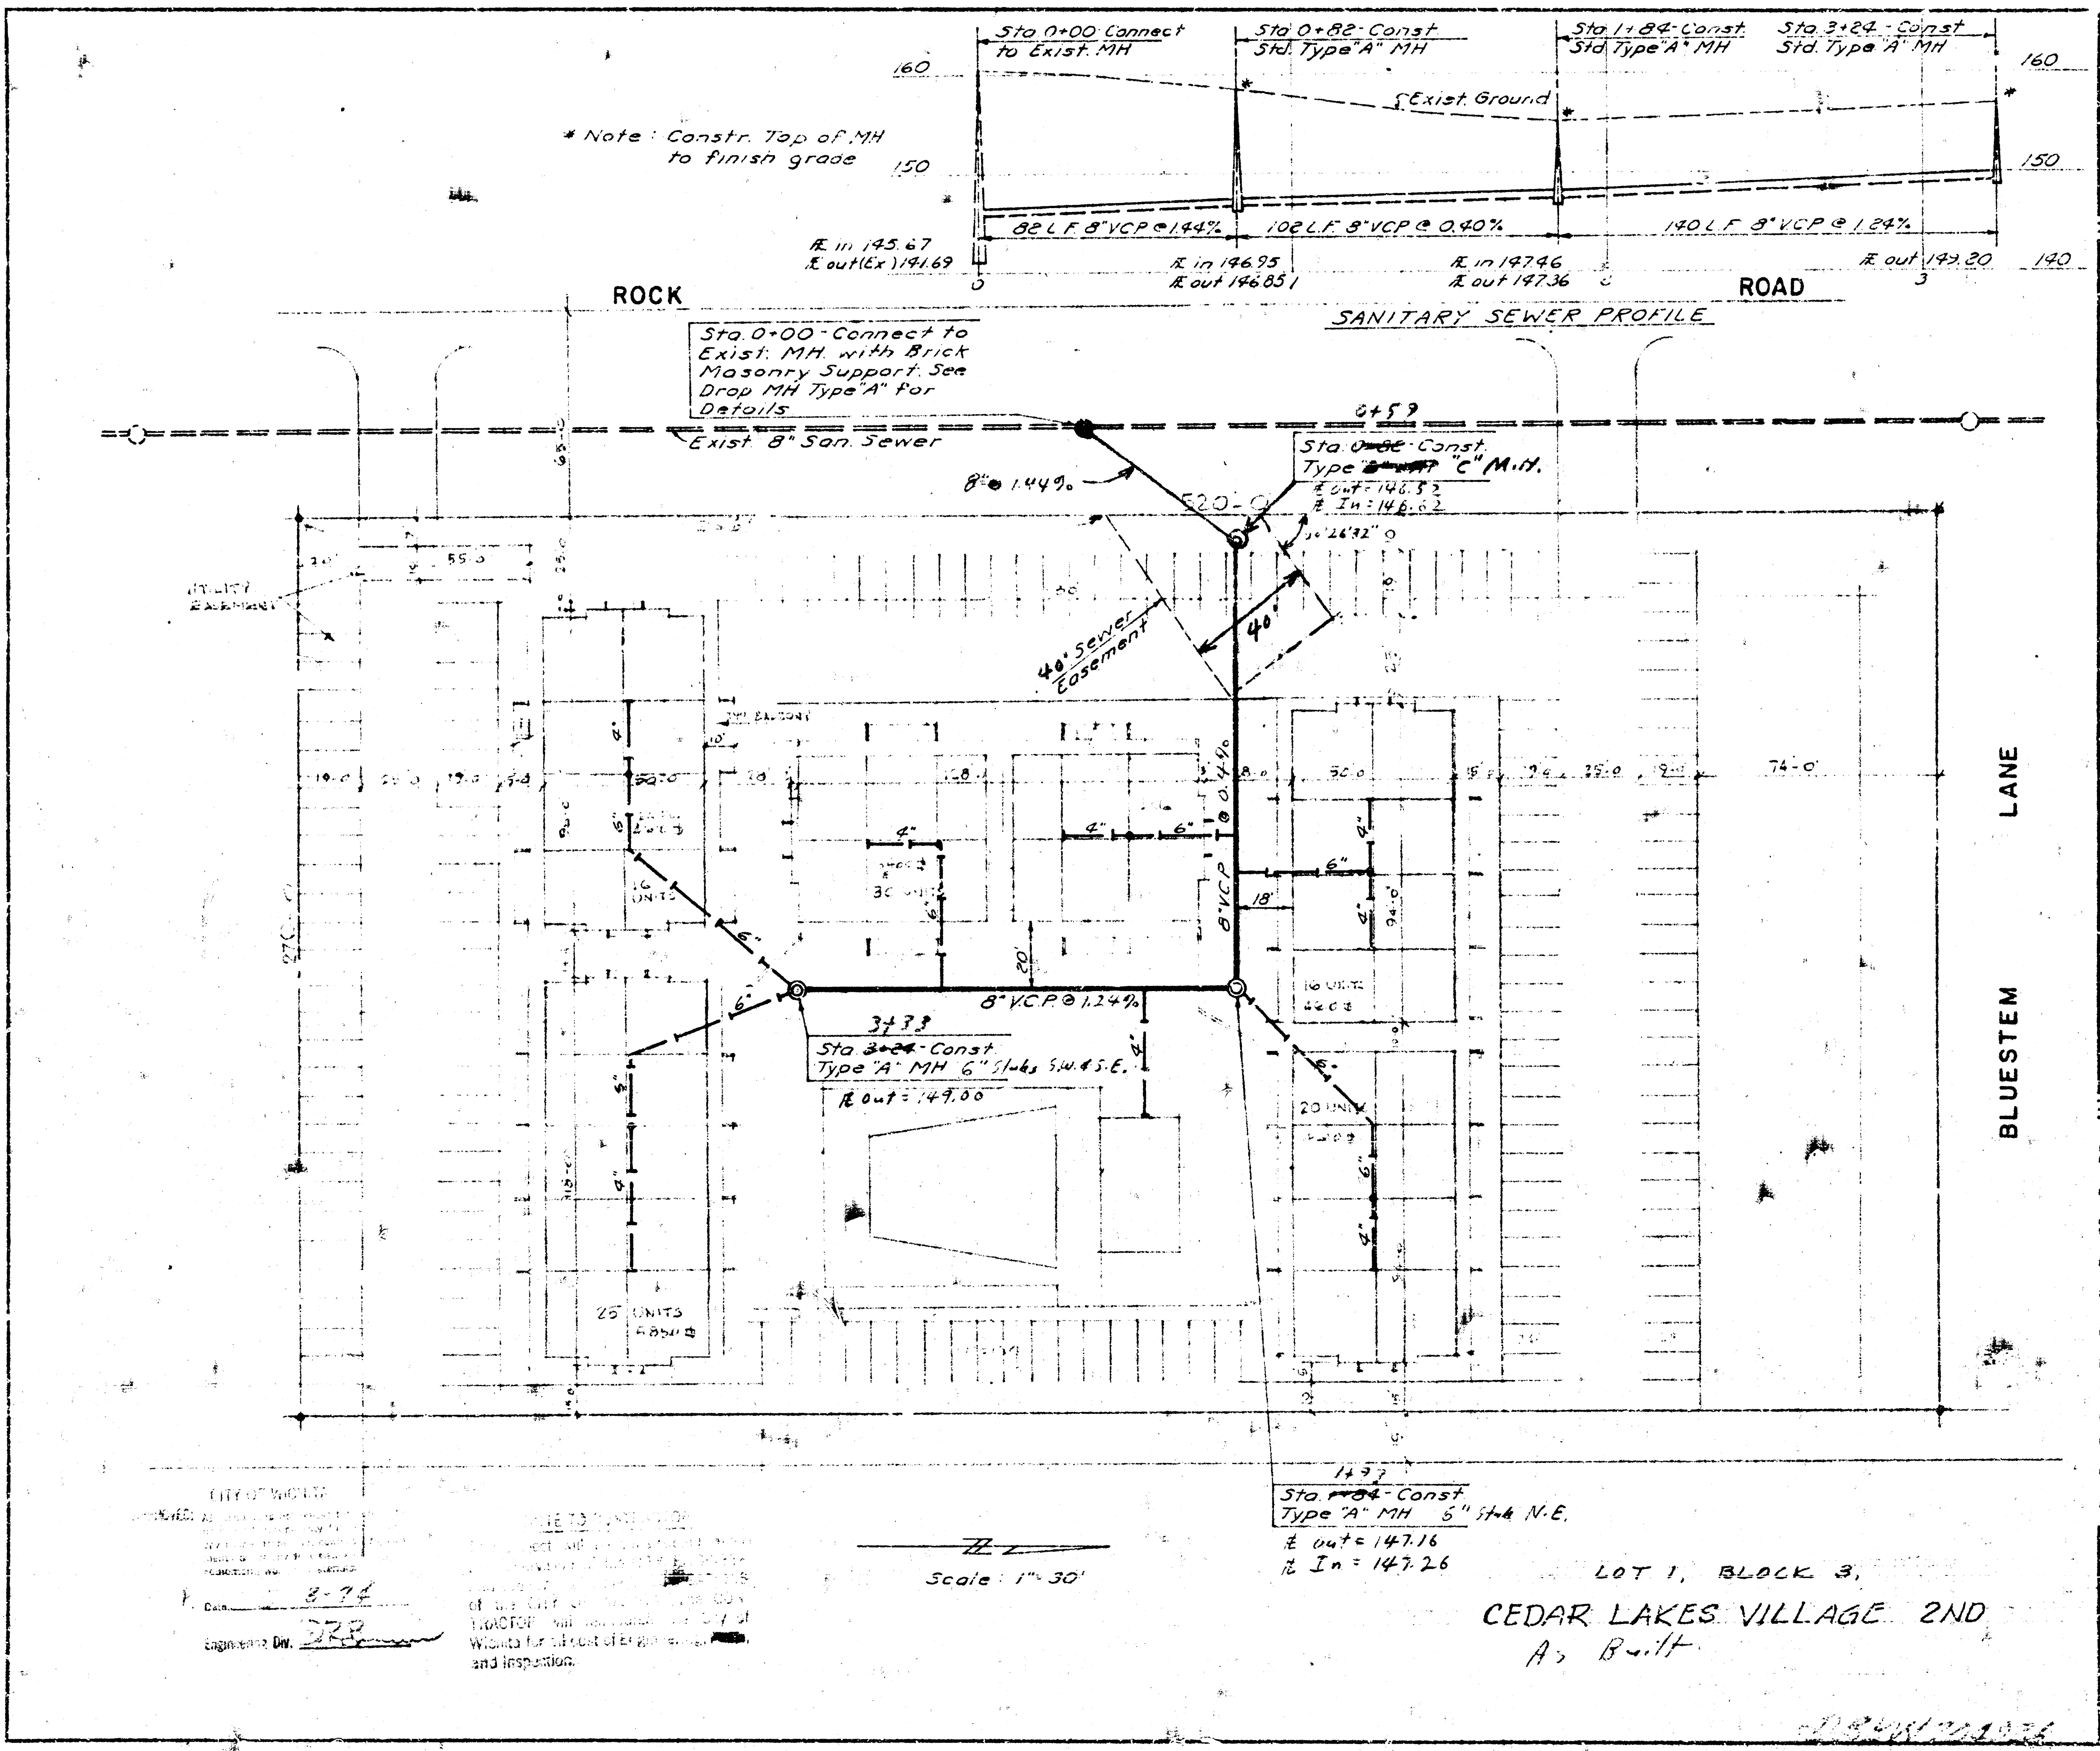

CITY OF WICHITA

Date 8-74

Engineering Div. DRB

NOTE TO CONTRACTOR

of the CITY ... CONTRACTOR will ... City of Wichita for all cost of Engineering and Inspection.

LOT 1, BLOCK 3,

CEDAR LAKES VILLAGE 2ND

As Built

DICK BRABHAM
ARCHITECT WICHITA, KS

DATE:

SHEET 3 OF

 

Use @ Sta 0+00