


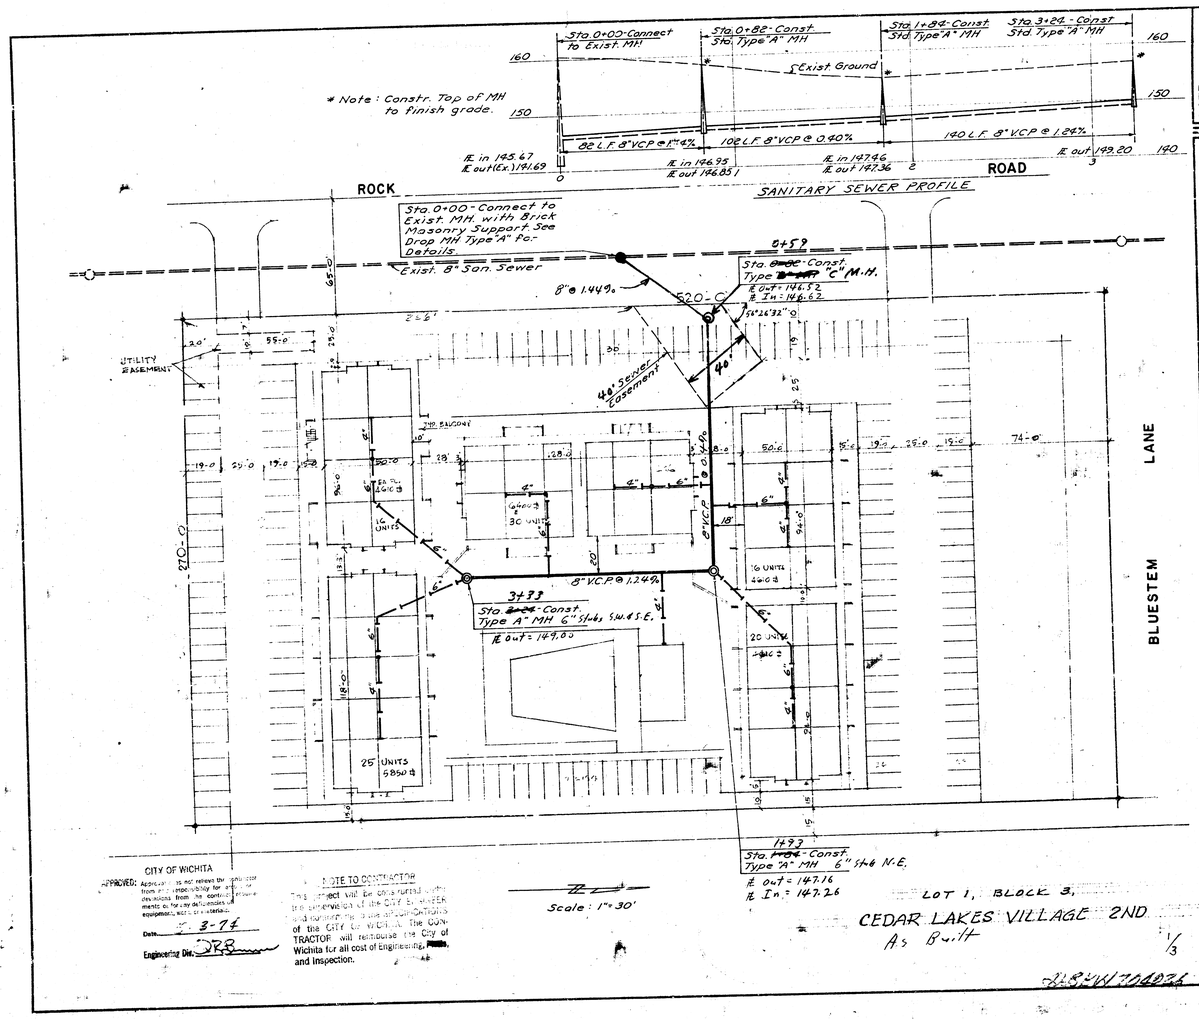


FILMED FROM THE BEST AVAILABLE COPY

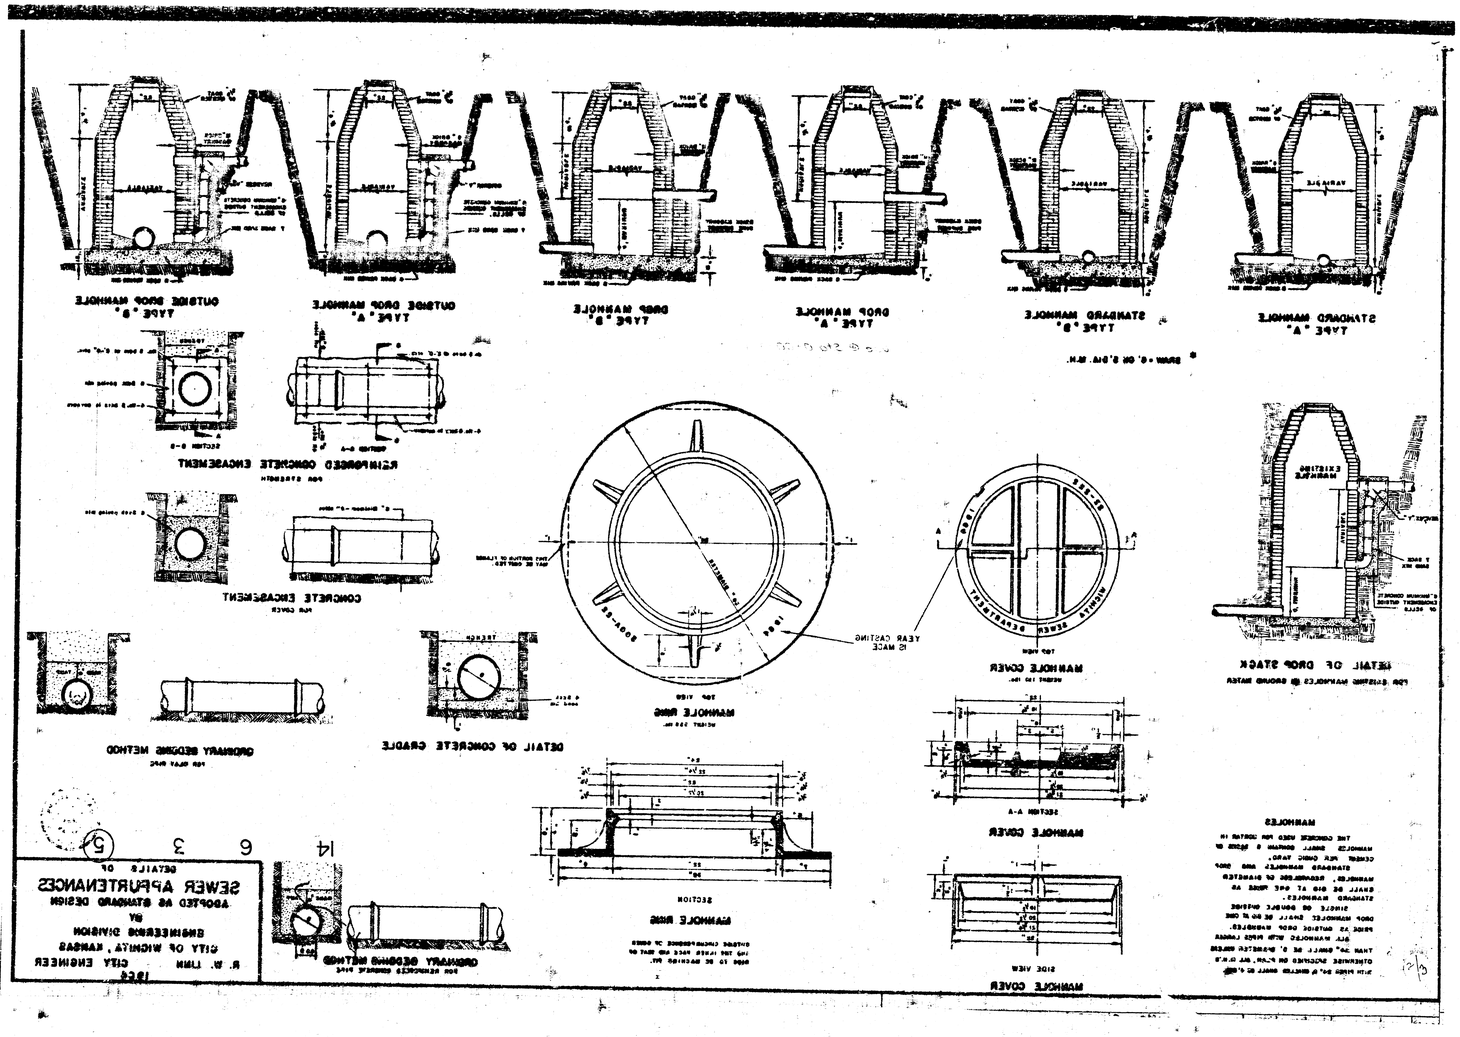

FILMED FROM THE BEST AVAILABLE COPY

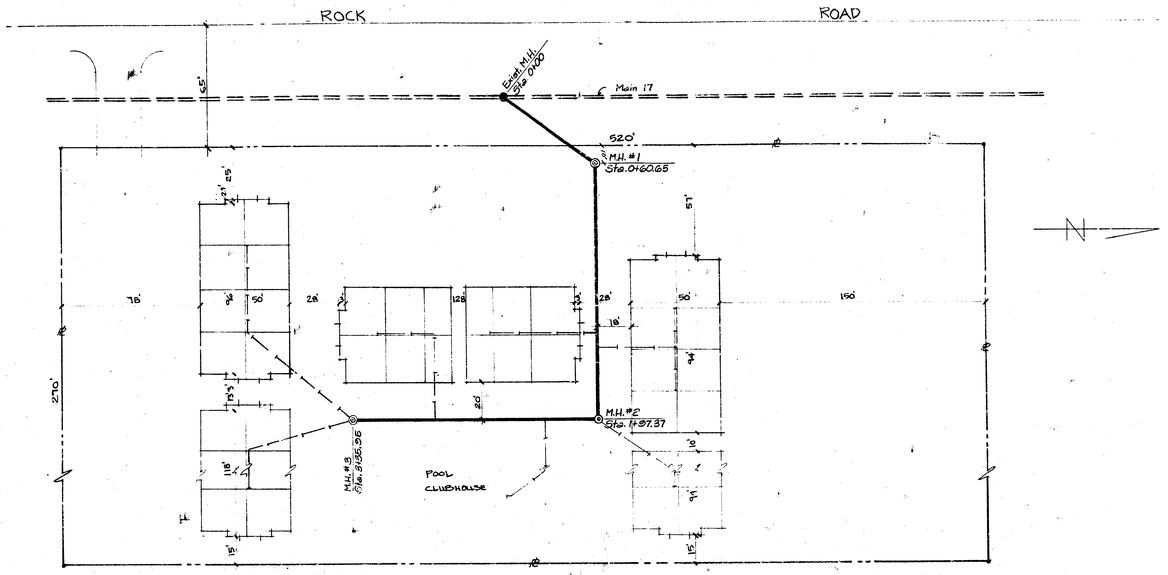

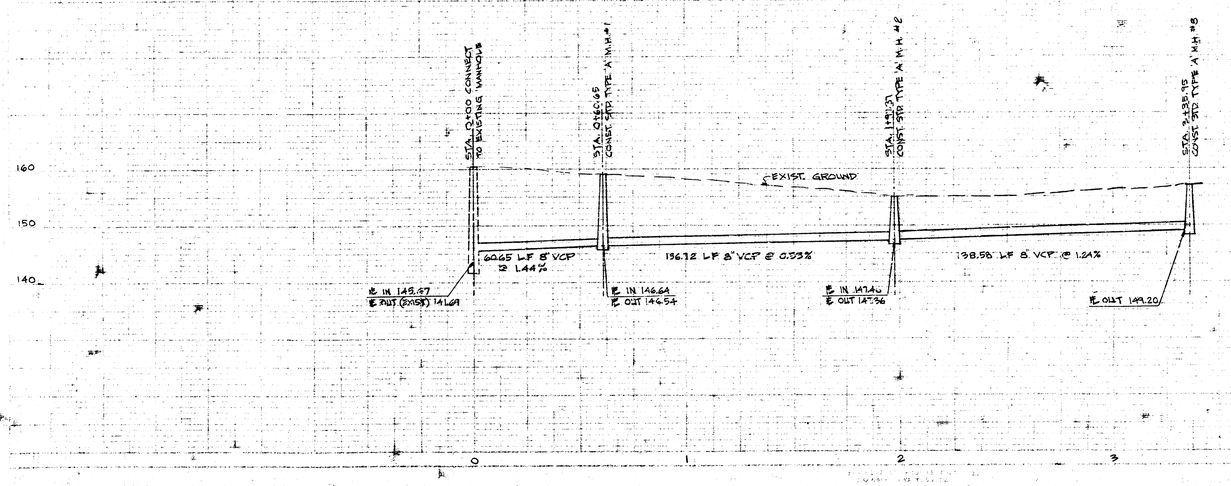

AS BUILT PLAN FOR
CEDAR LAKES VILLAGE APARTMENTS

June, 6, 1975

3/3

FILMED FROM THE BEST AVAILABLE COPY....