TOPOGRAPHIC MAP
CESSNA AIRCRAFT PROPERTY
PAWNEE PLANT
WICHITA, KANSAS
SCALE: 1" = 300'

H. R. HUNTER — CONSULTING ENGINEERS
WICHITA, KANSAS
MAY 1958

REVISED: SEPT. 1959
JULY 1961
APRIL 1962

ACREAGE		
AREA	A	LOCATION
1	405	S OF PAWNEE (320 + 80 + 5)
2	54.07	S OF KTP N OF PAWNEE
3	162.35	W ADD'N (JOHNSTON)
4	150	N OF SERV. HANGAR
5	14.5	E OF ADDITION N OF PAWNEE
6		
TOTAL	786.42	PAWNEE COMM. DIV.

CONTOUR INTERVAL 2'

BENCH MARK
C/S HEADWALL
EL. 1349.88

S.W. COR., S.W. 1/4 SEC. 36, T.27S., R.1E.

CENTER SEC. 36, T.27S., R.1E.

N.E. COR., S.E. 1/4, SEC. 36, T.27S., R.1E.

CENTER SEC. 31, T.27S., R.2E.

W.E. COR., S.E. 1/4, SEC 31, T.27S., R.2E

S.W. COR., N.W. 1/4 SEC. 1, T.28S., R.1E.

CENTER SEC. 1, T.28S., R.1E.

S.W. COR., E. 1/2, N.E. 1/4 SEC. 1, T.28S., R.1E.

S.W. COR., N.W. 1/4 SEC. 6, T.28S., R.2E.

CENTER SEC. 6, T.28S., R.1E.

N.W. COR. SEC. 6, T.28S., R.2E.

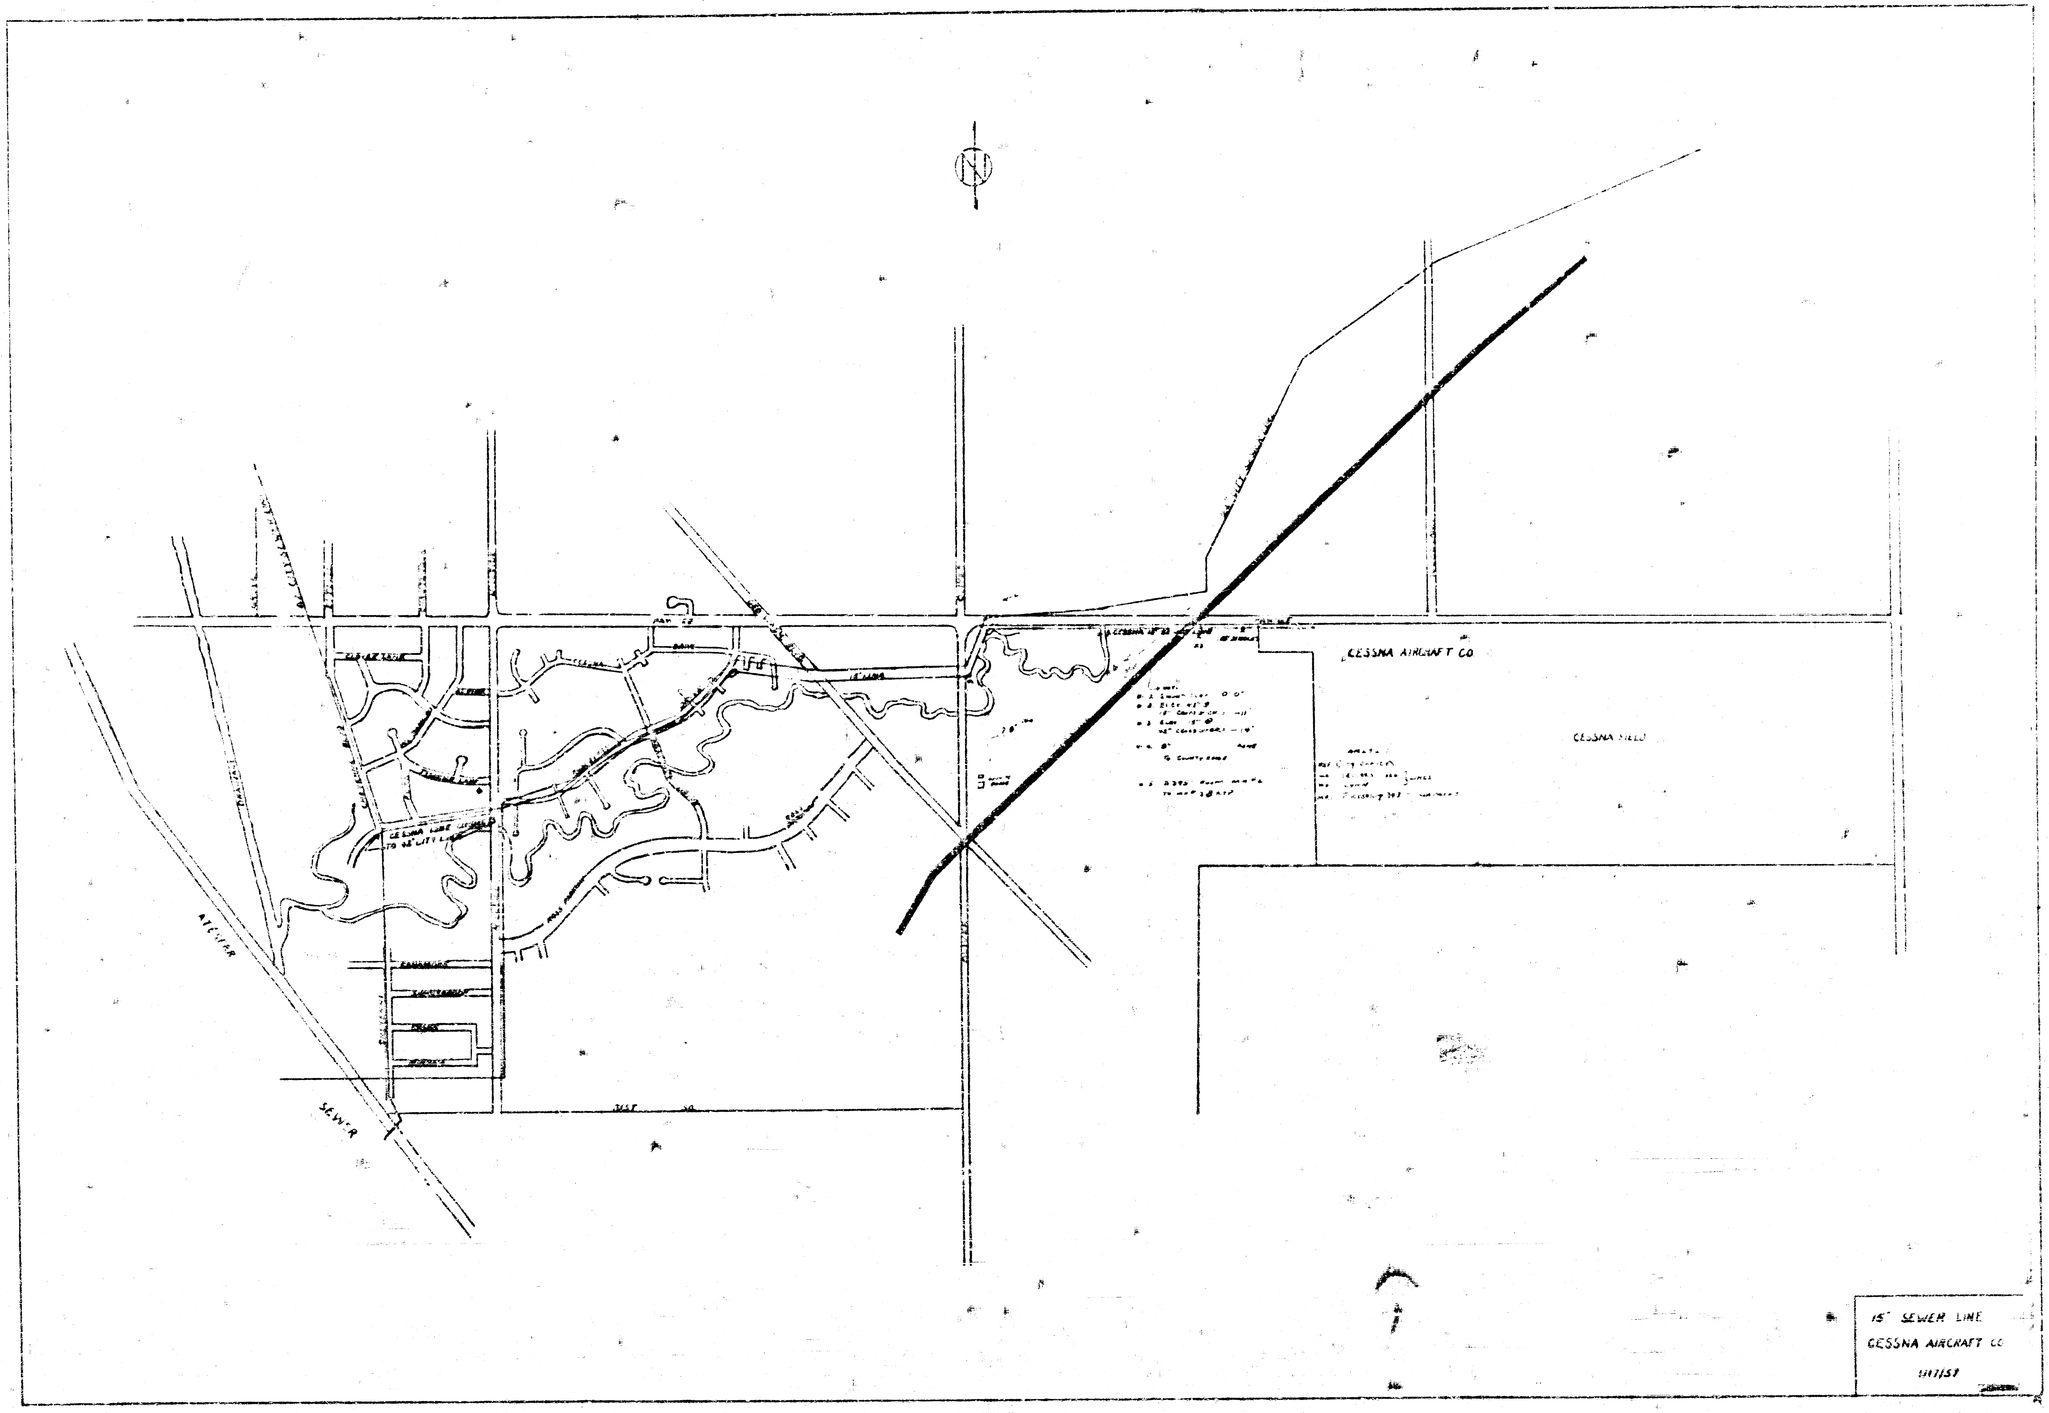
N.E. COR. NE 1/4 SEC. 6, T.28S., R.2E.

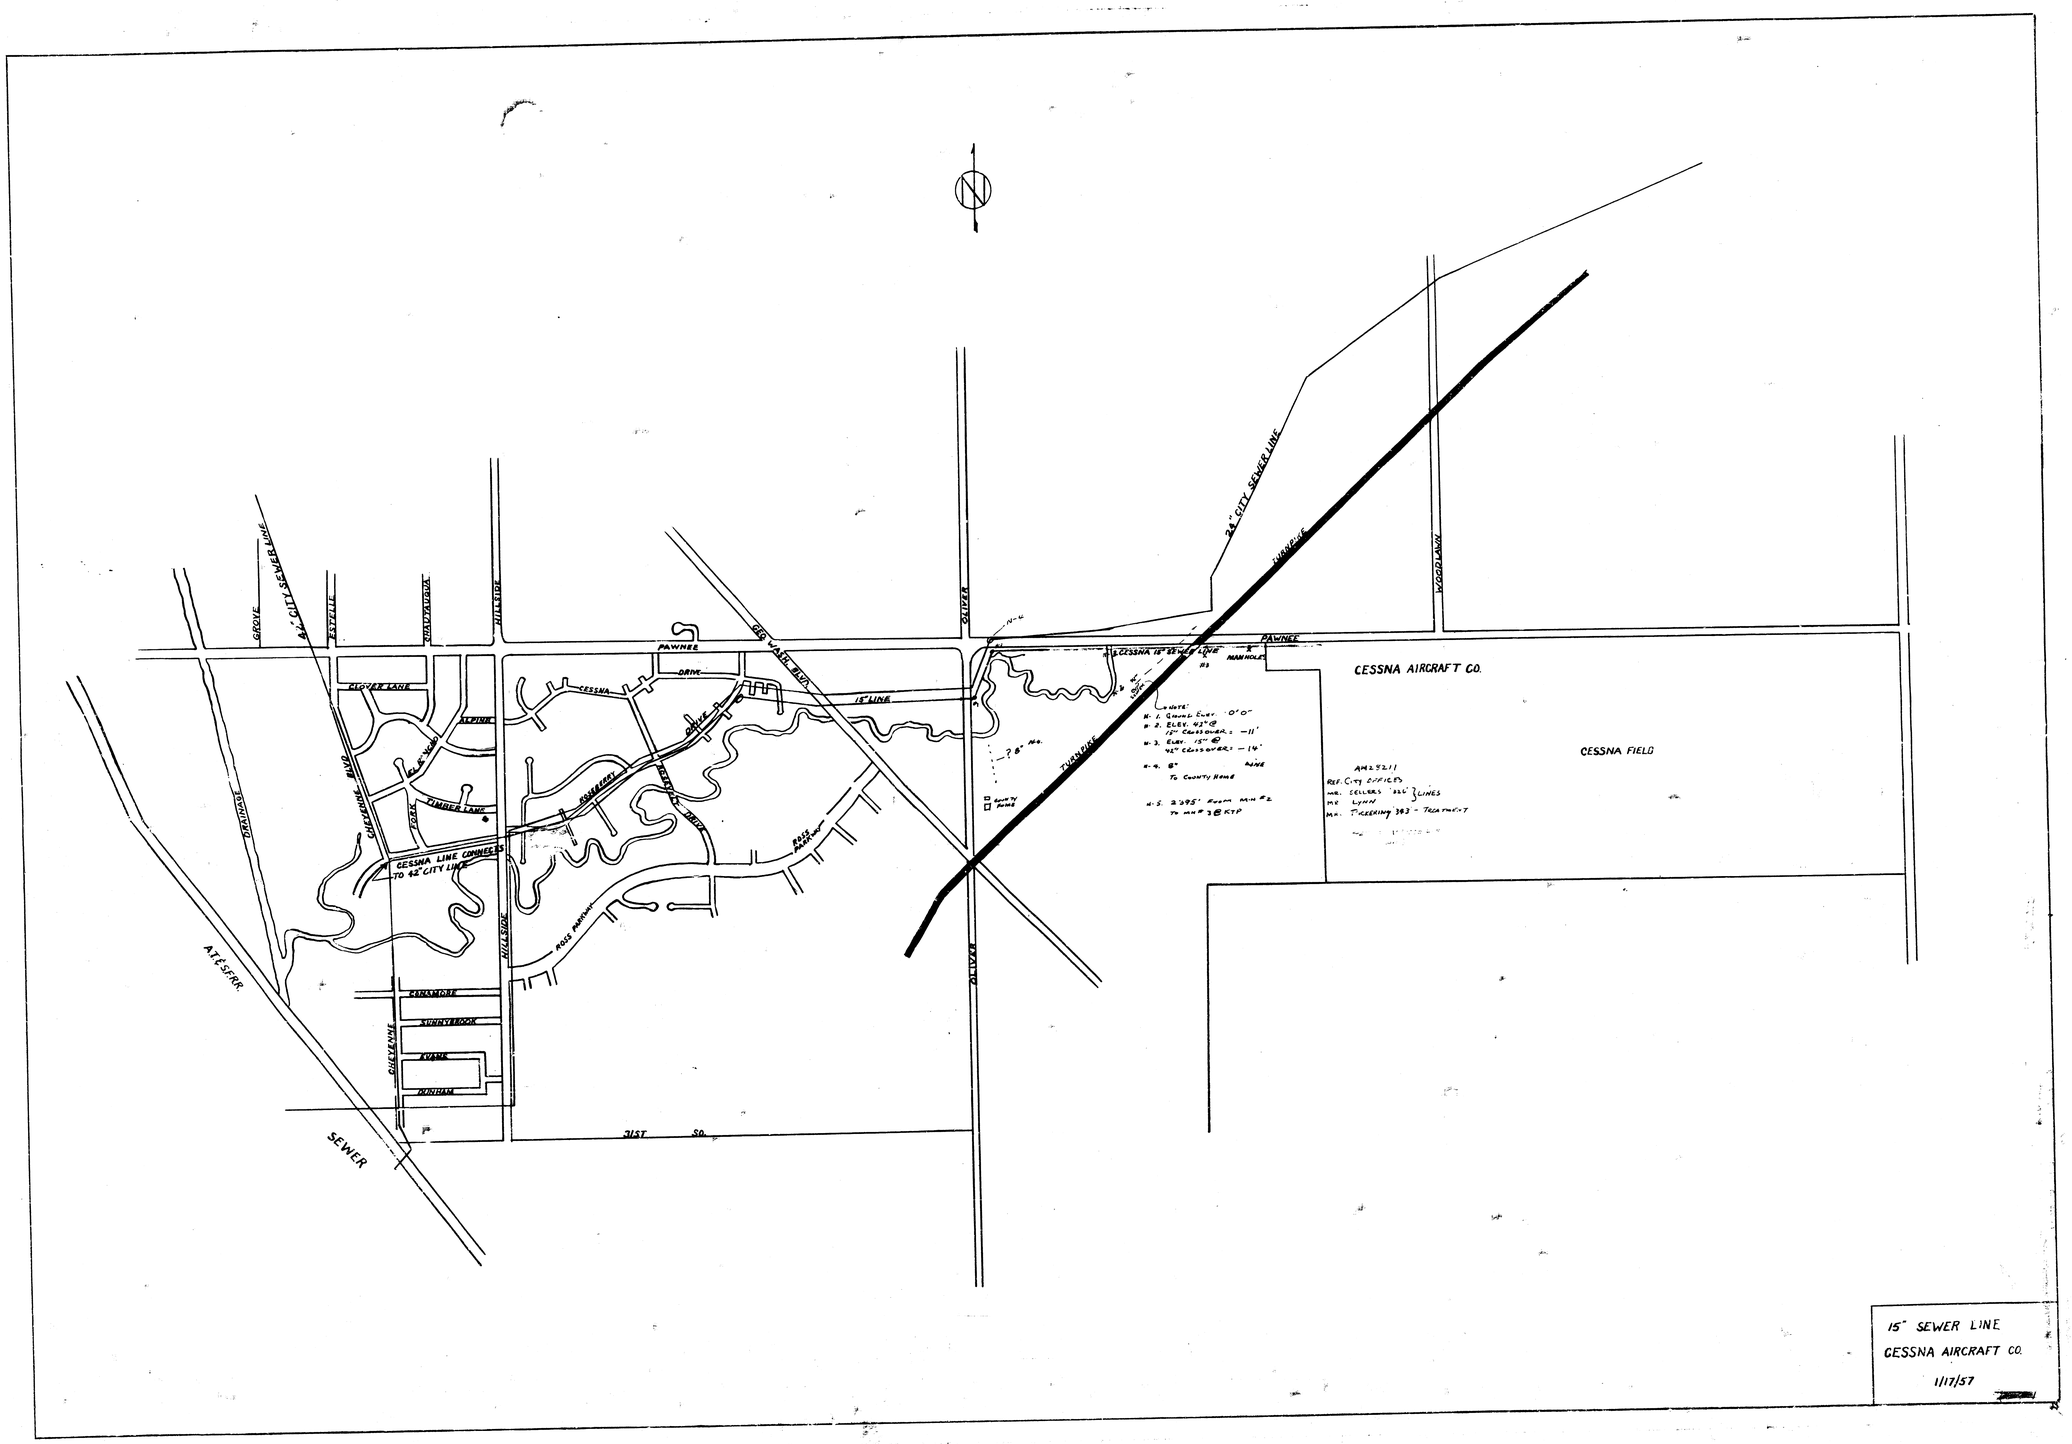
S.E. COR., N.E. 1/4 SEC. 6, T.28S., R.2E.

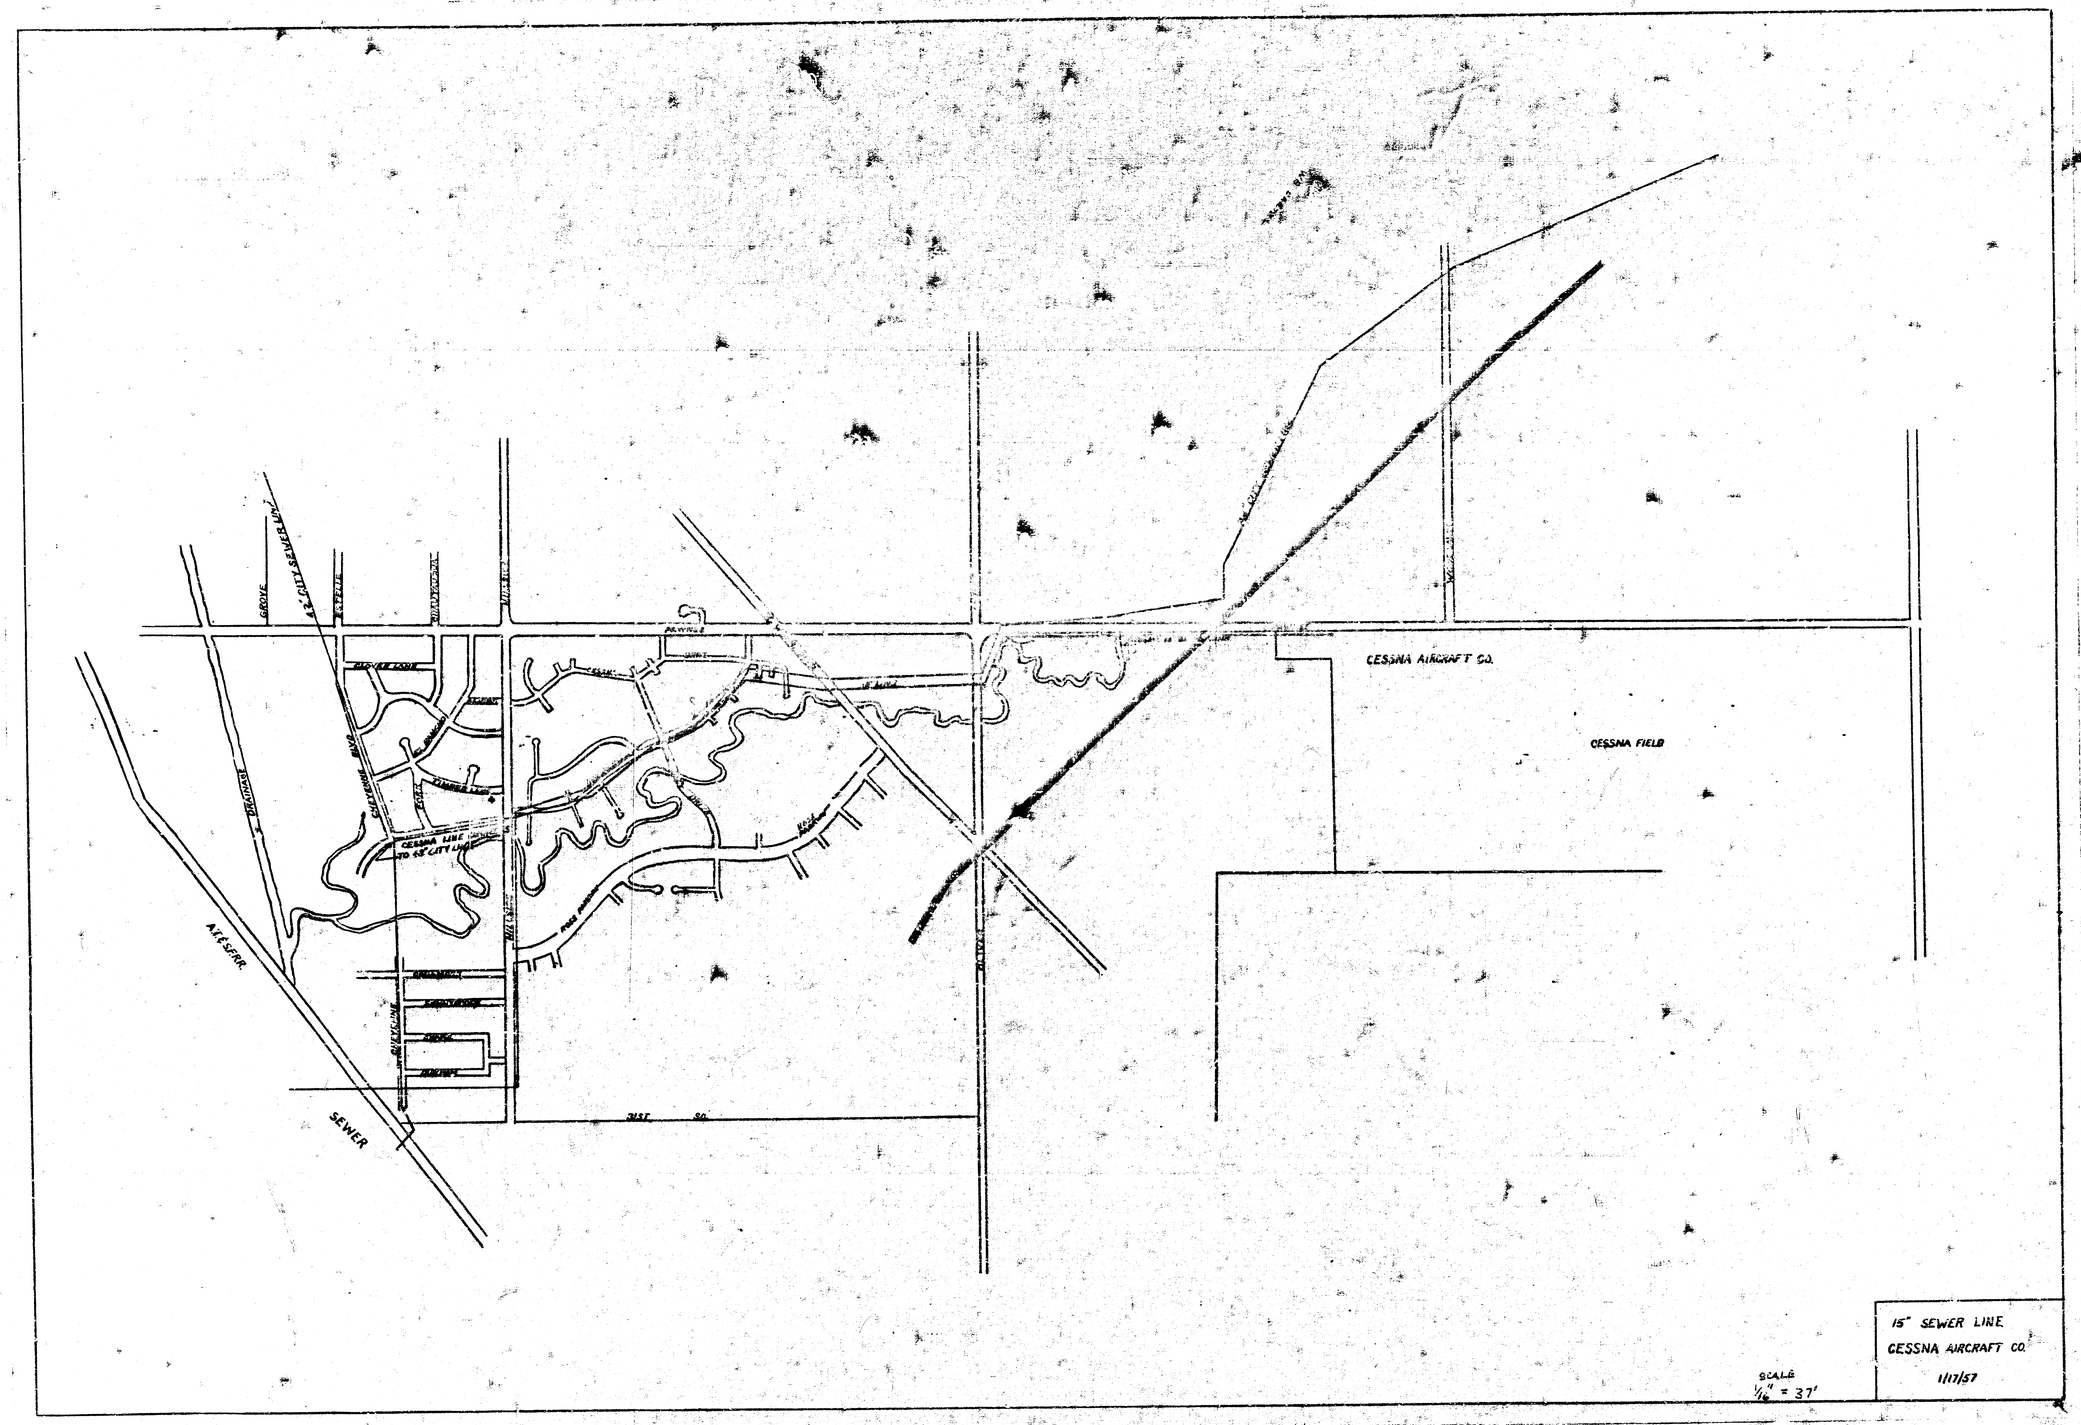
N.E. CORNER SEC. 7, T.28S., R.2E.

#1	405 A	S OF PAWNEE (320 + 80 + 5)
#2	54.07 A	INCL. PARK AREA
#3	162.35 A	
#4	150 A	
#5	14.5 A	
	320 A	
	86.13 A	
	76.22 A	
	24.8 A	DEEDED TO CITY 1960
	15.02 A	DEEDED TO CITY 1964
	6.90 ACRES	PARKING AREA
	5.0 ACRES	PARKING AREA
	80 ACRES	

PAWNEE ROAD
OLIVER
ROCK ROAD
CESSNA
PAWNEE
KANSAS TURNPIKE
ATCHISON, TOPEKA & SANTA FE
A.T. & S.F. R.R. SPUR TRACK
McCONNELL AFB
RUNWAY
ASPHALT TAXIWAY
APRON
TIE DOWN
FLY WAY
POND
WATER TOWER & BEACON
TRANSFORMER STATION
SHELTER BELT
COUNTY LINE
CITY LIMITS
ACCESS ROAD 30' R/W 20' EXPECT TO
LINE OF TRUE NORTH USC&GS 1951
SCALE 1" = 1 MILE
CONTOUR INTERVAL 2'
MEAN ANNUAL DECLINATION 1960 10° 50' EAST


CESSNA AIRCRAFT CO
CESSNA FIELD
FIFE
ATCHISON
SEWER
15" SEWER LINE
CESSNA AIRCRAFT CO
1/17/57


24" CITY SEWER LINE
GRAVITY LINE
OLIVER
WOODLAWN
PAWNEE
DRIVE
18" LINE
CESSNA
CESSNA DRIVE
CESSNA BLVD.
ROSS PARKWAY
TURNPIKE
MANHOLE
CESSNA AIRCRAFT CO.
CESSNA FIELD
AM25211
REF. CITY OFFICES
MR. SELLERS 220 } LINES
MR. LYNN
MR. PICKERING 393 - TREATMENT
NOTE:
M-1. GROUND ELEV. -0'0"
M-2. ELEV. 42"@ 15" CROSSOVER: -11'
M-3. ELEV. 15"@ 42" CROSSOVER: -14'
M-4. 8" MAIN TO COUNTY HOME
M-5. 2395' FROM MAN #2 TO MAN #3 @ K.T.P.
GROVE
ESTELLE
HILLSIDE
SKYLINE
TIMBER LANE
FOREST
ROSS PARKWAY
ATESERR
SUNNYBROOK
KWANE
DUNHAM
CHEYENNE
31ST ST.
SEWER
15" SEWER LINE
CESSNA AIRCRAFT CO.
1/17/57



SEWER LINES
W B CARTER
1224 N. Rdwy
FO 3-5363
ON 2-5-58