



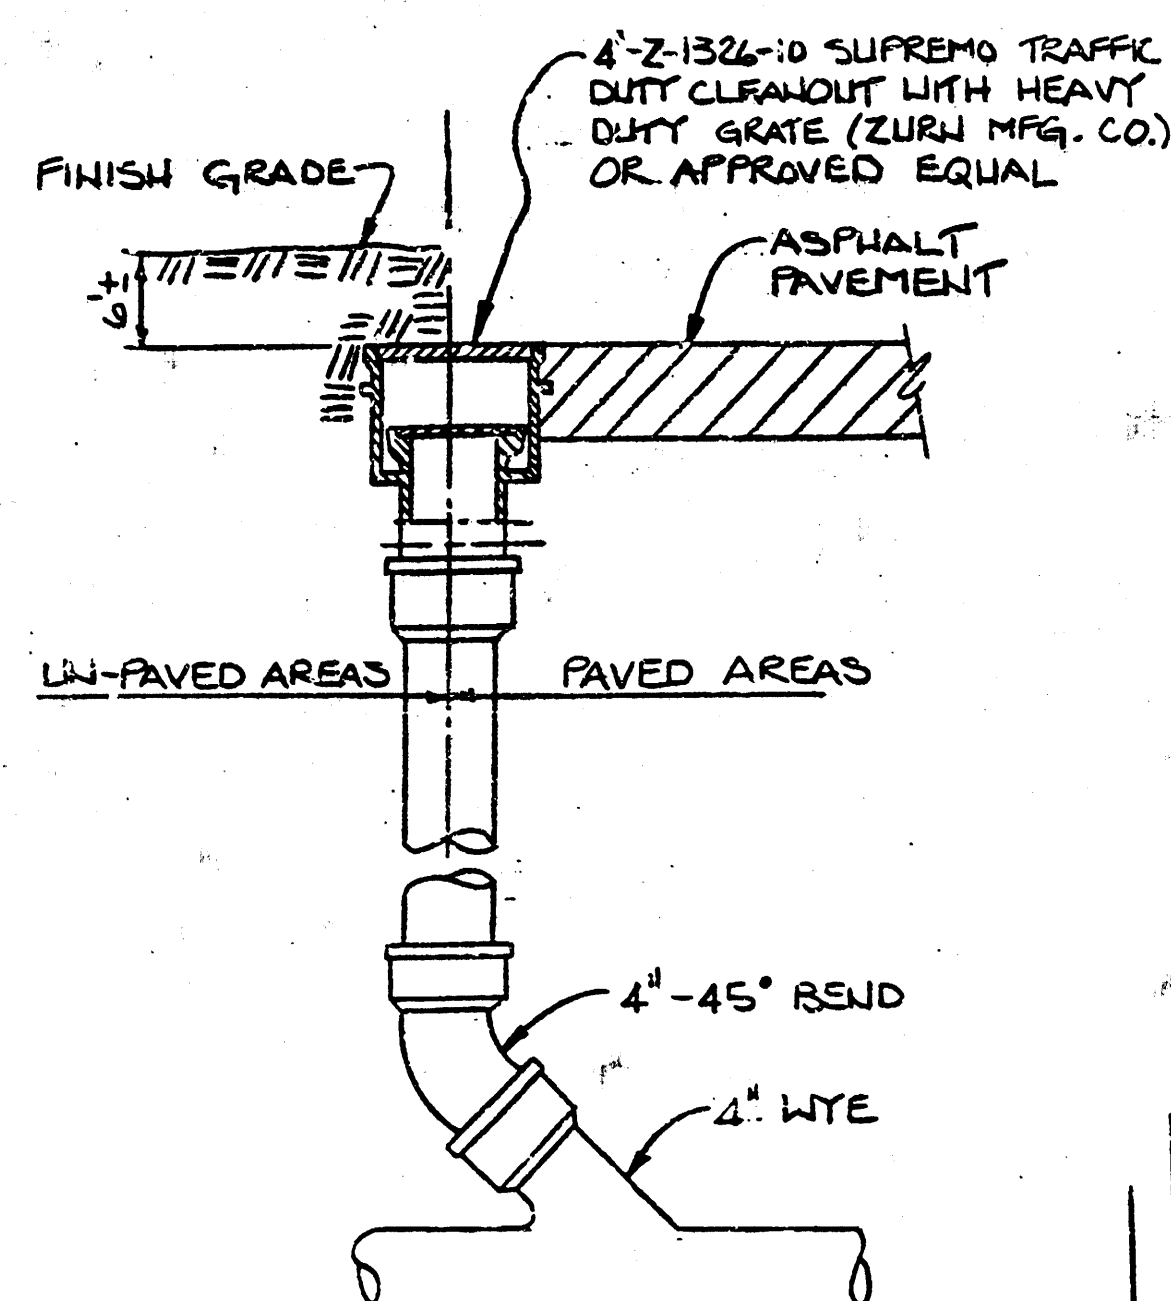


1 CLEANOUT DETAIL
N.T.S.

SANITARY SEWER NOTES:


1. ALL NEW 8" SANITARY SEWER LINE AND NEW MANHOLES TO BE CONSTRUCTED IN ACCORDANCE WITH CITY OF WICHITA STANDARDS AND SPECIFICATIONS.
2. RIM ELEVATIONS OF MH #A-1 & A-2 MAY BE ADJUSTED FROM THE TOP OF RIM (TR) ELEVATIONS SHOWN TO MATCH THE EXISTING GROUND ELEV.

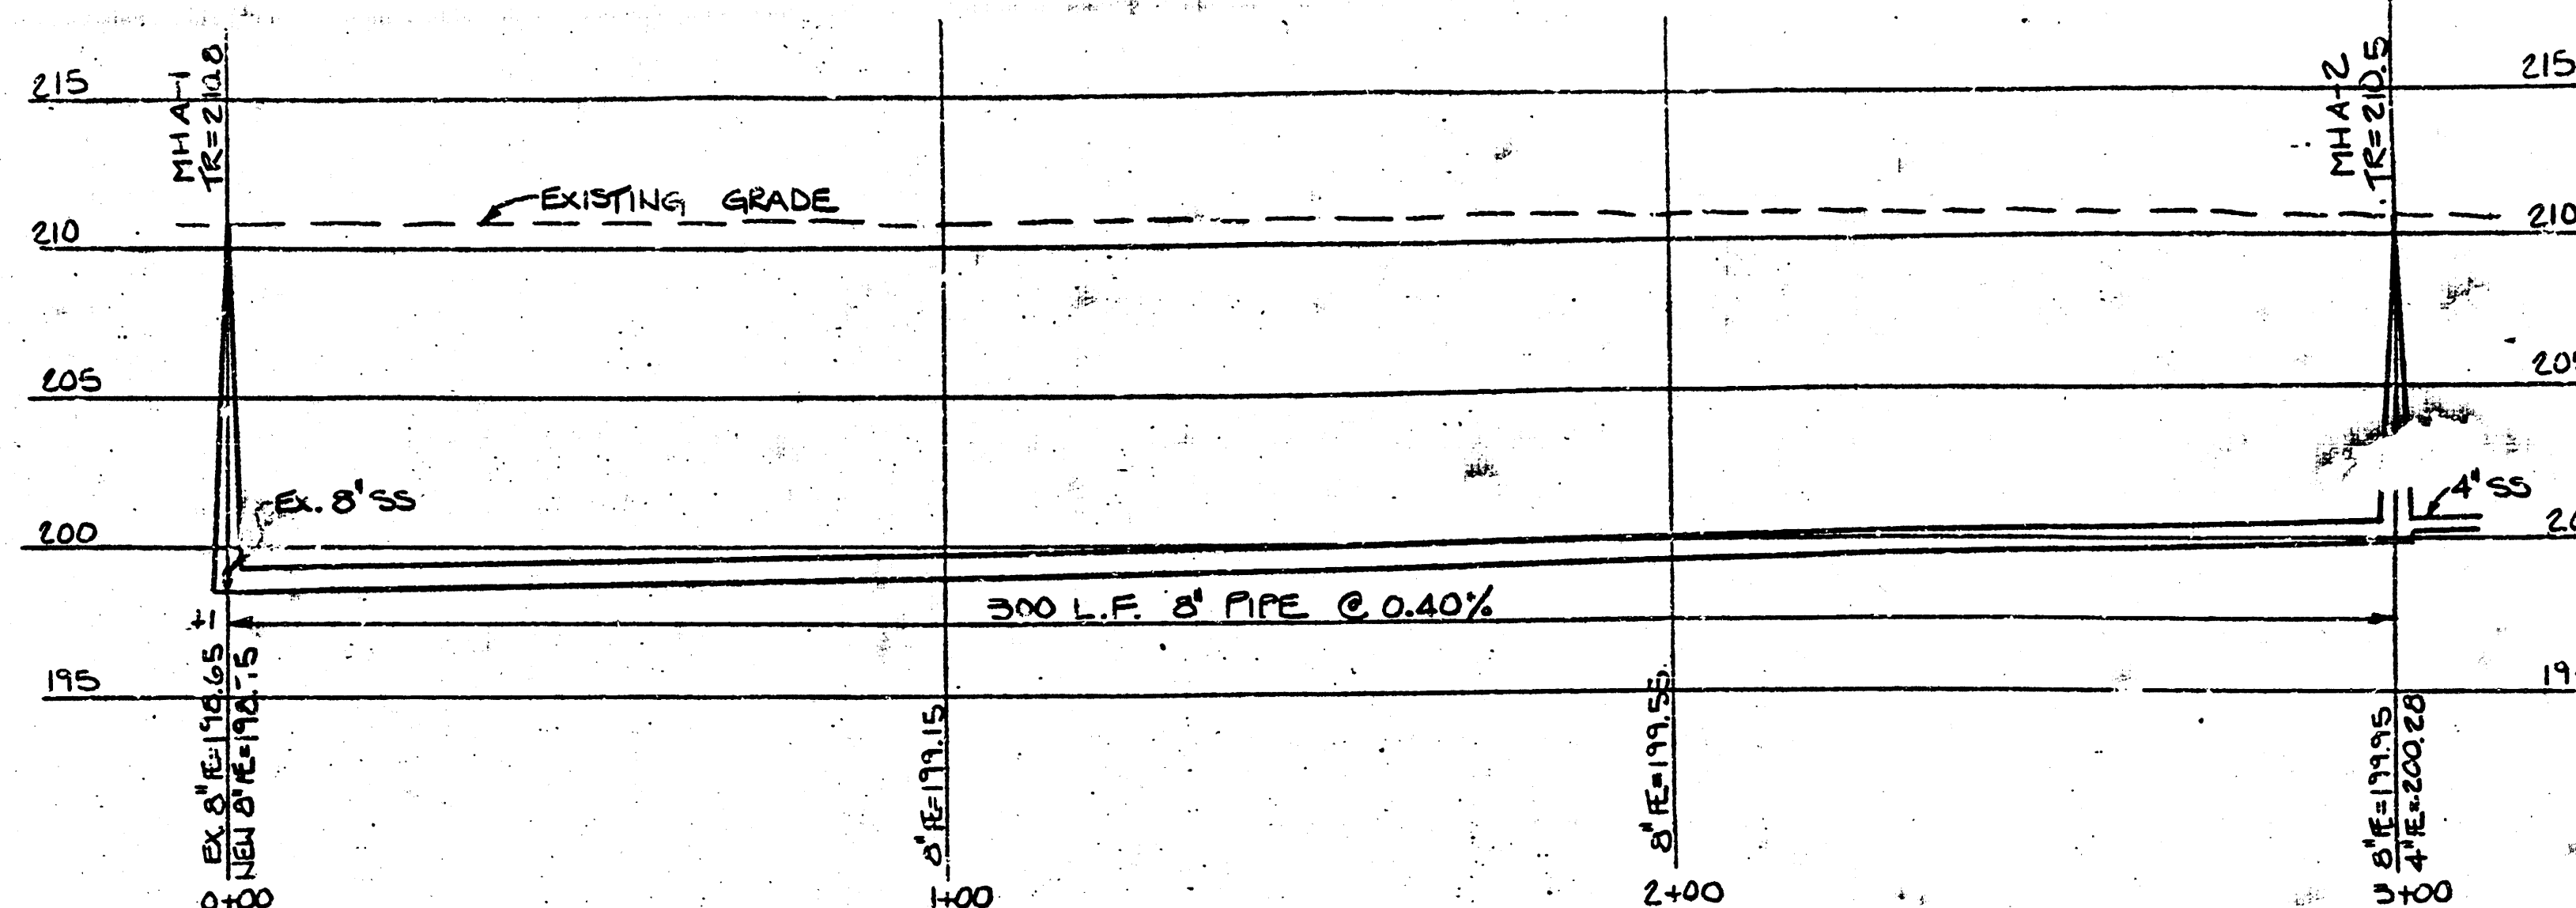

PROFILE
VERT. : 1"=5'
HORIZ. : 1"=50'

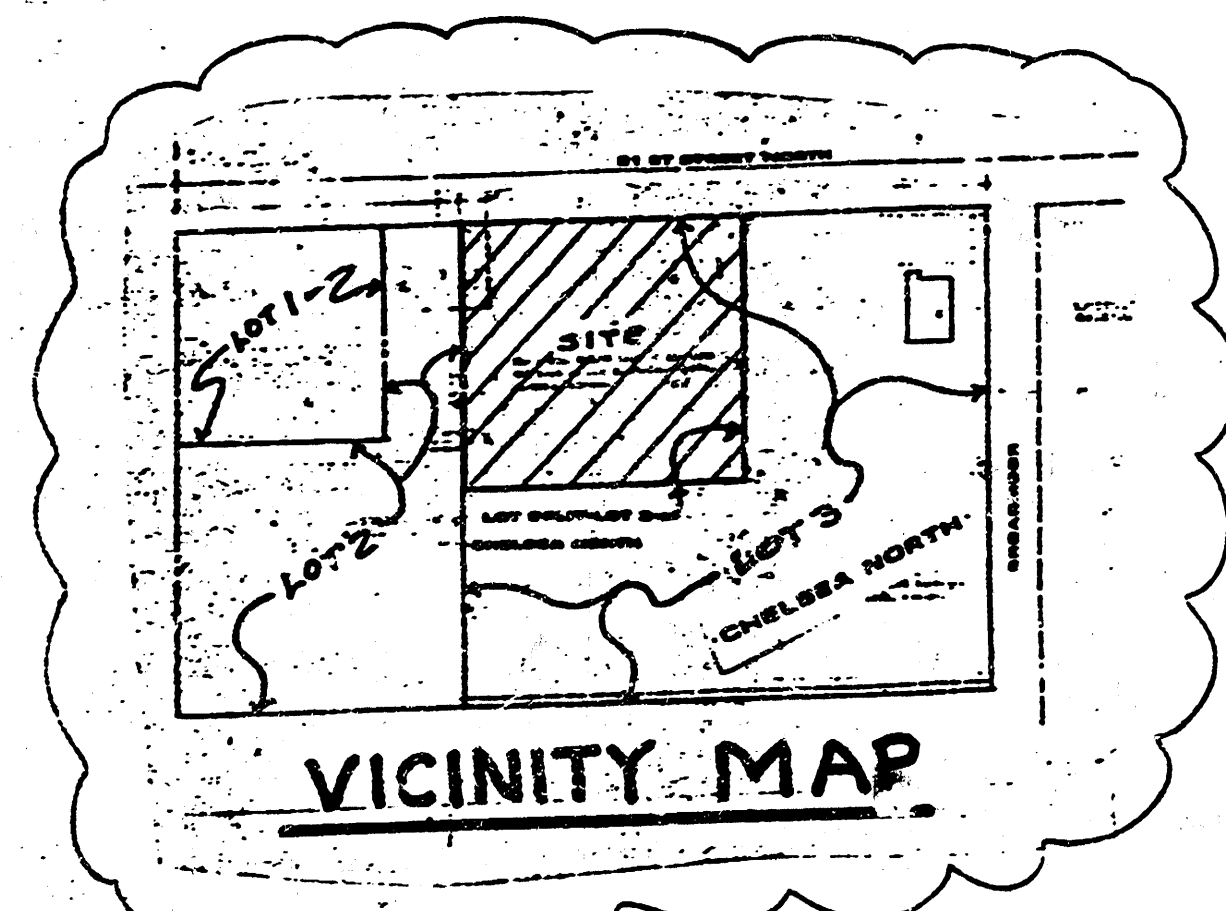


VICINITY MAP

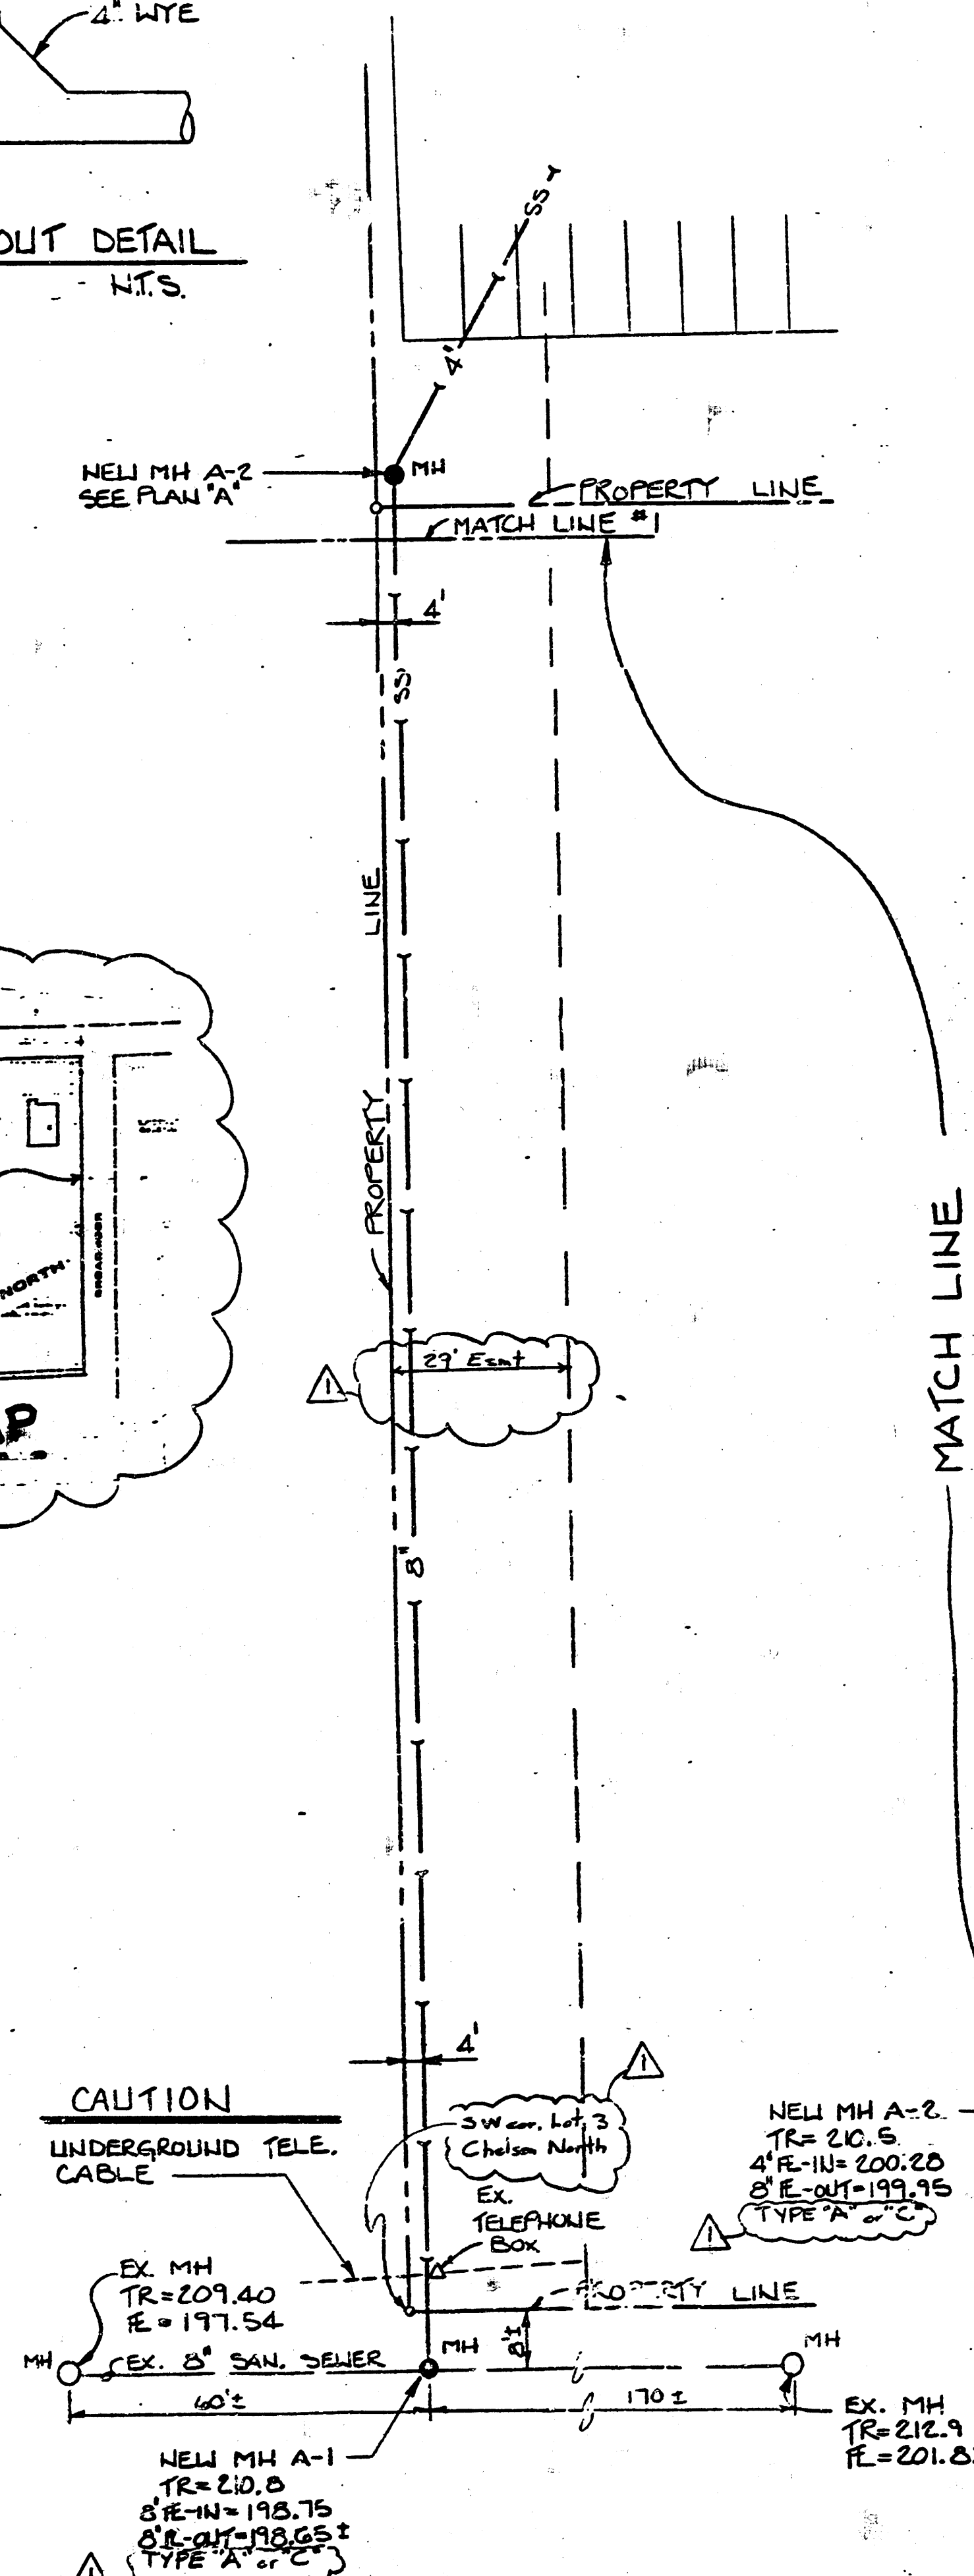

CAUTION
UNDERGROUND TELE.
CABLE

B PLAN "B"

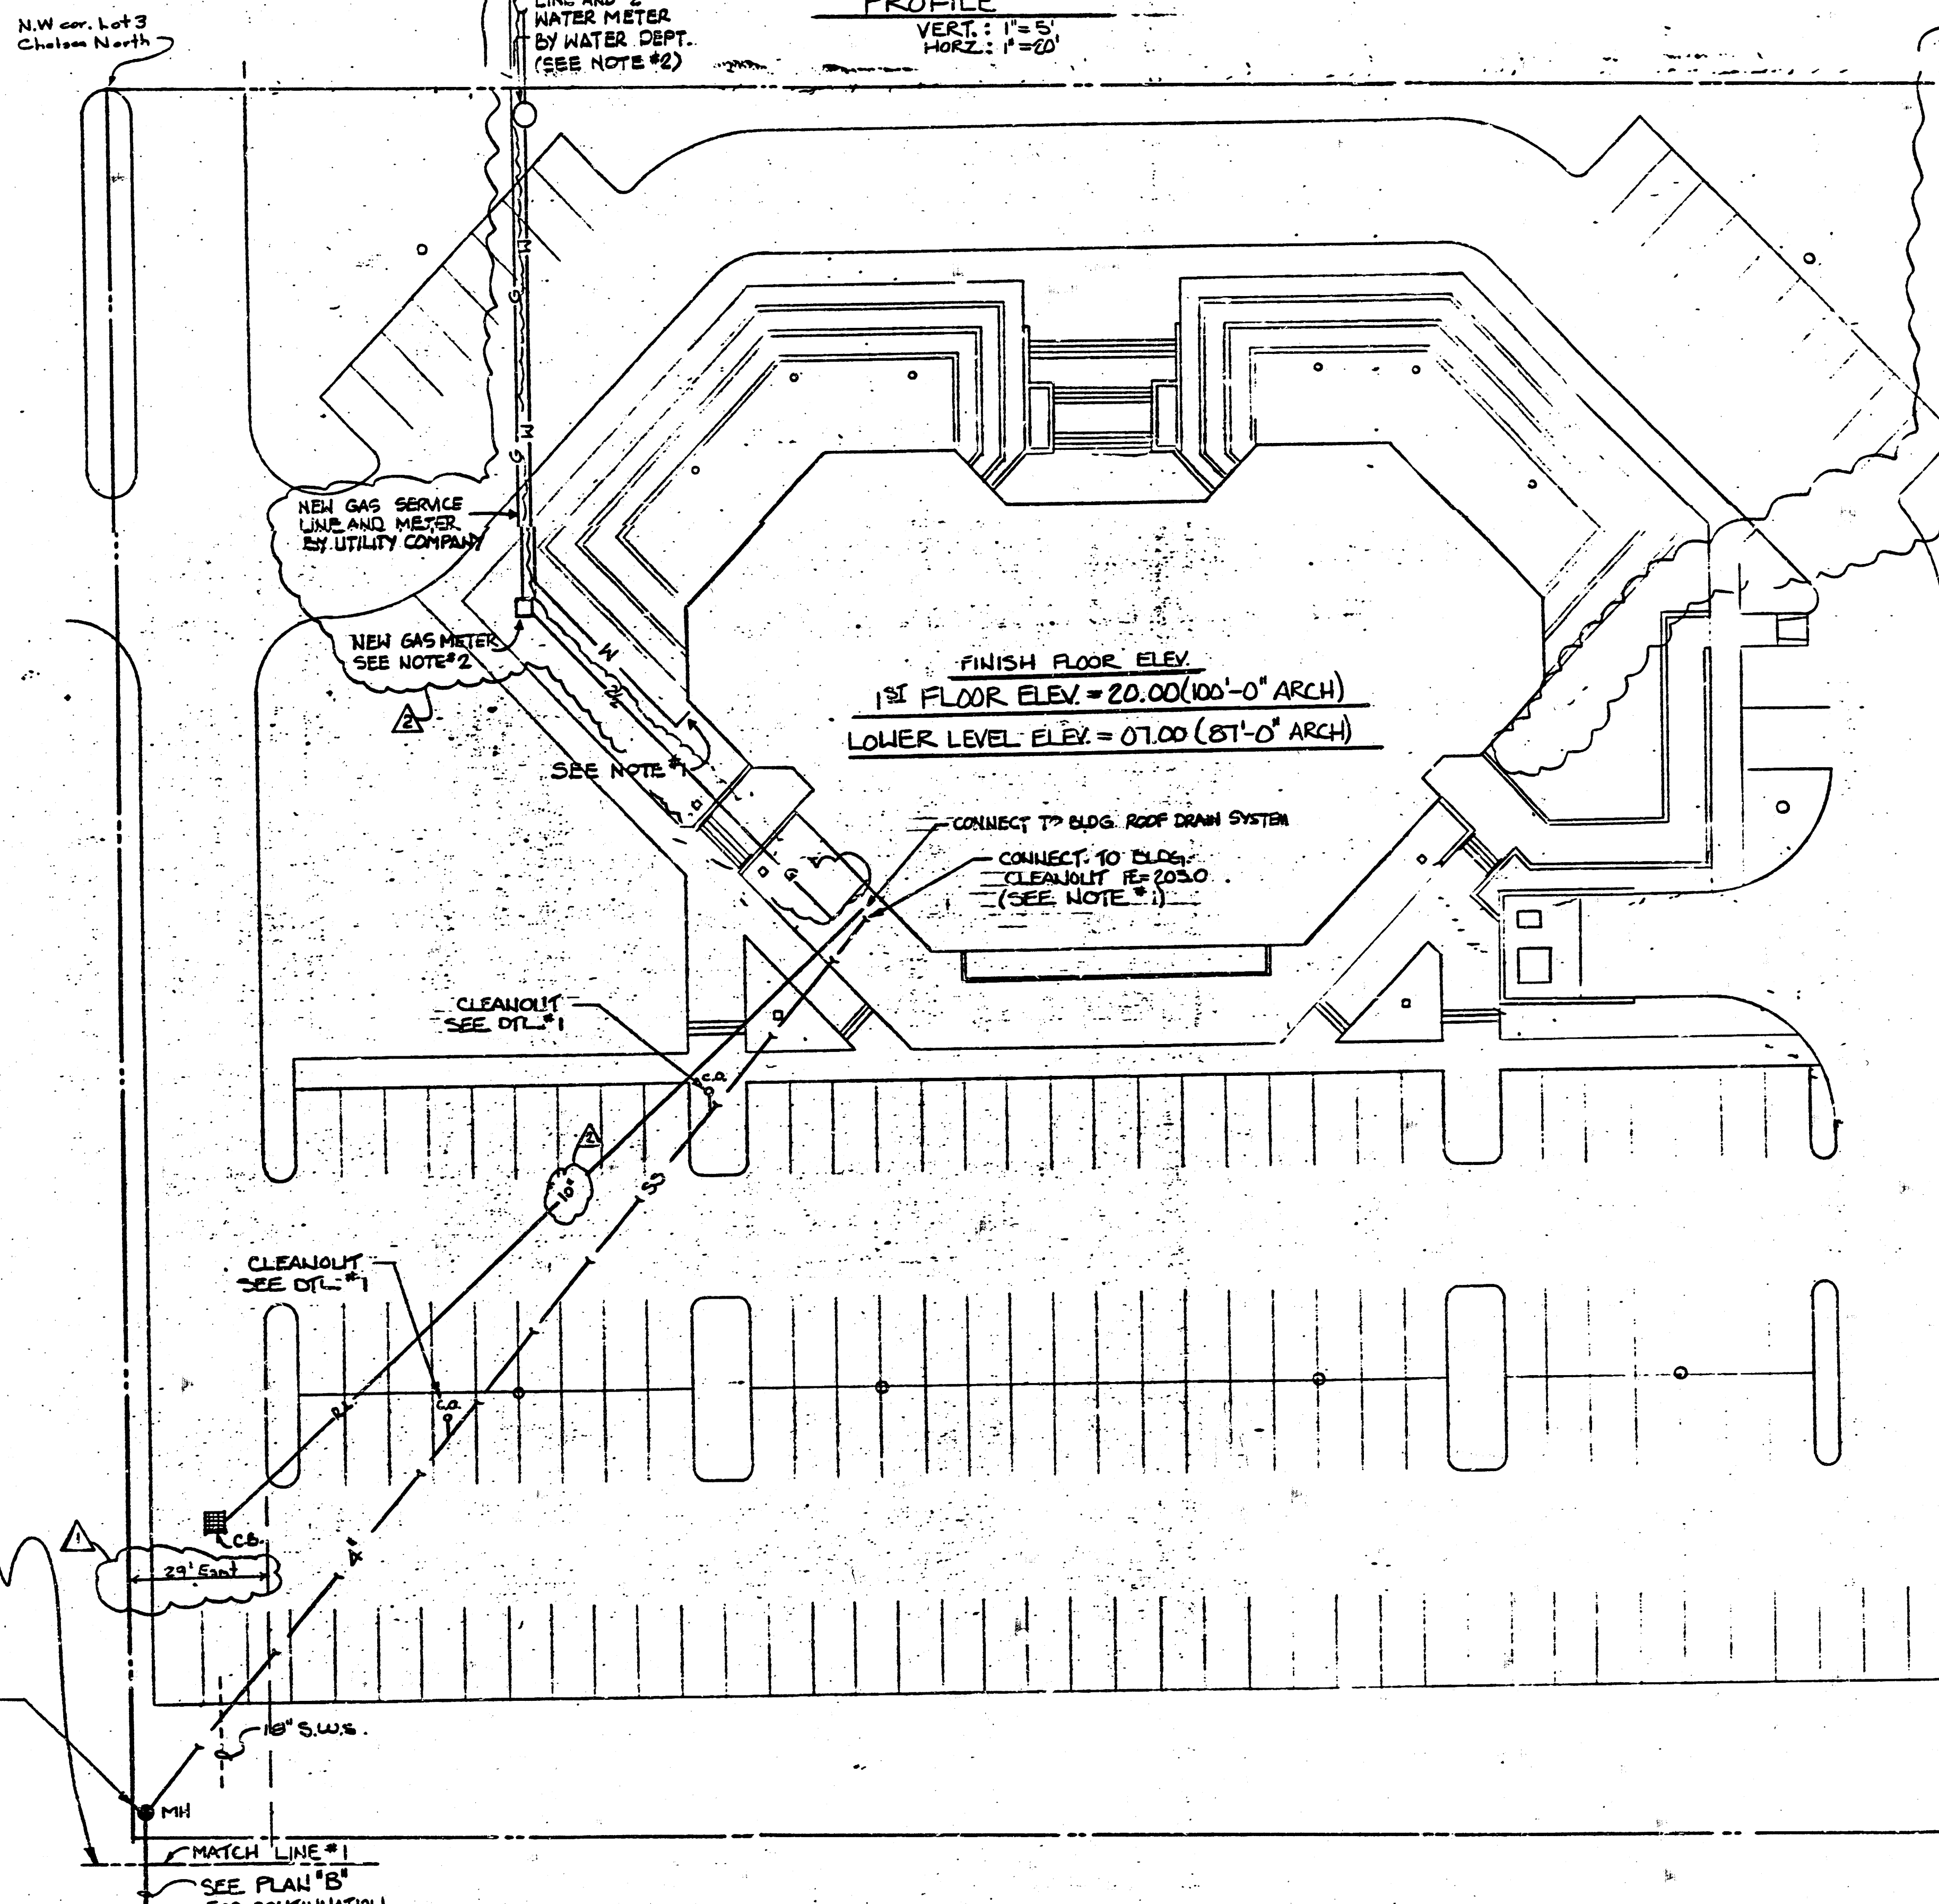

A SITE UTILITY PLAN

LEGEND

—●—	MANHOLE
—○—	CLEANOUT
—S—	NEW SAN. SEWER
—W—	NEW WATER LINE
—G—	NEW GAS LINE
—M—	GAS METER

NOTES:

1. REFER TO PLUMBING PLANS FOR EXACT LOCATION AND ELEVATION OF UTILITIES AT THE BUILDING.
2. CONTRACTOR TO COORDINATE WITH UTILITY COMPANIES TO INSTALL NEW GAS AND NEW WATER METERS. CONTRACTOR TO PROVIDE METER VAULT, PAD CONNECTIONS, ETC. AS REQUIRED BY UTILITY COMPANY.


PRINTS ISSUED

DATE	PURPOSE	NO.
7/16/04	FOR BIDS PERMIT	1
8/14/04	FOR CONSTRUCTION	2


FOR CONSTRUCTION: 8/14/04

REVISIONS

DATE	ITEM	NO.
2/28/04	PER CITY REVIEW	1
8/29/04	RELOCATED GAS METER	2

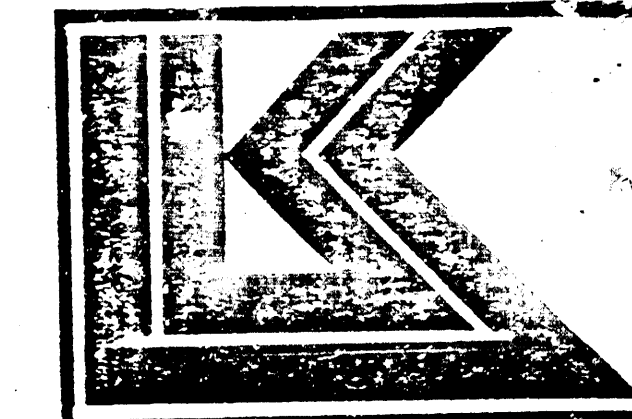

LAW/KINGDON, INC.
ARCHITECTS & ENGINEERS
345 RIVERSIDE, WICHITA, KANSAS 67203
Phone (316) 266-0250 Copyright © 1994

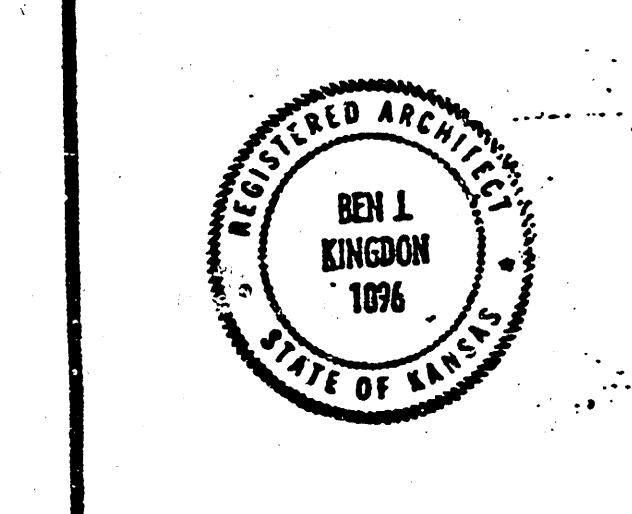


DRAWN	CHECKED
RELATED DRAWINGS	
SHELL	
DETAILS	
STRUCTURE	
MECHANICAL	
ELECTRICAL	
OTHER	
SEQUENCE NUMBER	
OF SHEETS	

**ALLIANCE LIFE
INSURANCE COMPANY
OFFICE BUILDING**
WICHITA KANSAS
PROJECT NUMBER 7442







KEY PLAN

SITE UTILITY PLAN	
SHEET TITLE	
SHEET NUMBER	
1/2	SU-1
OF SHEETS	

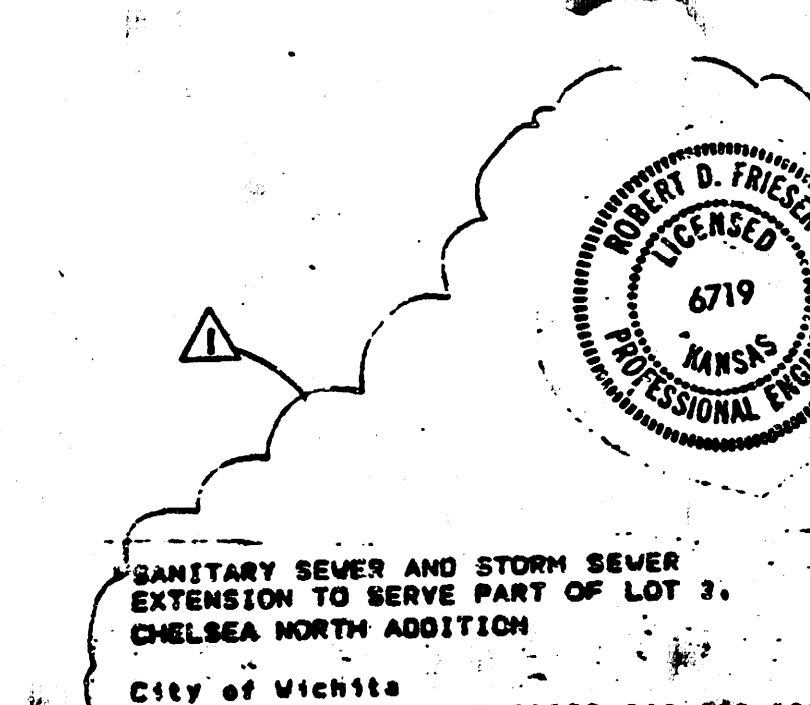

SANITARY SEWER AND STORM SEWER
EXTENSION TO SERVE PART OF LOT 3,
CHELSEA NORTH ADDITION
CITY OF WICHITA
Project # 448-78-245-28000-000-070-000

FILMED FROM THE BEST
AVAILABLE COPY

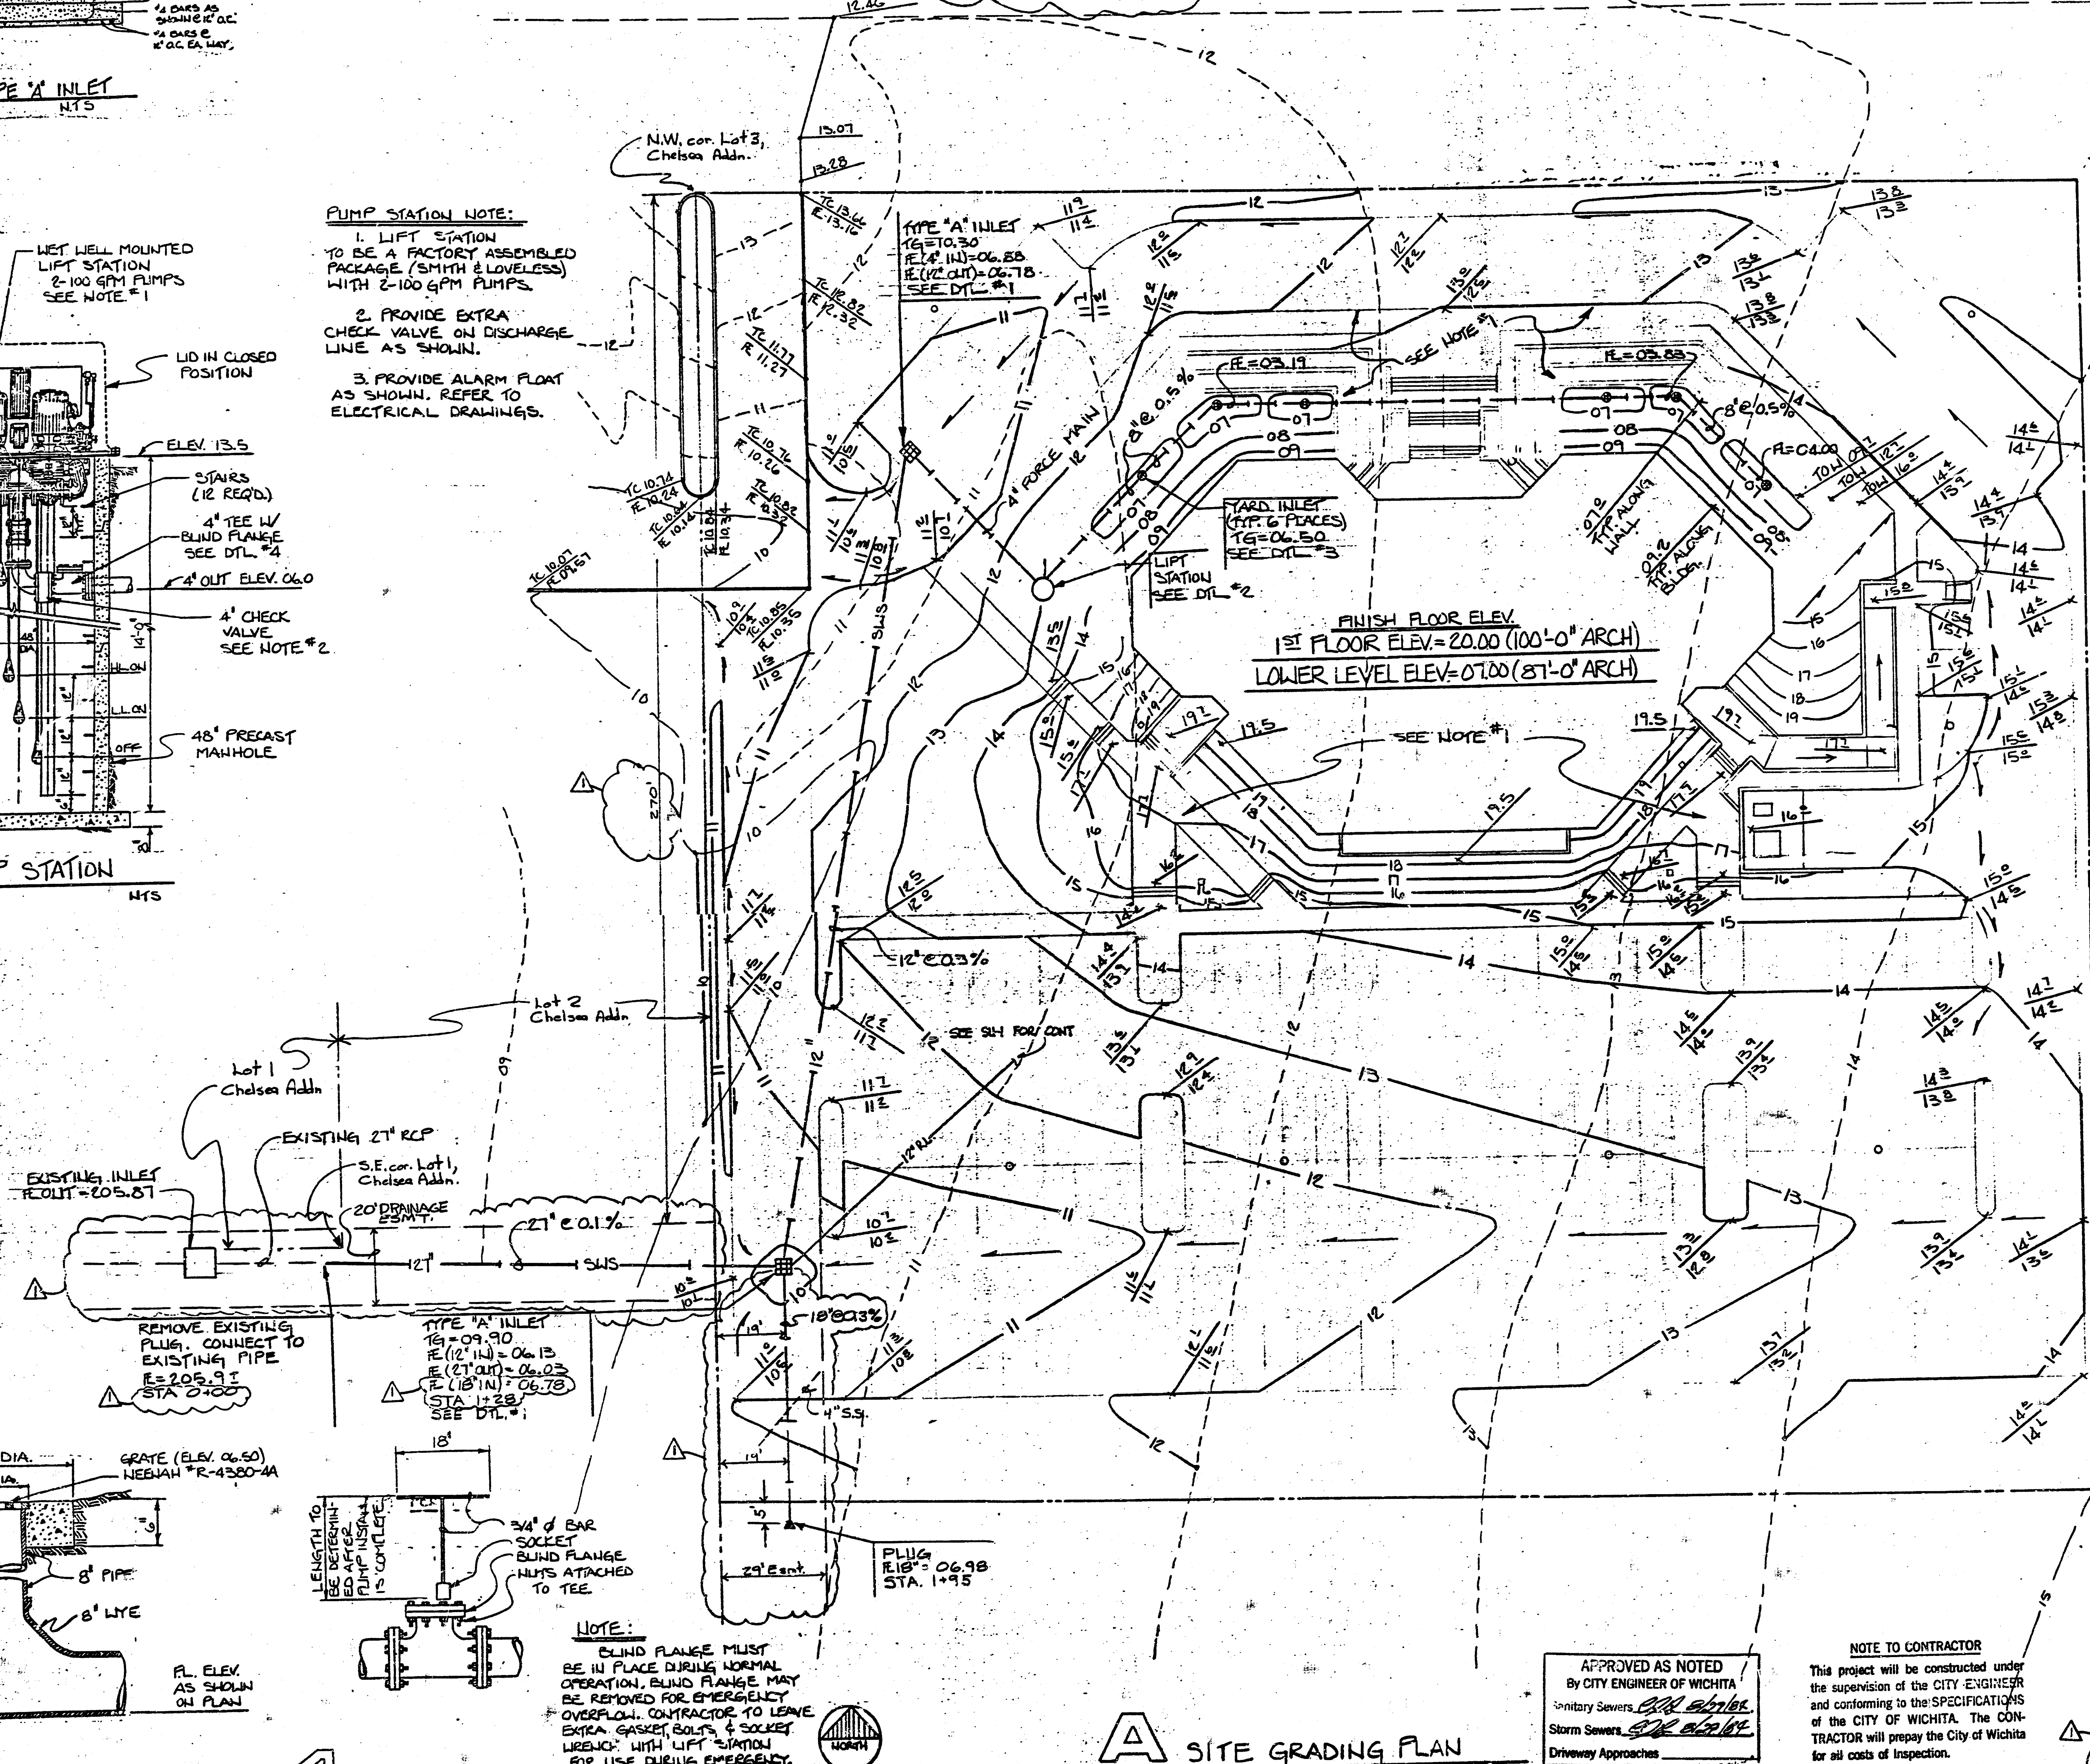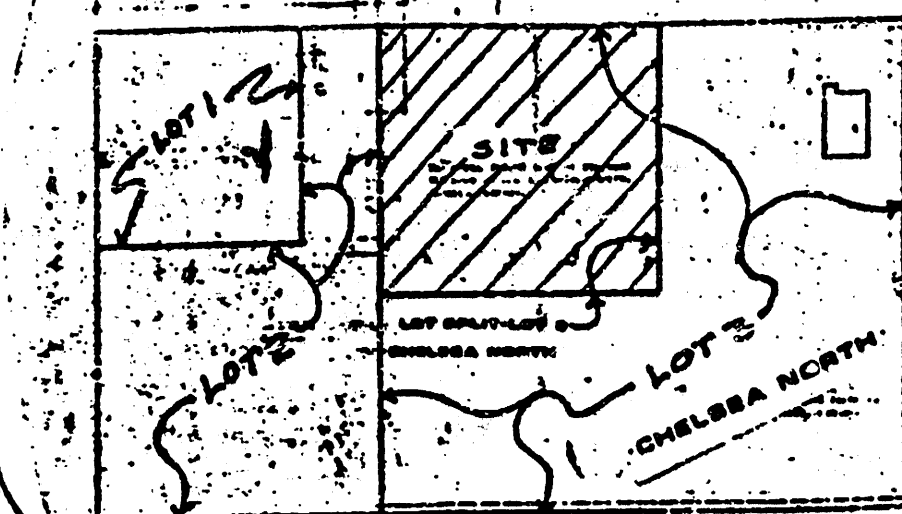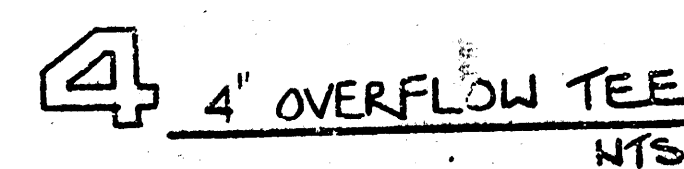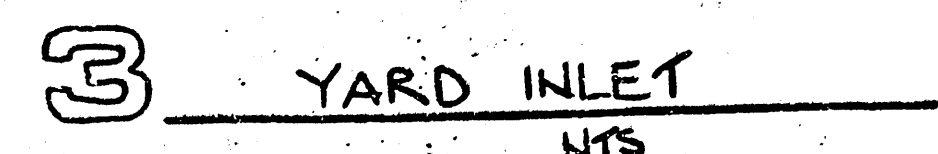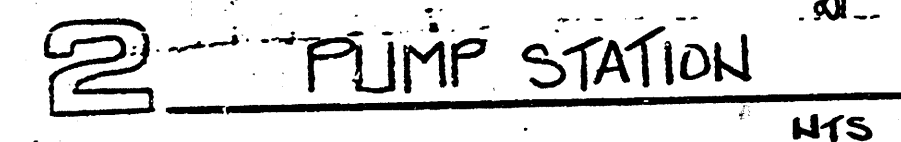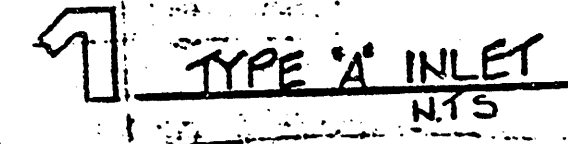

LEGEND

SANITARY SEWER AND STORM SEWER
EXTENSION TO SERVE PART OF LOT 3,
CHELSEA NORTH ADDITION
City of Wichita,
Project # 1500-249-80000-000-00

SITE GRADING PLAN

SHEET TITLE

SHEET NUMBER

2/2

SG.

OF _____ SHEETS

FILMED FROM THE BEST
AVAILABLE COPY.....