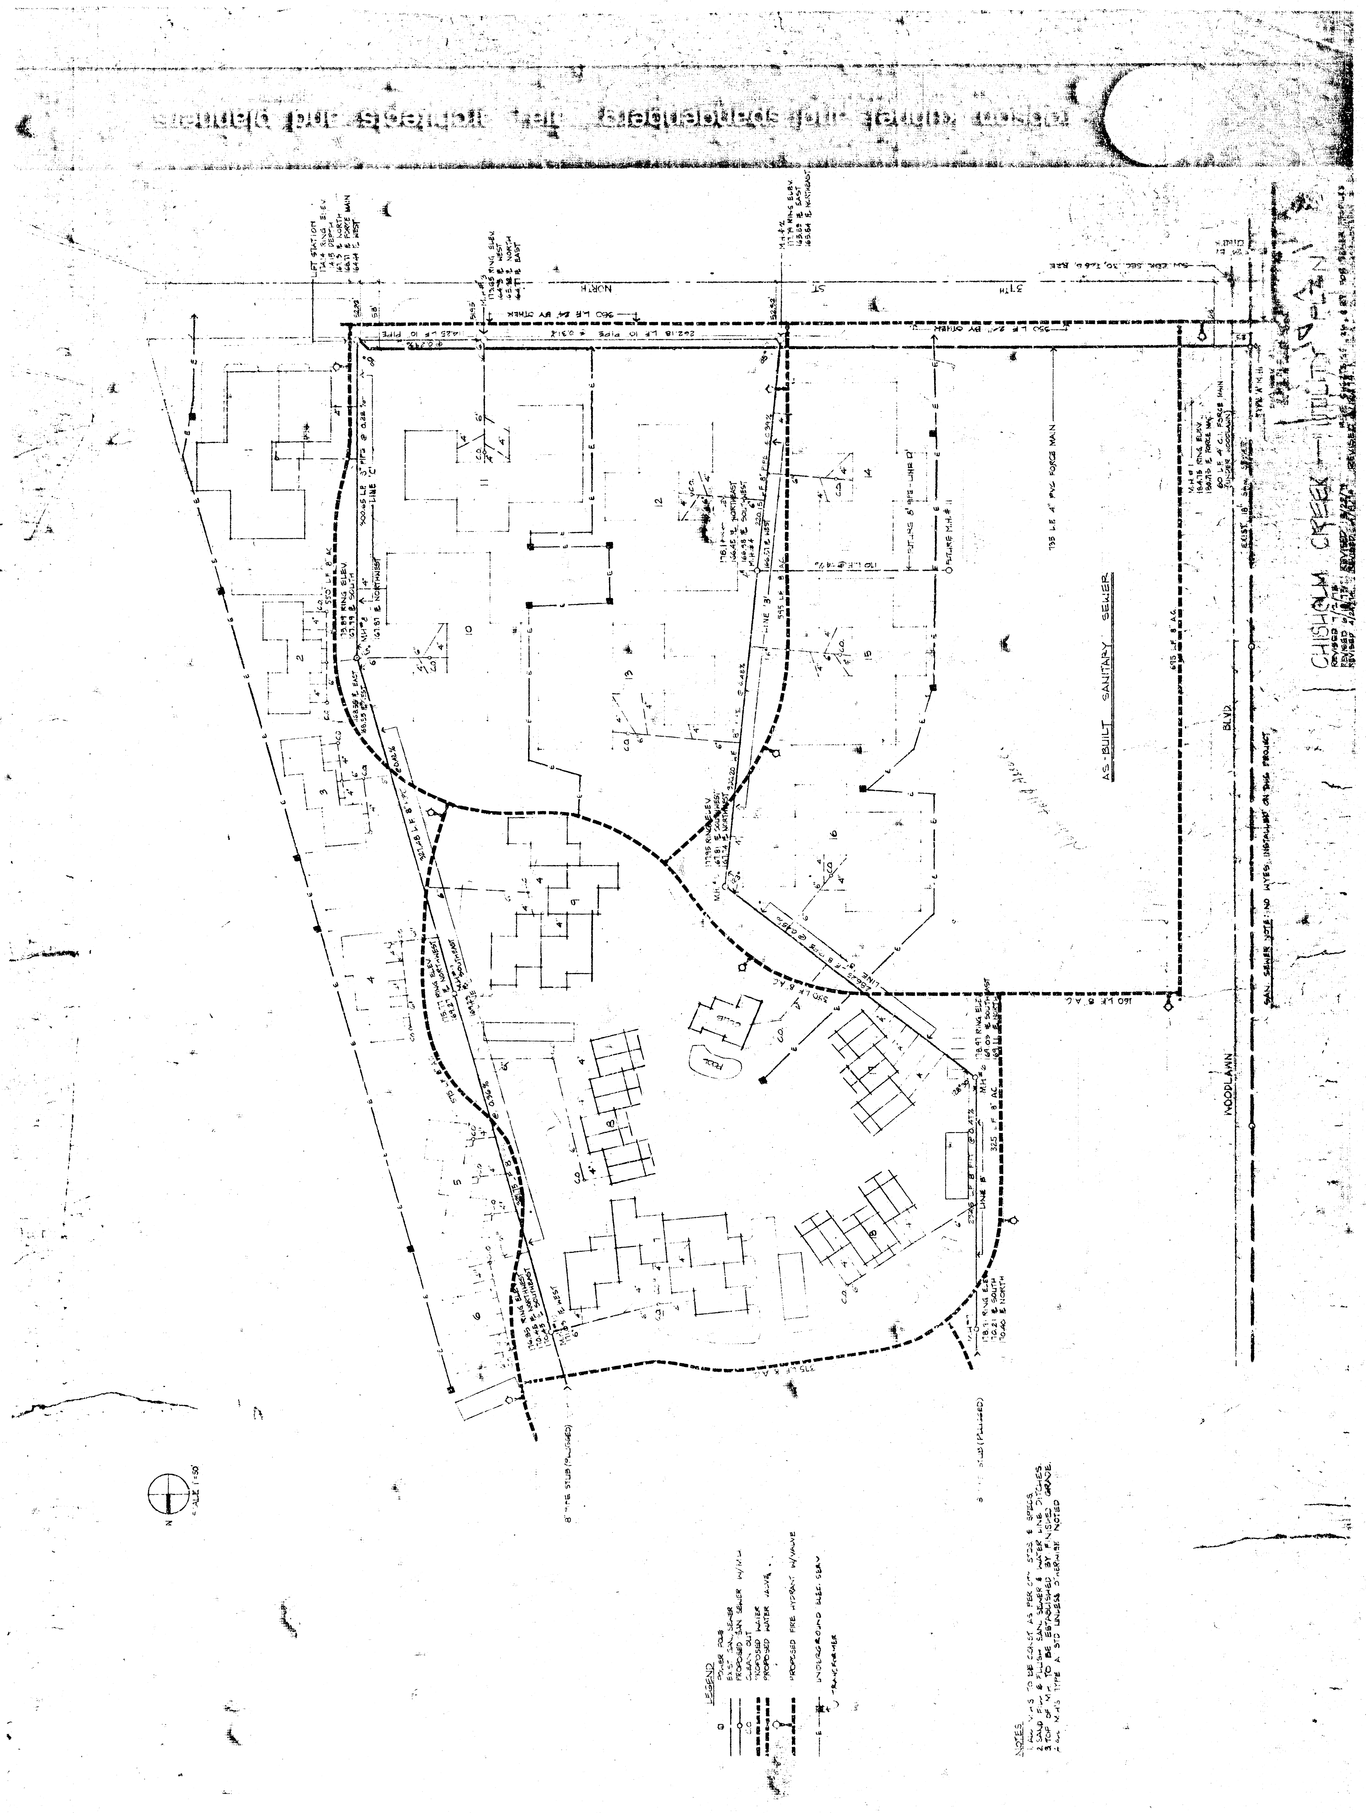
CHISHOLM CREEK — UTILITY PLAN
AS-BUILT SANITARY SEWER
WOODLAWN
BLVD
37TH
NORTH
EAST
SOUTH
WEST
LEGEND
NOTES