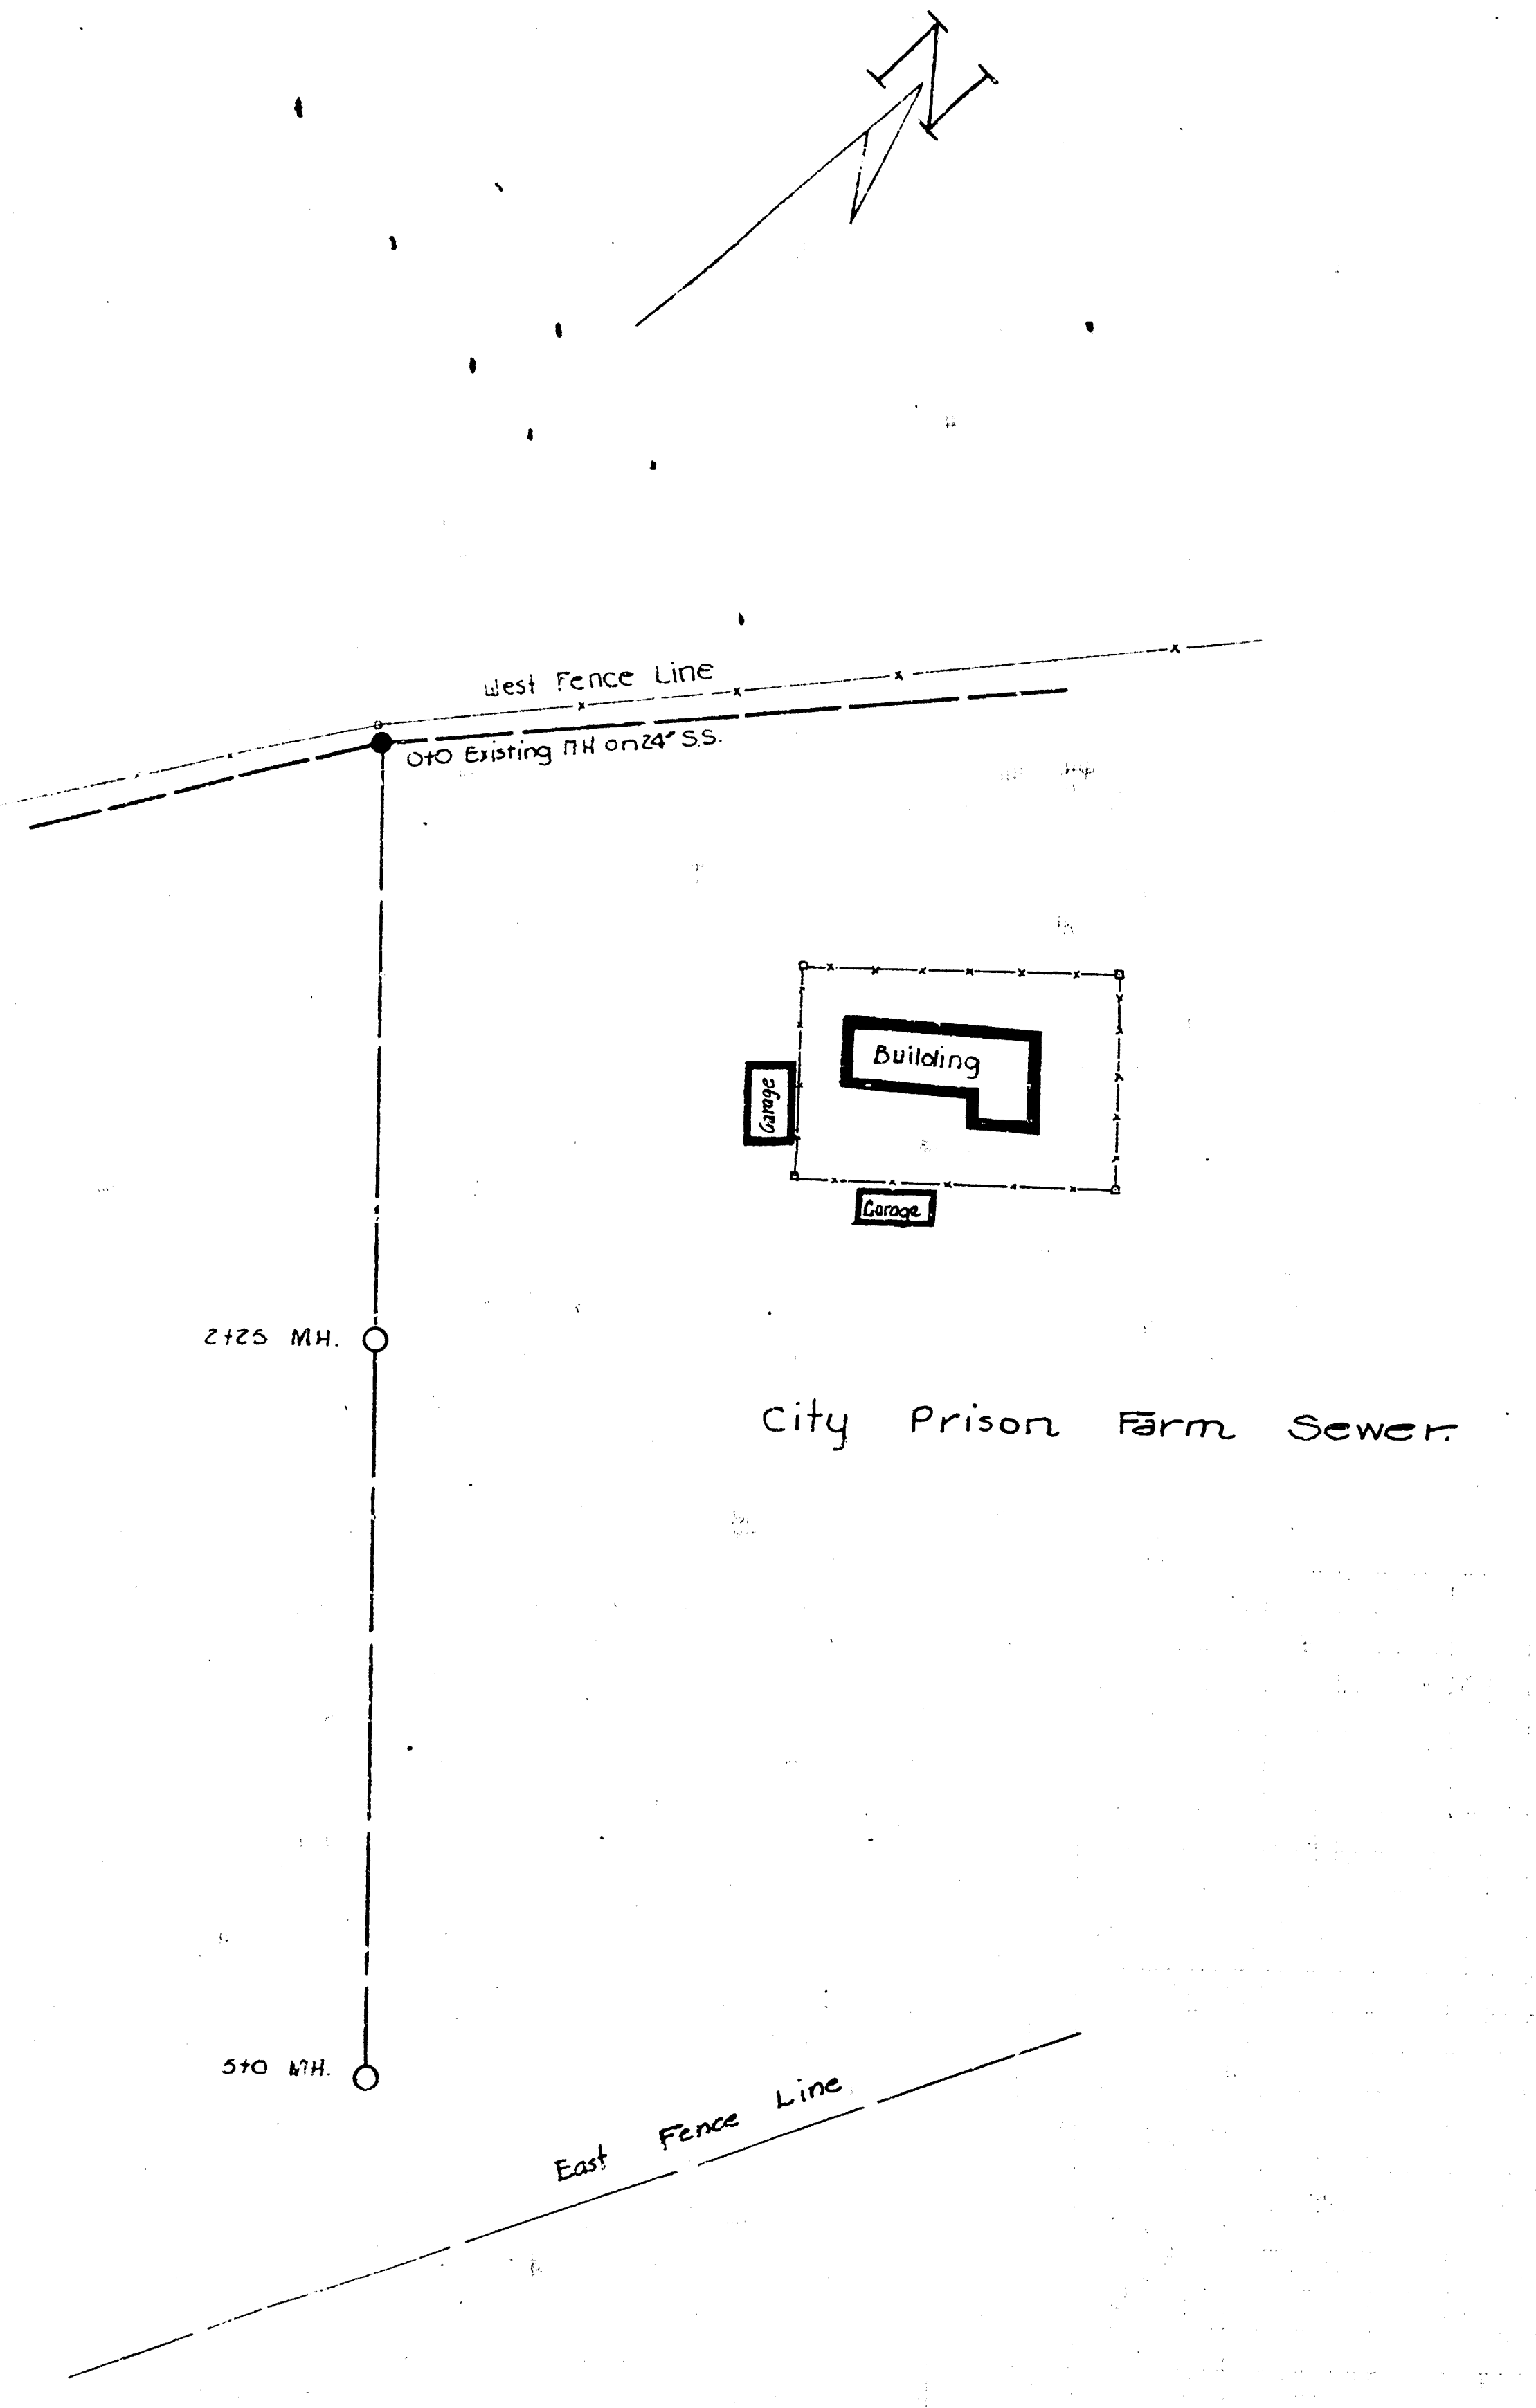
N
West Fence Line
0+0 Existing MH on 24" S.S.
Building
Garage
Garage
2+25 MH.
5+0 MH.
East Fence Line

City Prison Farm Sewer

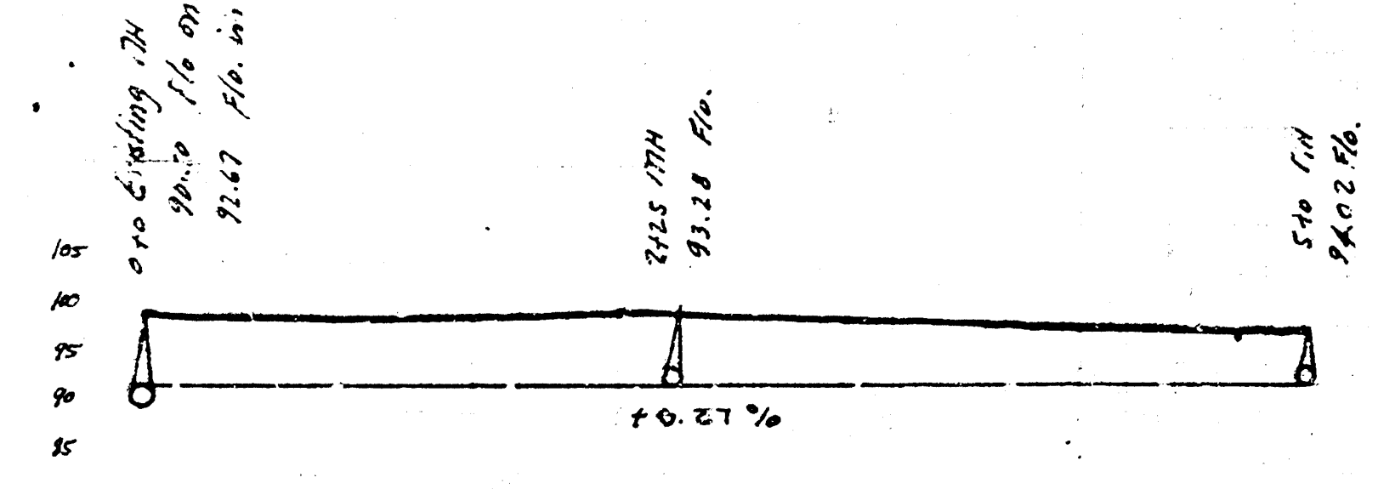
0+0 Existing MH
90.0 Flo out
92.67 Flo. in
2+25 MH 93.28 Flo.
5+0 MH 94.02 Flo.
105
100
95
90
85
+0.27%

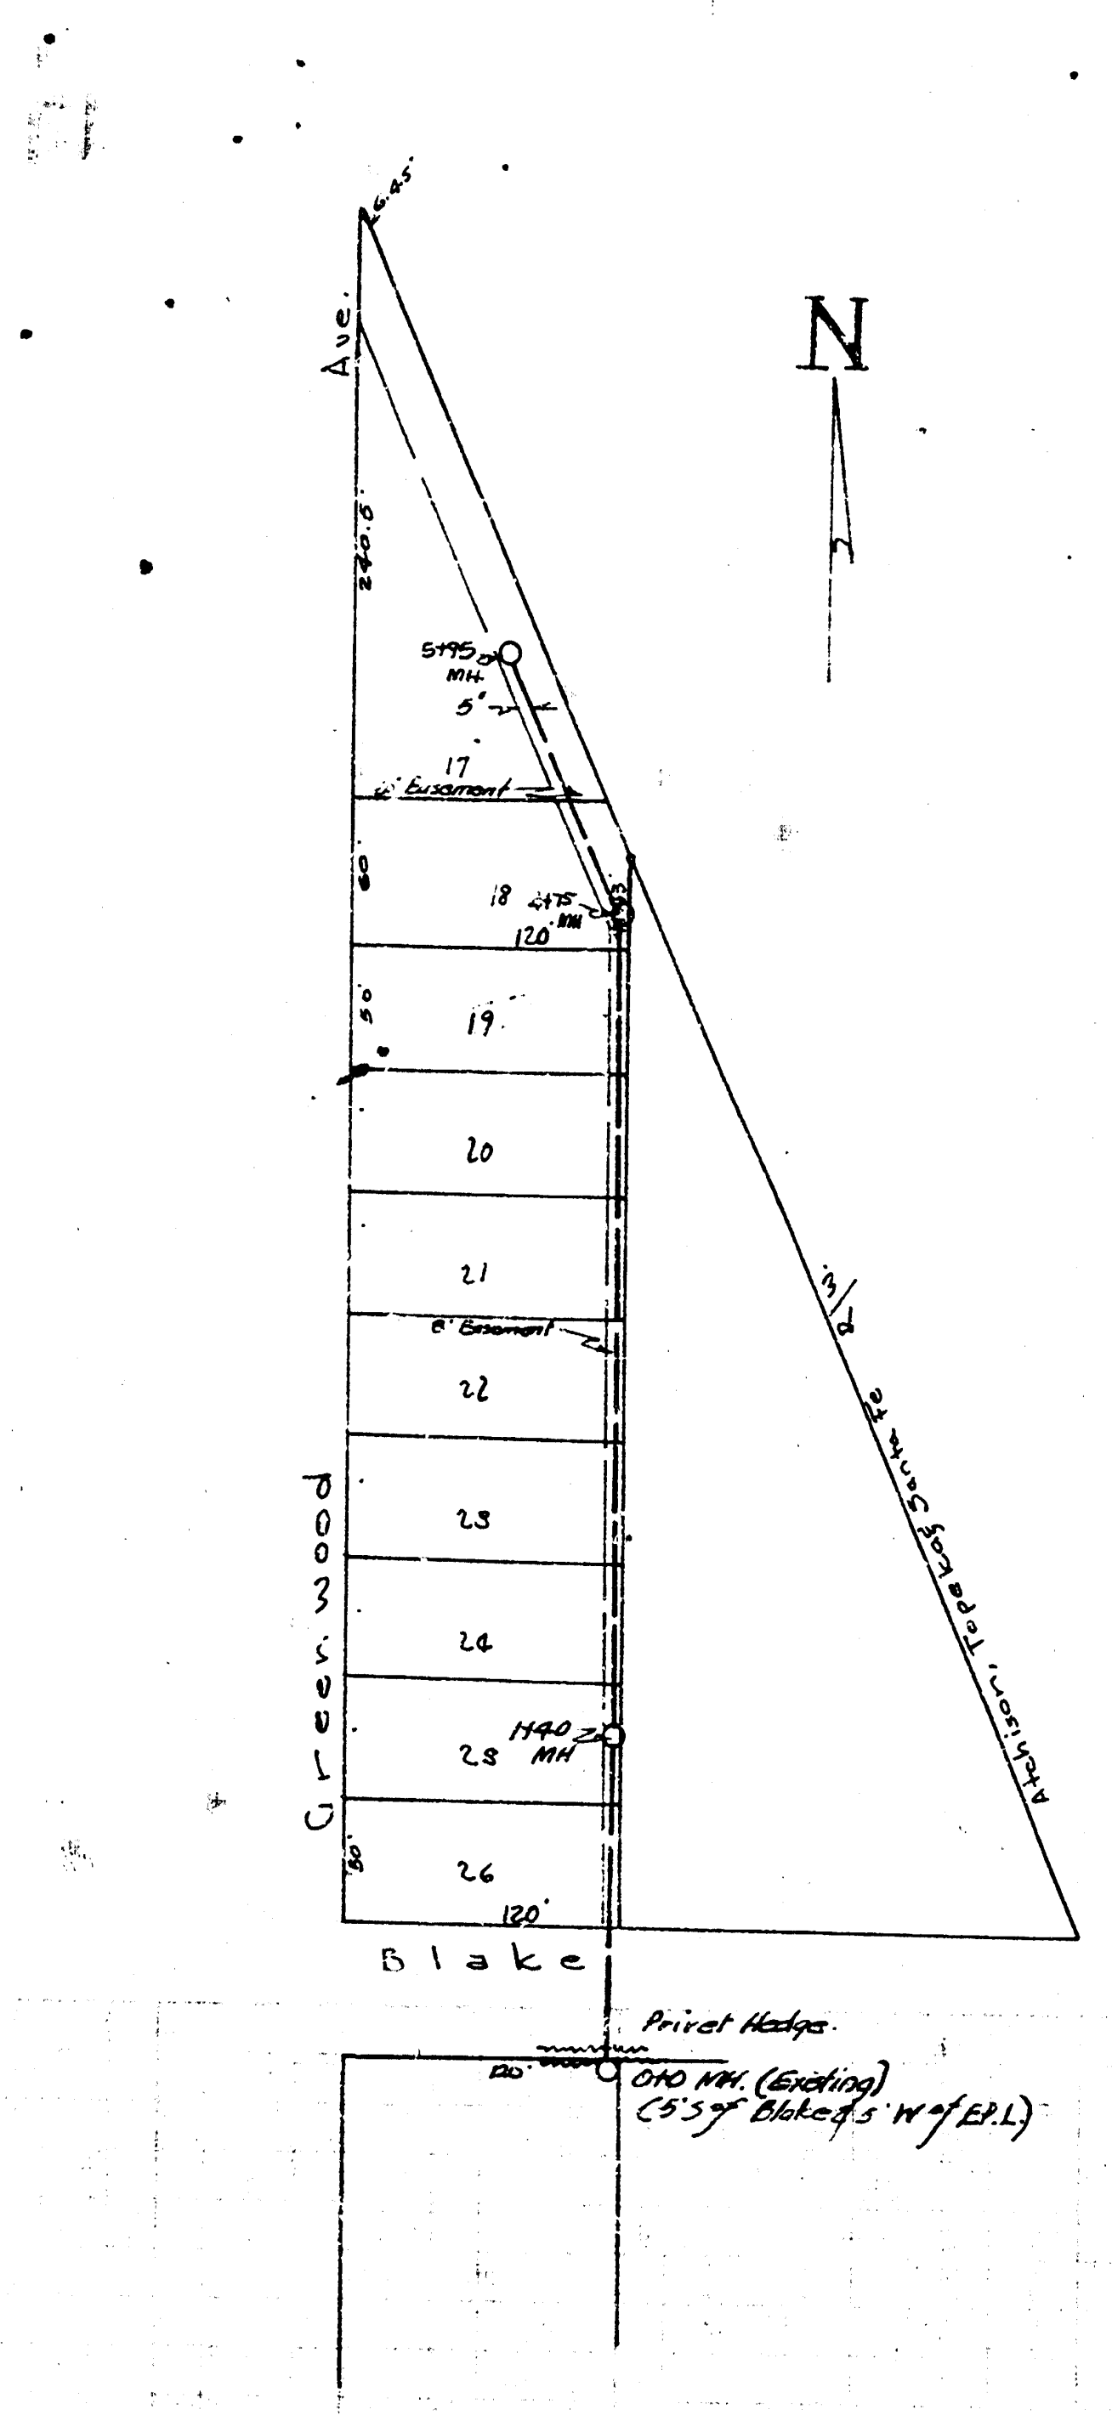
N
6.45
Ave.
240.5
5+95 MH
5'
17
6' Easement
18
4+75 MH
120'
60
50
19
20
21
6' Easement
22
23
24
1+40 MH
25
26
80
120'
Greenwood
Atchison, Topeka & Santa Fe
R/W
Blake
Privet Hedge
0+0 MH (Existing)
(5' S of Blake & 5' W of E.P.L.)
120'

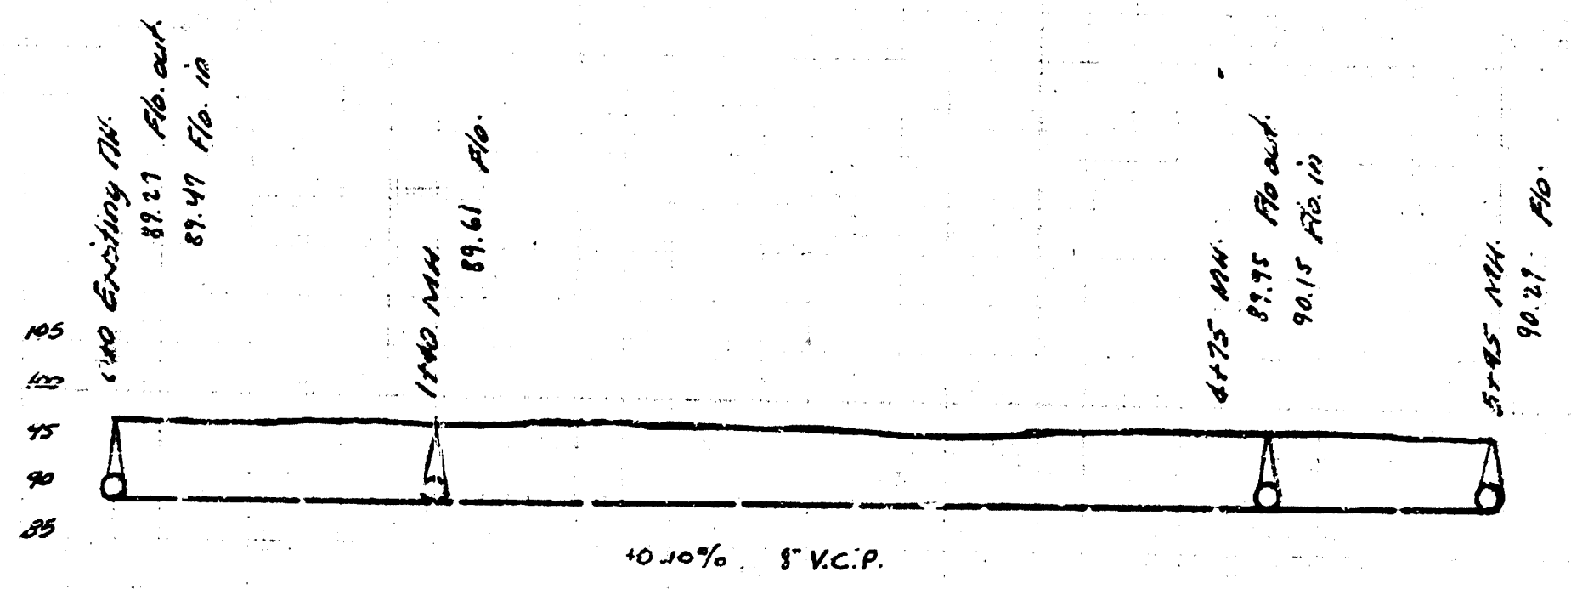
0+0 Existing MH
89.27 Flo. out
89.47 Flo. in
1+40 MH 89.61 Flo.
4+75 MH
89.95 Flo out
90.15 Flo. in
5+95 MH 90.27 Flo.
105
100
95
90
85
+0.10% 8" V.C.P.

Lat. 8, Dist. B, SS# 20.

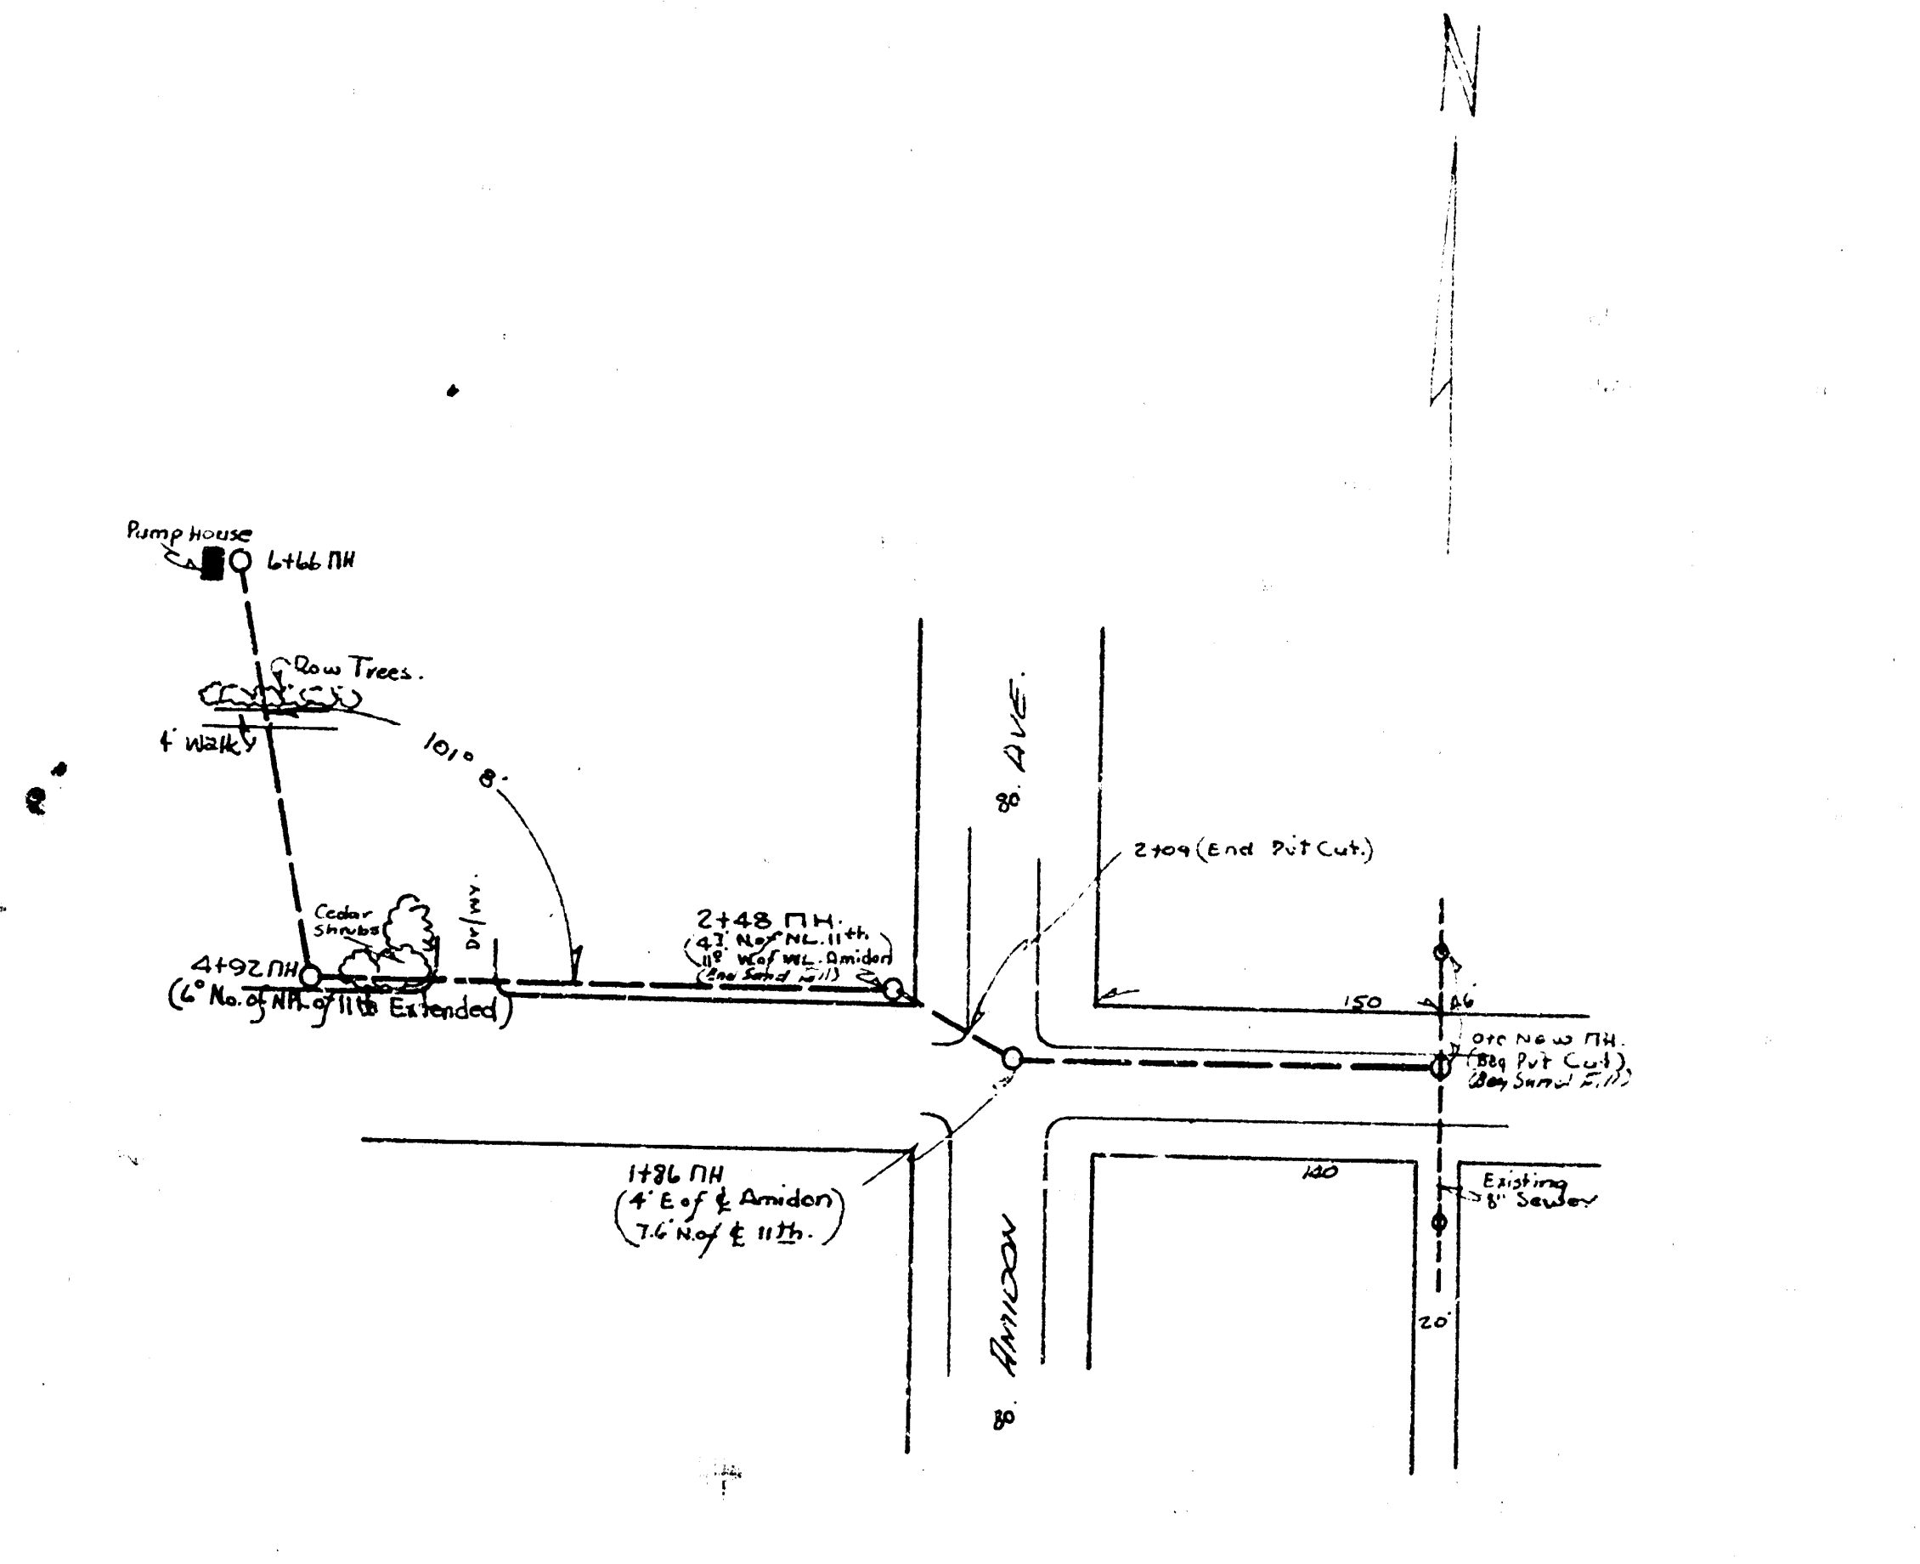
N
Pump House
6+66 MH
Row Trees.
4' Walk
101° 8'
Cedar Shrubs
Dr/wy
4+92 MH
(6' No. of NPL of 11th Extended)
2+48 MH.
(43' N of NL. 11th
11' W of WL. Amidon)
(End Sand Fill)
80
Ave.
2+09 (End Pvt Cut.)
150
46
0+0 New MH.
(Beg Pvt Cut)
(Beg Sand Fill)
1+86 MH
(4' E of ℄ Amidon)
(7.6' N. of ℄ 11th.)
140
Existing 8" Sewer
20'
Amidon
80

Salvation Army Sanitary Sewer

BM. 119.22 Iron in thimble ℄ Amidon on 11th

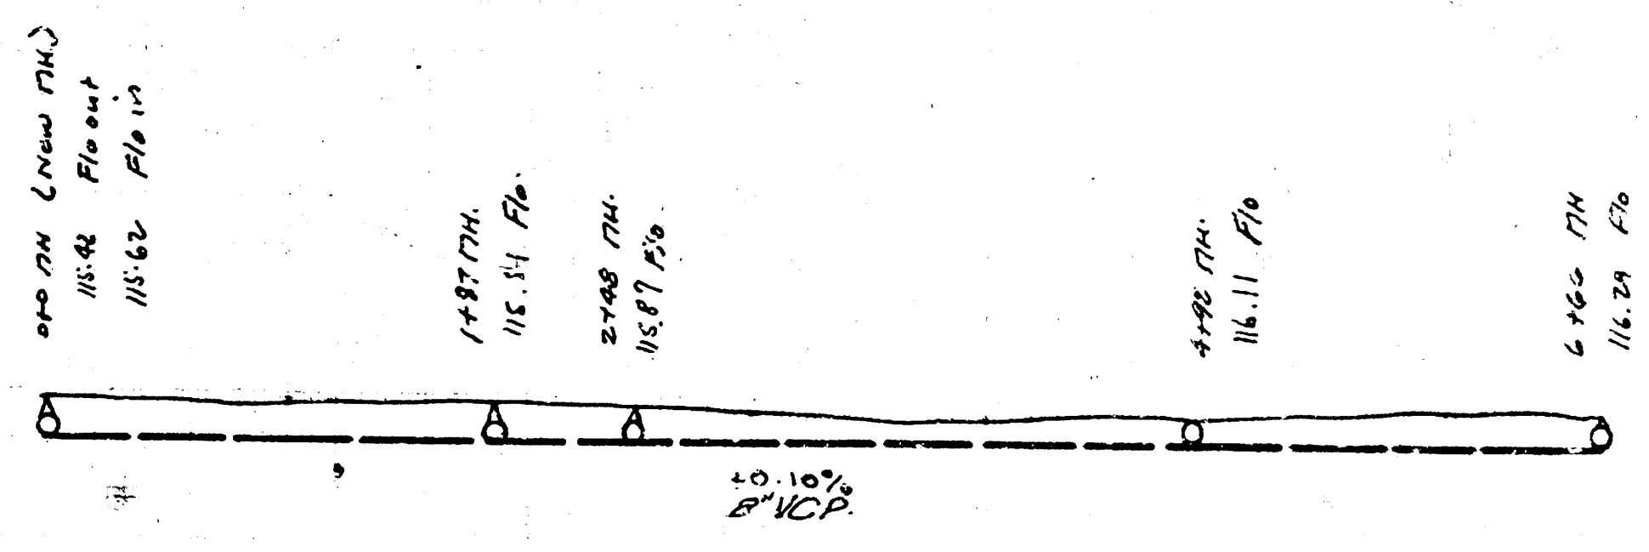
0+0 MH (New MH.)
115.42 Flo out
115.62 Flo in
1+87 MH. 115.54 Flo.
2+48 MH. 115.87 Flo
4+92 MH. 116.11 Flo
6+66 MH 116.29 Flo
130
125
120
115
110
+0.10%
8" VCP.

Salvation Army Sanitary Sewer
City Prison Farm Sanitary Sewer
Lat. 8, Dist. B, Sanitary Sewer #20.
City of Wichita, Kansas

L. K. White City Engineer
Date May 23, 1949