


ST FRANCIS

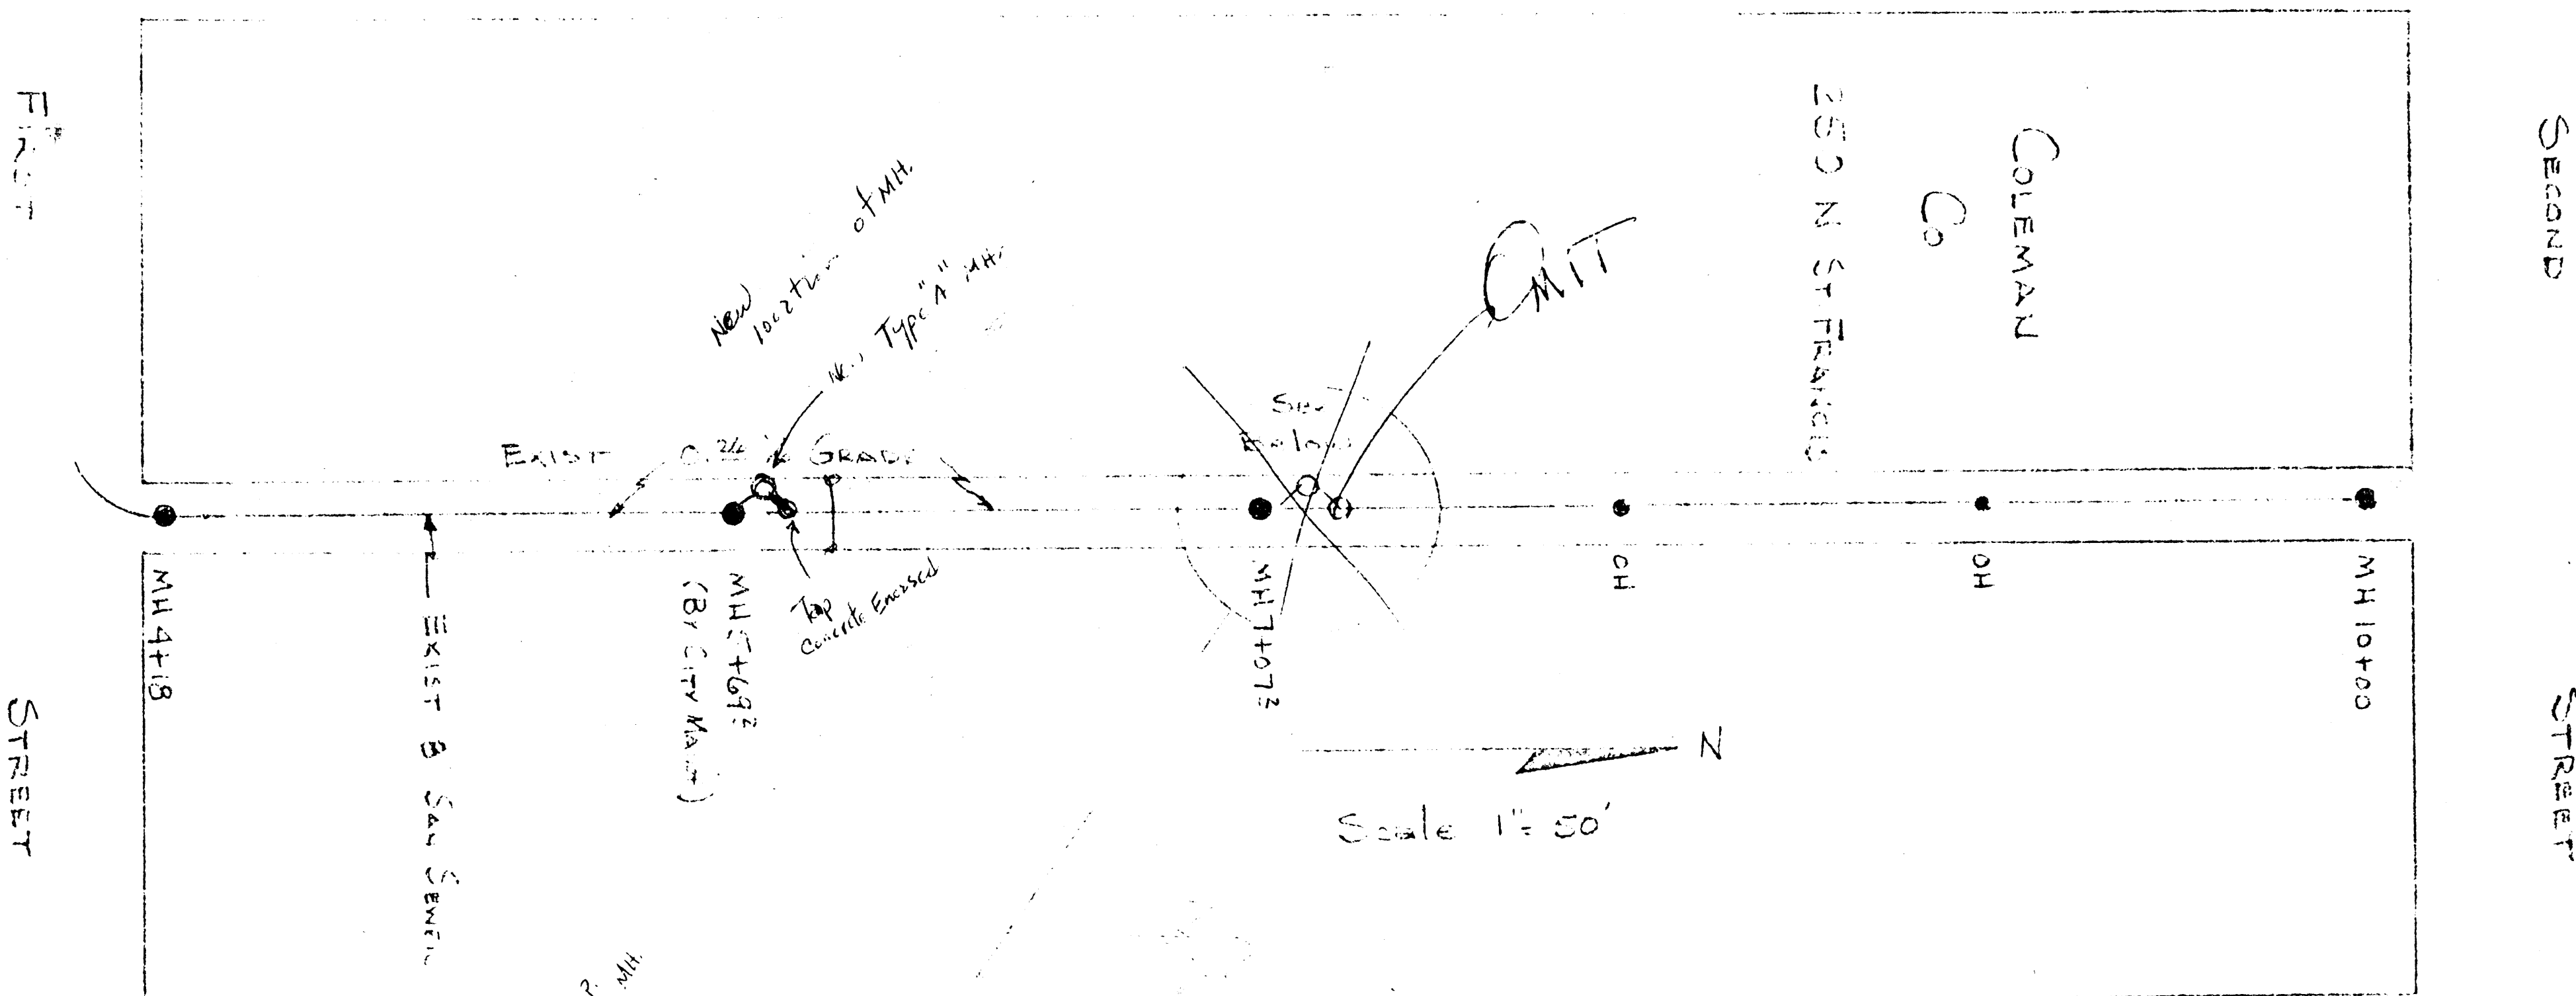

Thurs. AM
10-17-74

10' 45" x 45" x 45"

EXIST. M.H.
7+01.3
FL. 105.1
M.H. 10418

INSTALL 8" x 6" VISE
NORTH SIDE MH 10472

EXIST. M.H. F. West Equip (Type A)
FL. 105.12

OMIT THIS MANHOLE

NOTE TO CONTRACTOR


5-3-74

DRB

DRAW 704025

Rev. # 04/14/74

SEWER FLUME FOR
COLEMAN FACTORY A
250 N ST FRANCIS

WIND-STAR 12 MAY-1974

STATE 1 - PLAN - PROFILE - V.P. 2
DRAWING LAYER CO. 2.1.01
10/10001