

COLONIAL PARK MOBILE HOME COURT  
 FHA PROJECT NO. 102-00031M  
 WICHITA, KANSAS.

1966

-- PLAN INDEX --	
PAGE	ITEM
1	GENERAL PLAN & TOPOGRAPHY
2	AREA GRADING PLAN
3,4	TYPICAL SITE PLANS
5	STREET IMPROVEMENTS PLAN
6	STREET PROFILES
7	STREET & WALK DETAILS
8	SANITARY SEWER PLAN
9,10	SANITARY SEWER PROFILES
11	MANHOLE DETAILS
12	WATER DISTRIBUTION PLAN
13	WATER LINE DETAILS
14	GAS SYSTEM PLAN
15	POWER & TELEPHONE PLAN
16	UTILITIES CONNECTION PLAN
17	UTILITIES CONNECTION DETAILS
18	POOL & FACILITIES BUILDING PLAN
19	STORAGE BUILDING PLAN
20-22	FACILITIES BUILDING PLANS
23-24	SWIMMING POOL PLANS
25-29	EARTHWORK X-SECTIONS

PLANNER-DON C. MOEHRING C.E. BY Don C. Moehring, C.E.

ENGINEER-DON C. MOEHRING C.E. BY Don C. Moehring, C.E.

ARCHITECT-FELDNER & GREY BY Robert G. Feldner

OWNER-ELMER G. WOMACK BY Elmer G. Womack



CONTRACTOR-ELMER G. WOMACK BY Elmer G. Womack

MORTGAGEE-THE FOURTH NATIONAL  
 BANK & TRUST COMPANY WICHITA BY \_\_\_\_\_

MORTGAGE INSURER-FEDERAL HOUSING  
 ADMINISTRATION BY \_\_\_\_\_

*Not Booked*

*Booked 12-11-67  
 "Per Plan"  
 "No Final"  
 12-61-67  
 J.W.*



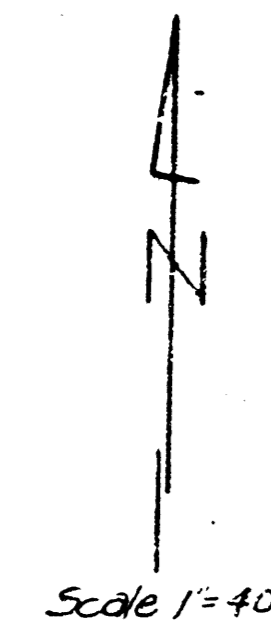
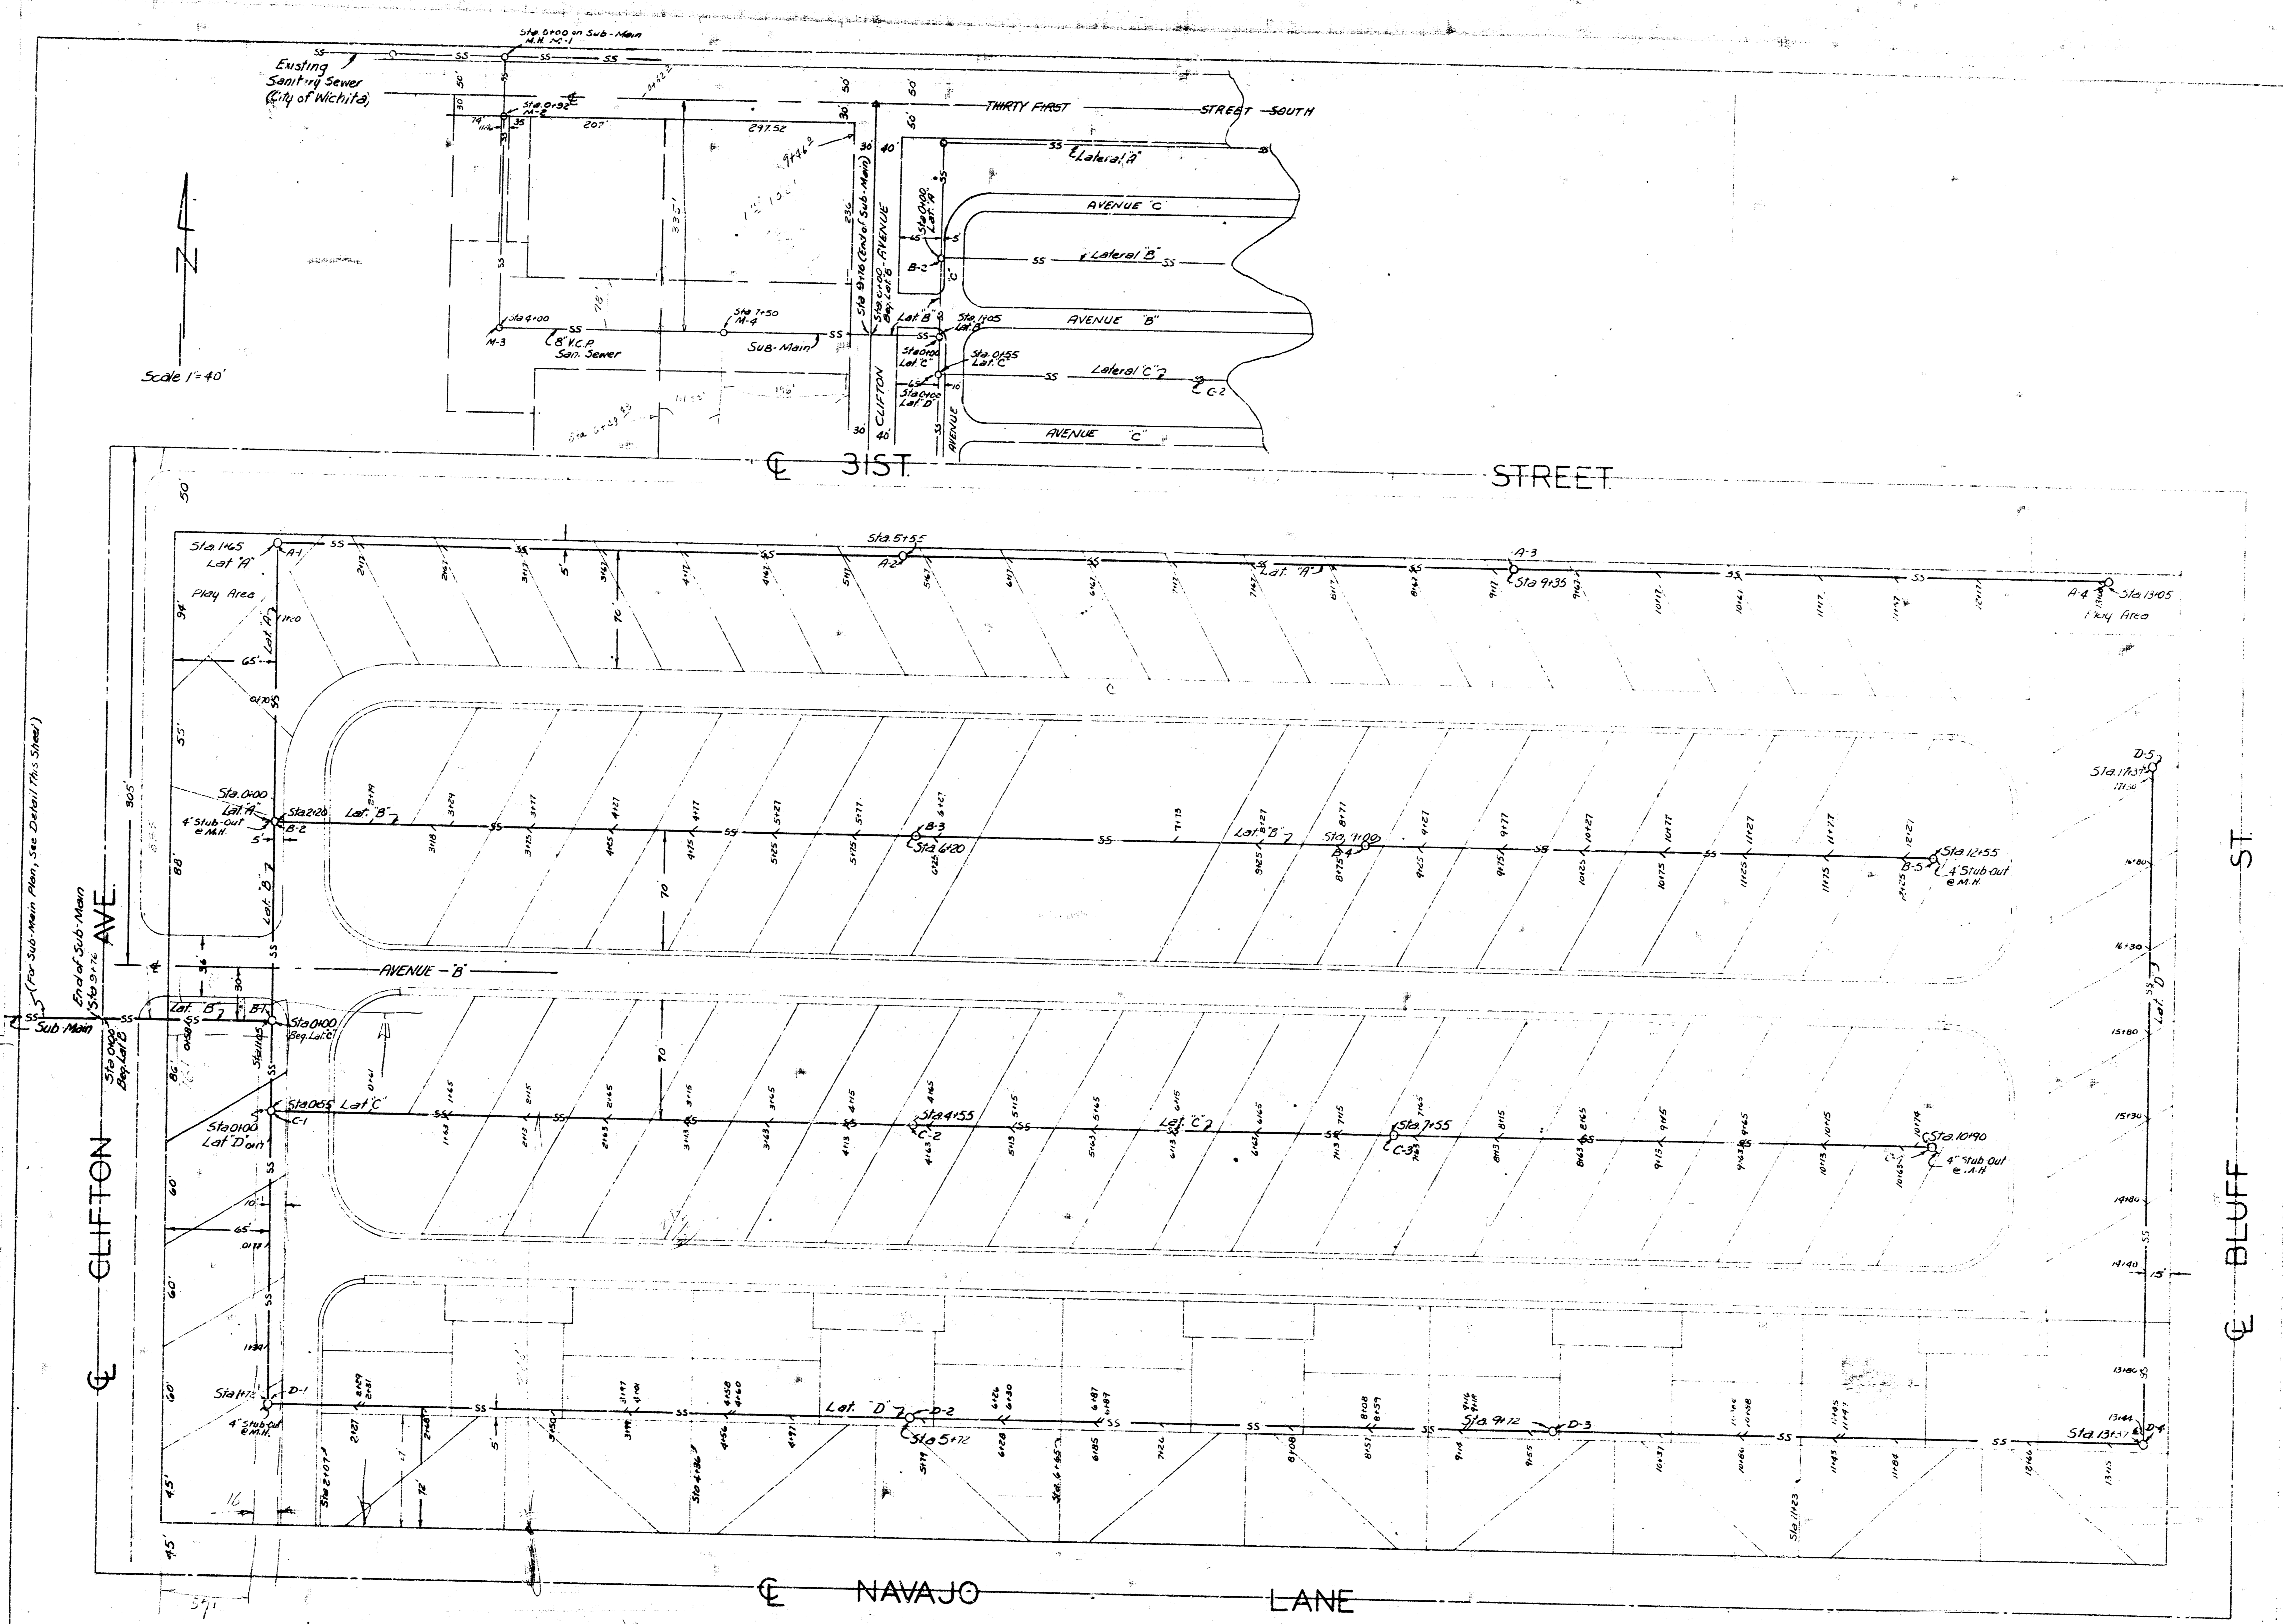


Scale 1" = 40'

End of Sub-Main  
Sta 1165  
Sub Main

Construction Note: M.H.s shall be located as indicated by the above stationings or at the first regular joint downstream.


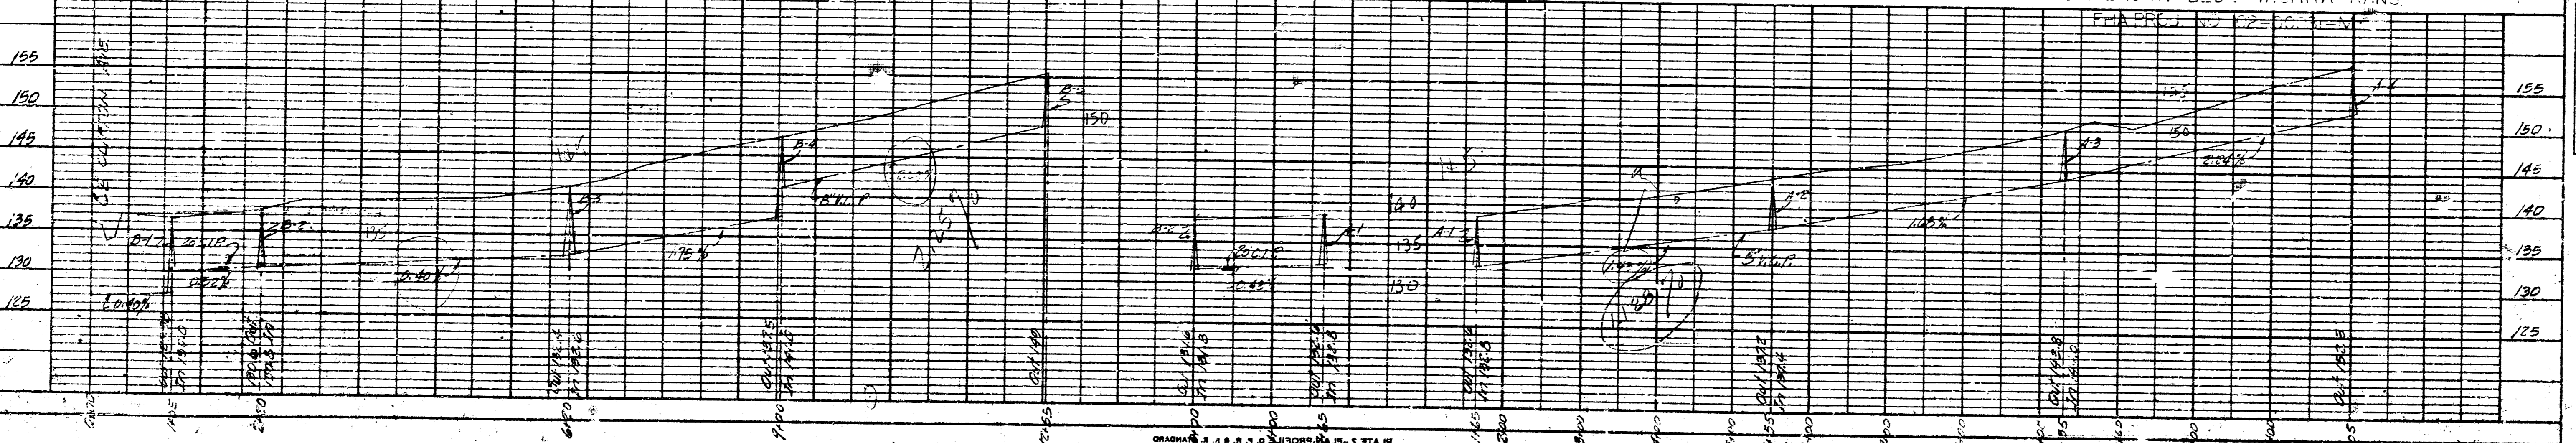
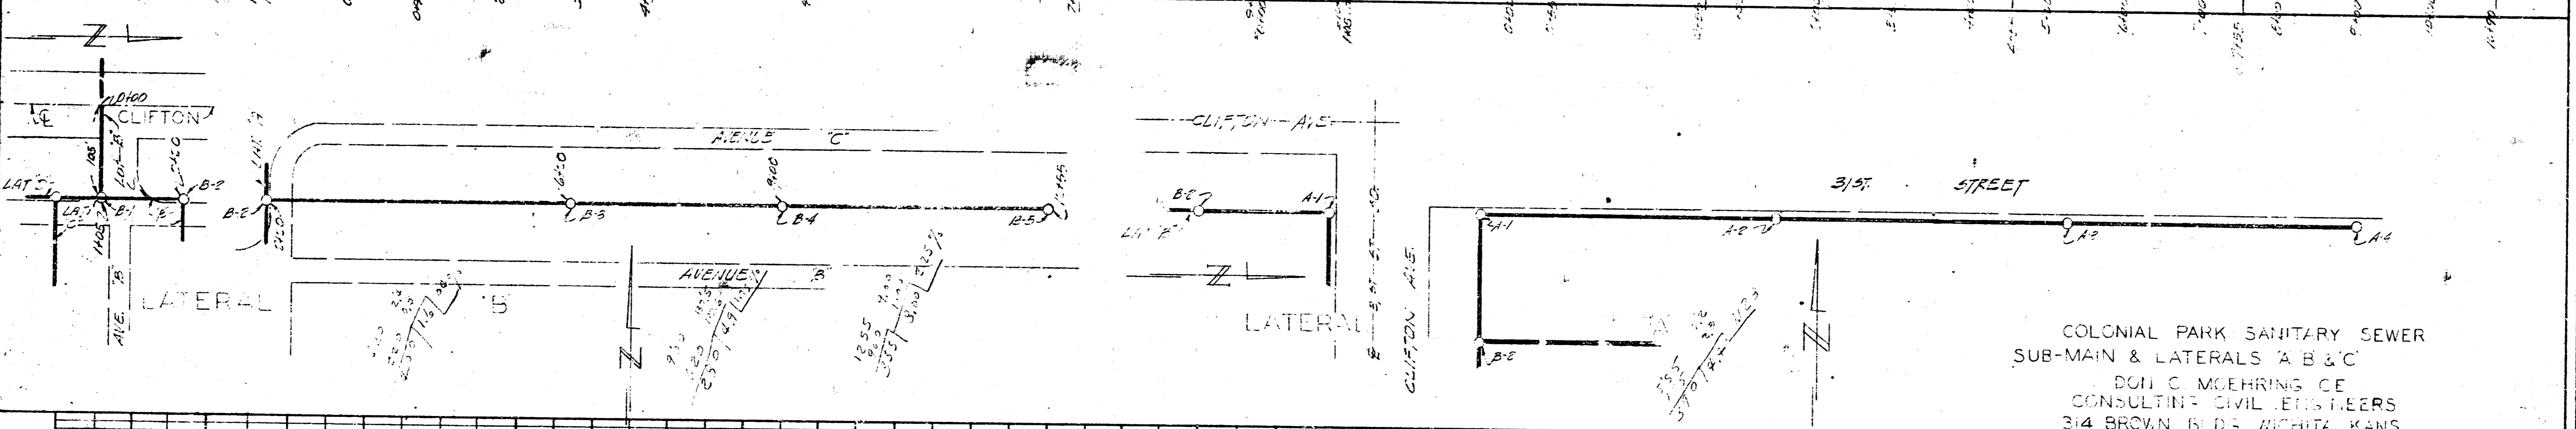
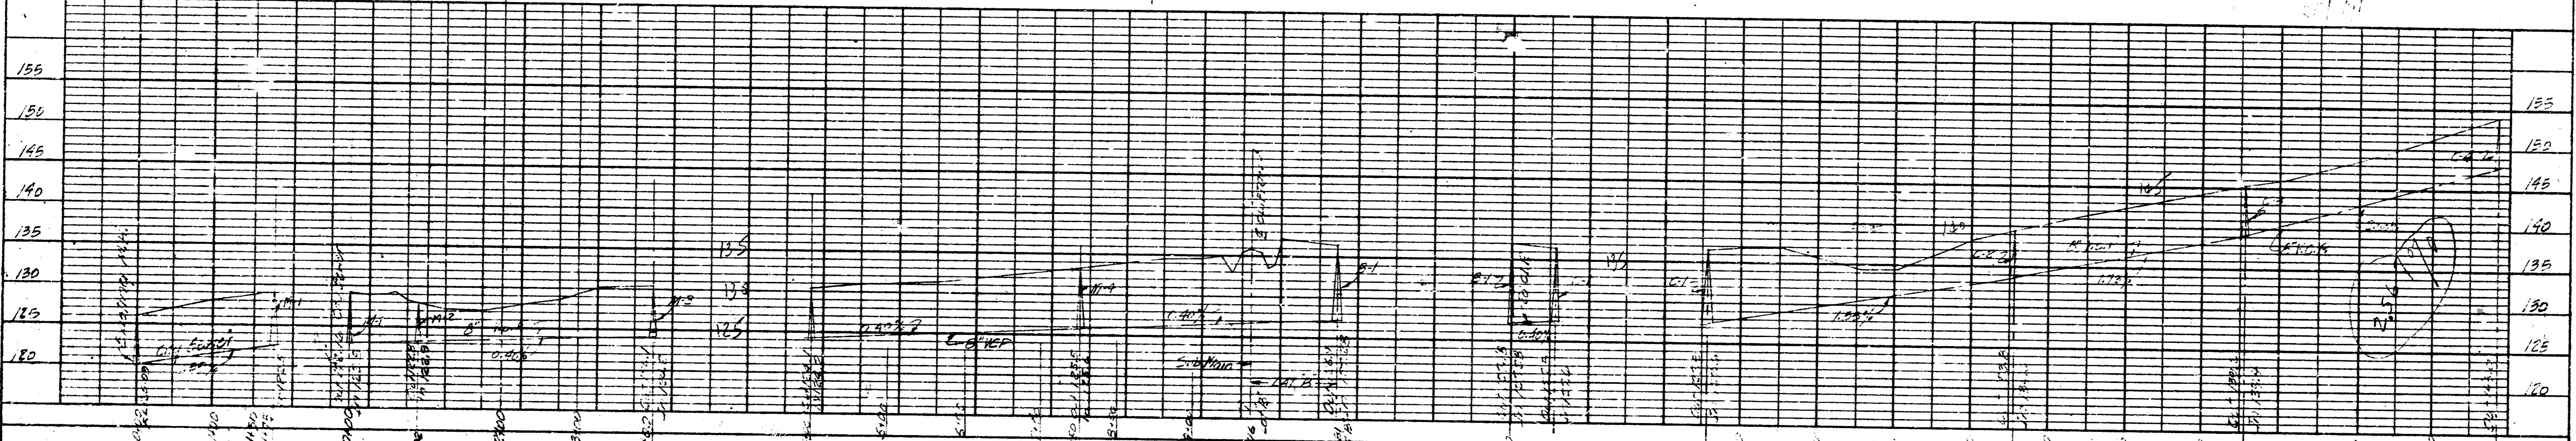
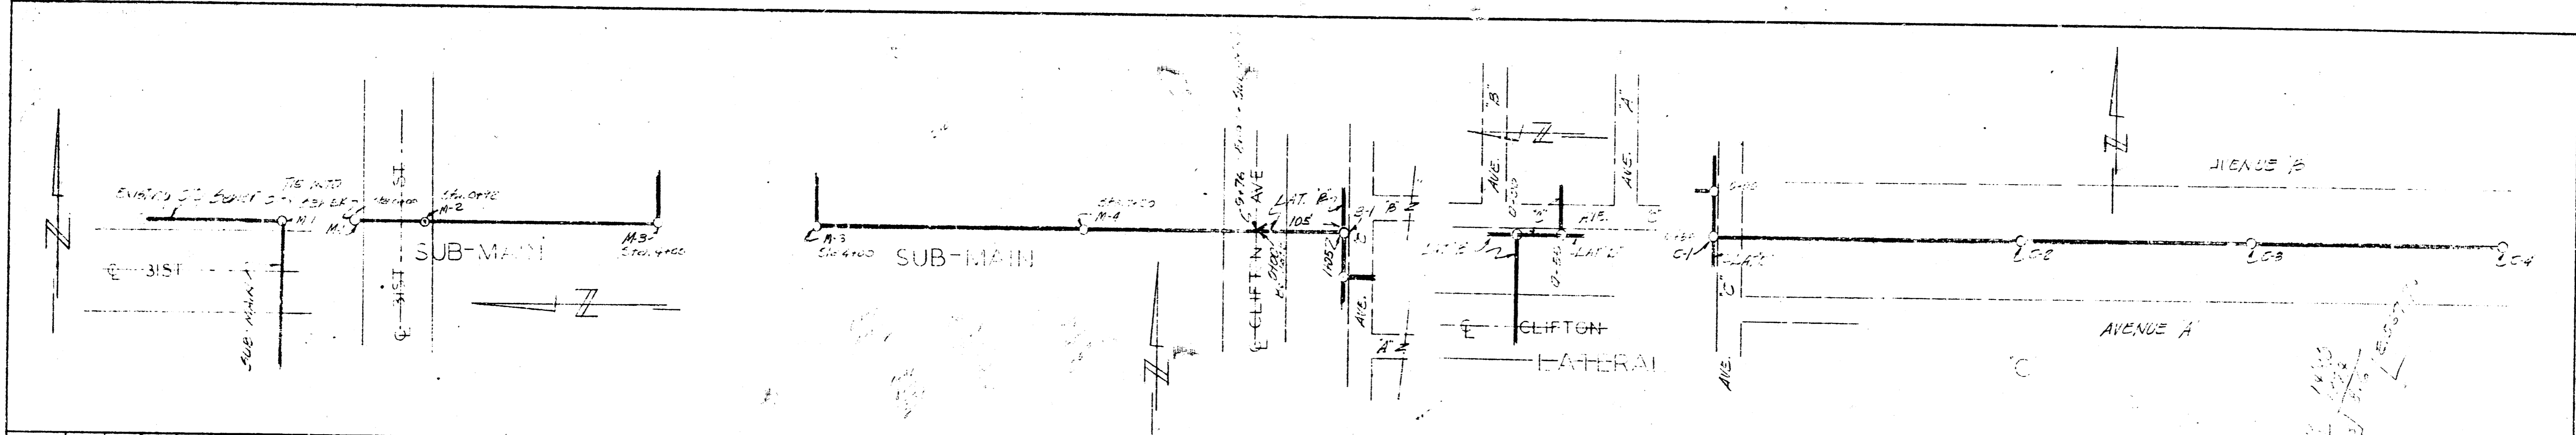


COLONIAL PARK SANITARY SEWER  
SUB-MAIN & LATERALS A B & C  
DUI C. MOHRING CE  
CONSULTING CIVIL ENGINEERS  
314 BROWN BLDG WICHITA, KANS.




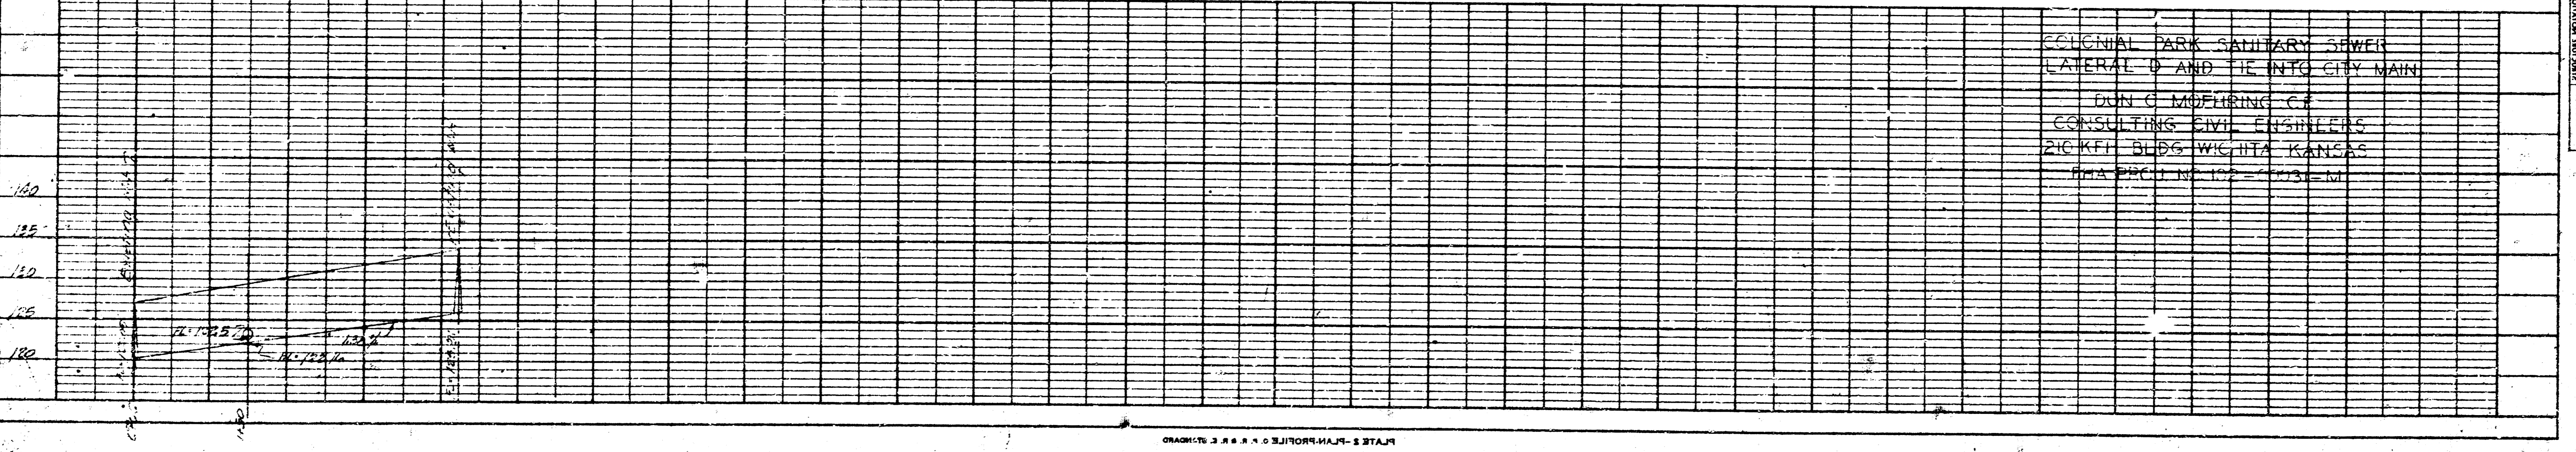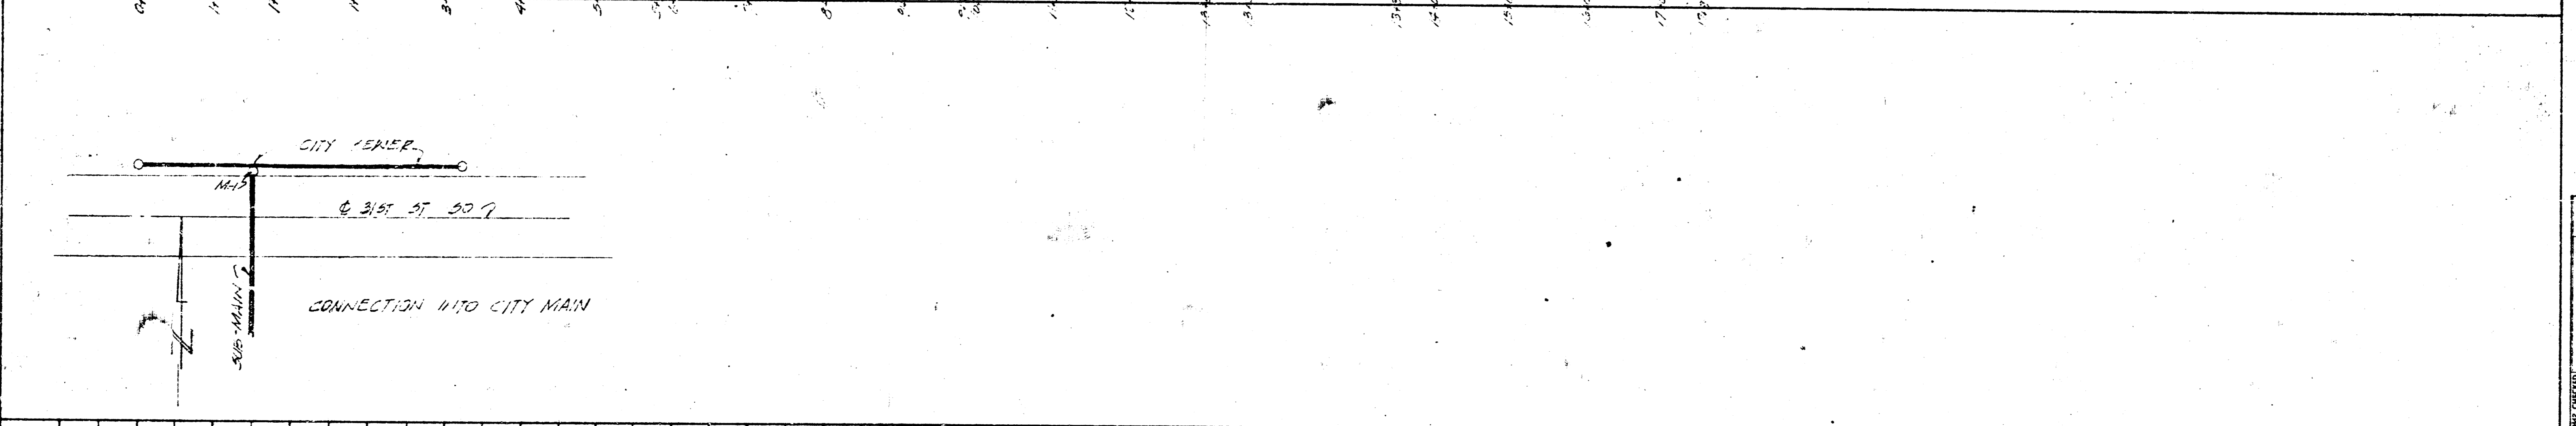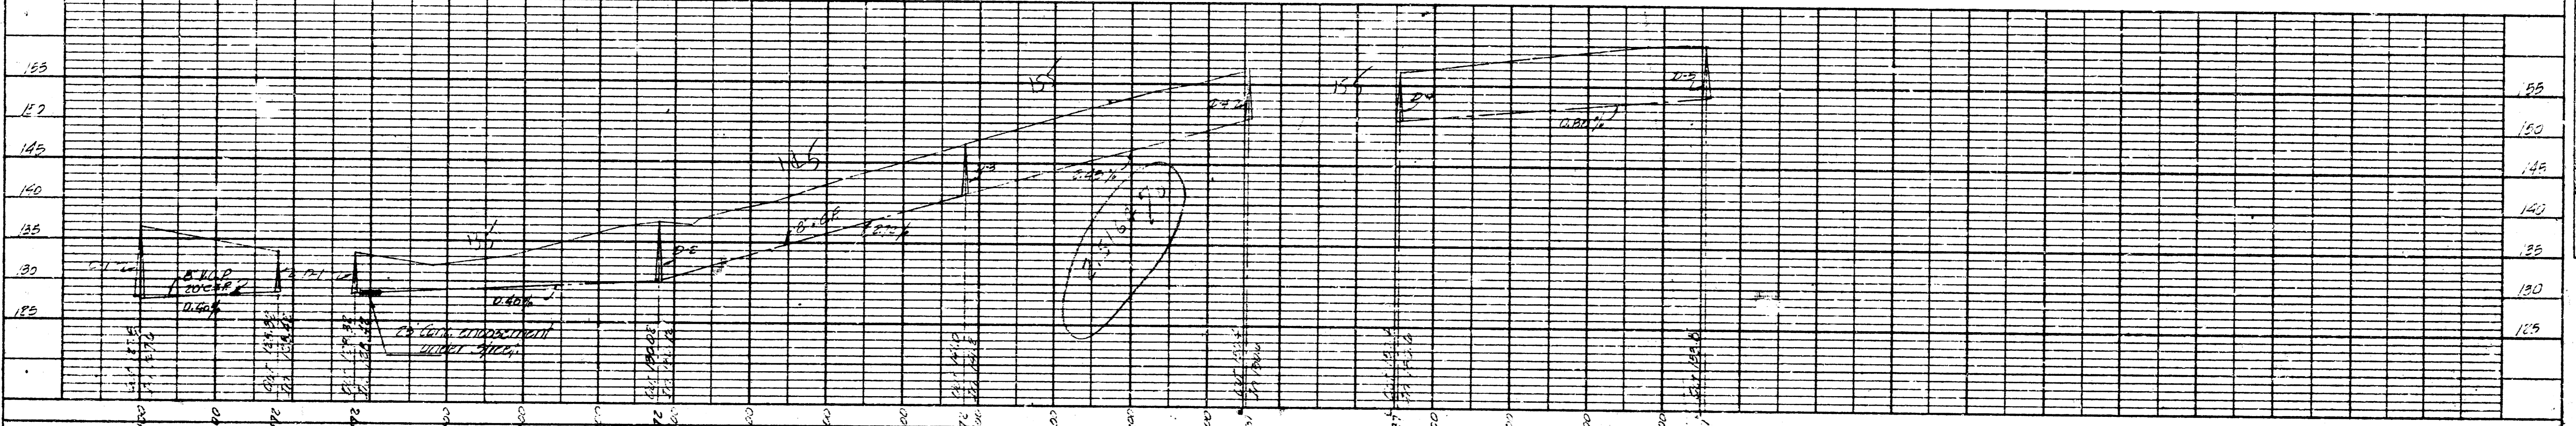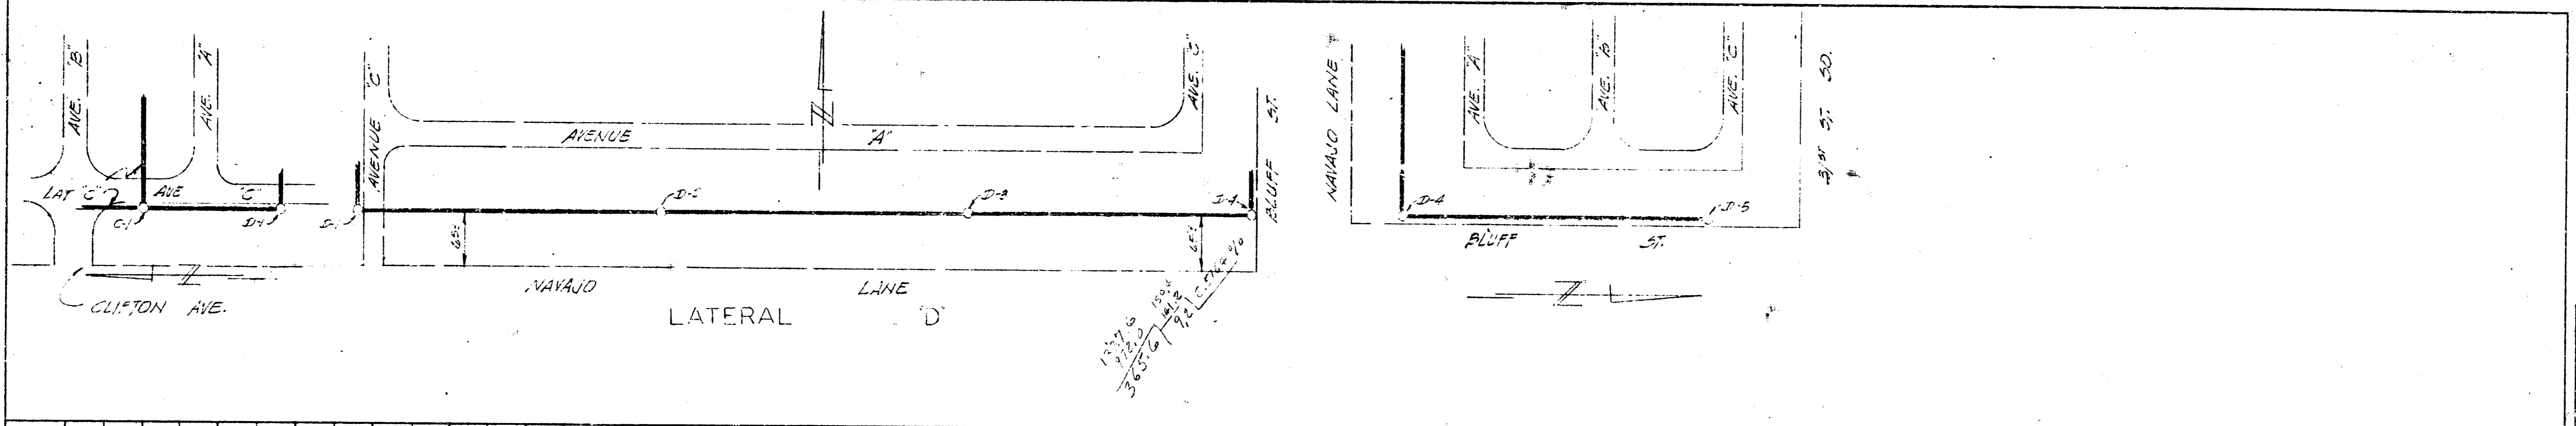

COLONIAL PARK SANITARY SEWER  
 LATERAL D AND TIE INTO CITY MAIN  
 DON C MOFFRING, C.E.  
 CONSULTING CIVIL ENGINEER  
 216 KTH BLDG WICHITA KANSAS  
 REG. NO. 102-4136-11

1" = 10' HORIZONTAL SCALE  
 1" = 4' VERTICAL SCALE  
 DATE: 10/15/50  
 SHEET NO. 10

