COLONIAL PARK MOBILE HOME COURT
FHA PROJECT NO. 102-00031M
WICHITA, KANSAS.

1966

— PLAN INDEX —

PAGE	ITEM
1	GENERAL PLAN & TOPOGRAPHY
2	AREA GRADING PLAN
3,4	TYPICAL SITE PLANS
5	STREET IMPROVEMENTS PLAN
6	STREET PROFILES
7	STREET & WALK DETAILS
8	SANITARY SEWER PLAN
9,10	SANITARY SEWER PROFILES
11	MANHOLE DETAILS
12	WATER DISTRIBUTION PLAN
13	WATER LINE DETAILS
14	GAS SYSTEM PLAN
15	POWER & TELEPHONE PLAN
16	UTILITIES CONNECTION PLAN
17	UTILITIES CONNECTION DETAILS
18	POOL & FACILITIES BUILDING PLAN
19	STORAGE BUILDING PLAN
20-22	FACILITIES BUILDING PLANS
23-24	SWIMMING POOL PLANS
25-29	EARTHWORK X-SECTIONS

PLANNER-DON C. MOEHRING C.E. BY Don C. Moehring, CE.

ENGINEER-DON C. MOEHRING C.E. BY Don C. Moehring, CE.

ARCHITECT-FELDNER & GREY BY Robert G. Feldner

OWNER-ELMER G. WOMACK BY Elmer G. Womack

CONTRACTOR-ELMER G. WOMACK BY Elmer G. Womack

MORTGAGEE-THE FOURTH NATIONAL BANK & TRUST COMPANY WICHITA BY _____

MORTGAGE INSURER-FEDERAL HOUSING ADMINISTRATION BY _____

~~Not~~ Booked

Ekad [illegible]
"Per Plan"
"No Final"
12-61-67
J.W.

Existing Sanitary Sewer (City of Wichita)

Sta 0+00 on Sub-Main M.H. NO-1

Sta 0+32 ℄

207'

297.52'

Sta 3+98.3

Sta 4+00 M-3

8" V.C.P. San. Sewer

Sta 7+50 M-4

Sub-Main

Sta 8+98 (End of Sub-Main) Beg. Lat. B

Sta 0+00 Lat. 'A'

Sta 0+00 Lat. 'B'

Sta 0+00 Lat. 'C'

Sta 0+00 Lat. 'D'

Sta 11+05 Lat. 'B'

Sta 0+55 Lat. 'C'

THIRTY FIRST STREET SOUTH

℄ Lateral 'A'

AVENUE 'C'

℄ Lateral 'B'

AVENUE 'B'

℄ Lateral 'C'-2

AVENUE 'C'

CLIFTON AVENUE

℄ 31ST STREET

Scale 1"=40'

Sta 1+65 Lat 'A'

Play Area

Sta 5+15

Sta 9+35

Sta 13+05

Sta 0+00 Lat 'A'

Sta 2+28 Lat 'B'

Sta 6+20

Sta 7+90

Sta 12+55

4" Stub Out @ M.H.

AVENUE 'B'

Sub Main

Sta 0+00 Beg. Lat 'B'

Sta 0+00 Beg. Lat 'C'

Sta 0+00 Lat 'C'

Sta 0+00 Lat 'D'

Sta 4+55

Sta 7+55

Sta 10+90

4" Stub Out @ M.H.

Sta 1+12

Sta 5+12

Sta 9+12

Sta 13+37

4" Stub Out @ M.H.

Lat. 'D'-2

Lat. 'D'-3

Lat. 'D'-4

℄ CLIFTON AVE

℄ BLUFF ST

℄ NAVAJO LANE

Construction Note: Wyes, shall be located as indicated by the above Stationings or at the first regular joint downstream.

SANITARY SEWER COLLECTION SYSTEM

F.H.A. Project # 102-00031-M

Drawn: E.S.

Checked: D.M.

8

SUB-MAIN

SUB-MAIN

CLIFTON

LATERAL

AVENUE A

AVENUE B

AVENUE C

CLIFTON AVE

CLIFTON


LATERAL


LATERAL

3/ST. STREET

COLONIAL PARK SANITARY SEWER
SUB-MAIN & LATERALS 'A' B & C'
DON C. MOEHRING C.E.
CONSULTING CIVIL ENGINEERS
314 BROWN BLDG. WICHITA, KANS.
FHA PROJ. NO. [illegible]

PLATE 2 - PLAN PROFILE O. A. R. R. & HANGING
THE FREDERICK POST CO., CHICAGO

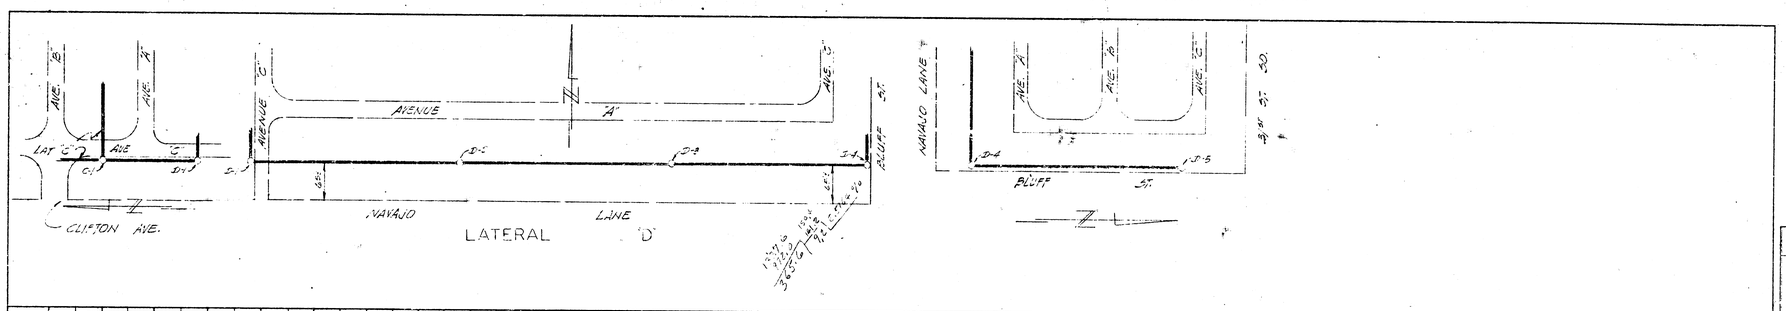

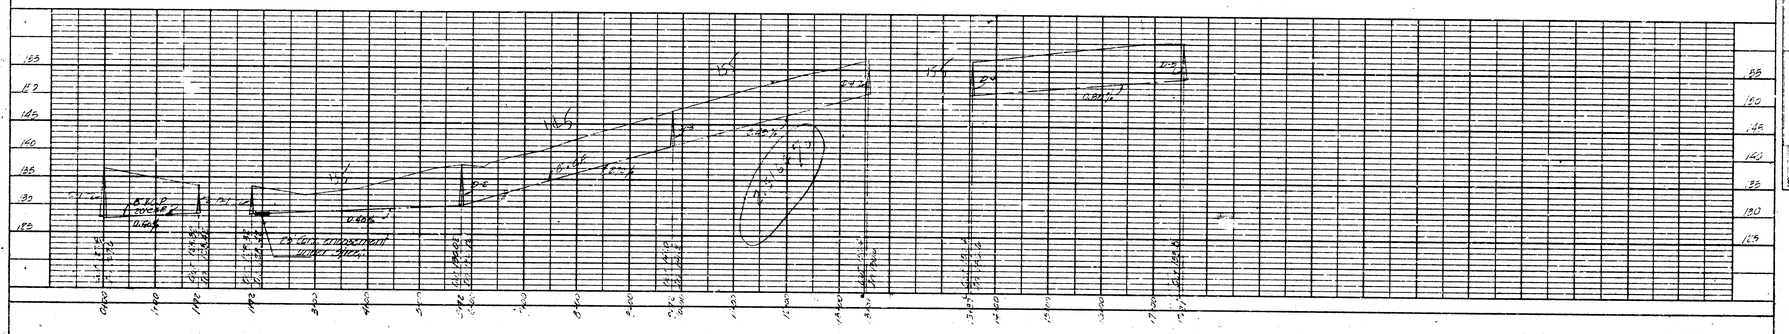

COLONIAL PARK SANITARY SEWER
LATERAL D AND TIE INTO CITY MAIN

CONSULTING CIVIL ENGINEERS
210 KFH BLDG WICHITA KANSAS
KHA PROJ. NO. 102-0013-M

10