



10-9-78  
 APPROVED FOR RECORD  
 By CITY ENGINEER  
 Date: \_\_\_\_\_  
 Signature: \_\_\_\_\_  
 Title: \_\_\_\_\_

NOTE TO CONTRACTOR  
 This project will be the responsibility of the contractor and contractor's insurance shall cover the project. The City of Wichita, Kansas, will not be responsible for any damage to property or persons during the construction of this project.

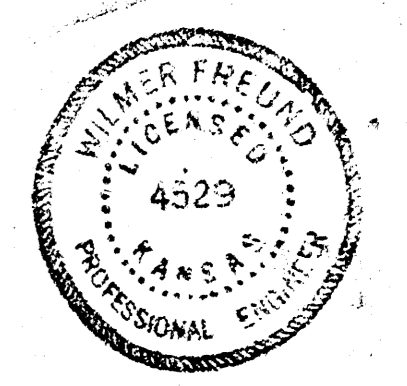

2  
 B.M. Top of Fire Hyd (1/4" in Mueller) 20' N. & 50' W. of Int. Clifton & Craig Sts., El. 137.10

B.M. RR Spk. in TP 30' W & 100' So. of NE Cor. NW 1/4, SW 1/4, Sec. 11, T8S, E. 1. El. 134.65

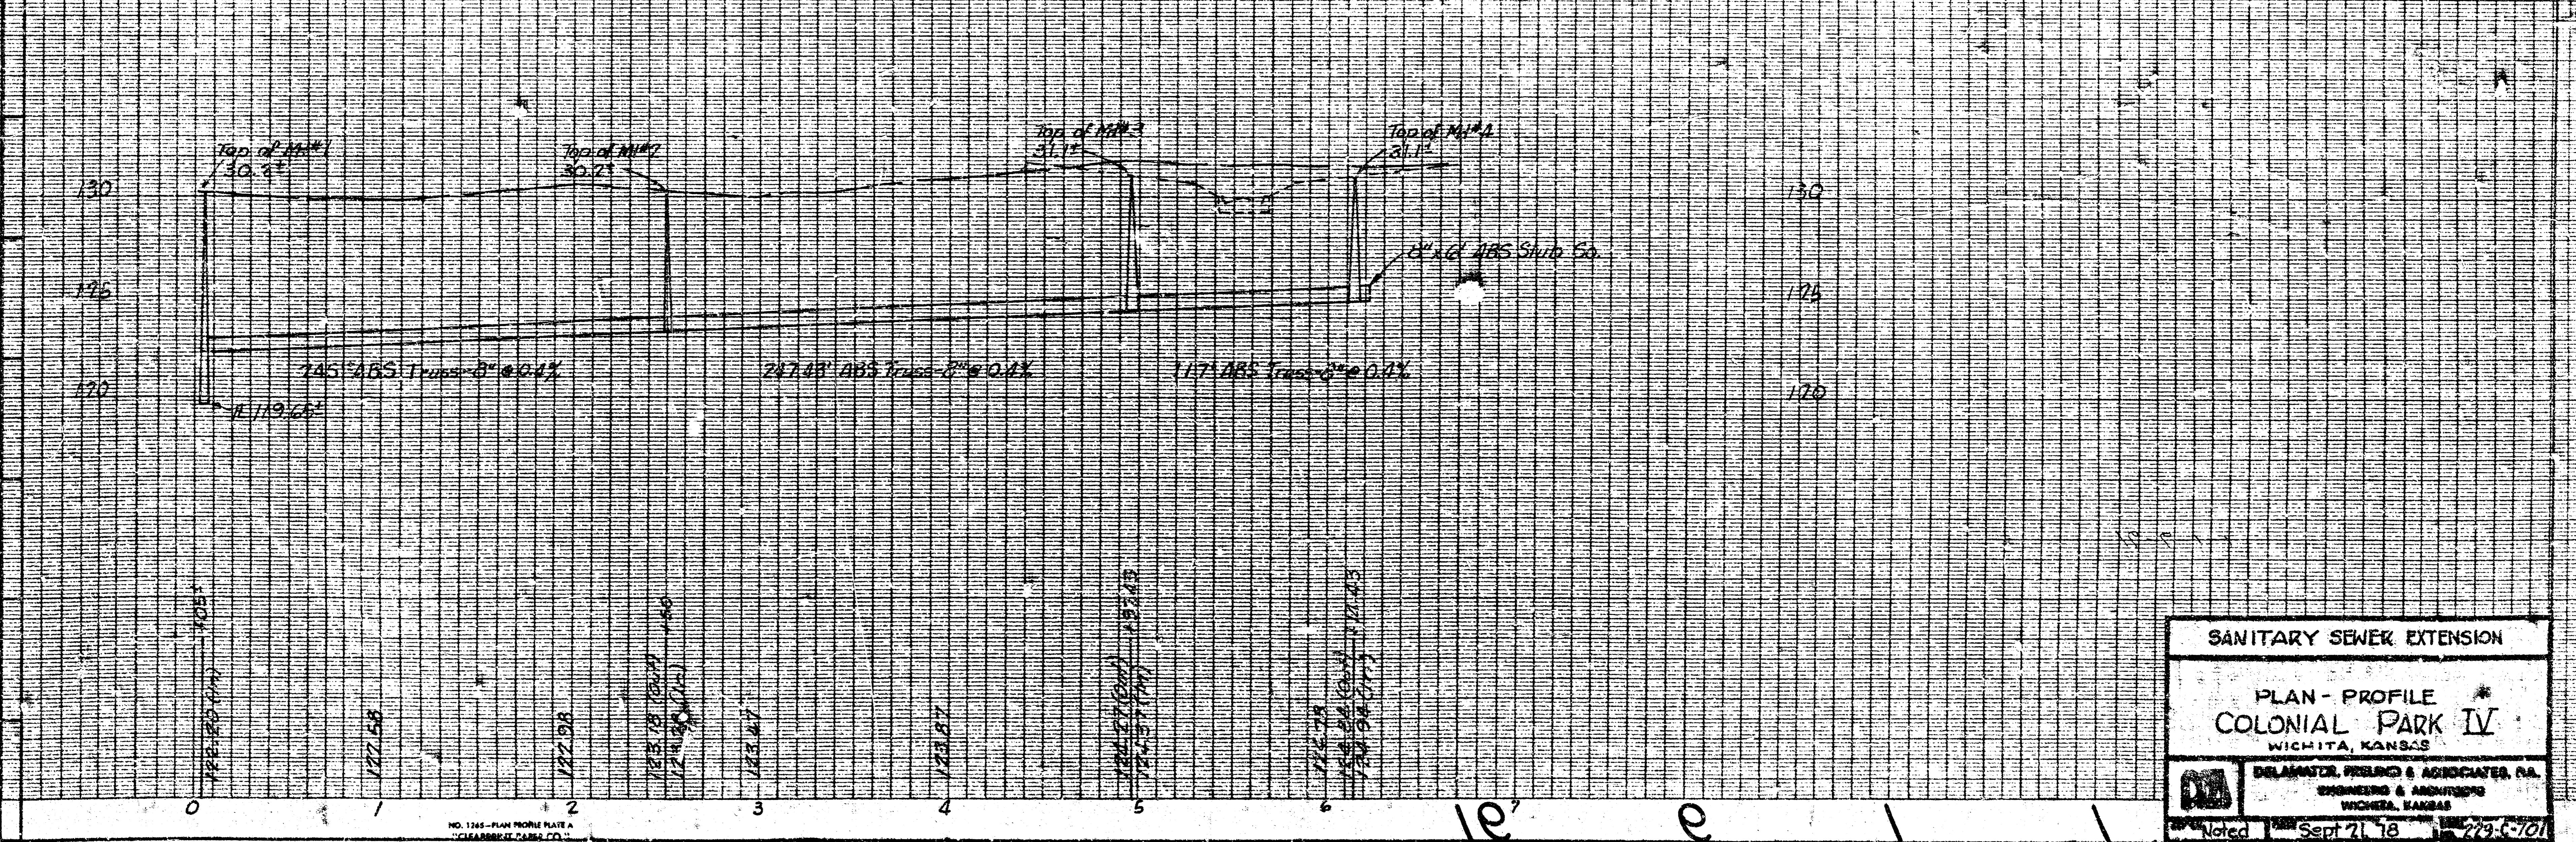

SANITARY SEWER EXTENSION  
 PLAN - PROFILE  
 COLONIAL PARK IV  
 WICHITA, KANSAS  
 DELAMATER, FREUND & ASSOCIATES, P.A.  
 ENGINEERS & ARCHITECTS  
 WICHITA, KANSAS  
 Noted Sept 21, 78

468-76-245-80627-000-008

AVAILABLE COPY... FILMED FROM THE BEST