BENCH MARKS

"M" in Mueller on Fire Hydrant at N.W. Corner pf 35th. St. No. and Webb Road. Elev.= 245.67

"□" Cut in top of Curb opposite S.W. Corner Lot 15. Elev.= 235.95

"□" Cut in top of Curb 55.86 ft. E. of S.W. corner lot 21. Elev.= 244.60

Nail in Cap in of 37th. St. No. 55.86 ft. E of N.W. corner of Lot 9. Elev= 236.40

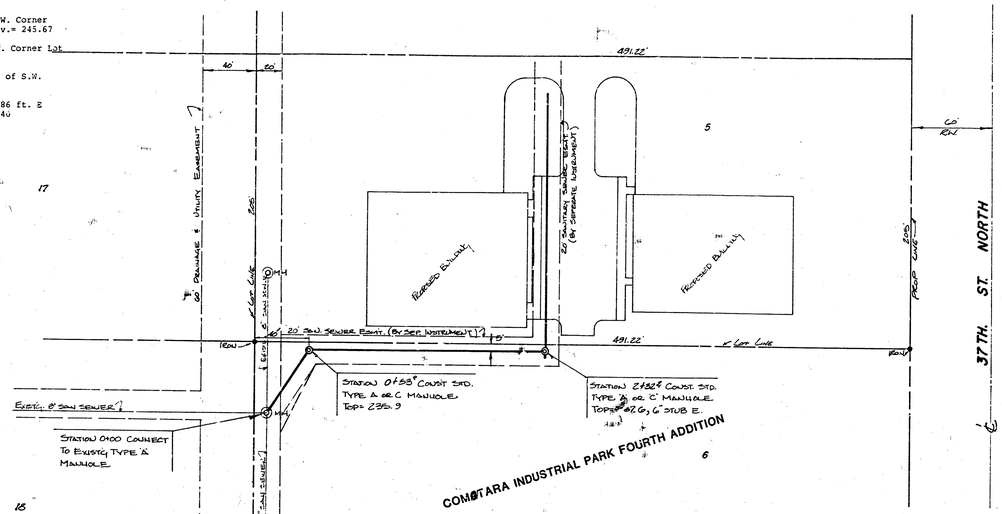

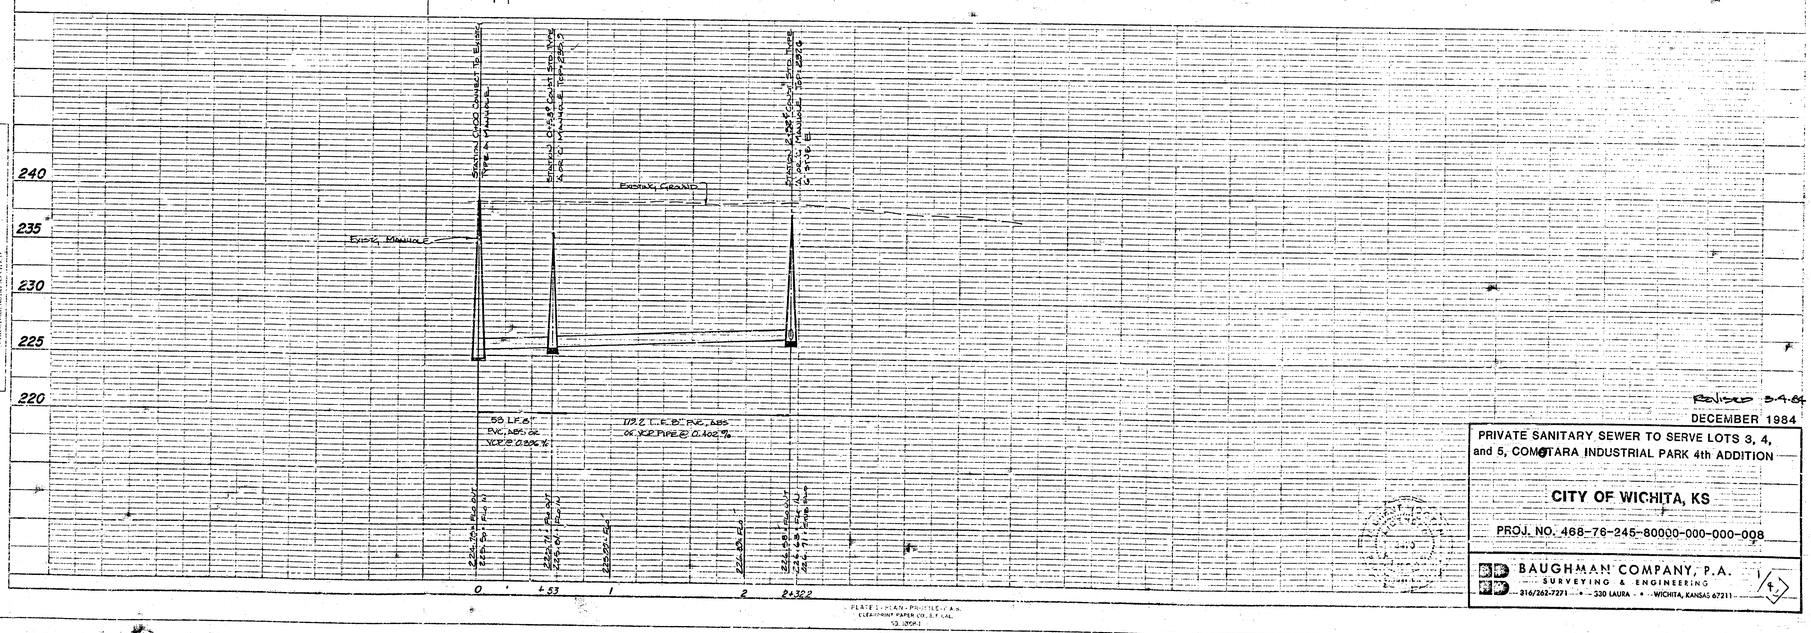

PLATE 1 - PLAN - PROFILE - P.A.S.
ELEVATIONS REFER TO U.S.C.&G.S. DATUM

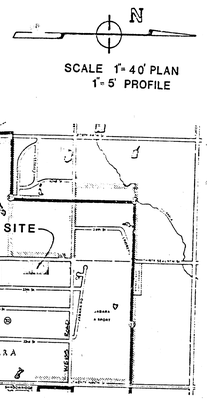

SCALE 1"= 40' PLAN
1"= 5' PROFILE

VICINITY MAP

APPROVED AS NOTED
By CITY ENGINEER OF WICHITA
Sanitary Sewers 9/6/84
Storm Sewers _____
Driveway Approaches _____

NOTE TO CONTRACTOR

The owner will be responsible for [illegible] CITY OF WICHITA [illegible] CITY OF WICHITA. The CITY [illegible] for the costs of inspection.

REVISED 3-4-84
DECEMBER 1984

PRIVATE SANITARY SEWER TO SERVE LOTS 3, 4, and 5, COMOTARA INDUSTRIAL PARK 4th ADDITION

CITY OF WICHITA, KS

PROJ. NO. 468-76-245-80000-000-000-008

BAUGHMAN COMPANY, P.A.
SURVEYING & ENGINEERING
316/262-7271 • 330 LAURA • WICHITA, KANSAS 67211

1/1

BENCH MARKS

"M" in Mueller on Fire Hydrant at N.W. Corner pf 35th. St. No. and Webb Road. Elev.= 245.67

"□" Cut in top of Curb opposite S.W. Corner Lot 15. Elev.= 235.95

"□" Cut in top of Curb 55.86 ft. E. of S.W. corner lot 21. Elev.= 244.60

Nail in Cap in of 37th. St. No. 55.86 ft. E of N.W. corner of Lot 9. Elev= 236.40

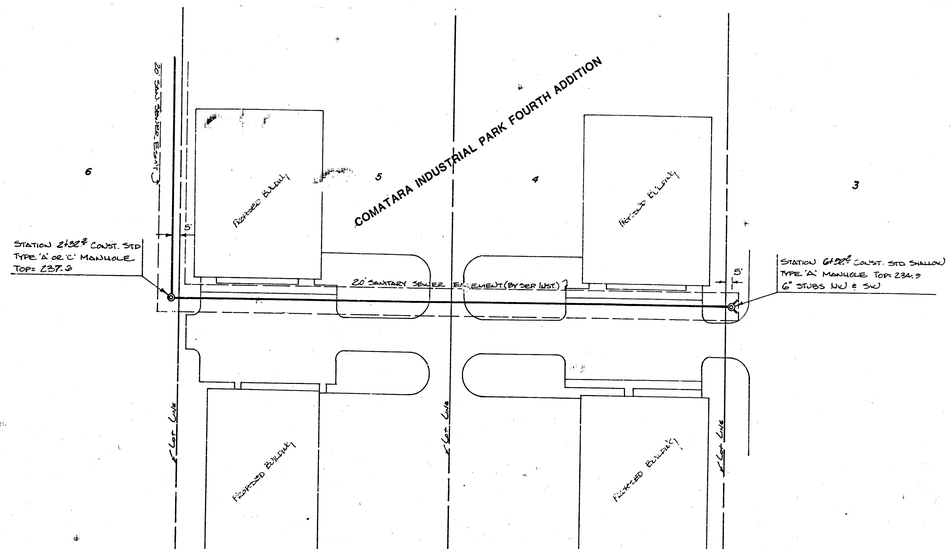

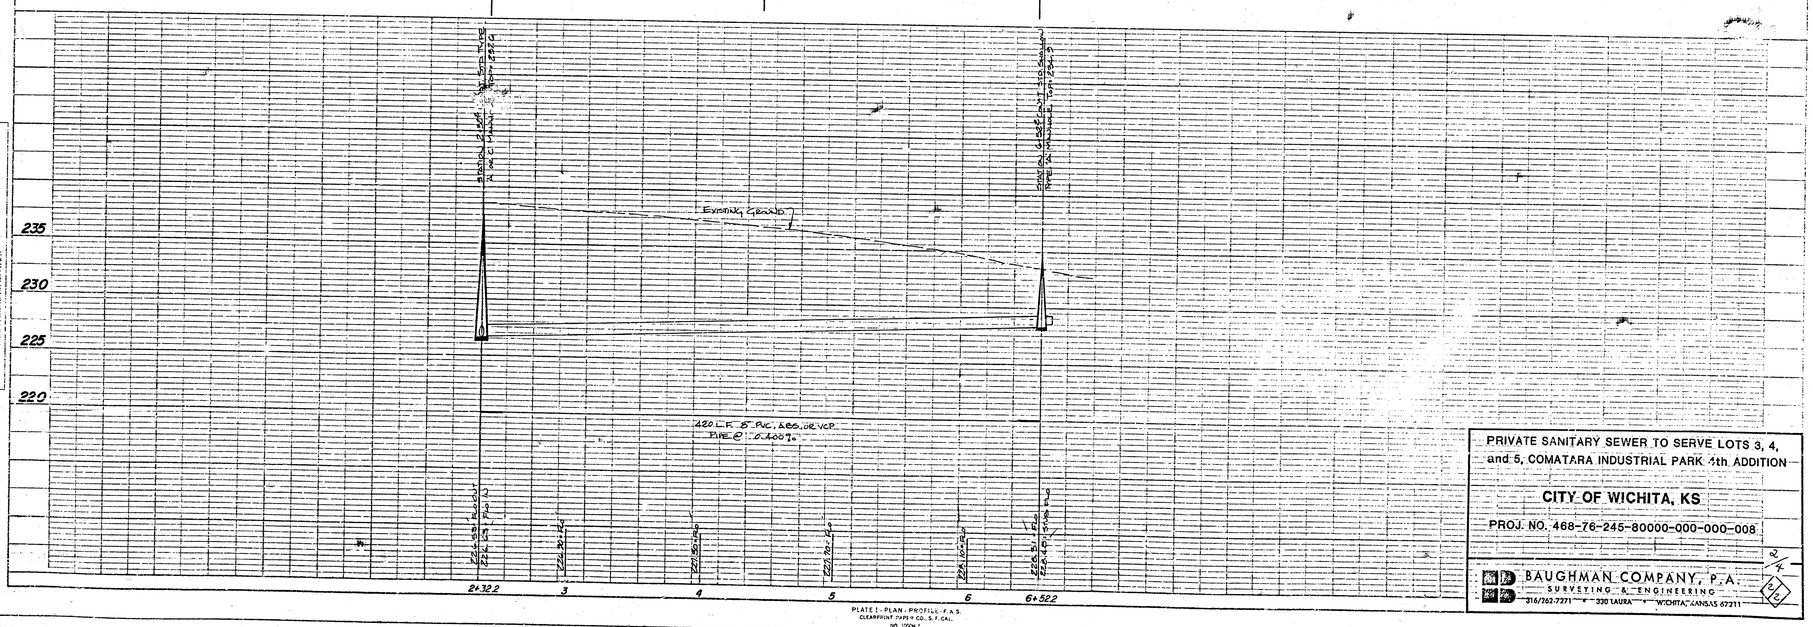

N

SCALE 1"=40' PLAN
1"= 5' PROFILE

PRIVATE SANITARY SEWER TO SERVE LOTS 3, 4, and 5, COMATARA INDUSTRIAL PARK 4th ADDITION

CITY OF WICHITA, KS

PROJ. NO. 468-76-245-80000-000-000-008

BAUGHMAN COMPANY, P.A.
SURVEYING & ENGINEERING
316/262-7271 — 330 LAURA — WICHITA, KANSAS 67211

R/W 2/4

PLATE I - PLAN - PROFILE - F.A.S.
CLEARPRINT PAPER CO., S. F. CAL.
NO. 1076H 1

FILMED FROM THE BEST

BENCH MARKS

"M" in Mueller on Fire Hydrant at N.W. Corner pf 35th. St. No. and Webb Road. Elev.= 245.67

"□" Cut in top of Curb opposite S.W. Corner Lot 15. Elev.= 235.95

"□" Cut in top of Curb 55.86 ft. E. of S.W. corner lot 21. Elev.= 244.60

Nail in Cap in of 37th. St. No. 55.86 ft. E of N.W. corner of Lot 9. Elev= 236.40

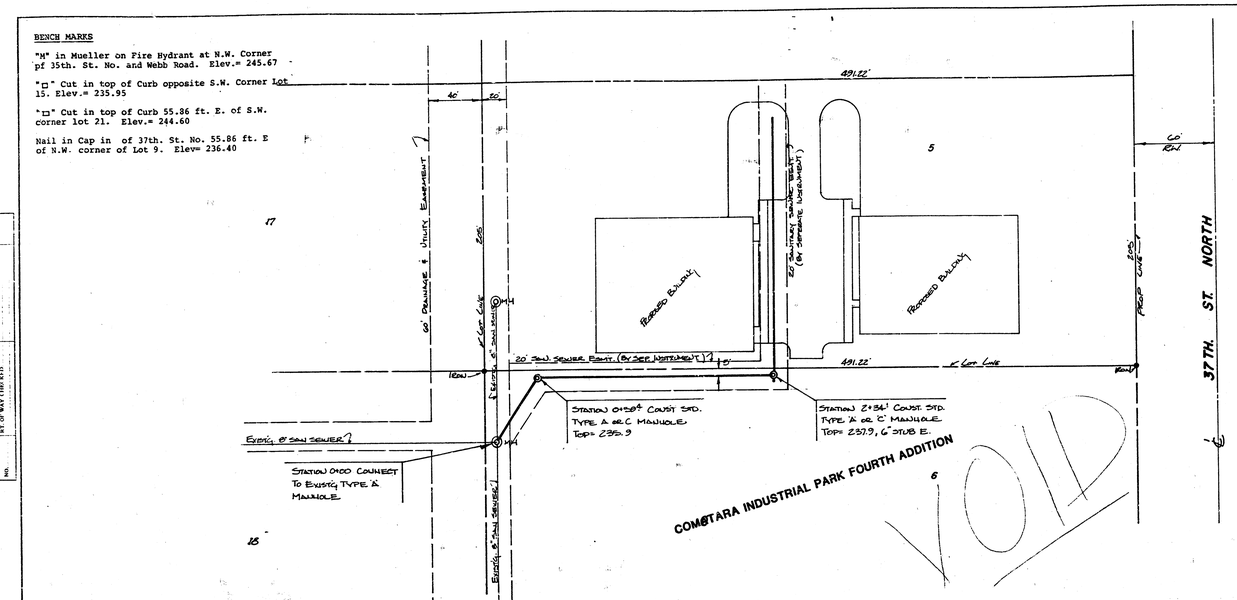

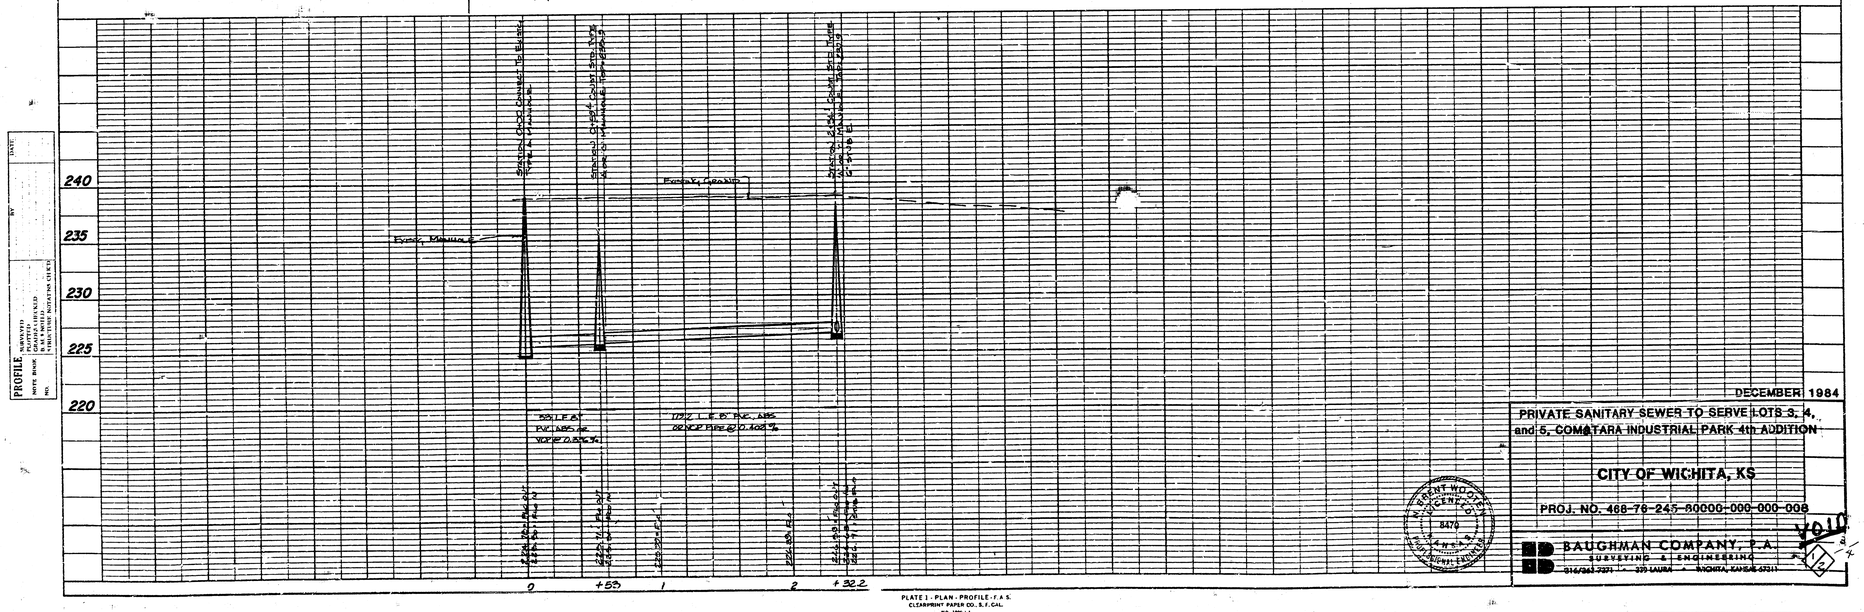

PLATE 3 - PLAN - PROFILE - F.A.S.
CLEARPRINT PAPER CO., S.F. CAL.
NO. 1000H-1

N

SCALE 1"= 40' PLAN
1"= 5' PROFILE

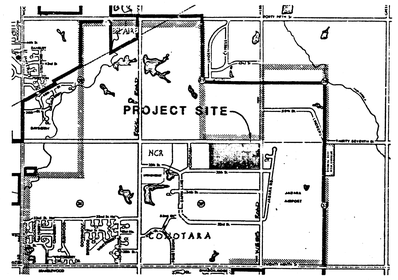

VICINITY MAP

APPROVED AS NOTED
By CITY ENGINEER OF WICHITA
Sanitary Sewers 20B 12/5/84
Storm Sewers _____
Driveway Approaches _____

NOTE TO CONTRACTOR

This project will be constructed under the supervision of the CITY ENGINEER and conforming to the SPECIFICATIONS of the CITY OF WICHITA. The CONTRACTOR will prepay the City of Wichita for all costs of Inspection.

DECEMBER 1984

PRIVATE SANITARY SEWER TO SERVE LOTS 3, 4, and 5, COMOTARA INDUSTRIAL PARK 4th ADDITION

CITY OF WICHITA, KS

PROJ. NO. 468-78-245-80000-000-000-008

VOID

BAUGHMAN COMPANY, P.A.
SURVEYING & ENGINEERING
316/263-7331 339 LAURA WICHITA, KANSAS 67211

8470

FILMED FROM THE BEST AVAILABLE COPY....

BENCH MARKS

"M" in Mueller on Fire Hydrant at N.W. Corner pf 35th. St. No. and Webb Road. Elev.= 245.67

"□" Cut in top of Curb opposite S.W. Corner Lot 15. Elev.= 235.95

"□" Cut in top of Curb 55.86 ft. E. of S.W. corner lot 21. Elev.= 244.60

Nail in Cap in of 37th St. No. 55.86 ft. E of N.W. corner of Lot 9. Elev= 236.40

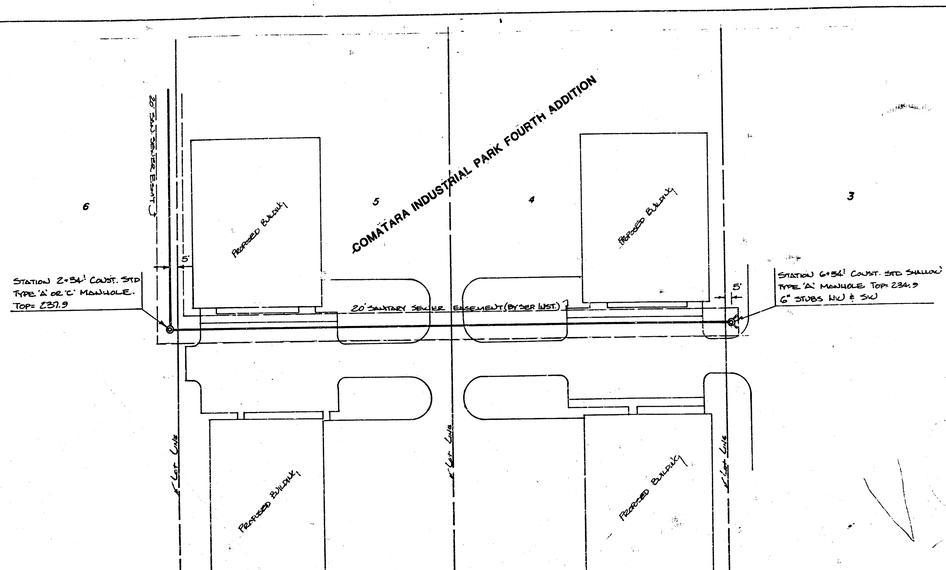

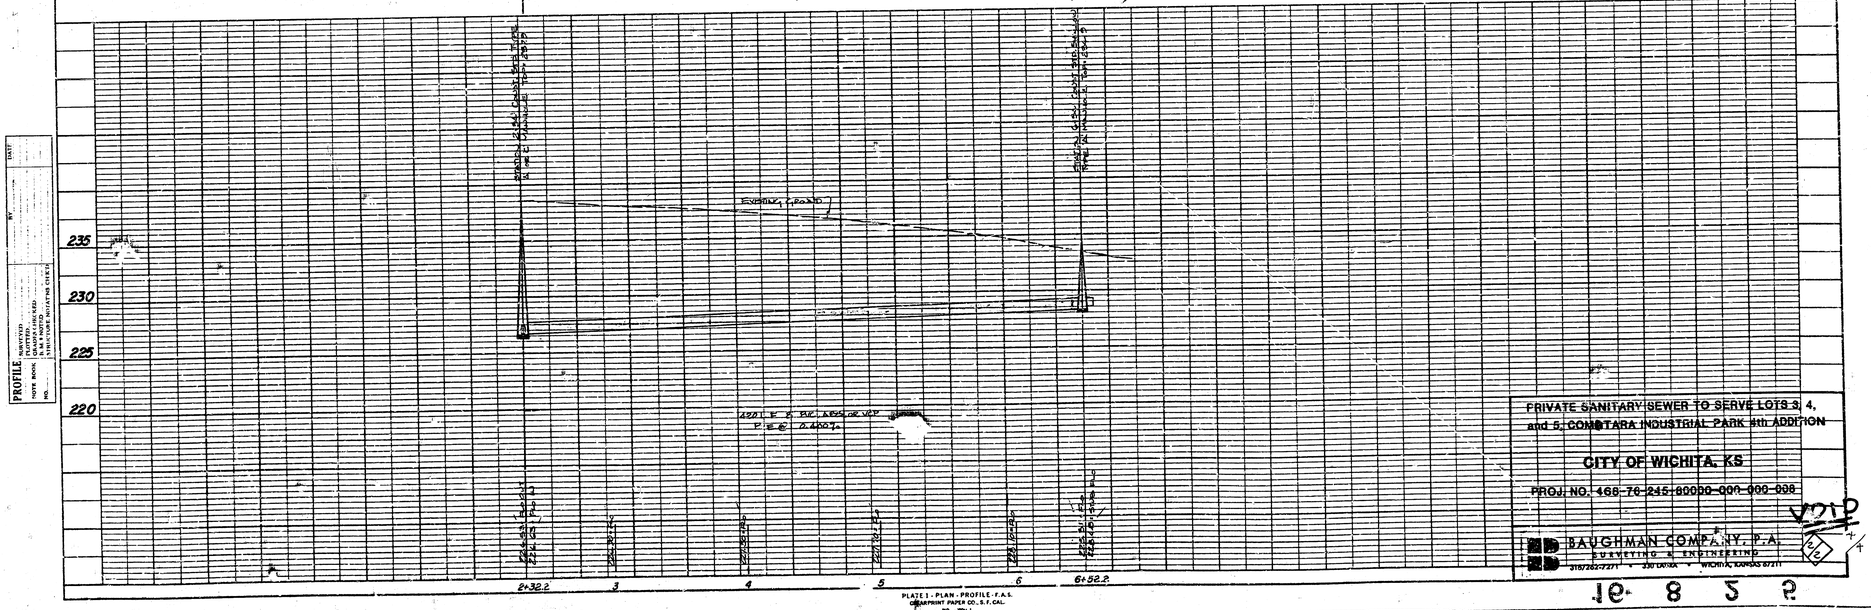

N

SCALE 1"= 40' PLAN
1"= 5' PROFILE

PRIVATE SANITARY SEWER TO SERVE LOTS 3, 4, and 5, COMOTARA INDUSTRIAL PARK 4th ADDITION

CITY OF WICHITA, KS


BAUGHMAN COMPANY, P.A.
SURVEYING & ENGINEERING

VOID

PLAT 1 - PLAN - PROFILE - F.A.S.
NO. 4804-1

PLAN — SURVEYED / PLOTTED / CHECKED / NOTE BOOK / NO. — DATE / BY

PROFILE — SURVEYED / PLOTTED / CHECKED / H. & V. NOTES / NOTE BOOK / NO. — DATE / BY

FILMED FROM THE BEST AVAILABLE COPY