
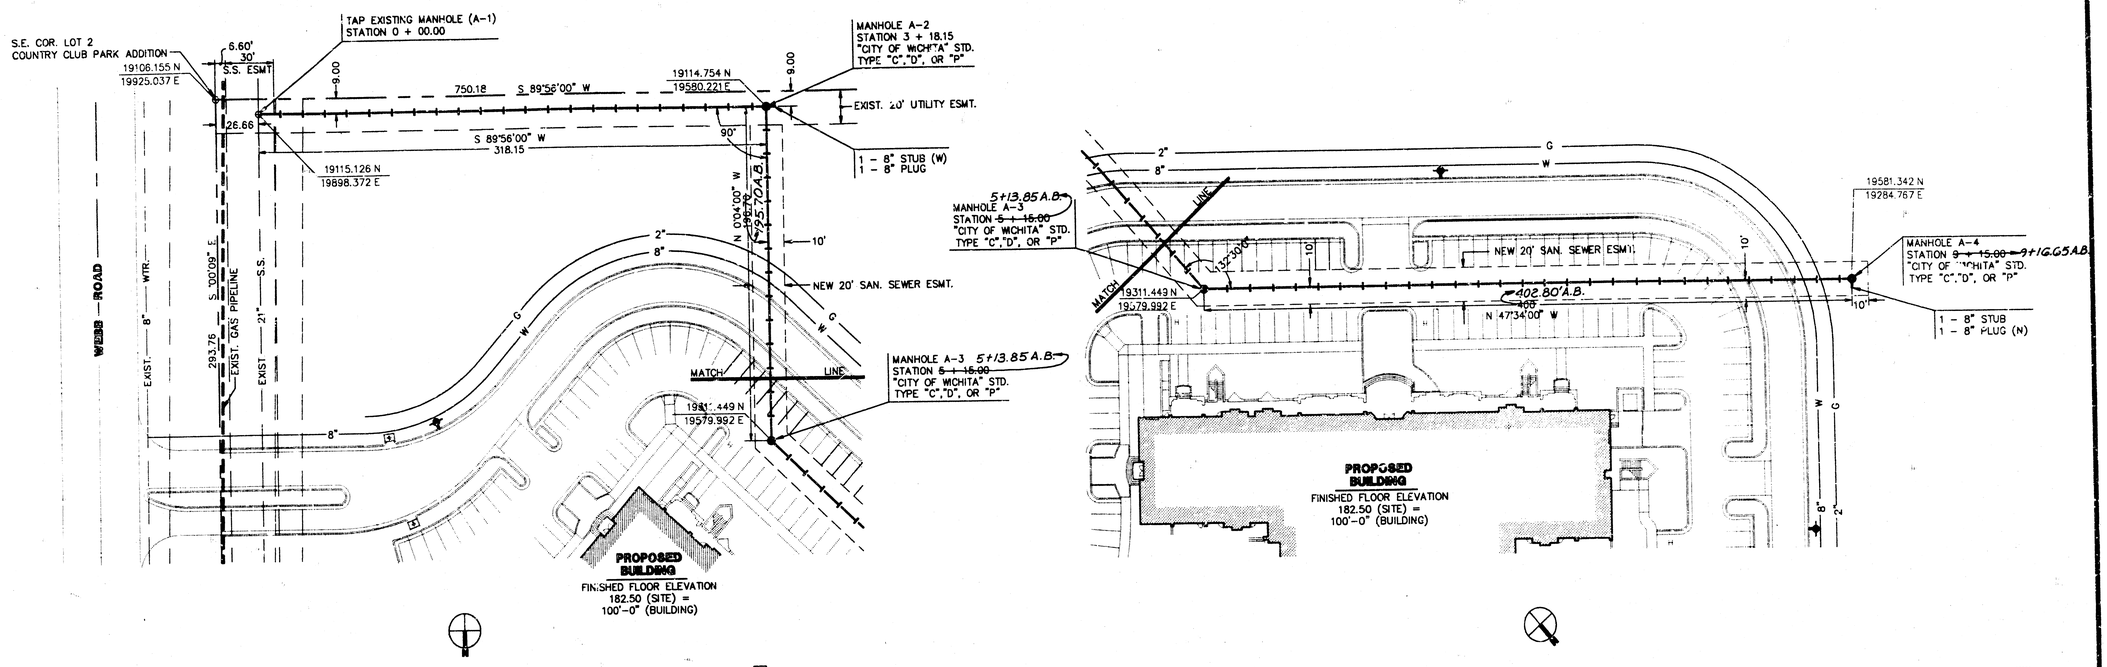


A SANITARY SEWER PLAN AND PROFILE

SCALE: PLAN – 1" = 40'
PROFILE – 1" = 40' HORIZ.
– 1" = 4' VERT.

PRIVATE SANITARY SEWER EXTENSION
TO SERVE COUNTRY CLUB PARK ADDITION
C.O.W. PROJ. NO.

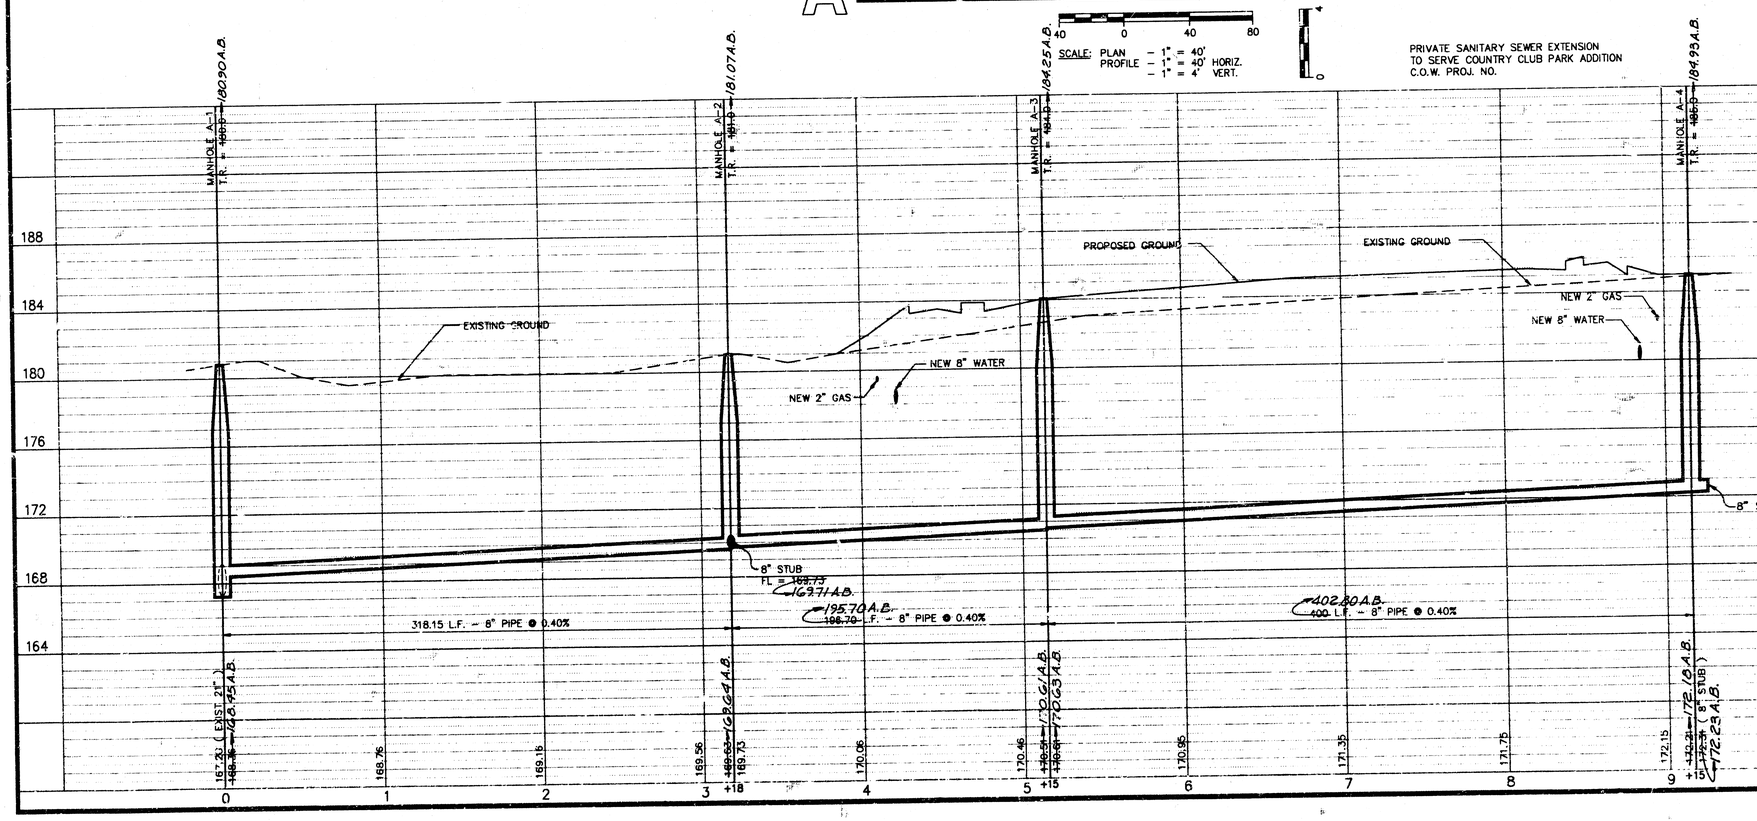

ROBERT D. FRIESEN
LICENSED
6719
KANSAS
PROFESSIONAL ENGINEER

COUNTRY CLUB PARK - BUILDING ONE
SANITARY SEWER EXTENSION IMPROVEMENTS

KEY MAP

MICHAEL E. LINDEBAK, P.E. – CITY ENGINEER
INDEX CODE 219PPS607853

BOOKED
2.90
RAV

AS BUILT:
11-89

GOSSEN LIVINGSTON ASSOCIATES, INC.
ARCHITECTS PLANNERS ENGINEERS (316) 267-3887

Designed By RDF
Drawn By RDF
Job No. 882.100
Date JUNE 20, 1989

Sheet 3 of 3

FILMED FROM THE BEST AVAILABLE COPY

CONSTRUCTION PLANS FOR

SANITARY SEWER EXTENSION IMPROVEMENTS

TO SERVE


COUNTRY CLUB PARK ADDITION

TO

THE CITY OF WICHITA,

SEDGWICK COUNTY, KANSAS

MICHAEL E. LINDEBAK, P.E. - CITY ENGINEER

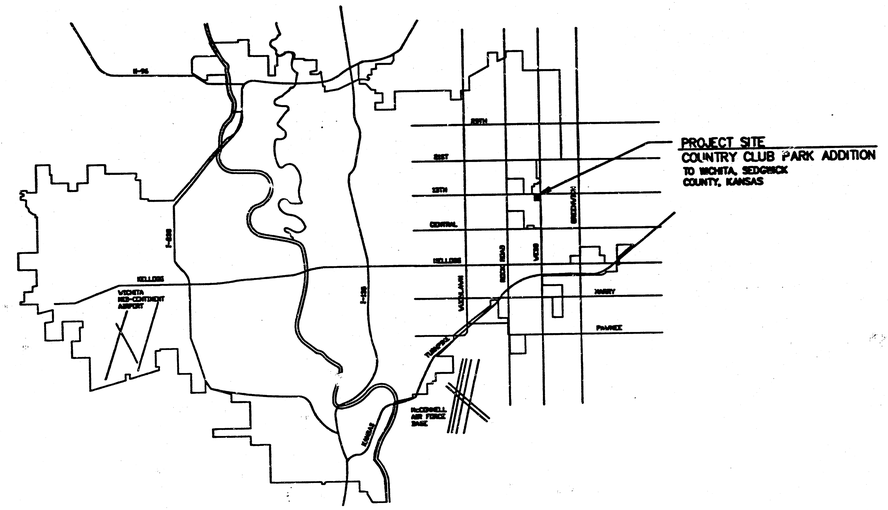

LOCATION MAP

INDEX CODE 219PPS607853 61

JUNE, 1989

PLANS PREPARED BY

GOSSEN LIVINGSTON ASSOCIATES, P.A.

ARCHITECTS PLANNERS ENGINEERS (316) 265-9367

420 S. EMPORIA, WICHITA, KANSAS 67020

APPROVED AS NOTED
By CITY ENGINEER OF WICHITA
Sanitary Sewers 6-20-89
Storm Sewers
Driveway Approaches
Water Mains
Paving

NOTE TO CONTRACTOR

INSPECTION AND TESTING FOR THIS PROJECT IS TO BE PROVIDED BY A LICENSED CONSULTING ENGINEERING FIRM UNDER CONTRACT WITH THE OWNER/DEVELOPER. SAID INSPECTION TO BE IN ACCORDANCE WITH THE CITY OF WICHITA STANDARD CONSTRUCTION ENGINEERING PRACTICES AND CERTIFIED BY A LICENSED PROFESSIONAL ENGINEER. NO WORK SHALL BE PERFORMED IN DEDICATED EASEMENTS OR THE PUBLIC RIGHT-OF-WAY BY THE CONTRACTOR WITHOUT SUCH INSPECTION NOR SHALL ANY WORK BE COMMENCED IN DEDICATED EASEMENTS OR PUBLIC RIGHT-OF-WAY WITHOUT WRITTEN AUTHORIZATION BY THE CITY ENGINEER.

ROBERT D. FRIESEN LICENSED 6719 KANSAS PROFESSIONAL ENGINEER

INSPECTION AND TESTING FOR THIS PROJECT IS TO BE PROVIDED BY A LICENSED CONSULTING ENGINEERING FIRM CONTRACTED BY THE OWNER/DEVELOPER. SAID INSPECTION TO BE IN ACCORDANCE WITH THE CITY OF WICHITA STANDARD CONSTRUCTION ENGINEERING PRACTICES AND CERTIFIED BY A LICENSED PROFESSIONAL ENGINEER. NO WORK SHALL BE PERFORMED IN DEDICATED EASEMENTS OR THE PUBLIC RIGHT-OF-WAY BY THE CONTRACTOR WITHOUT SUCH INSPECTION NOR SHALL ANY WORK BE COMMENCED IN DEDICATED EASEMENTS OR RIGHT-OF-WAY WITHOUT WRITTEN AUTHORIZATION BY THE CITY ENGINEER.

COUNTRY CLUB PARK - BUILDING ORDER
SANITARY SEWER EXTENSION IMPROVEMENTS

KEY MAP

MICHAEL E. LINDEBAK, P.E. - CITY ENGINEER
INDEX CODE: 219PPS607853

GOSSEN LIVINGSTON ASSOCIATES P.A.
ARCHITECTS PLANNERS ENGINEERS
420 S. EMPORIA, WICHITA, KANSAS 67202 (316) 265-9367


Designed By RDF
Drawn By RDF
Job No. 882.100
Date JUNE 20, 1989

Sheet 1 of 3 2/4

FILMED FROM THE BEST COPY AVAILABLE

COUNTRY CLUB PARK ADDITION

WICHITA, SEDGWICK COUNTY, KANSAS

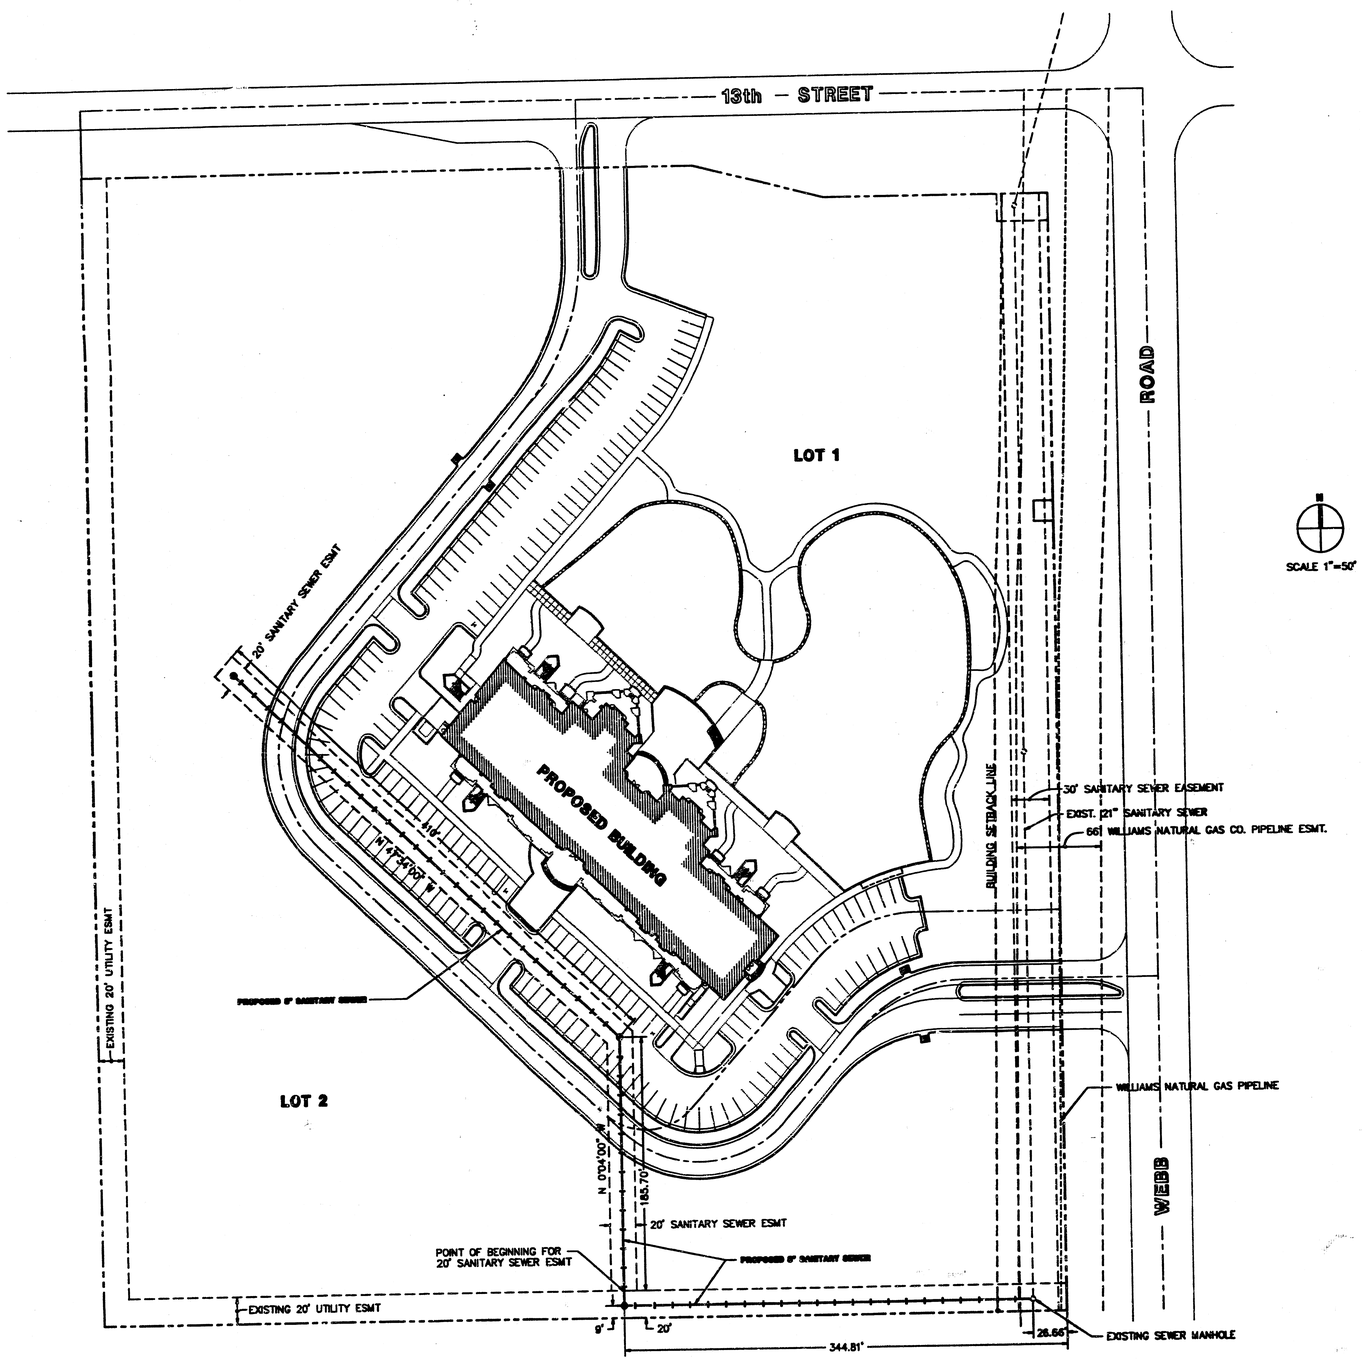

ROBERT D. FRIESEN LICENSED 6719 KANSAS PROFESSIONAL ENGINEER

COUNTRY CLUB PARK - BUILDING ONE
SANITARY SEWER EXTENSION IMPROVEMENTS


KEY MAP


MICHAEL E. LINDEBAK, P.E. – CITY ENGINEER
INDEX CODE 219PS607853

GOSSEN LIVINGSTON ASSOCIATES, P.A.
Designed By ROF
Drawn By ROF
Job No. 662.100
Date JUNE 20, 1989

Sheet 2 of 8

FILMED FROM THE BEST AVAILABLE COPY

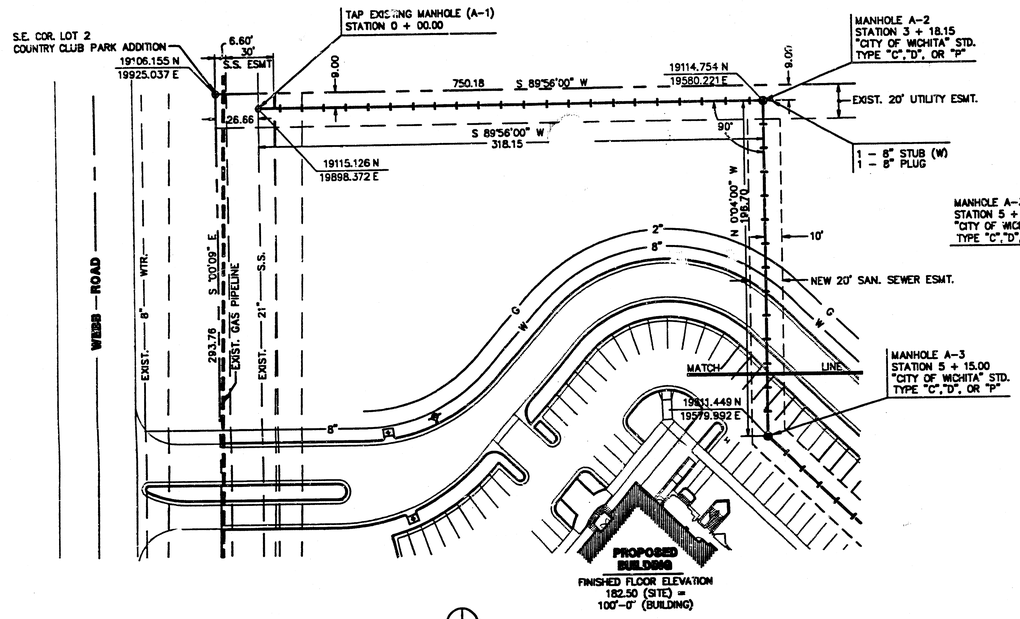


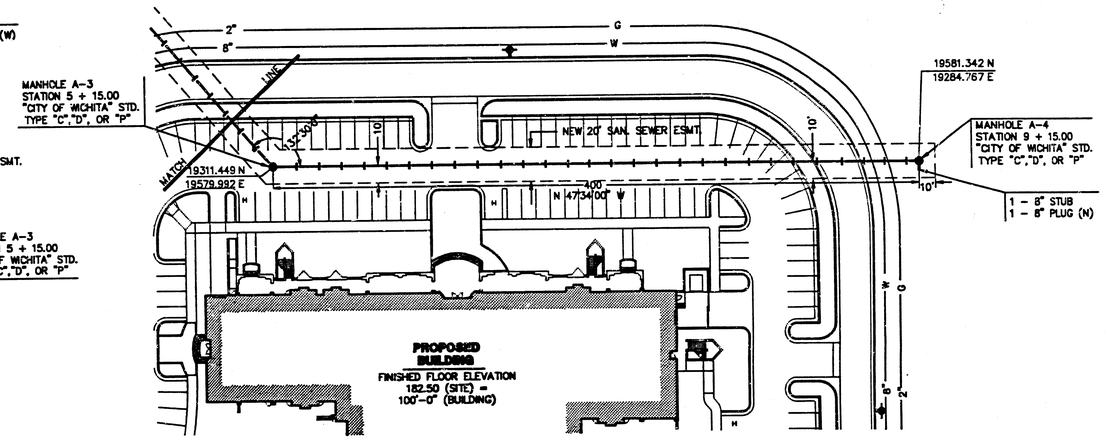

A SANITARY SEWER PLAN AND PROFILE

SCALE: PLAN - 1" = 40' HORIZ.
PROFILE - 1" = 4' VERT.

PRIVATE SANITARY SEWER EXTENSION
TO SERVE COUNTRY CLUB PARK ADDITION
C.O.W. PROJ. NO.

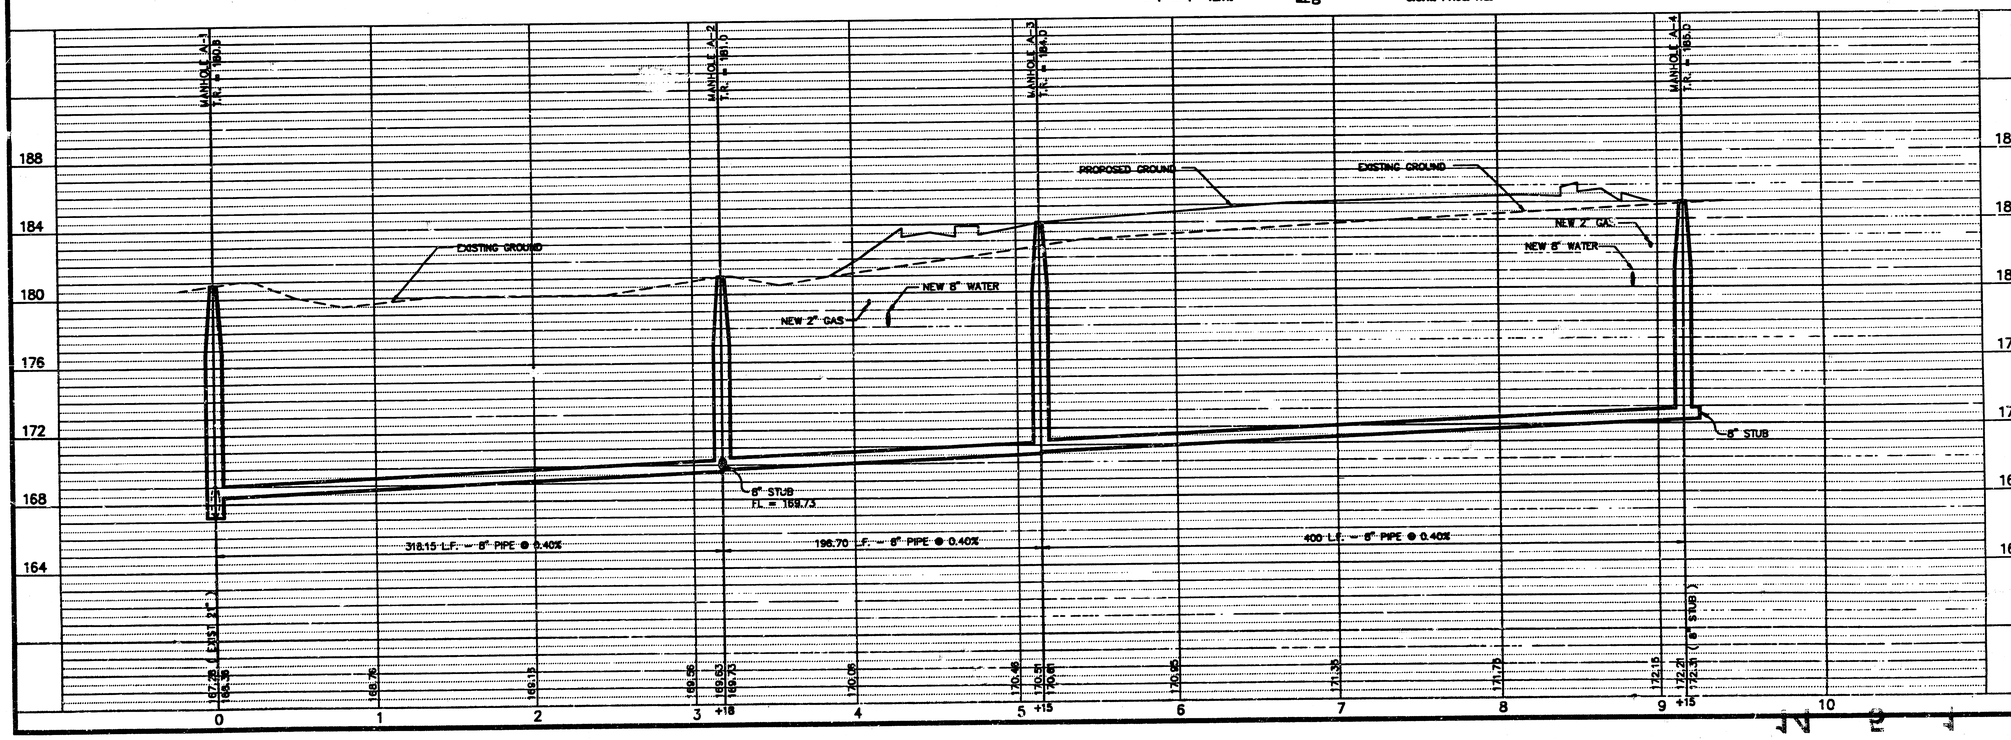

ROBERT D. FRIESEN
LICENSED
6719
KANSAS
PROFESSIONAL ENGINEER

COUNTRY CLUB PARK - BUILDING ONE
SANITARY SEWER EXTENSION IMPROVEMENTS

KEY MAP

MICHAEL E. LINDEBAK, P.E. - CITY ENGINEER
INDEX CODE 219PS807853

COSSEN LIVINGSTON ASSOCIATES P.A.

Designed By RDF
Drawn By RDF
Job No. 662.100
Date JUNE 20, 1989

Sheet 2 of 3

4/4

FILMED FROM THE BEST