

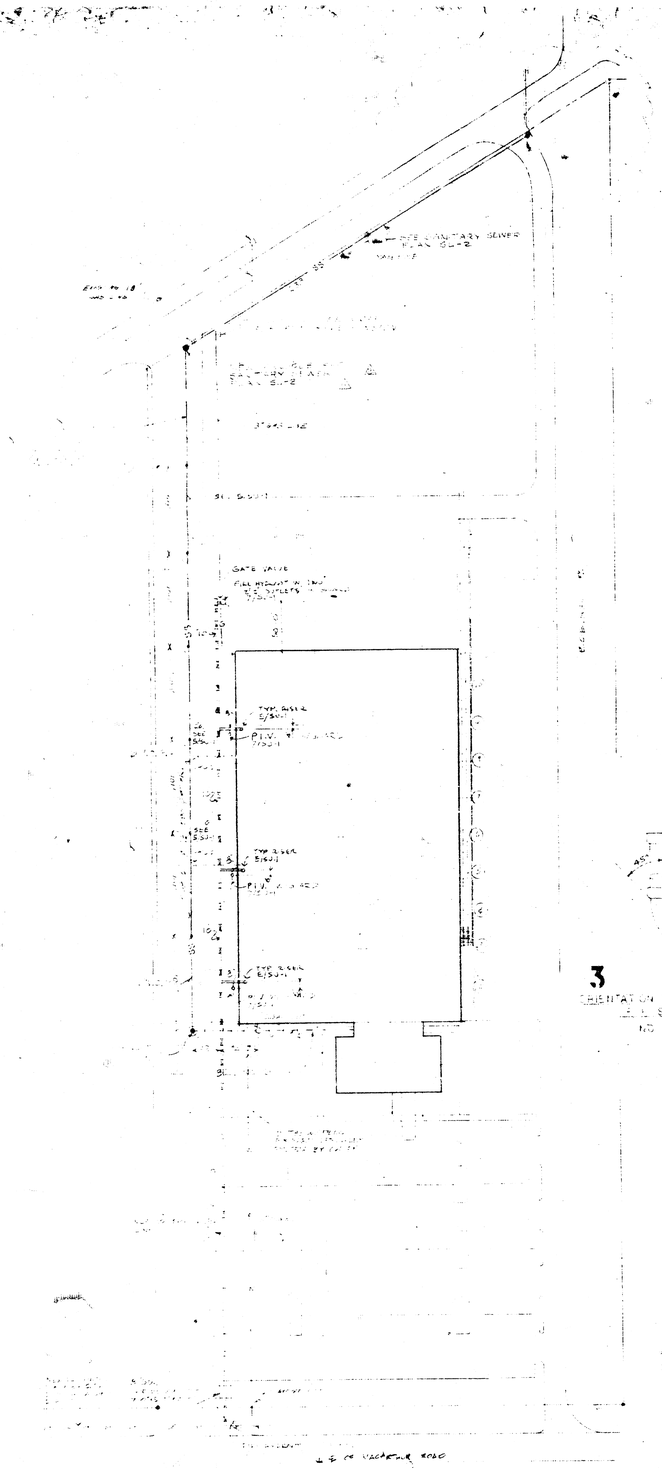


A SITE PLAN

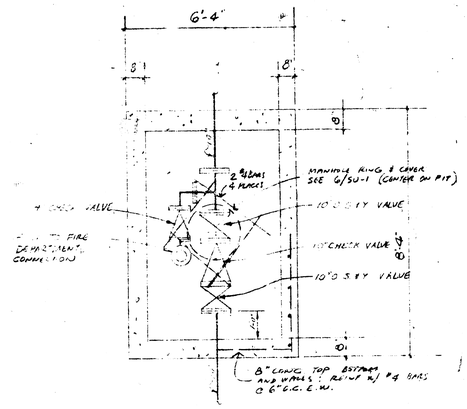


B PIT DETAIL

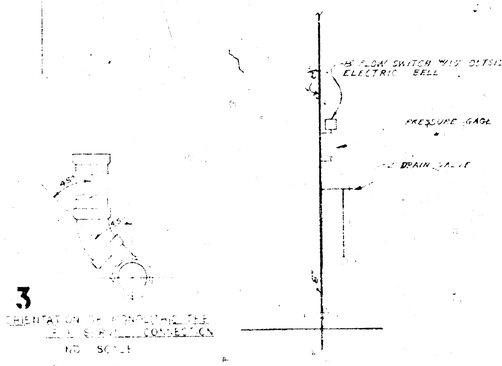

3

ORIENTATION OF FIRE PROTECTION TEE
& FIRE DEPARTMENT CONNECTION
NO SCALE

E DETAIL

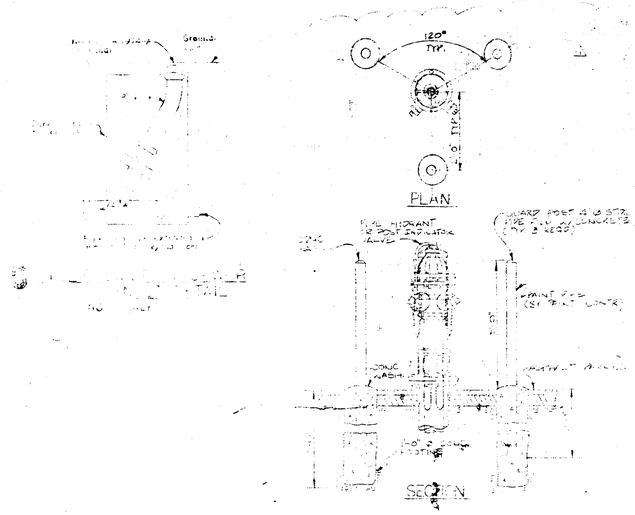

7 TYP. GUARD POST DETAIL

NOTES:

ALL MATERIAL EXCAVATED BENEATH BUILDING OR ELEVATED PAVEMENTS SHALL BE REPLACED WITH CONCRETE TO SUBGRADE. CONCRETE REPLACEMENT SHALL EXTEND TO THE LIMITS OF EXCAVATION. HAMMERS SHALL EXTEND TO AND INCLUDE THE FIRST JOINT OF SOIL BEYOND THE MANHOLE EXCAVATION LIMITS.

ALL MANHOLE RINGS SHALL BE SET IN MORTAR. [illegible] SHALL BE SET ON A BED OF 1:2 CEMENT MORTAR 12" THICK AND EXTEND 12" BEYOND THE OUTSIDE OF THE MANHOLE BASE. ALL MANHOLE RINGS SHALL BE SET IN PAVEMENT OR IN AREAS TO BE IMMEDIATELY PAVED SHALL HAVE THE CONCRETE IMMEDIATELY BEARING SURFACES AND TAPER JOINTS WITH CEMENT MORTAR TO CONFORM TO THE A.S.T.M. SERIAL DESIGNATION A 48.

TRENCH BACKFILL SHALL BE CROWNED OVER TRENCH [illegible] TO A HEIGHT OF 6" MINIMUM AND NOT LESS THAN NEEDED TO BE REPLACED BY PAVEMENT. BACKFILL SHALL BE PLACED IN NOT MORE THAN 6" LAYERS AND COMPACTED BY SUITABLE MECHANICAL MEANS.

TRENCH BACKFILL SHALL BE FREELY DEPOSITED AND EXCAVATED MATERIAL FREE FROM DEBRIS, ORGANIC MATERIAL, AND STONES LARGER THAN [illegible] MAXIMUM DENSITY AS DETERMINED BY A.A.S.H.O. STANDARD METHOD T-99. GRADING OF THE TOP OF CONSTRUCTED TRENCH SHALL BE MADE TO CONFORM TO THE FINISHED GRADE OF THE [illegible]

PRINTS ISSUED

DATE	PURPOSE	NO.
6/19/71	FOR APPROVAL	
7/6/71	OWNER APPROVAL	
12/7	PER SECTION [illegible]	2

FOR CONSTRUCTION:

REVISIONS

DATE	ITEM	NO
12/7	PER SECTION [illegible]	2

[illegible] COMPANY

CALVIN KINGDON | PA. 512 S. WARNER WICHITA, KANSAS 67218 PHONE (316) 269-9088
ARCHITECTS & ENGINEERS

DRAWN	CHECKED
EBW/GAS	GMW

RELATED DRAWINGS

SHELL	
DETAILS	
STRUCTURE	
MECHANICAL	
ELECTRICAL	
OTHER	

ESQUENCE NUMBER

OF SHEETS

MANUFACTURING FACILITIES

[illegible] SYSTEMS CORP. INC


PROJECT NUMBER [illegible]

KEY PLAN

TENANT


SHEET TITLE

TENANT NUMBER	SHEET NUMBER
	SU-1

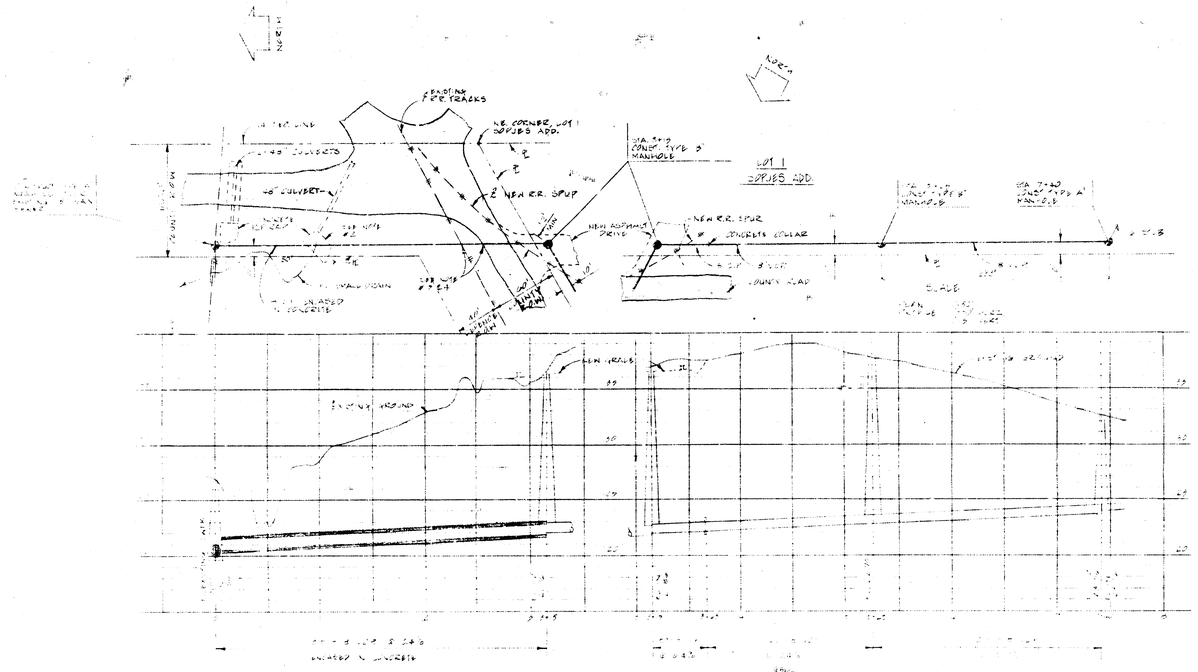




CONCRETE ENCASEMENT DETAIL
NO SCALE

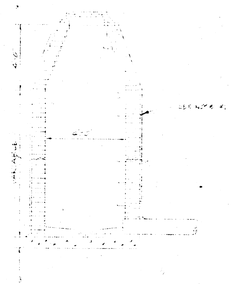

TYPE A MANHOLE
NO SCALE

 

TYPE B MANHOLE
NO SCALE



PAVEMENT REPLACEMENT DETAIL
NO SCALE

AS BUILT 5-4-72
BASED 3-3-72
@ I-45 & W.D.U.

PRINTS ISSUED

DATE	PURPOSE	NO

FOR CONSTRUCTION:

REVISIONS

DATE	ITEM	NO

THE LAW COMPANY

CALVIN KINGDON FA BERGER
ARCHITECTS & ENGINEERS

DRAWN	CHECKED

RELATED DRAWINGS

SHELL	
DETAILS	
STRUCTURE	
MECHANICAL	
ELECTRICAL	
OTHER	

SEQUENCE NUMBER

OF SHEETS

PROJECT NUMBER

KEY PLAN


TENANT

SHEET TITLE

TENANT NUMBER


SHEET NUMBER

SU 2

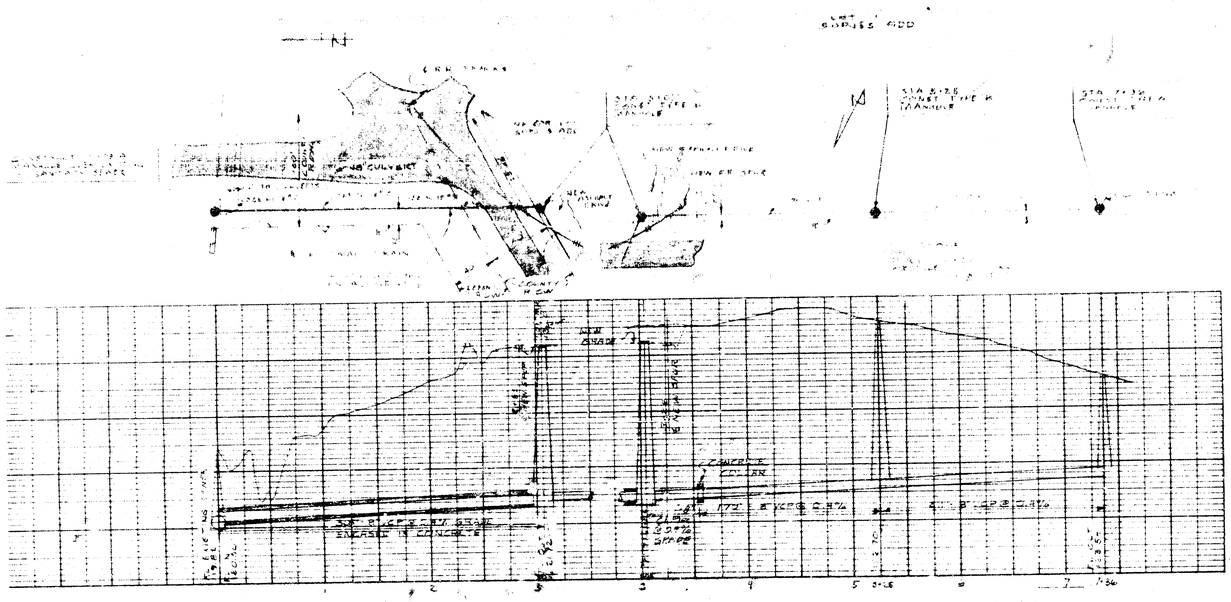





CONCRETE ENCASEMENT DETAIL
N. SCALE

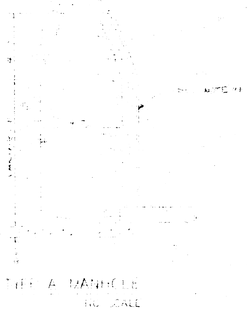


TYPE A MANHOLE
NO SCALE

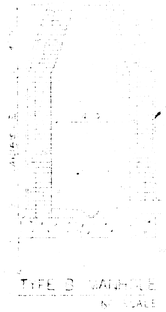

TYPE B MANHOLE
N. SCALE

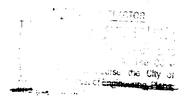

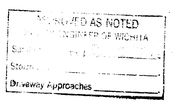

PRINTS ISSUED

DATE	PURPOSE	NO.

FOR CONSTRUCTION:

REVISIONS

DATE	ITEM	NO.

THE LAW COMPANY

CALVIN KINGDON BERGER | P.A.
ARCHITECTS & ENGINEERS
213 E. MARKET
WICHITA, KANSAS 67202
PHONE (316) 262-2566

DRAWN	CHECKED

RELATED DRAWINGS

SHELL	
DETAILS	
STRUCTURE	
MECHANICAL	
ELECTRICAL	
OTHER	

SEQUENCE NUMBER

OF SHEETS

PROJECT NUMBER

KEY PLAN

TENANT

SHEET TITLE

TENANT NUMBER	SHEET NUMBER
	1

OF SHEETS