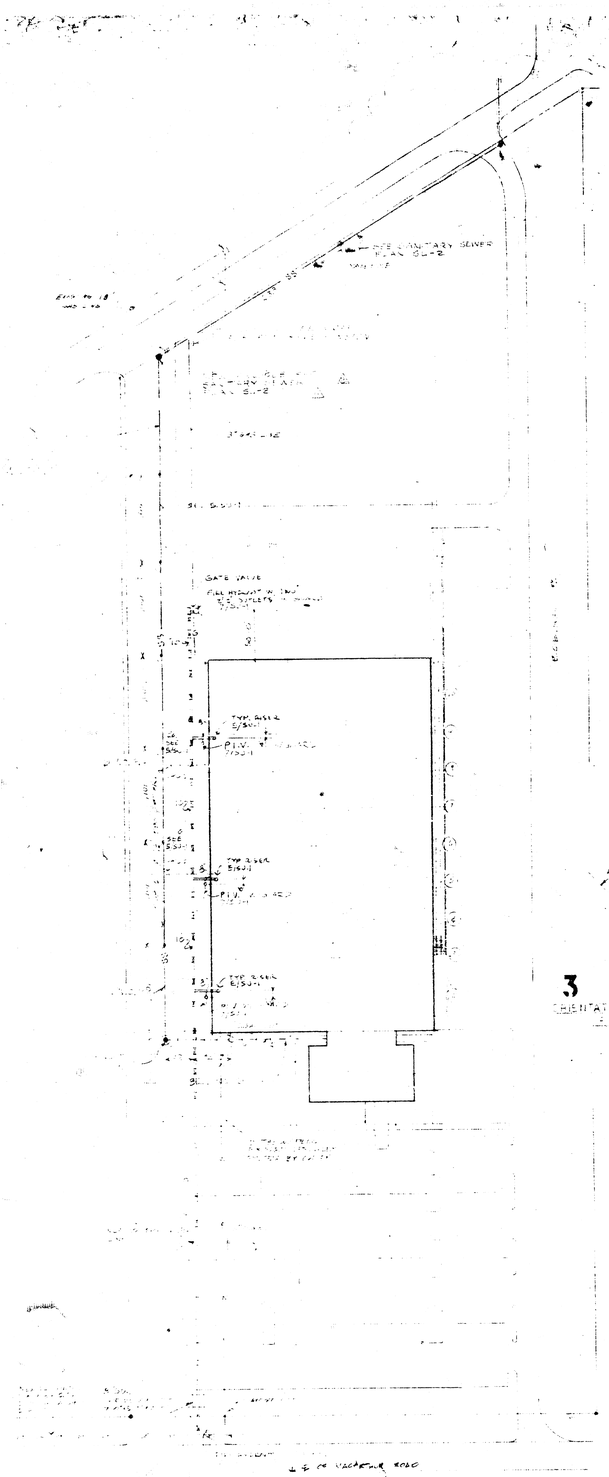

A SITE PLAN

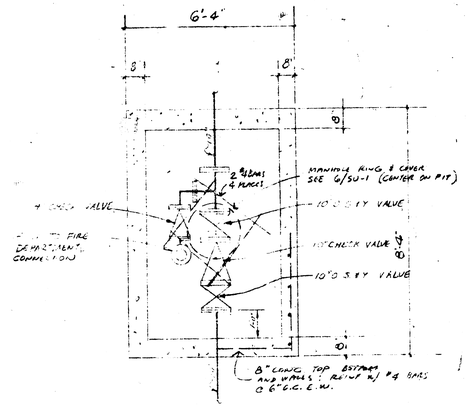

B PIT DETAIL

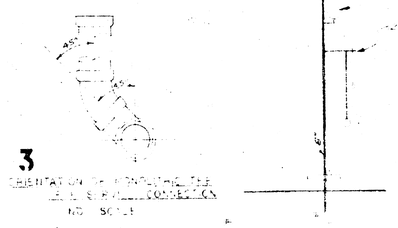


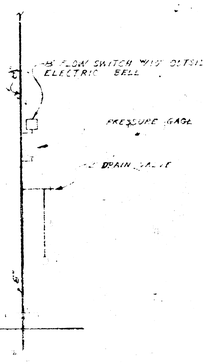

E

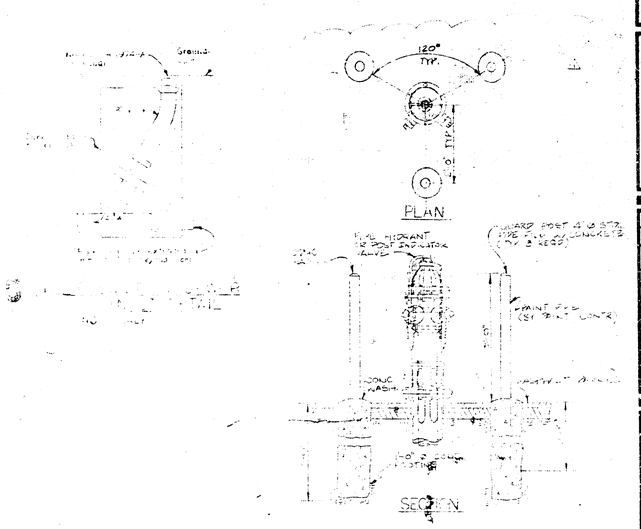

7 TYP. GUARD POST DETAIL

NOTES:

ALL MANHOLE RINGS SHALL BE SET IN METAL [illegible] BY [illegible] FOR 8" PIPE THROUGH 12" PIPE [illegible] FOR 15" PIPE THROUGH 24" PIPE. ALL MANHOLE RINGS SHALL BE SET AT PAVEMENT GRADE IN AREAS TO BE IMMEDIATELY PAVED. [illegible] BLEEDING SURFACES AND THOSE [illegible] WITH [illegible] A.S.T.M. SERIAL DESIGNATION A [illegible]

[illegible] SHALL BE CRUSHED STONE OR GRAVEL [illegible] PASSING 1 1/2" AND NOT LESS THAN [illegible] TO BE PLACED [illegible] IN NOT MORE THAN 6" LAYERS AND COMPACTED BY [illegible] MEANS.

TRENCH BACKFILL SHALL BE FREELY [illegible] FROM FROZEN MATERIAL, FREE FROM DEBRIS, ORGANIC MATERIAL, AND STONES [illegible] DETERMINED BY A.S.T.M. STANDARD METHOD [illegible] SUBSTRATUM [illegible]

PRINTS ISSUED

DATE	PURPOSE	NO.
6/14/71	FOR APPROVAL	
7/27/71	[illegible]	
[illegible]	[illegible]	3

FOR CONSTRUCTION

REVISIONS

DATE	ITEM	NO
[illegible]	[illegible]	

THE LAW COMPANY


ARCHITECTS & ENGINEERS

DRAWN	CHECKED
[illegible]	[illegible]

RELATED DRAWINGS

SHELL	
DETAILS	
STRUCTURE	
MECHANICAL	
ELECTRICAL	
OTHER	

ISSUANCE NUMBER

OF SHEETS

MUNICIPAL AUTHORITY

[illegible] BUILDING SYSTEMS CORP. INC.

PROJECT NUMBER [illegible]

KEY PLAN

TENANT

SHEET TITLE

TENANT NUMBER

SHEET NUMBER

SU1

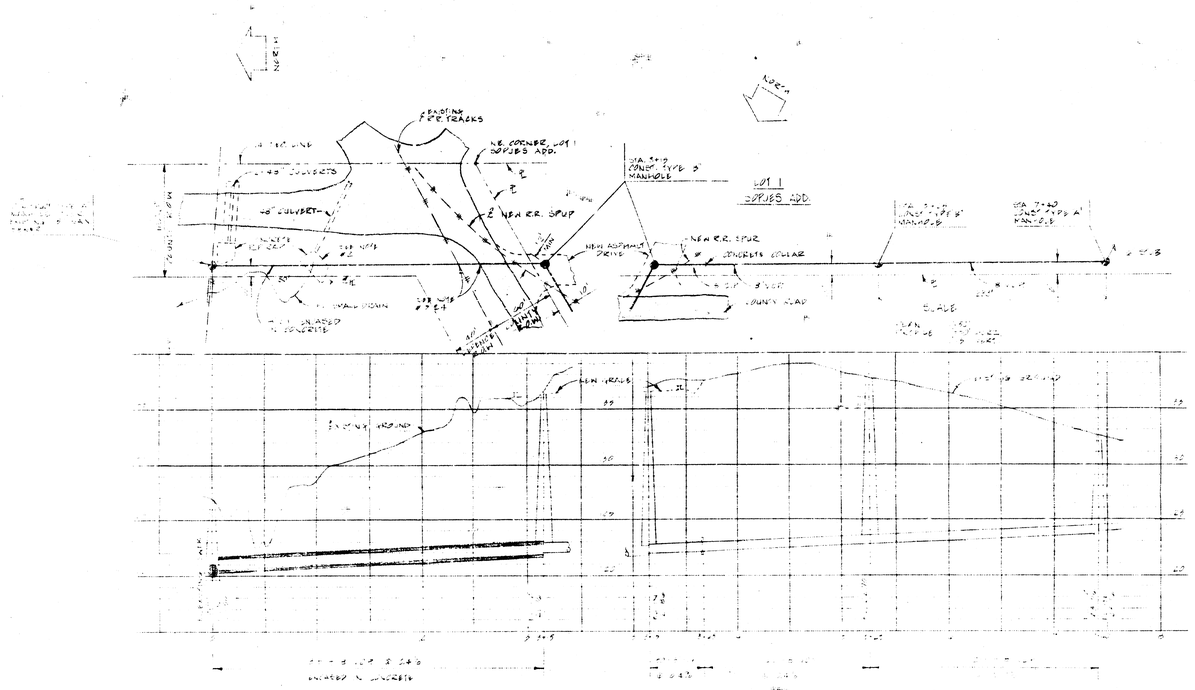

CONCRETE ENCASEMENT DETAIL
NO SCALE

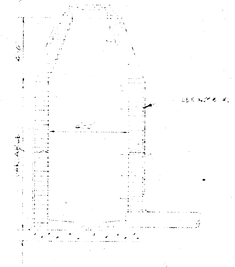

TYPE A MANHOLE
NO SCALE

TYPE B MANHOLE
NO SCALE

PAVEMENT REPLACEMENT DETAIL
NO SCALE

AS BUILT 3-4-72
BASED 3-3-72
@ I-45 & W.D.U.

PRINTS ISSUED		
DATE	PURPOSE	NO

FOR CONSTRUCTION:

REVISIONS		
DATE	ITEM	NO

THE LAW COMPANY

CALVIN KINGDON ASSOCIATES BERGER
ARCHITECTS & ENGINEERS

DRAWN	CHECKED

RELATED DRAWINGS

SPIELL	
DETAILS	
STRUCTURE	
MECHANICAL	
ELECTRICAL	
OTHER	

SEQUENCE NUMBER

OF SHEETS

PROJECT NUMBER

KEY PLAN

TENANT

SHEET TITLE

TENANT NUMBER	SHEET NUMBER
	SU 2

OF SHEETS

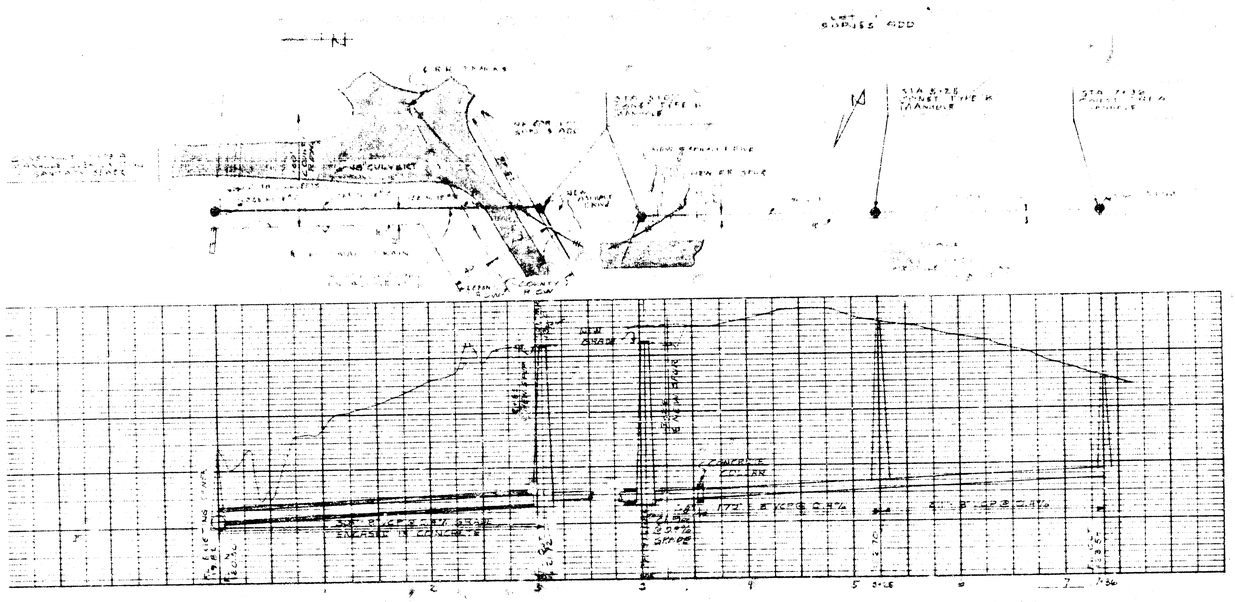

CONCRETE ENCASEMENT DETAIL
NO SCALE

TYPE A MANHOLE
NO SCALE

TYPE B MANHOLE
NO SCALE

Approved as Noted
City Engineer, City of Wichita
Street
Driveway Approaches

PRINTS ISSUED		
DATE	PURPOSE	NO

FOR CONSTRUCTION:

REVISIONS		
DATE	ITEM	NO

THE LAW COMPANY

CALVIN KINGDON BERGER P.A.
ARCHITECTS & ENGINEERS

DRAWN	CHECKED

RELATED DRAWINGS

SHELL	
DETAILS	
STRUCTURE	
MECHANICAL	
ELECTRICAL	
OTHER	

SEQUENCE NUMBER

CA _____ SHEETS

PROJECT NUMBER

KEY PLAN

TENANT

SHEET TITLE

TENANT NUMBER	SHEET NUMBER
	1