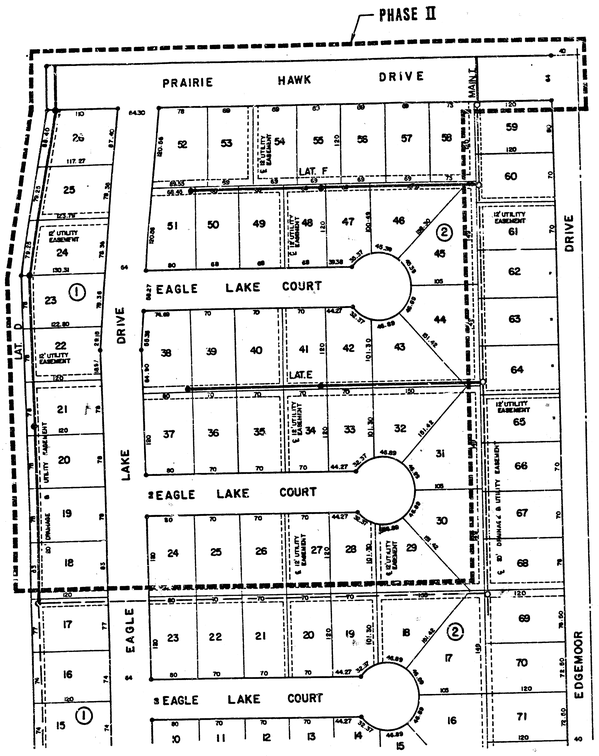

PLANS FOR

SANITARY SEWER EXTENSIONS

TO

EAGLE LAKE ADDITION PHASE II

BEL AIRE, SEDGWICK COUNTY

SE1485

1986

CITY OF WICHITA PROJECT NO. 468 76 245 80001 000 000 051

BM
"□" CUT IN SW COR. INLET BOX,
150'± NO. OF ℄ EAGLE LAKE COURT
EL. 1398.61 USGS

INDEX OF SHEETS

1 – TITLE SHEET
2 – LAT. D AND LAT. E
3 – LAT. F AND MAIN I
4–8 DETAILS

APPROVED AS NOTED
By CITY ENGINEER OF WICHITA
Sanitary Sewers DB 2/13/86
Storm Sewers _____
Driveway Approaches _____
Water Mains _____
Paving _____

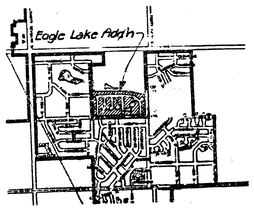

VICINITY MAP
N.S.

NOTE TO CONTRACTOR

This project will be constructed under the supervision of the CITY ENGINEER and conforming to the SPECIFICATIONS of the CITY OF WICHITA. The CONTRACTOR will pay the City of Wichita for all costs of plan review, inspection and testing per contract.

CHARLES W. GOODNESS LICENSED KANSAS PROFESSIONAL ENGINEER

REVISED 2/10/86

REESS & GOODNESS ENGINEERS
2140 WEST 21ST STREET
WICHITA, KANSAS 67203
(316) 832-0213

1/6

REVISION		DRAWN BY		CHECKED BY	DESIGNED BY	PROJECT	CUSTOMER	SCALE GIVEN	PROJECT NO. SE 485
								DATE 1/23/86	SHEET 1 OF 8

SCW - Standard

FILMED FROM THE BEST AVAILABLE COPY

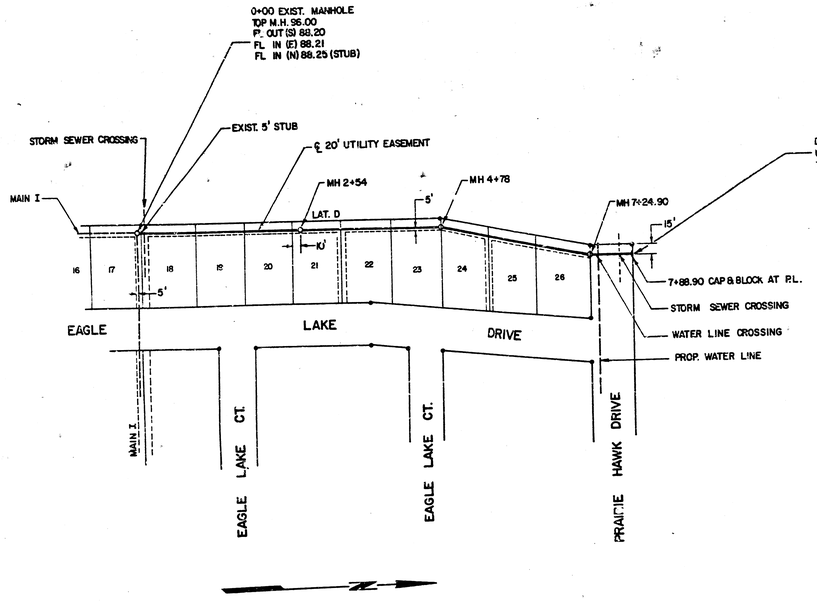

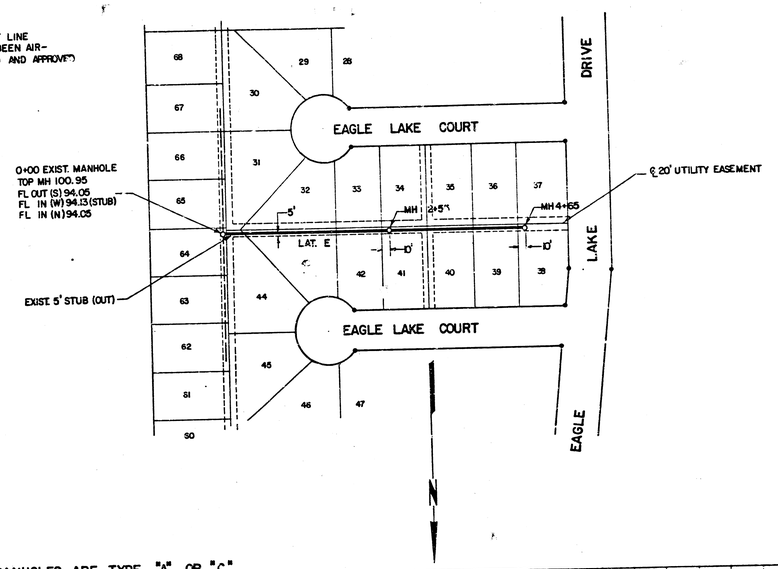

SCALE
PLAN 1"= 100'
PROFILE
HORIZ 1"= 50'
VERT 1"= 5'

ALL PIPE IS 8" PVC

ALL MANHOLES ARE TYPE "A" OR "C"

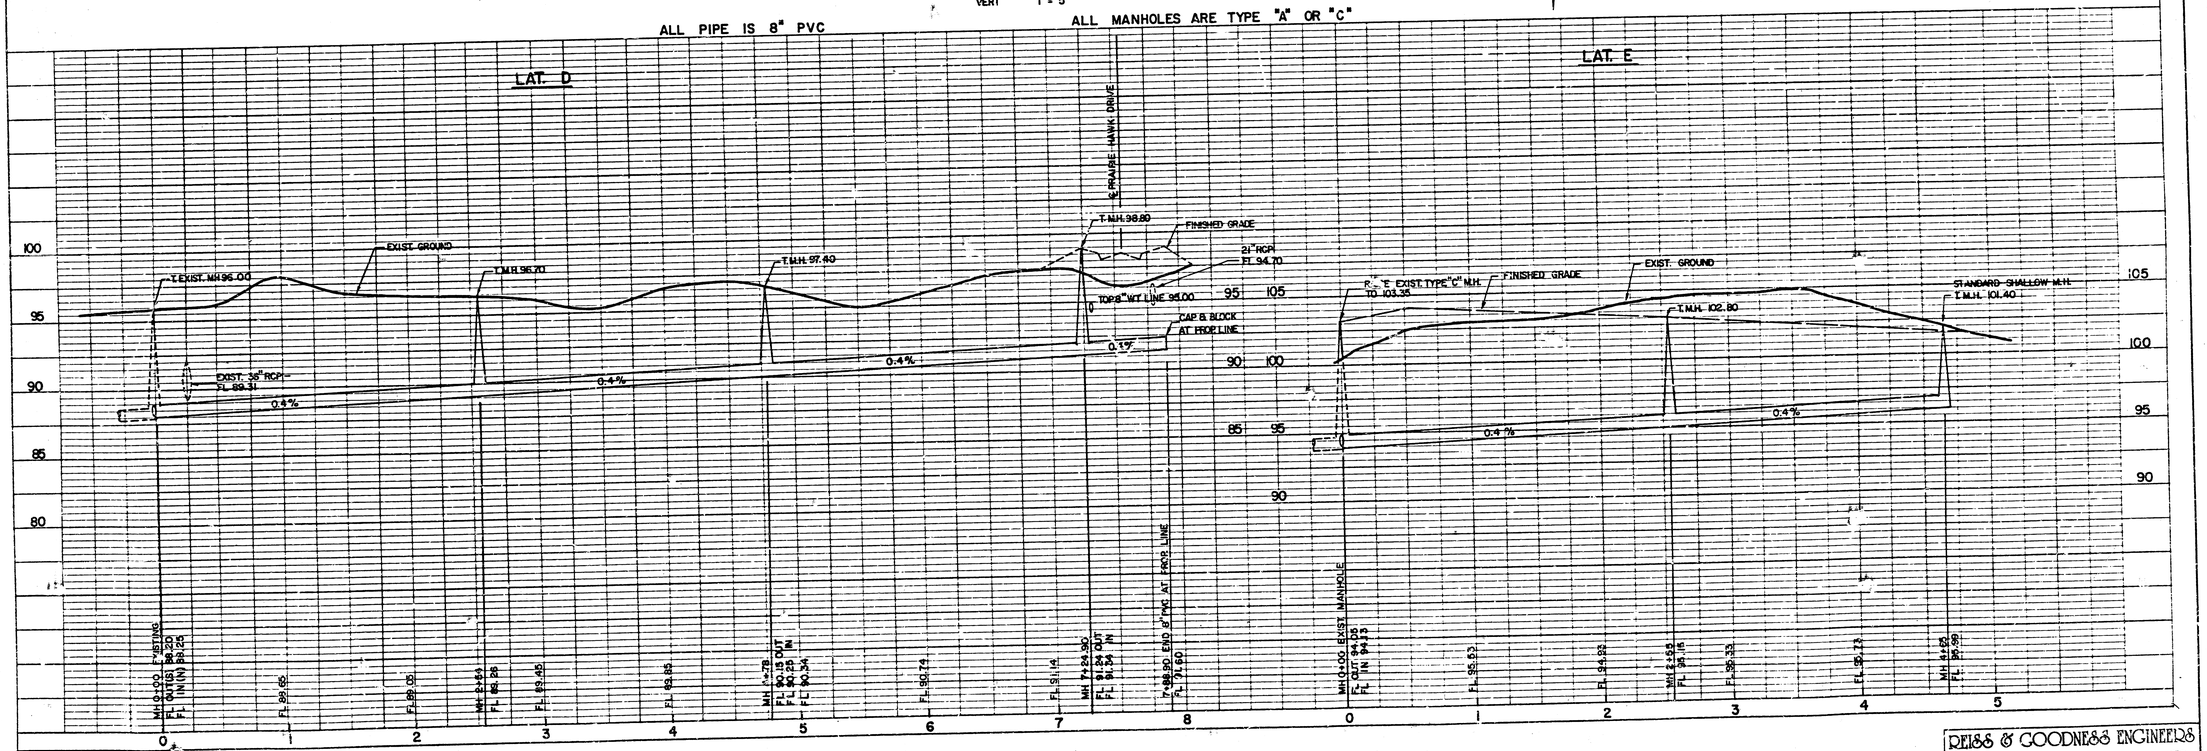

REISS & GOODNESS ENGINEERS
2160 WEST 21ST STREET
WICHITA, KANSAS 67203
(316) 832-0233

REVISION		DRAWN BY		CHECKED BY	DESIGNED BY	PROJECT
						SANITARY SEWER EXTENSIONS LAT D & LAT E

CUSTOMER EAGLE LAKE ADDITION PHASE II BEL AIRE, KANSAS

SCALE NOTED | PROJECT NO. SE 148 | DATE 1/23/86 | SHEET 2 2/6

FILMED FROM THE BEST AVAILABLE COPY

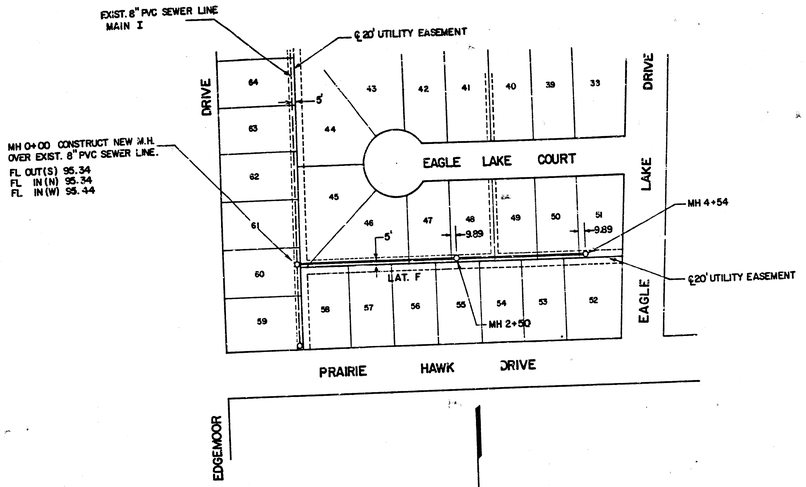

NOTE:
CONTRACTOR WILL CHECK F.L. GRADE(OUT) OF EXIST. PIPE BEFORE LAYING NEW PIPE AND MAKE ANY NECESSARY CHANGES IN GRADE

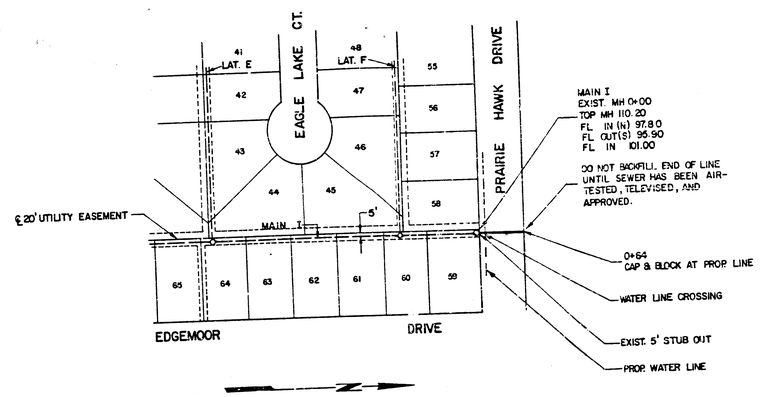

SCALE
PLAN 1"=100'
PROFILE
HORIZ 1"=50'
VERT. 1"=5'

ALL PIPE IS 8" PVC

ALL MANHOLES ARE TYPE "A" OR "C"

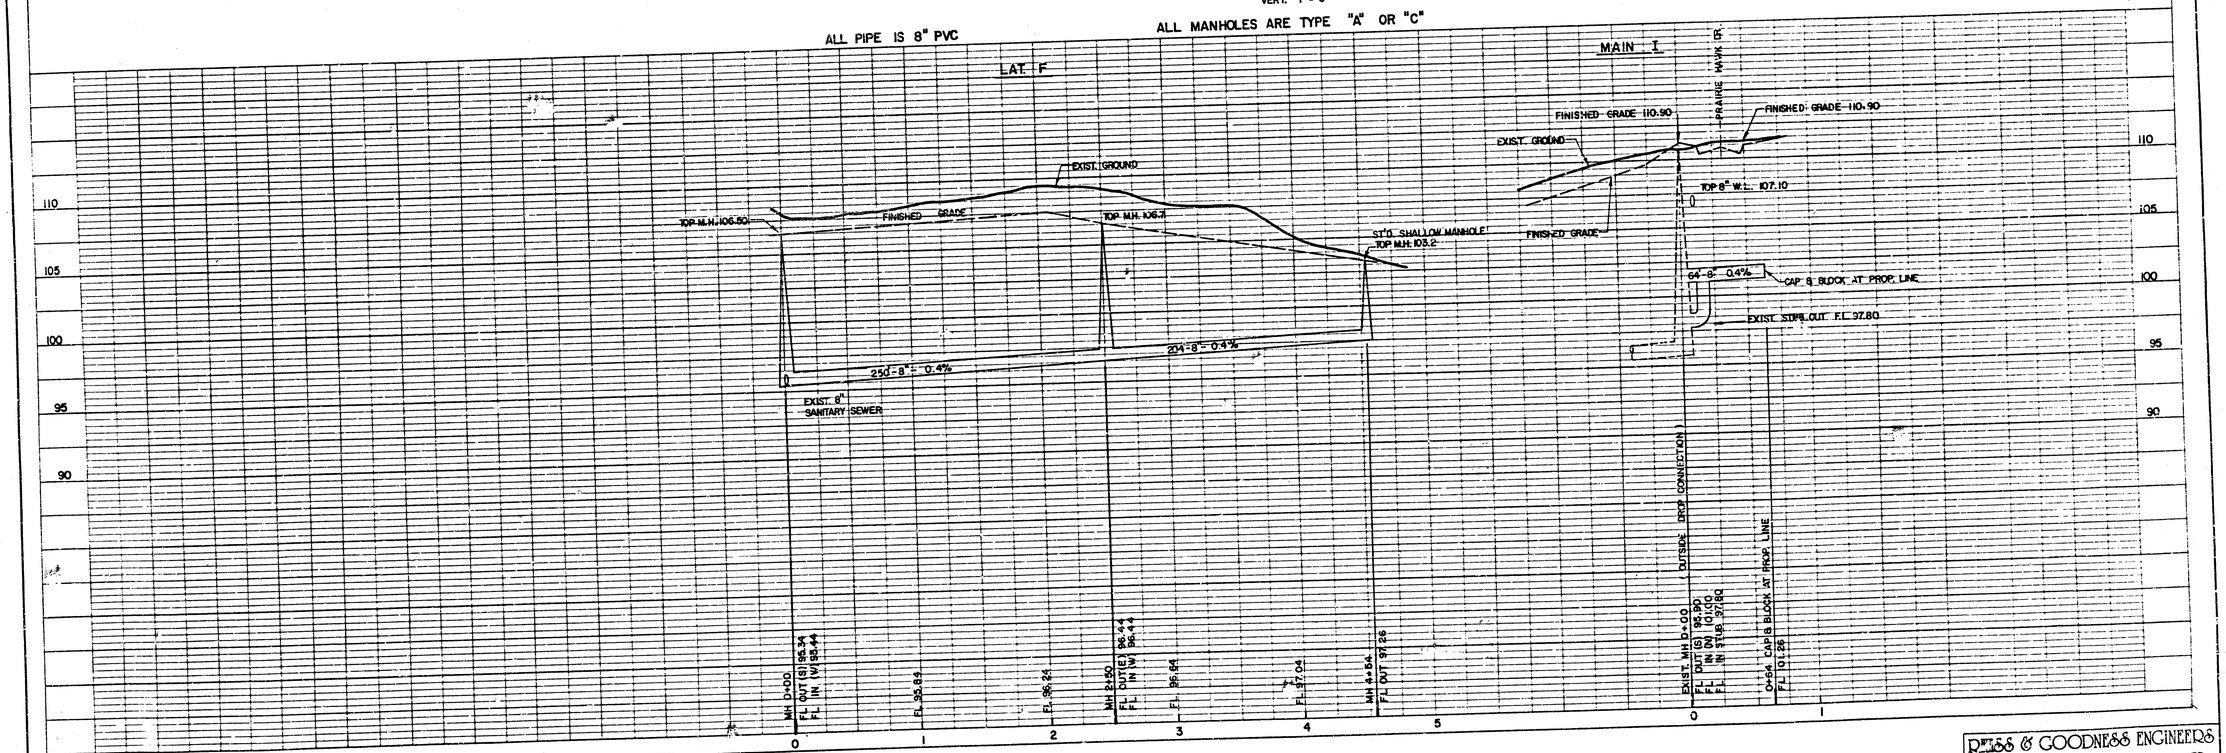

2160 WEST 21ST STREET
WICHITA, KANSAS 67203
(316) 832-0213

REVISION		DRAWN BY		CHECKED BY	DESIGNED BY	PROJECT	CUSTOMER	SCALE	PROJECT NO.
						SANITARY SEWER EXTENSIONS LAT F & MAIN I	EAGLE LAKE ADDITION-PHASE II-BEL AIRE, KANSAS	GIVEN	SE 1485
								DATE 1/24/86	SHEET 3 OF 6

FILMED FROM THE BEST AVAILABLE COPY

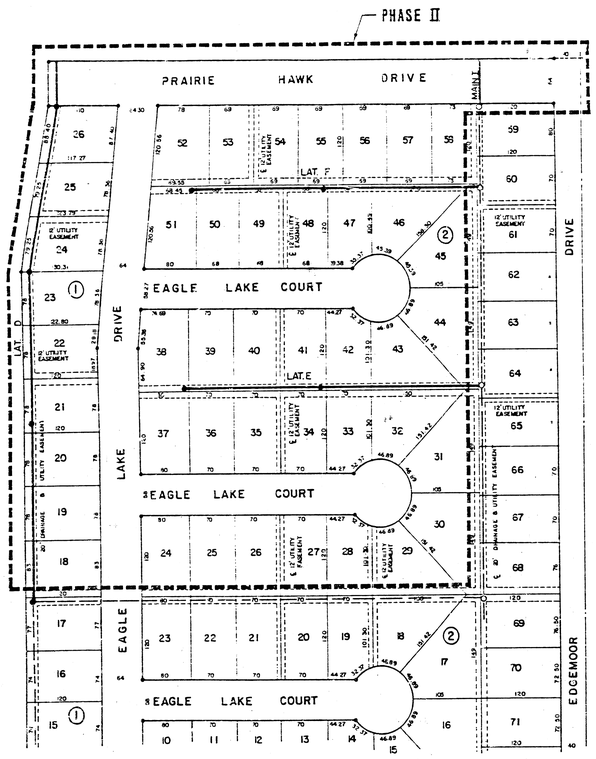

PLANS FOR

SANITARY SEWER EXTENSIONS

TO

EAGLE LAKE ADDITION PHASE II

BEL AIRE, SEDGWICK COUNTY

SE1485

1986

CITY OF WICHITA PROJECT NO. 468 76 245 80001 000 000 051

BM
"□" CUT IN SW COR. INLET BOX,
150' ± NO. OF ℄ EAGLE LAKE COURT
EL. 1398.61 USGS

INDEX OF SHEETS

1 – TITLE SHEET
2 – LAT. D AND LAT. E
3 – LAT. F AND MAIN I
4–3 DETAILS

APPROVED AS [illegible]
By CITY ENGINEER OF WICHITA
Sanitary Sewer [illegible]
Storm Sewer
Driveway
Water Main
Paving

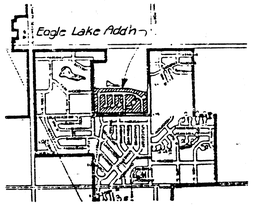

VICINITY MAP
N.S.

"AS BUILT"

NOTE TO CONTRACTOR

This project will be constructed under the supervision of the CITY [illegible] and conforming to the [illegible] of the CITY OF [illegible] CONTRACTOR will pay the City of [illegible] [illegible]

REVISED 2/10/86

REISS & GOODNESS ENGINEERS
2160 WEST 21st STREET
WICHITA, KANSAS 67203
(316) 832-0213

REVISION	DRAWN BY	CHECKED BY	DESIGNED BY	PROJECT	CUSTOMER	SCALE GIVEN	PROJECT NO. SE 1485
						DATE 1/23/86	SHEET 1 OF 4/6

FILMED FROM THE BEST AVAILABLE COPY.....

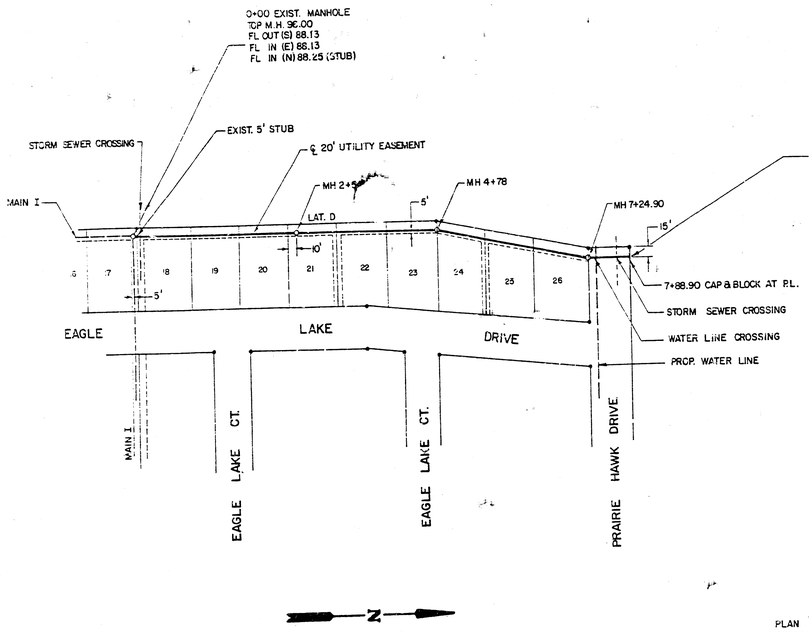

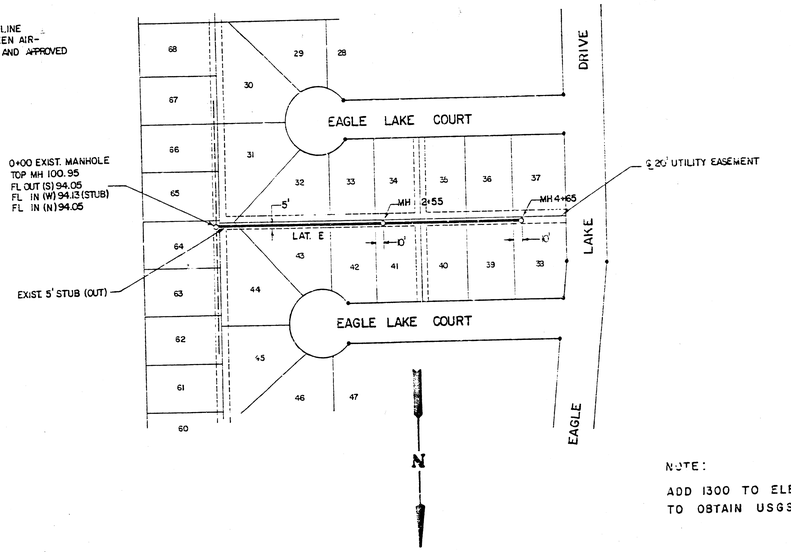

NOTE:
ADD 1300 TO ELEVATIONS SHOWN TO OBTAIN USGS ELEVATION

SCALE
PLAN 1" = 100'
PROFILE
HORIZ 1" = 50'
VERT 1" = 5'

ALL PIPE IS 8" PVC

ALL MANHOLES ARE TYPE "C"

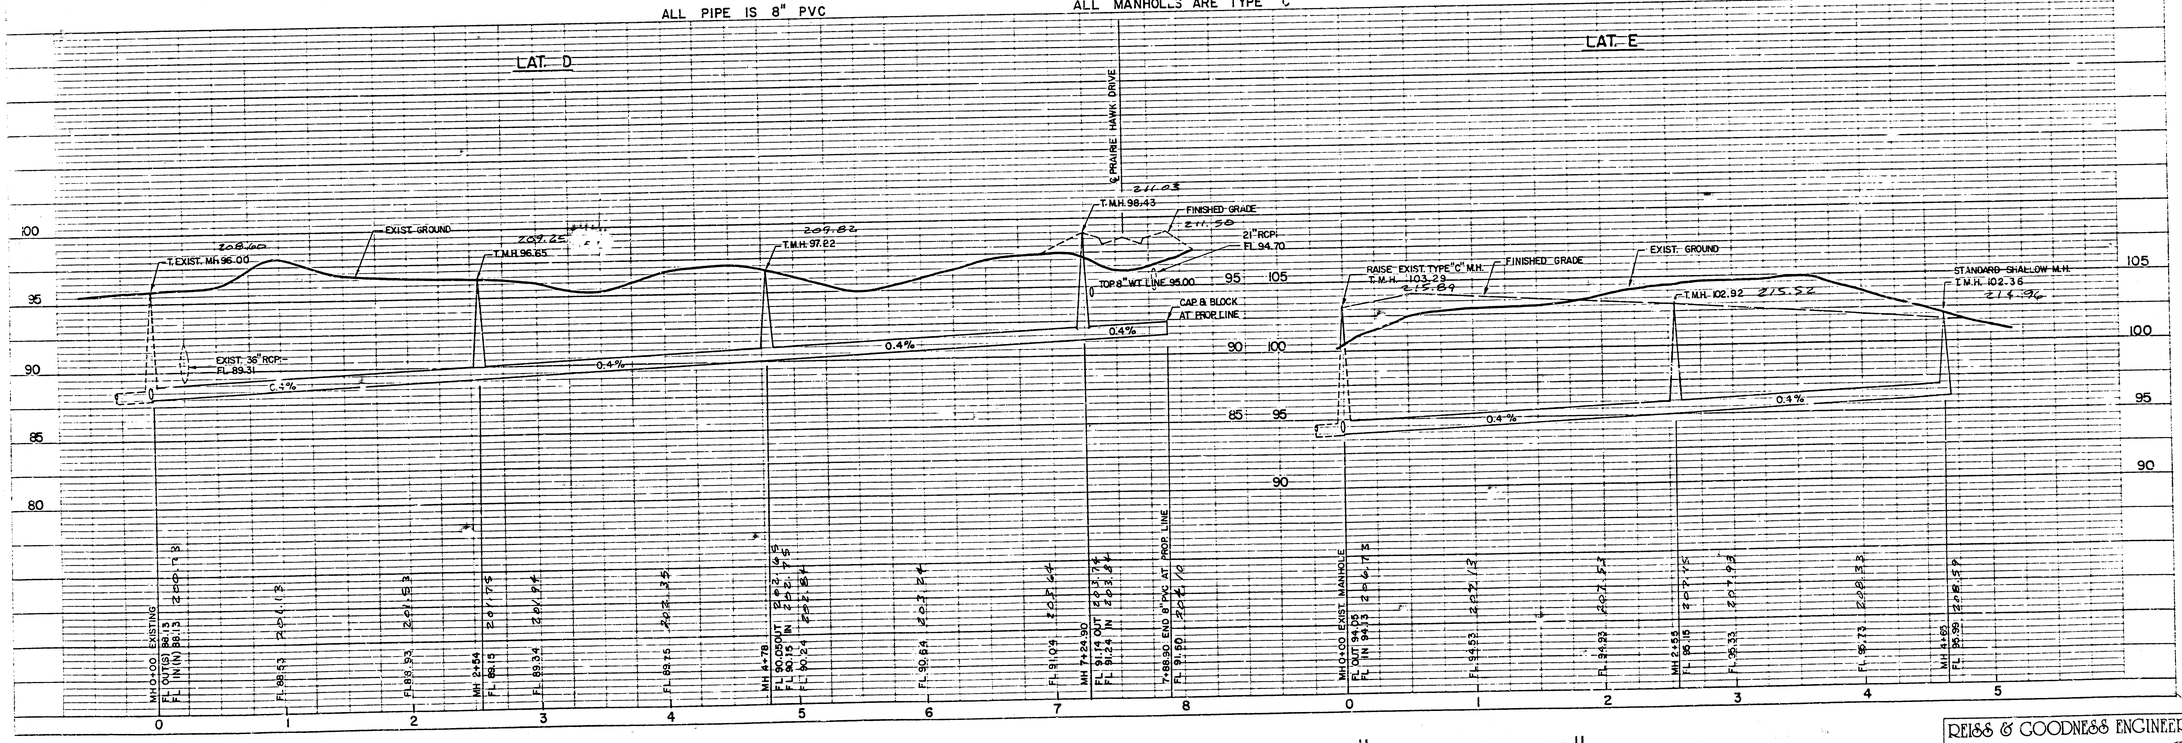

"AS BUILT"

REISS & GOODNESS ENGINEERS
2160 WEST 21ST STREET
WICHITA, KANSAS 67203
(316) 832-0213

REVISION	DRAWN BY	CHECKED BY	DESIGNED BY	PROJECT
				SANITARY SEWER EXTENSIONS LAT D & LAT E

CUSTOMER EAGLE LAKE ADDITION PHASE II BEL AIRE, KANSAS

SCALE NOTED | PROJECT NO. SE 1485
DATE 1/23/86 | SHEET 5/16 8

FILMED FROM THE BEST AVAILABLE COPY

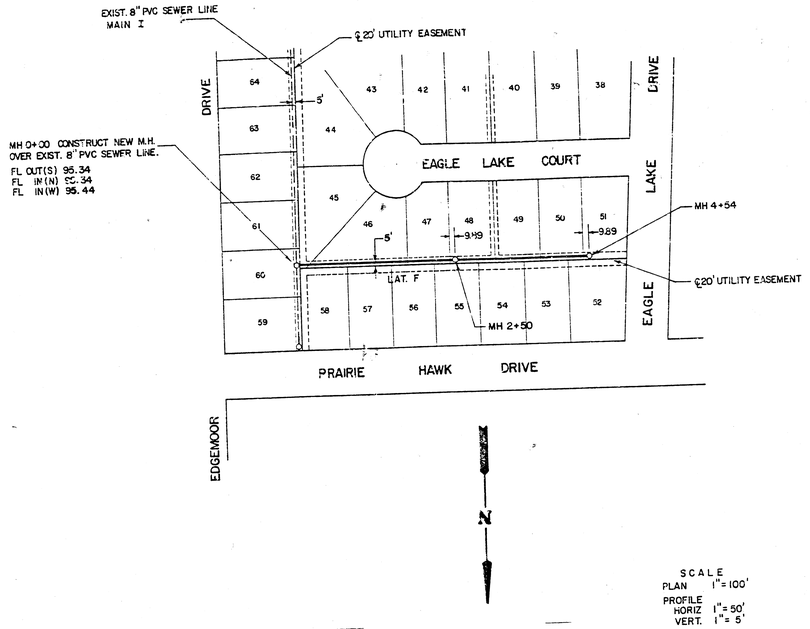

NOTE:
CONTRACTOR WILL CHECK F.L. GRADE(OUT) OF EXIST. PIPE BEFORE LAYING NEW PIPE AND MAKE ANY NECESSARY CHANGES IN GRADE

NOTE:
ADD 1300 TO ELEVATIONS SHOWN TO OBTAIN USGS ELEVATION

SCALE
PLAN 1" = 100'
PROFILE
HORIZ 1" = 50'
VERT. 1" = 5'

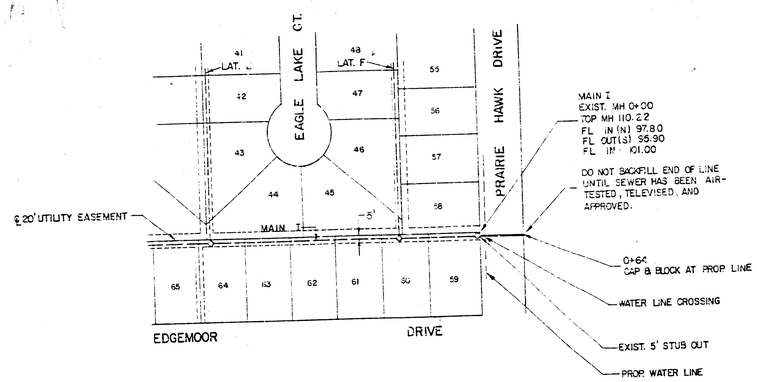

ALL PIPE IS 8" PVC

ALL MANHOLES ARE TYPE "C"

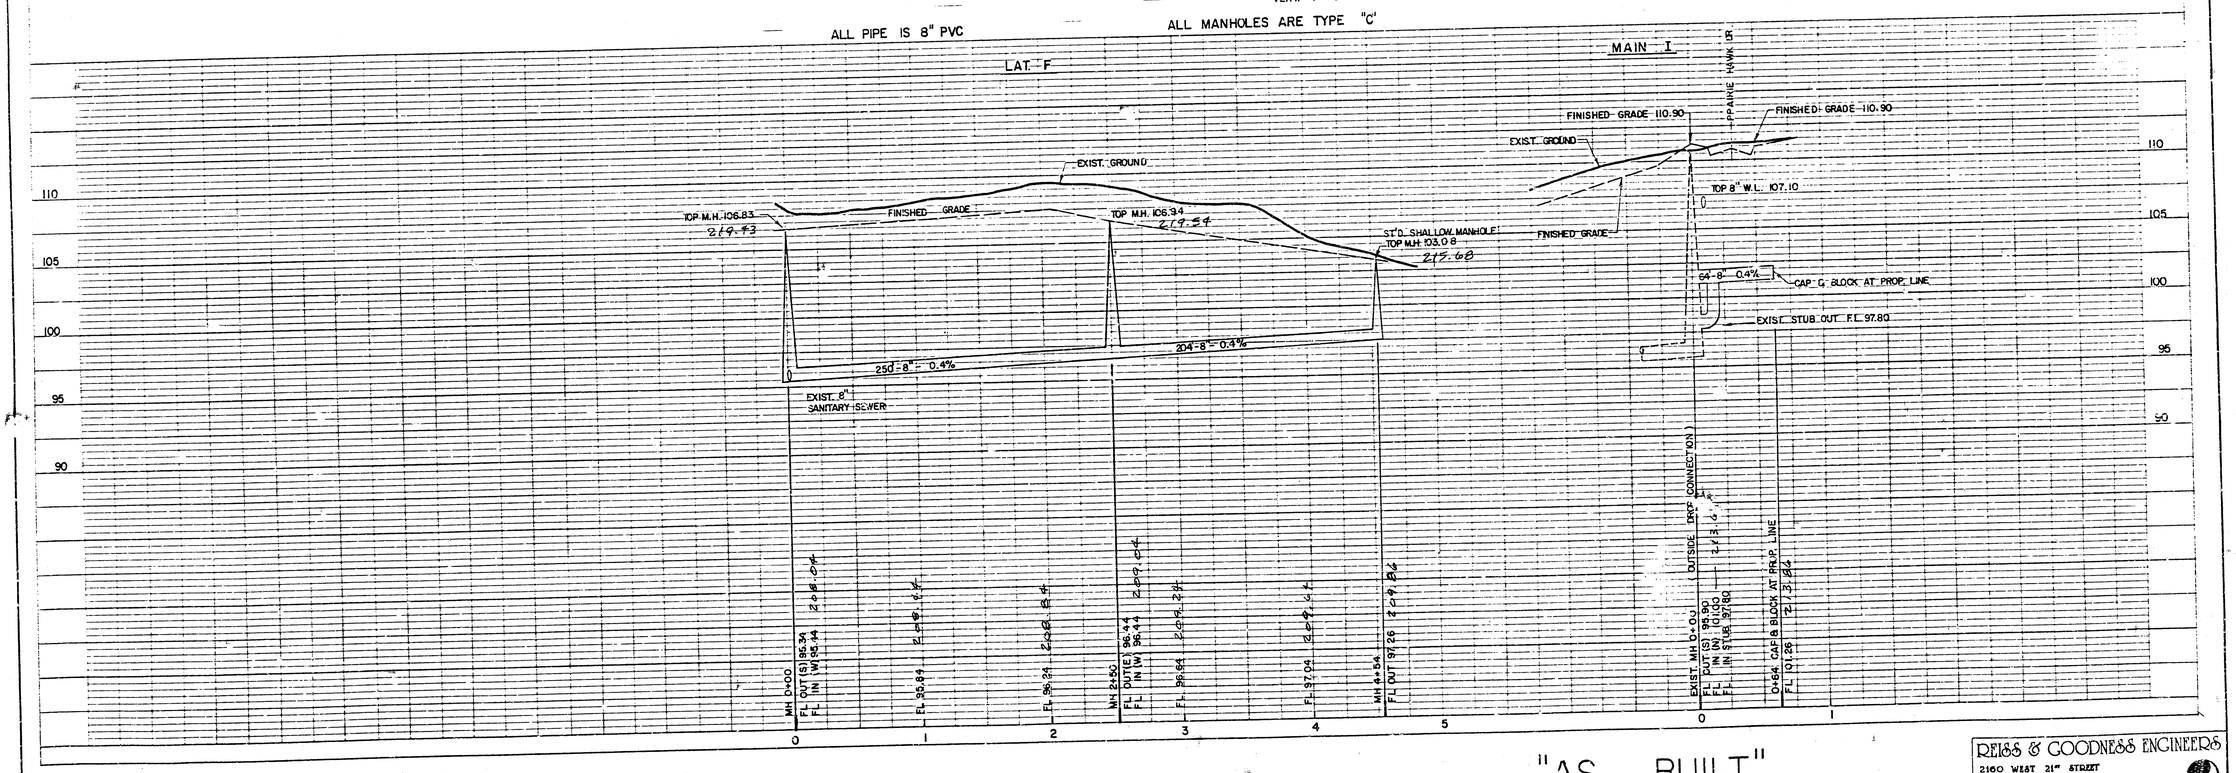

"AS BUILT"

REISS & GOODNESS ENGINEERS
2160 WEST 21st STREET
WICHITA, KANSAS 67203
(316) 832-0213

REVISION	DRAWN BY	CHECKED BY	DESIGNED BY	PROJECT	CUSTOMER	SCALE GIVEN	PROJECT NO. SE 1485
				SANITARY SEWER EXTENSIONS LAT F & MAIN I	EAGLE LAKE ADDITION-PHASE II-BEL AIRE, KANSAS	DATE 1/24/86	SHEET 6-8 / 6

FILMED FROM THE BEST AVAILABLE COPY